


14+00

15+00

STA. 14+00 TO STA. 15+50

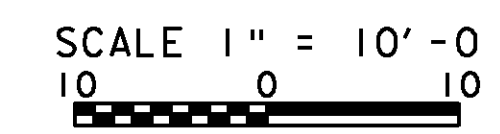

PROJECT:	CHESTER	PROJECT NO.:	BRF 016-1 (25)
DESIGN FILE NAME:	88b194/structures/s88b194xsl.dgn	PLOT DATE:	16-MAR-2011
IPARM FILE NAME:	s88b194m13.i	DRAWN BY:	M. FESSEL
DESIGNED BY:	E.L. RUSTAY	CHECKED BY:	R.S. YOUNG
SQUAD LEADER:	C.P. WILLIAMS	MAINLINE CROSS SECTIONS	SHEET: 46 OF 50