




5+25

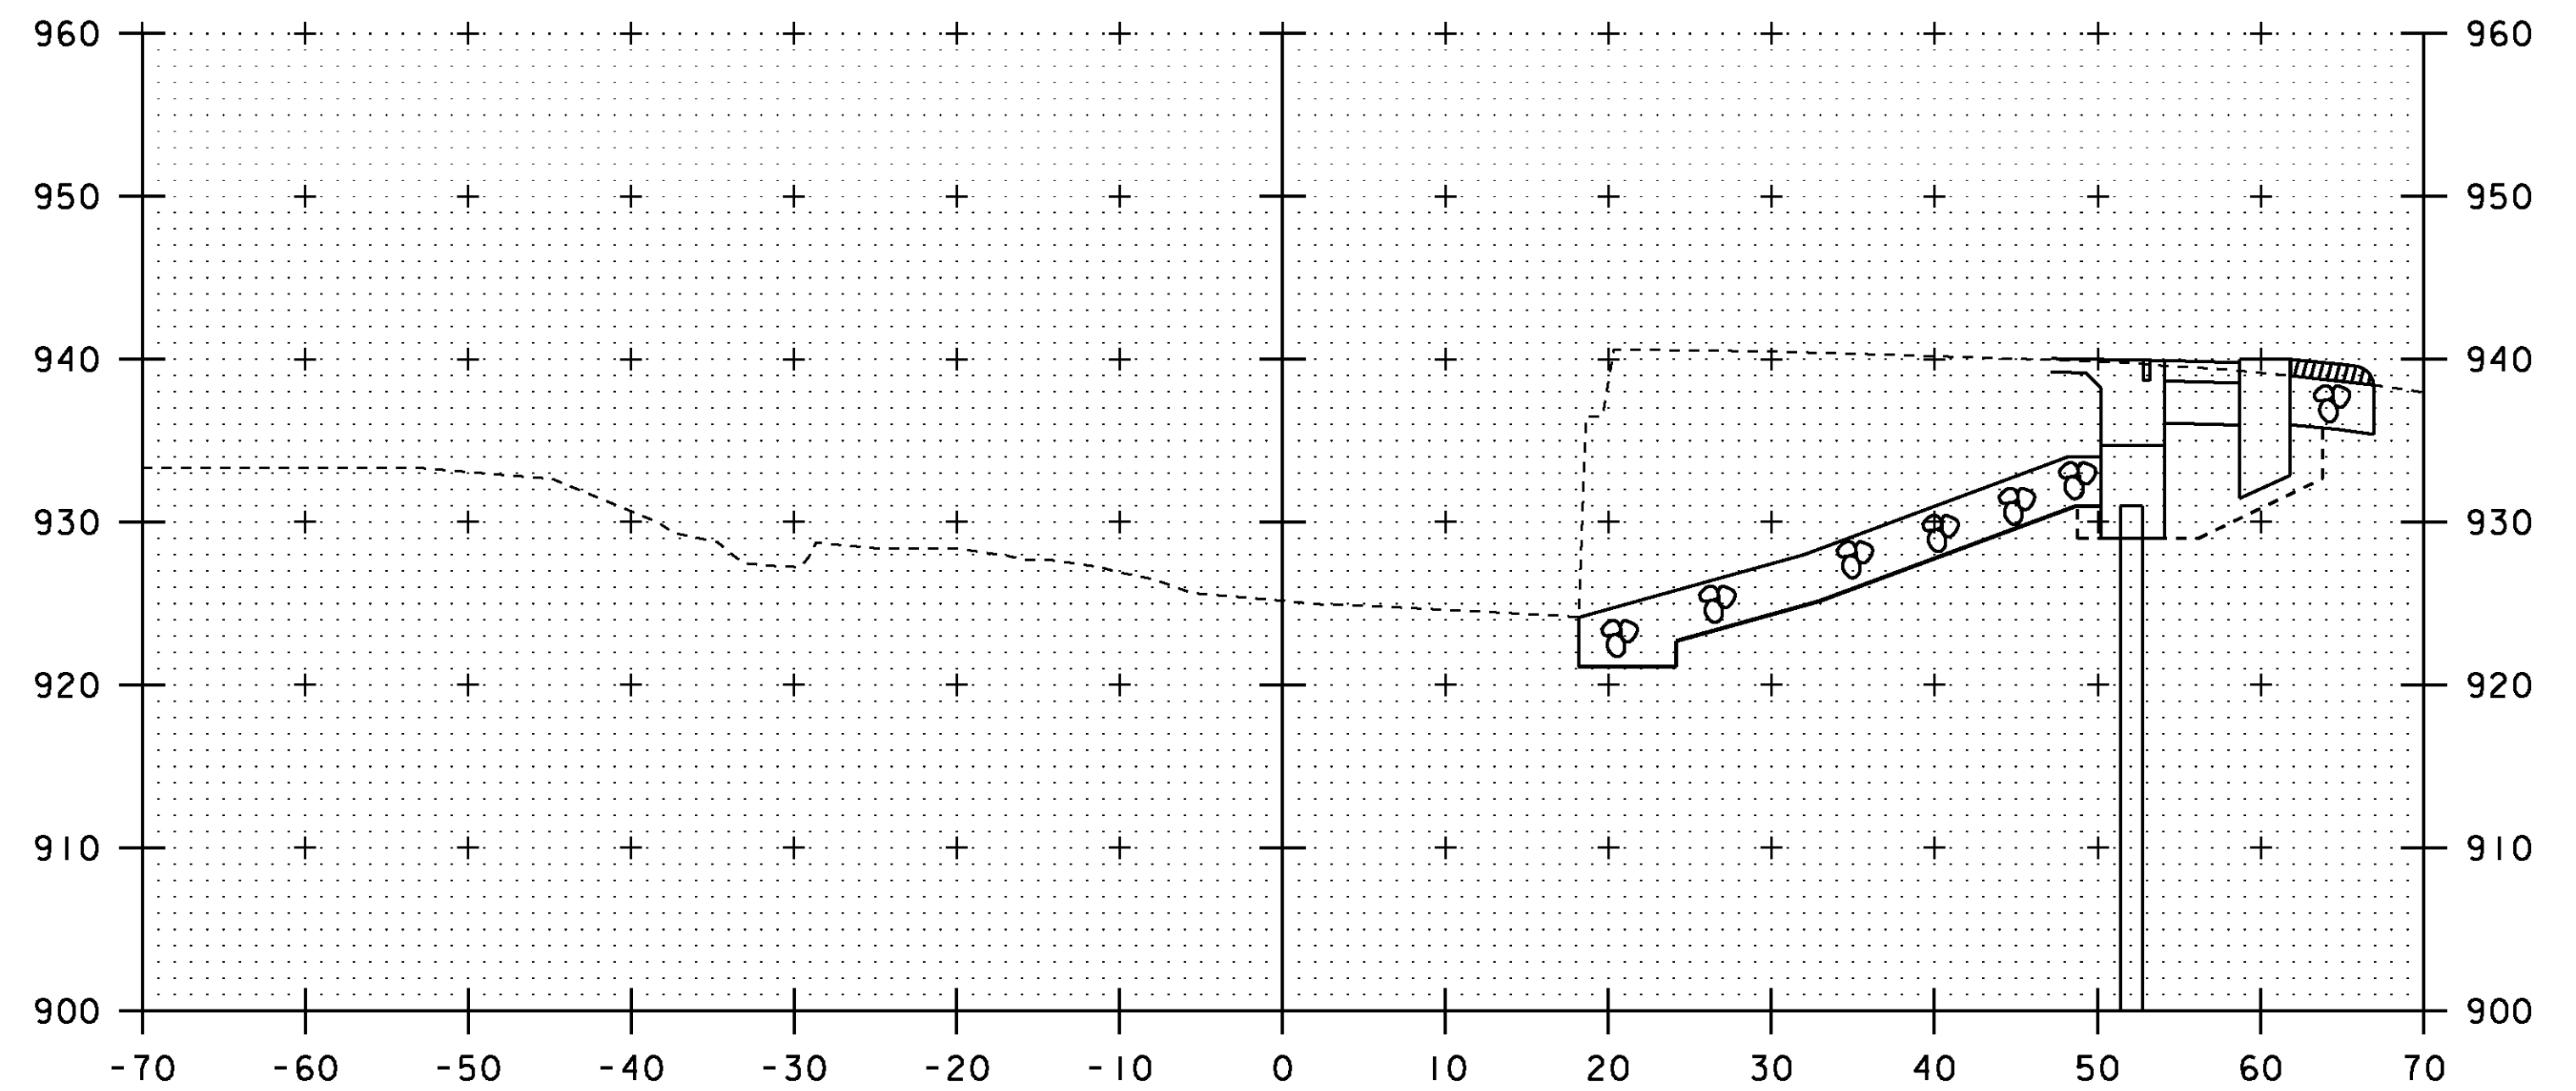

5+75

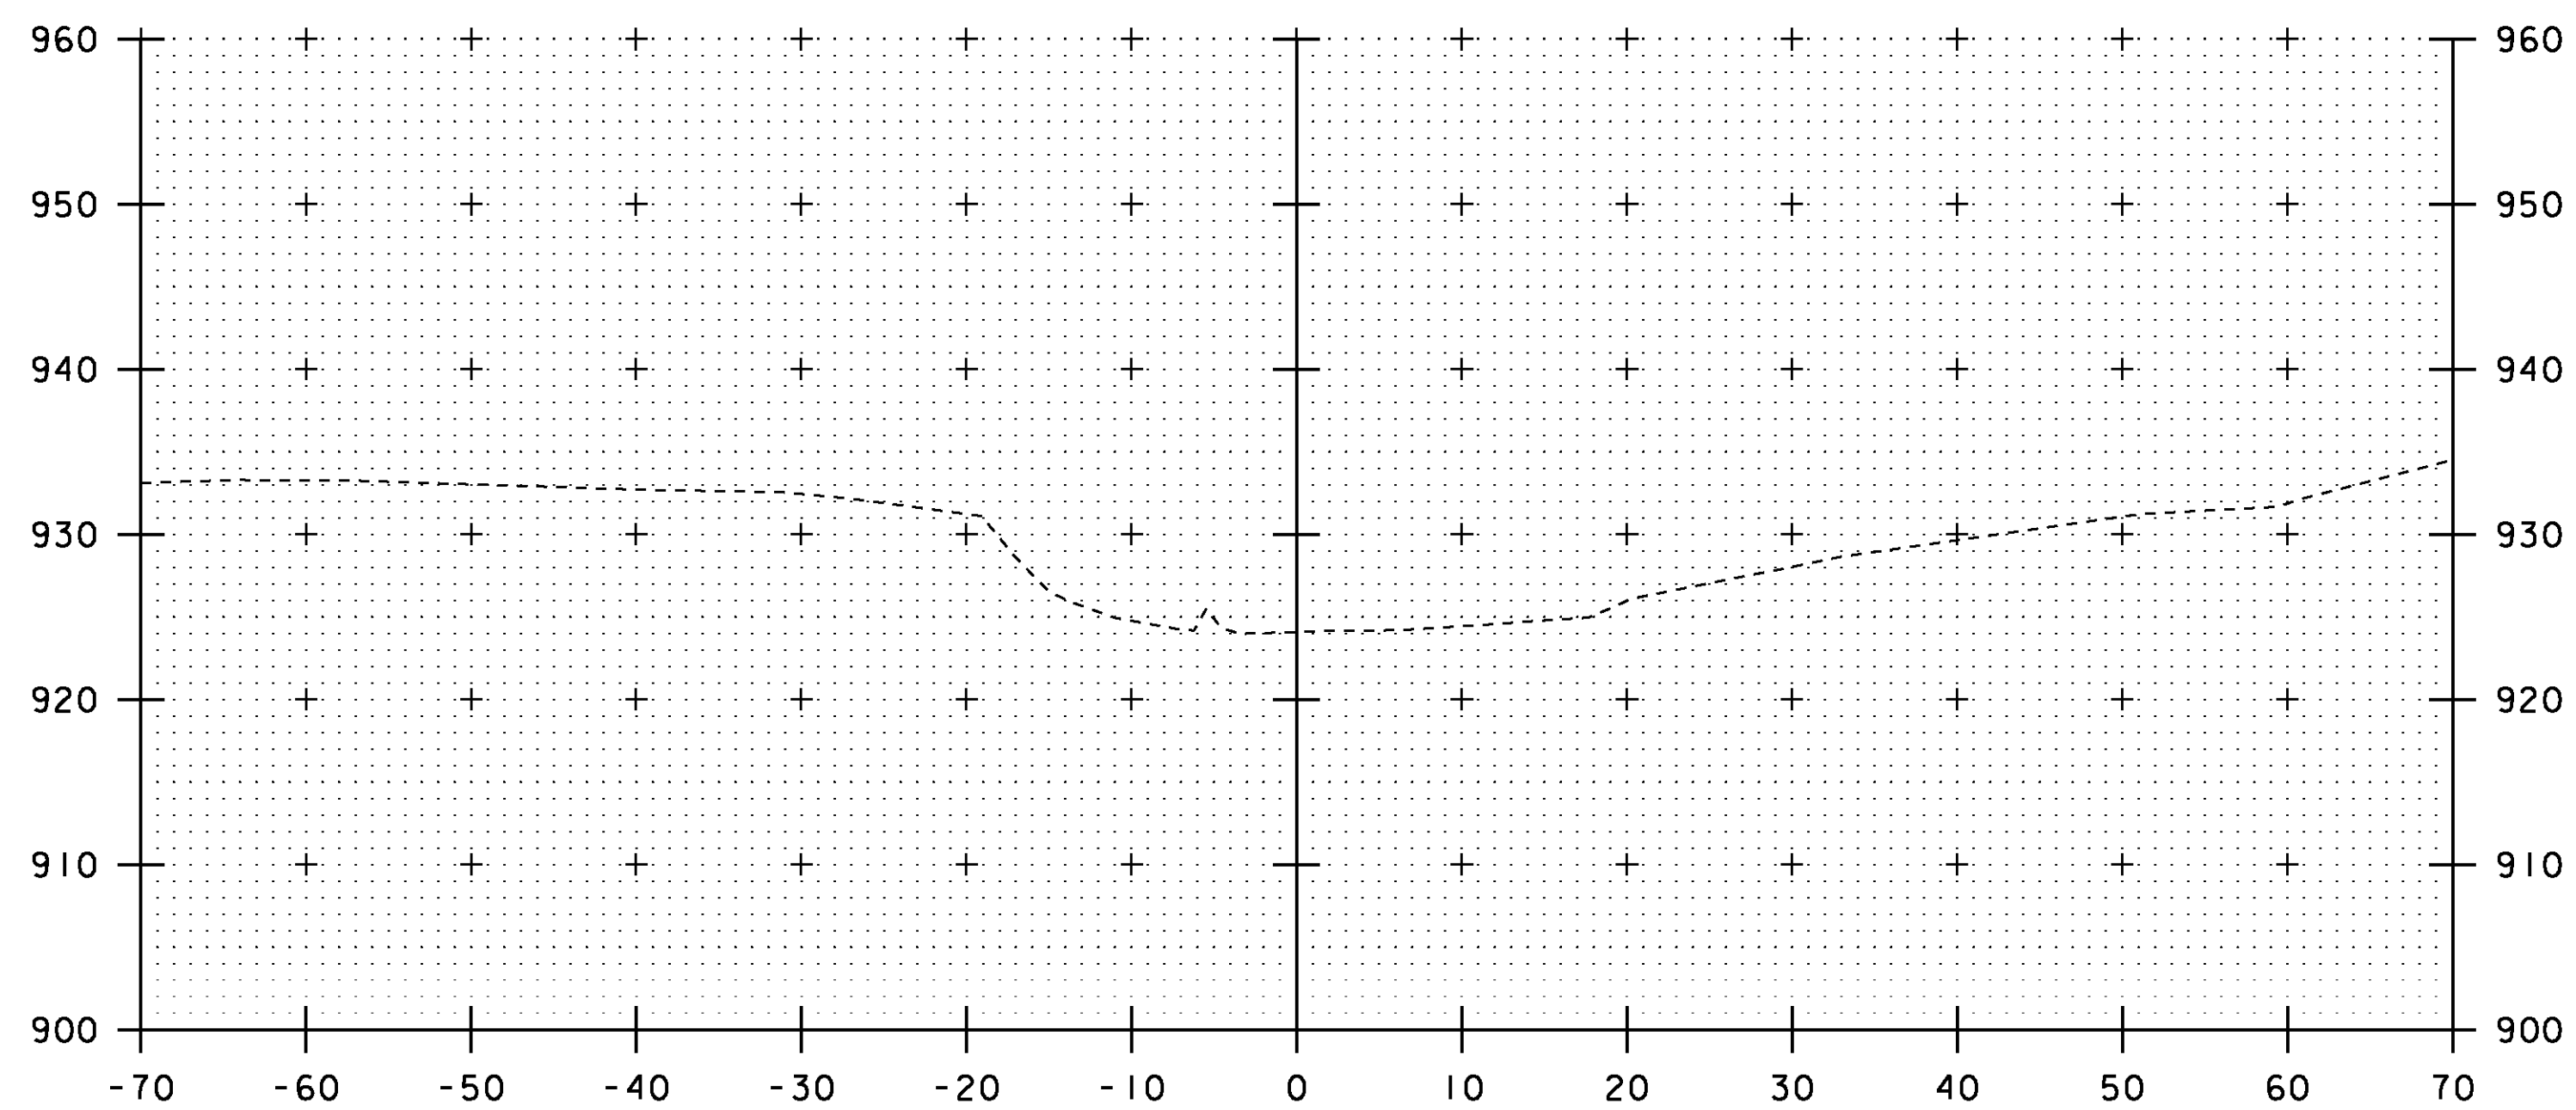

5+00

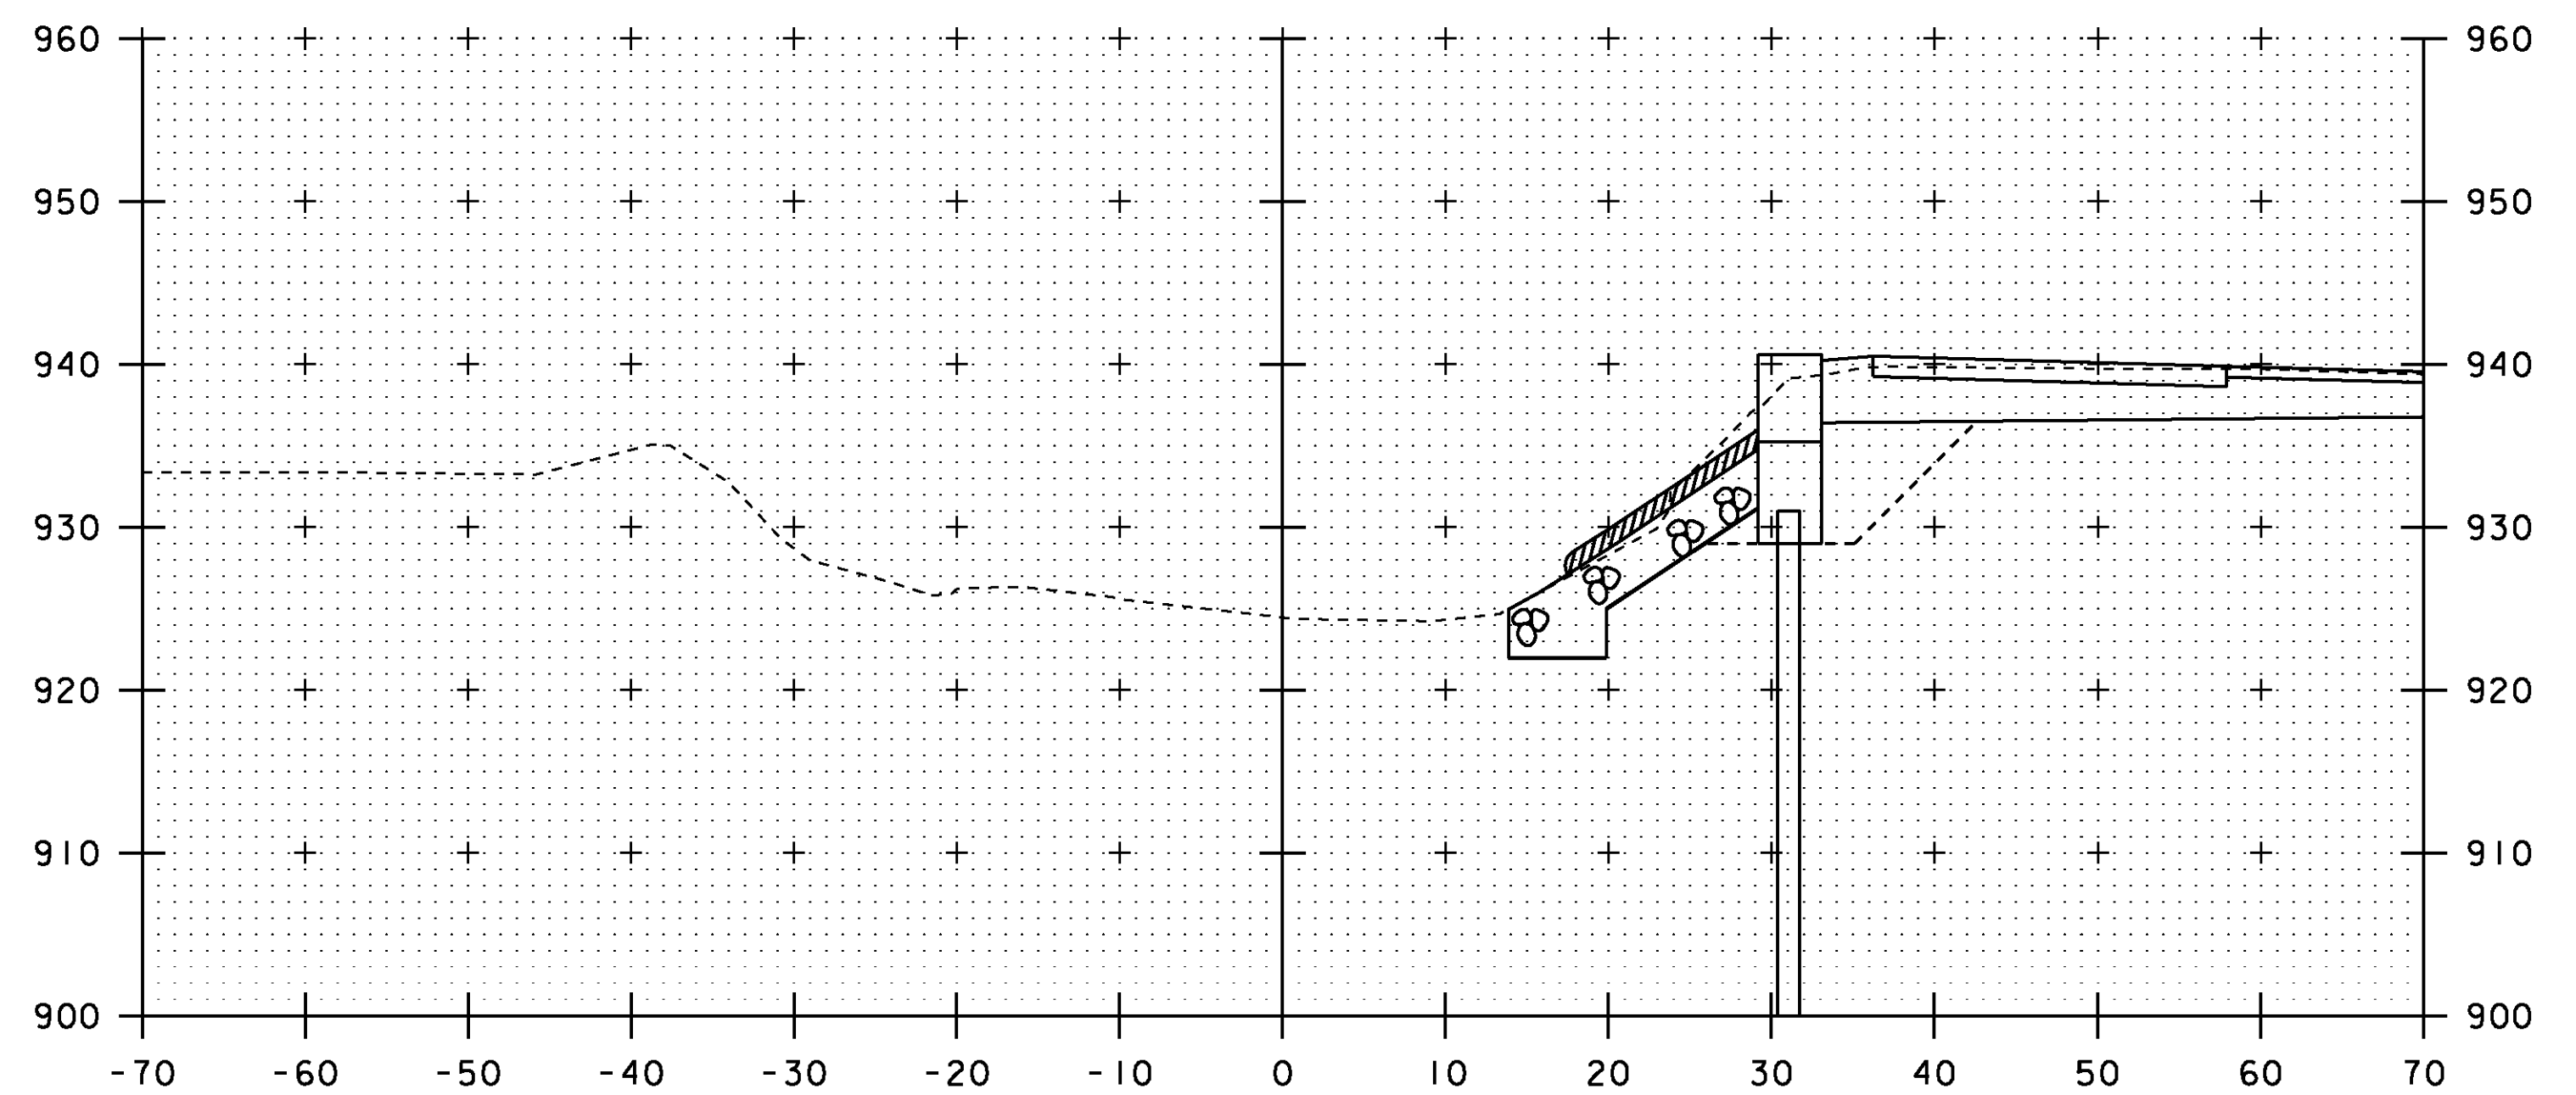

5+50

STA 5+27 RT
 BEGIN UNCLASSIFIED CHANNEL EXCAVATION
 BEGIN GEOTEXTILE UNDER STONE FILL
 BEGIN STONE FILL TYPE III
 BEGIN GRUBBING MATERIAL

SCALE 1" = 10'-0"
 10 0 10

STA. 5+00 TO STA. 5+75

PROJECT:	CHESTER	PROJECT NO.:	BRF 016-1 (25)
DESIGN FILE NAME:	88b194/structures/s88b194xsl.dgn	PLOT DATE:	16-MAR-2011
IPARM FILE NAME:	s88b194chl.i	DRAWN BY:	M. FESSEL
DESIGNED BY:	E. L. RUSTAY	CHECKED BY:	R. S. YOUNG
SQUAD LEADER:	C. P. WILLIAMS		
CHANNEL CROSS SECTIONS		SHEET:	48 OF 50