



STA 6+02 LT
 BEGIN UNCLASSIFIED CHANNEL EXCAVATION
 BEGIN GEOTEXTILE UNDER STONE FILL
 BEGIN STONE FILL TYPE III
 BEGIN GRUBBING MATERIAL

6+25


STA 6+24 RT
 END UNCLASSIFIED CHANNEL EXCAVATION
 END GEOTEXTILE UNDER STONE FILL
 END STONE FILL TYPE III
 END GRUBBING MATERIAL

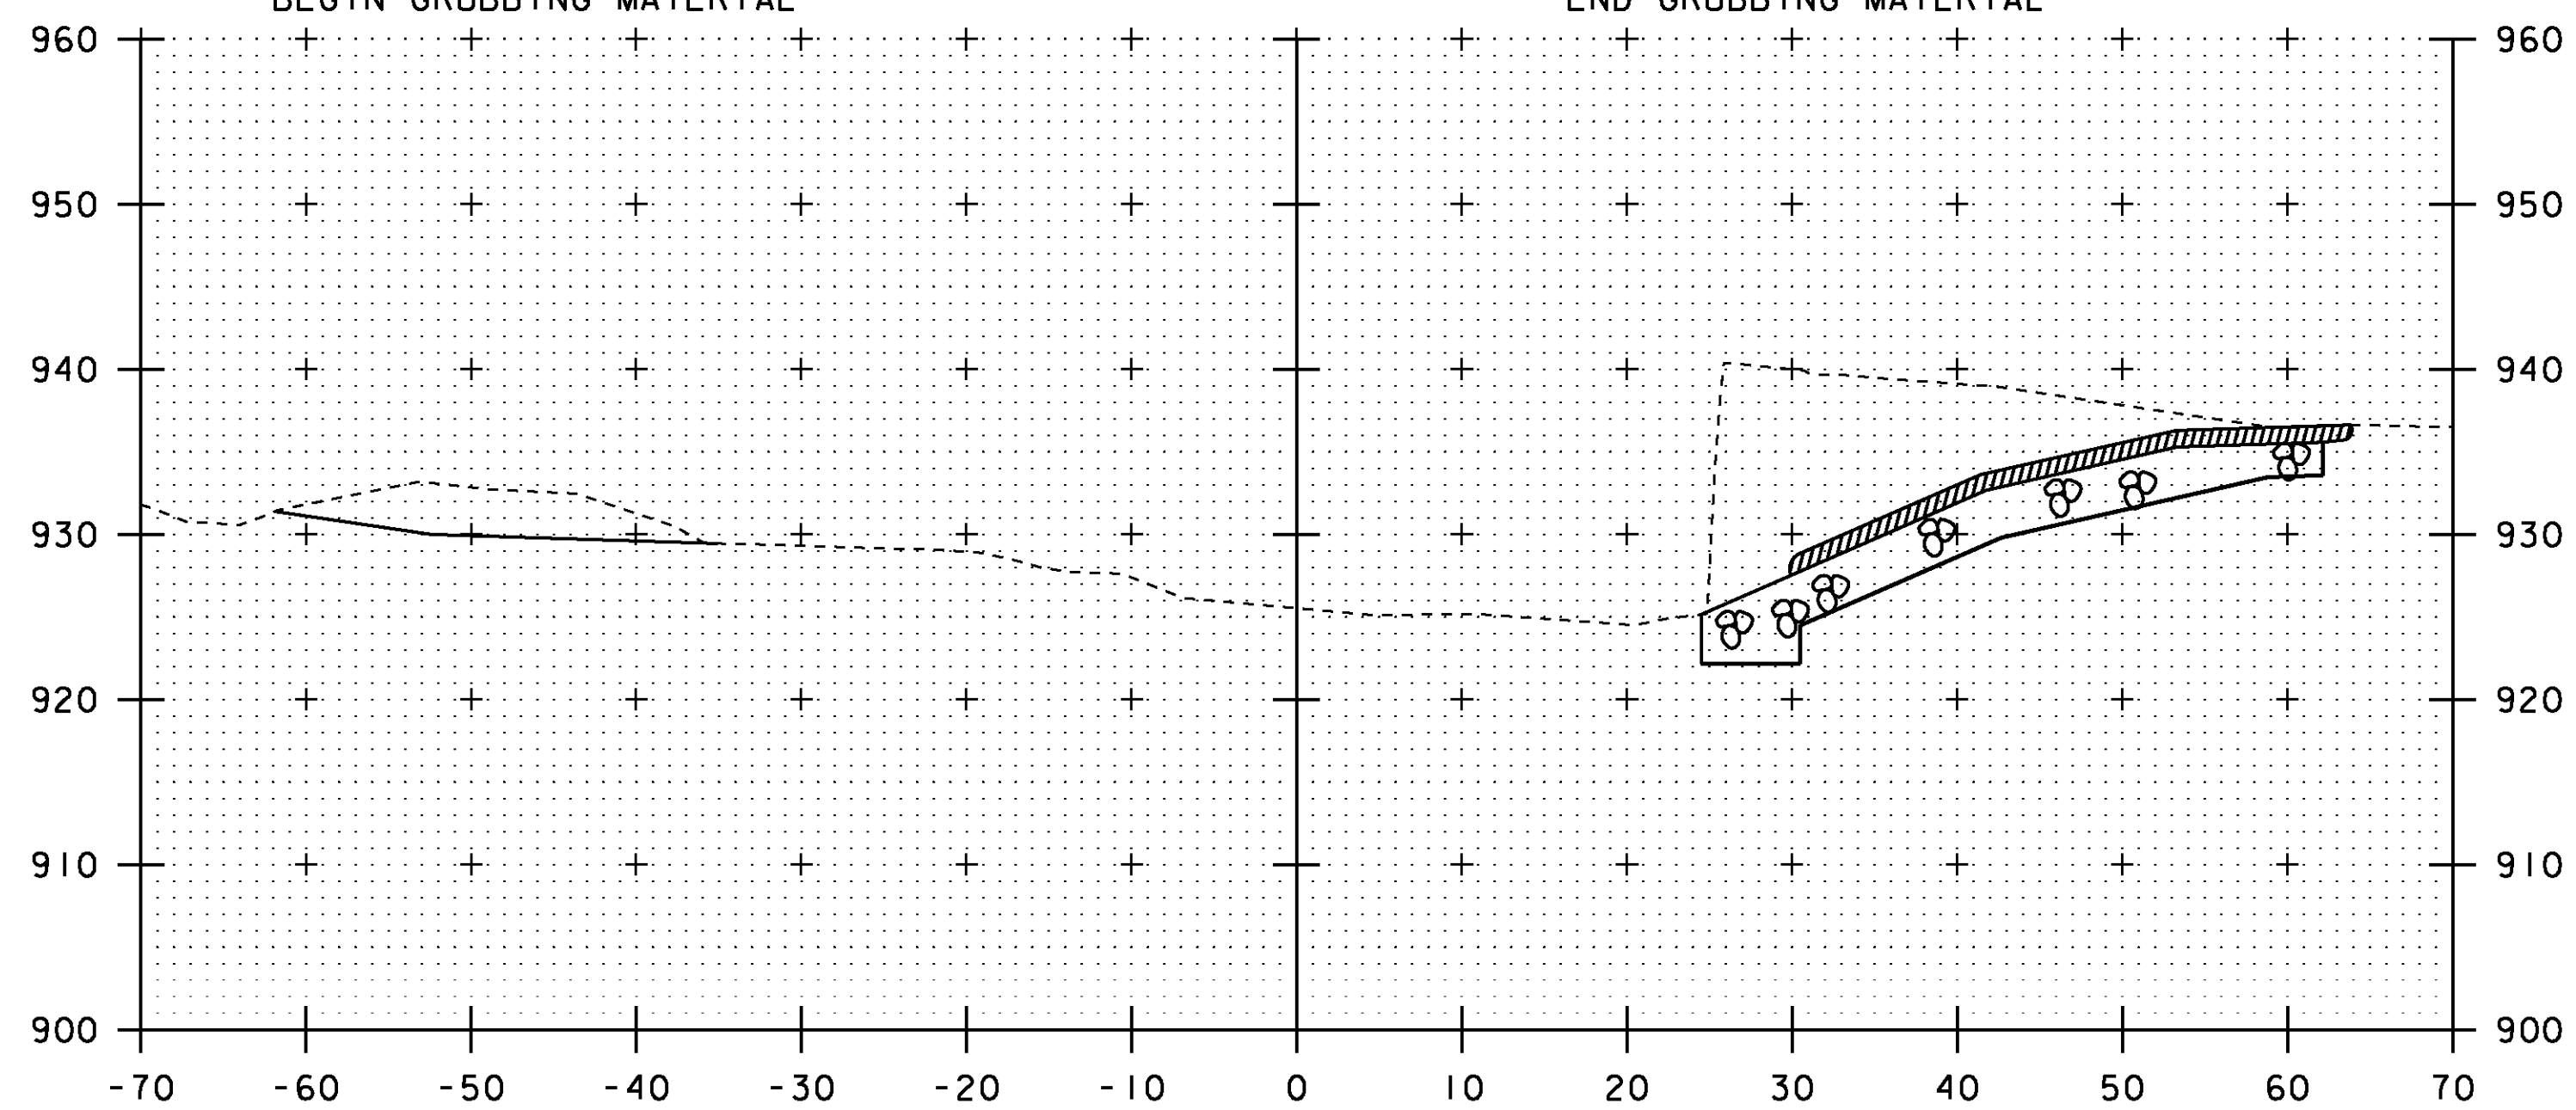

6+00

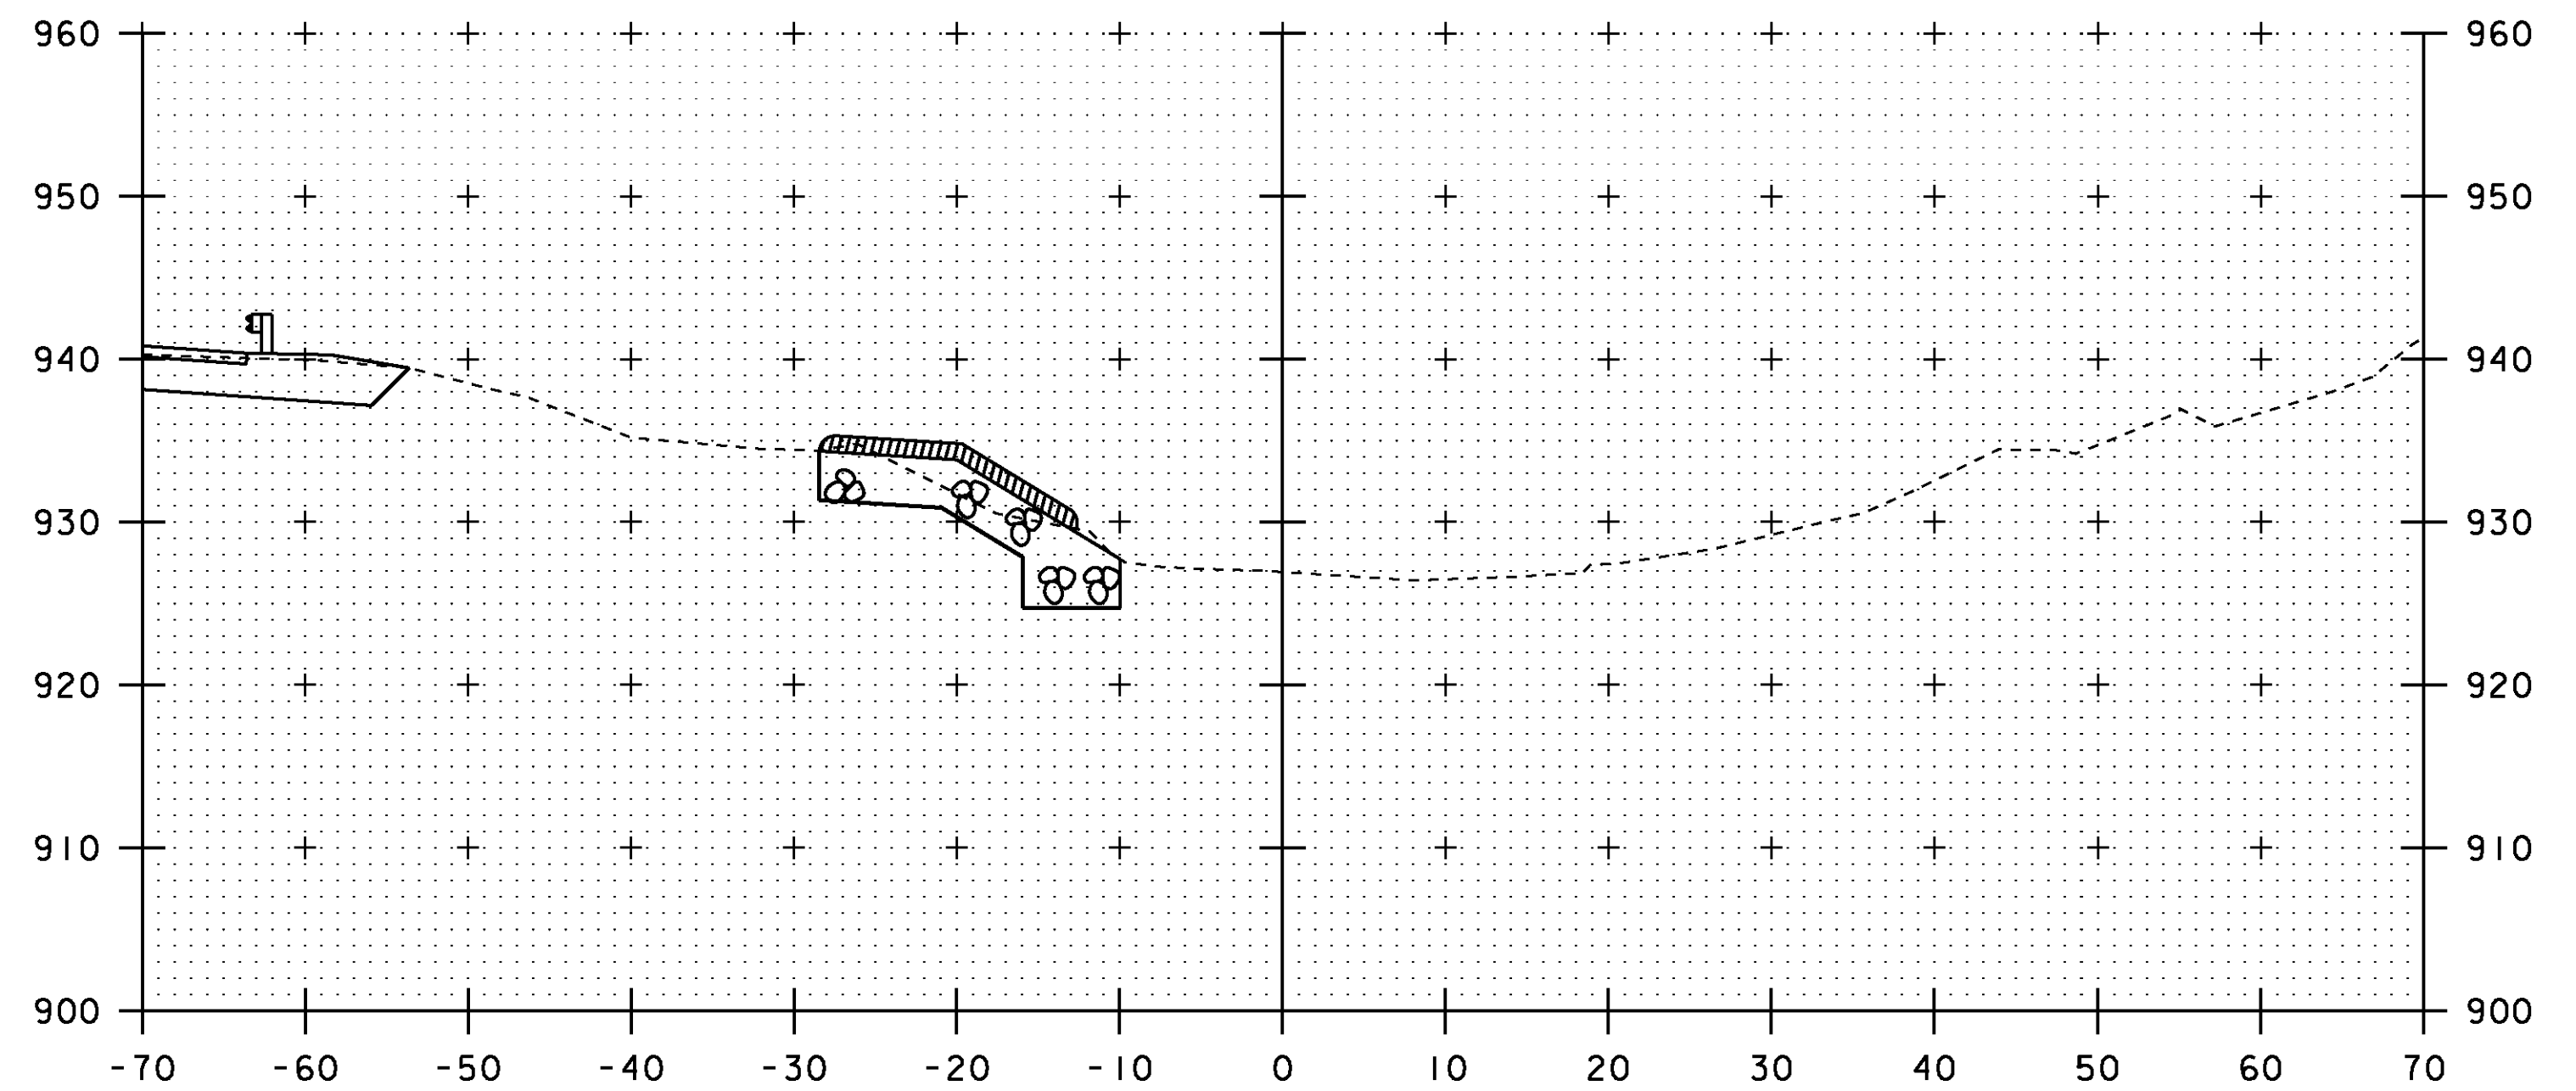


6+75

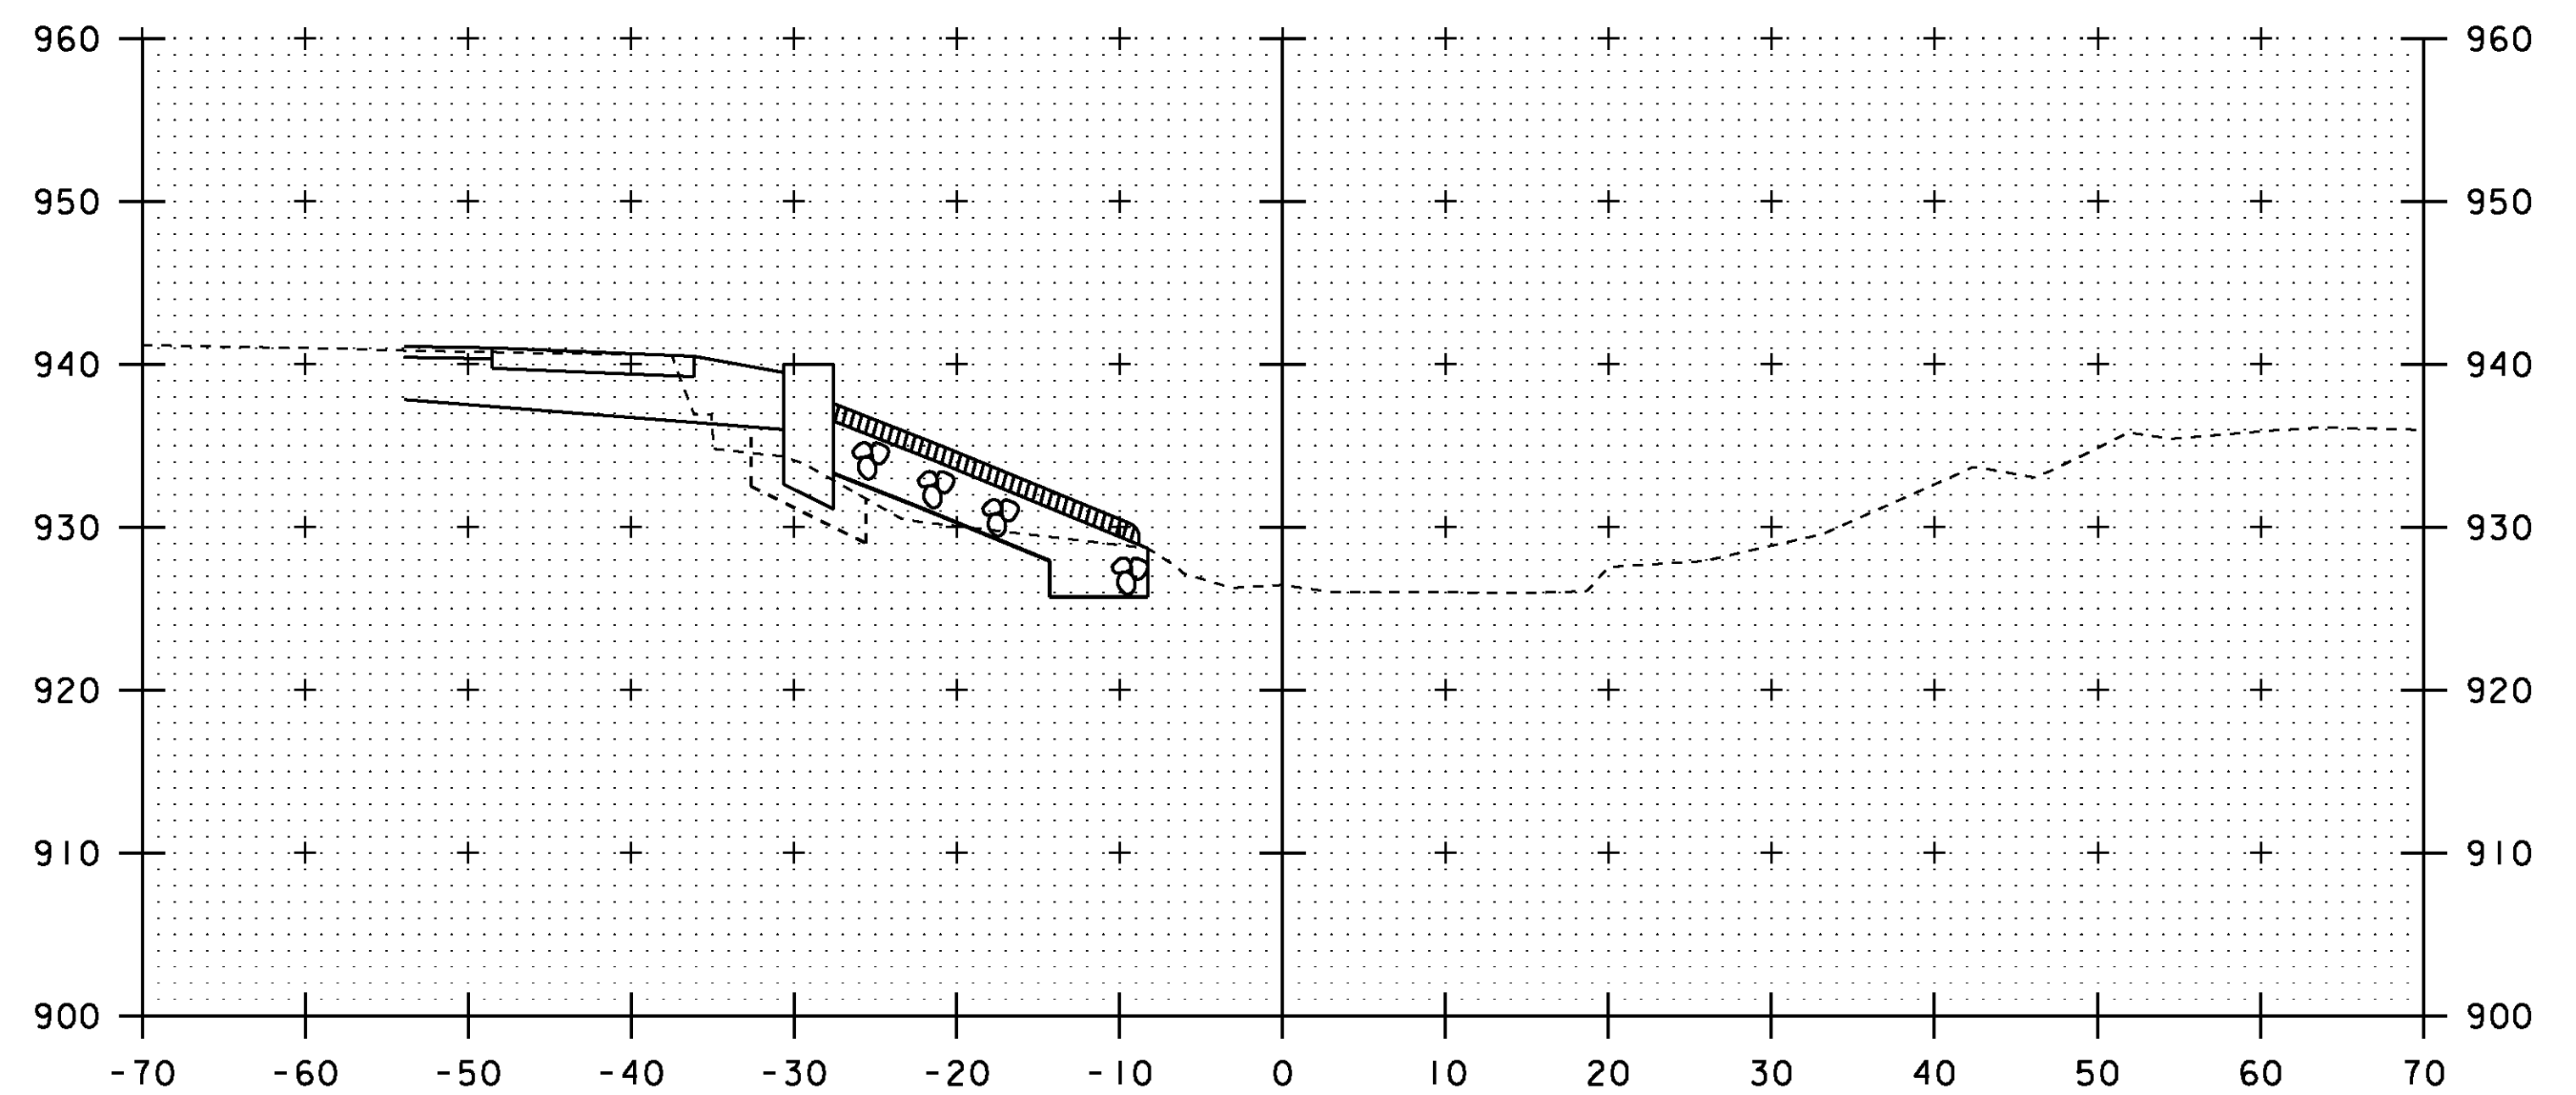

6+50

STA. 6+00 TO STA. 6+75

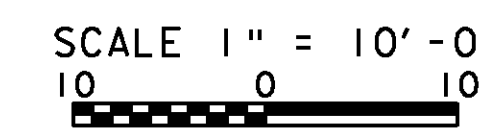

PROJECT:	CHESTER	PROJECT NO.:	BRF 016-1 (25)
DESIGN FILE NAME:	88b194/structures/s88b194xsl.dgn	PLOT DATE:	16-MAR-2011
IPARM FILE NAME:	s88b194ch2.i	DRAWN BY:	M. FESSEL
DESIGNED BY:	E. L. RUSTAY	CHECKED BY:	R. S. YOUNG
SQUAD LEADER:	C. P. WILLIAMS	SHEET:	49 OF 50
CHANNEL CROSS SECTIONS			