


PROJECT DESCRIPTION AND LOCATION

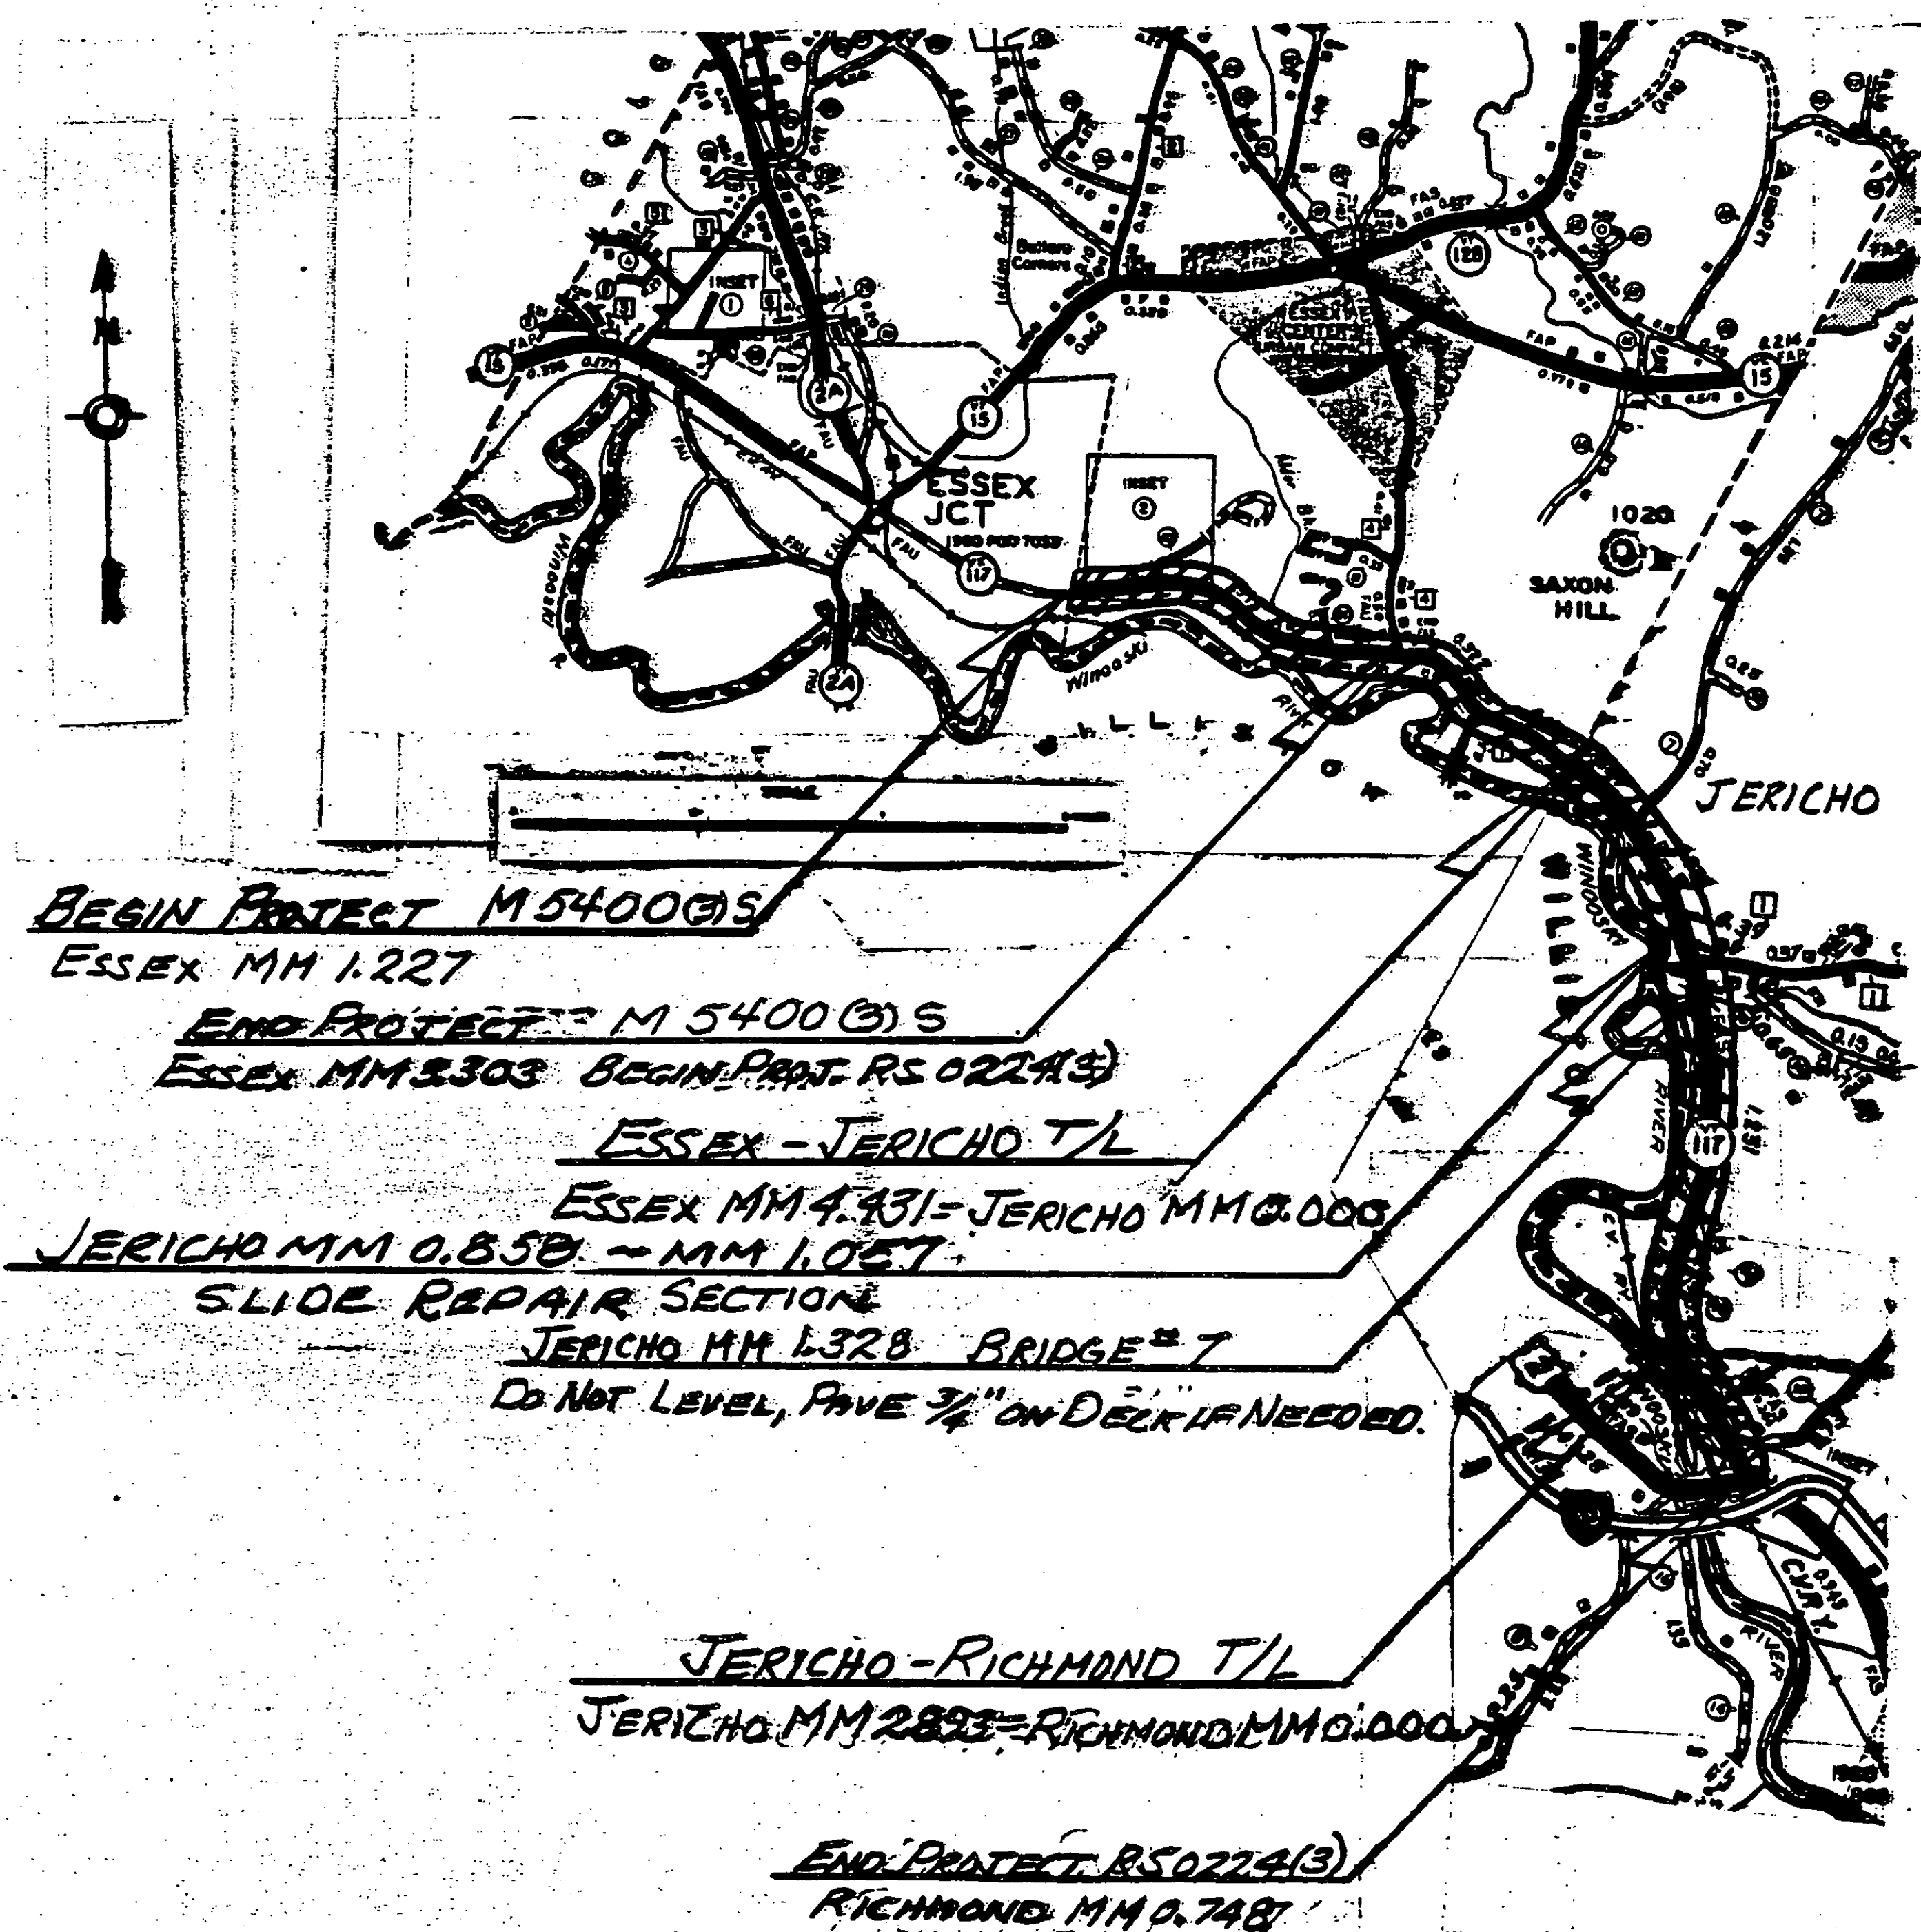

PROJECT LOCATION

ESSEX

BEGINNING AT MM 1.227 ON Vt. 117 IN ESSEX - THE ESSEX JCT VILLAGE LINE - AND PROCEEDING SOUTHEASTERLY 2.076 MILES TO MM 3.303 - THE JCT. WITH TH-4.
 PROJECT LENGTH = 10,960' = 2.076 MI.

ESSEX - JERICHO - RICHMOND RS 0224(3)

BEGINNING AT MM 3303 ON Vt. 117 IN ESSEX - THE JCT. WITH TH-4 - AND PROCEEDING SOUTHEASTERLY 4.769 MILES TO RICHMOND MM 0.748 - THE JCT. OF Vt. 117 AND US 2.
 PROJECT LENGTH = 25,182' = 4.769 MI.

ESSEX
 PROJECT ESSEX - JERICHO - RICHMOND

NO. M 5400(3)S
RS 0224(3)

SHEET 3 OF 60 SHEETS