



# TYPICAL SECTIONS & DESIGN DATA

ITEM 406.25, BITUMINOUS CONCRETE PAVEMENT  
LEVELING COURSE, TYPE III OR IV (22' WIDE), EST. 250 TONS/MI.  
AS DIRECTED BY THE ENGINEER. \*SEE NOTE #1  
1 1/4" WEARING COURSE ( $\pm 1/4$ ") TYPE III (22' WIDE)

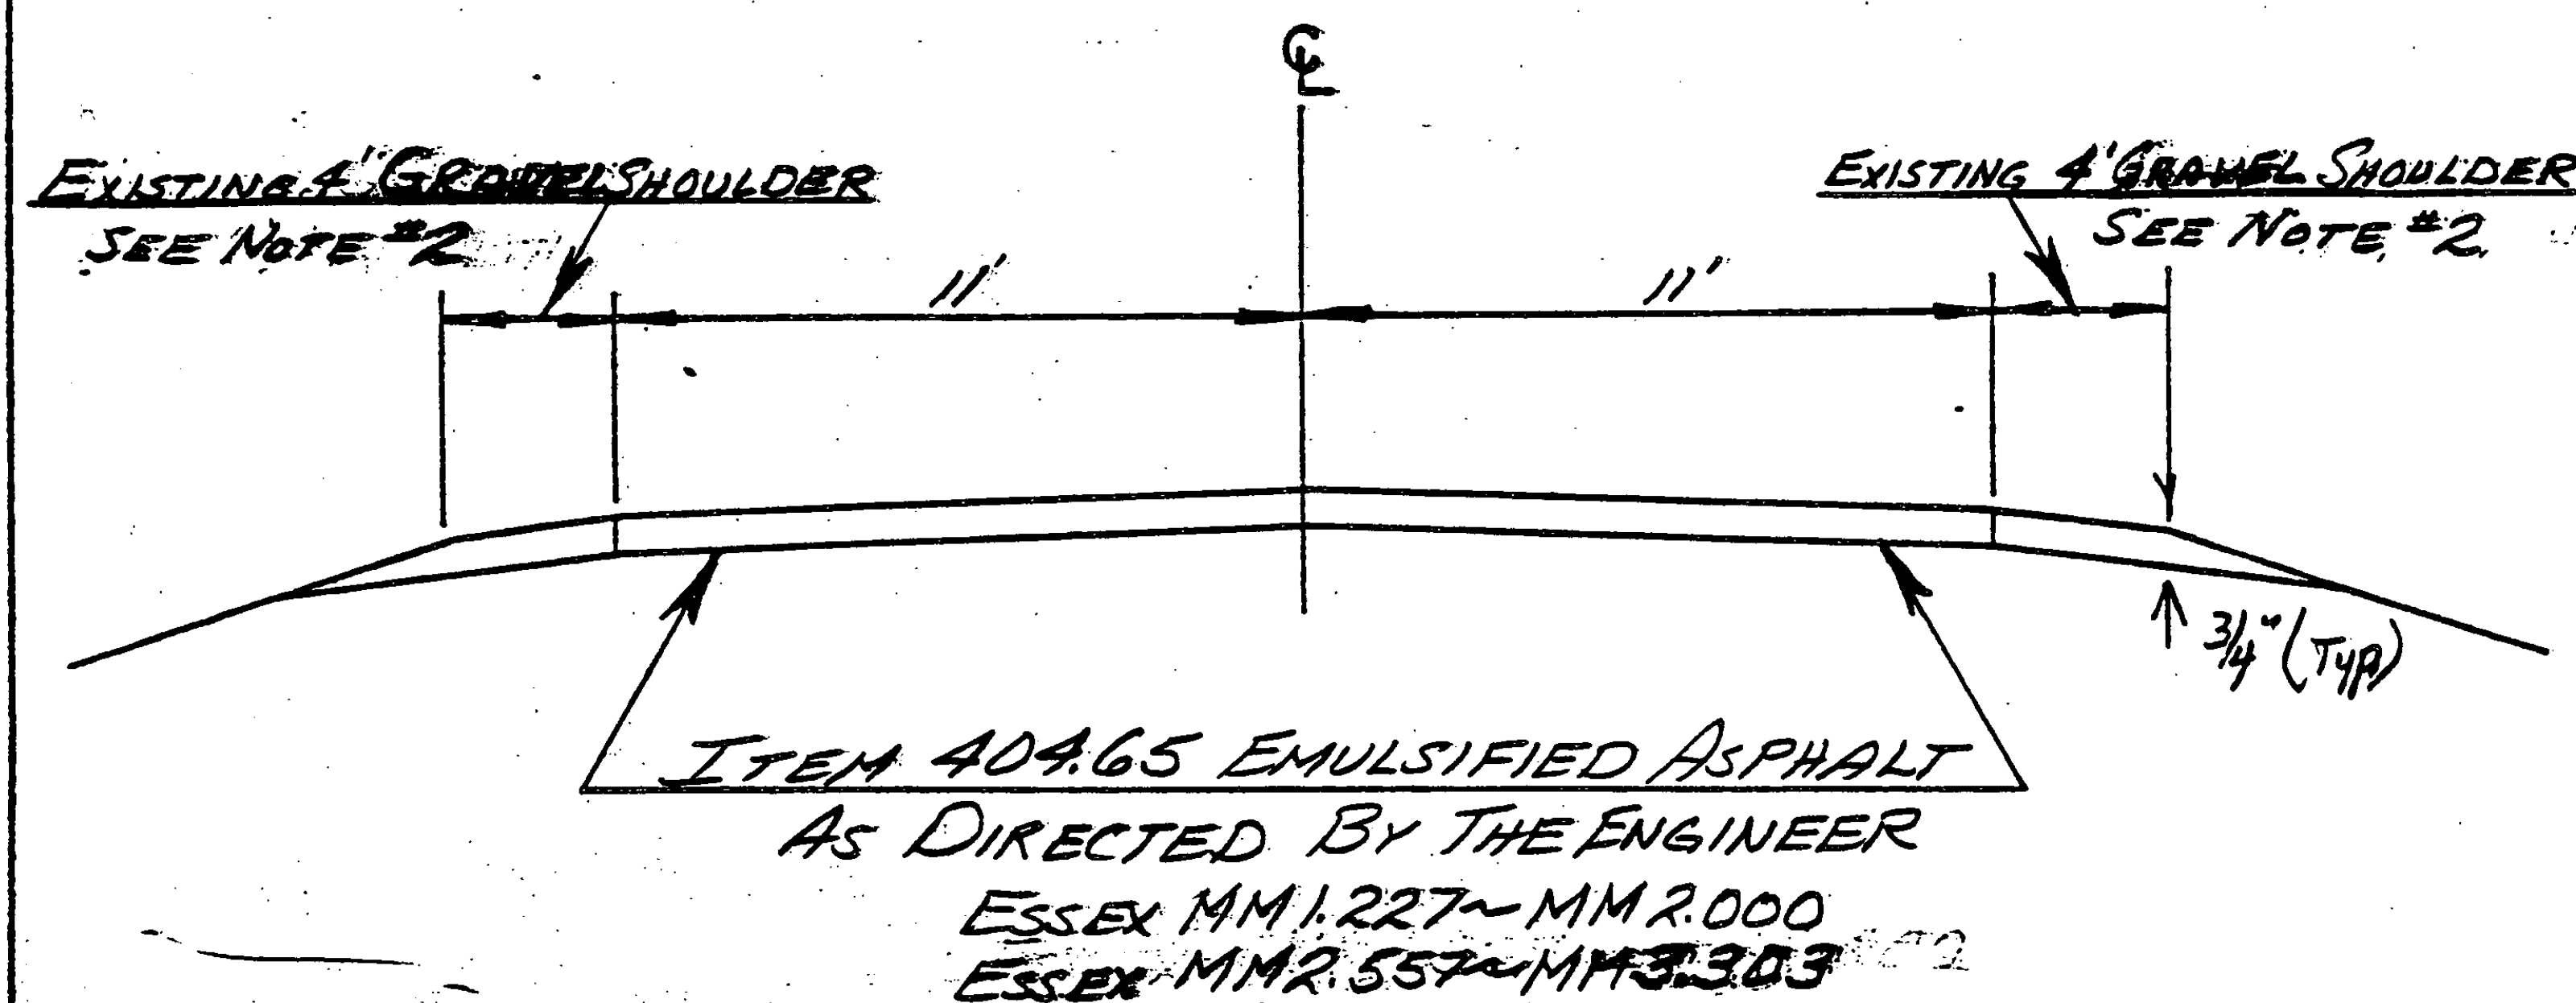

ITEM 406.25, BITUMINOUS CONCRETE PAVEMENT  
LEVELING COURSE, TYPE III OR IV (23' WIDE), EST. 250 TONS/MI.  
AS DIRECTED BY THE ENGINEER. \*SEE NOTE #1  
1 1/4" WEARING COURSE ( $\pm 1/4$ ") TYPE III (23' WIDE)

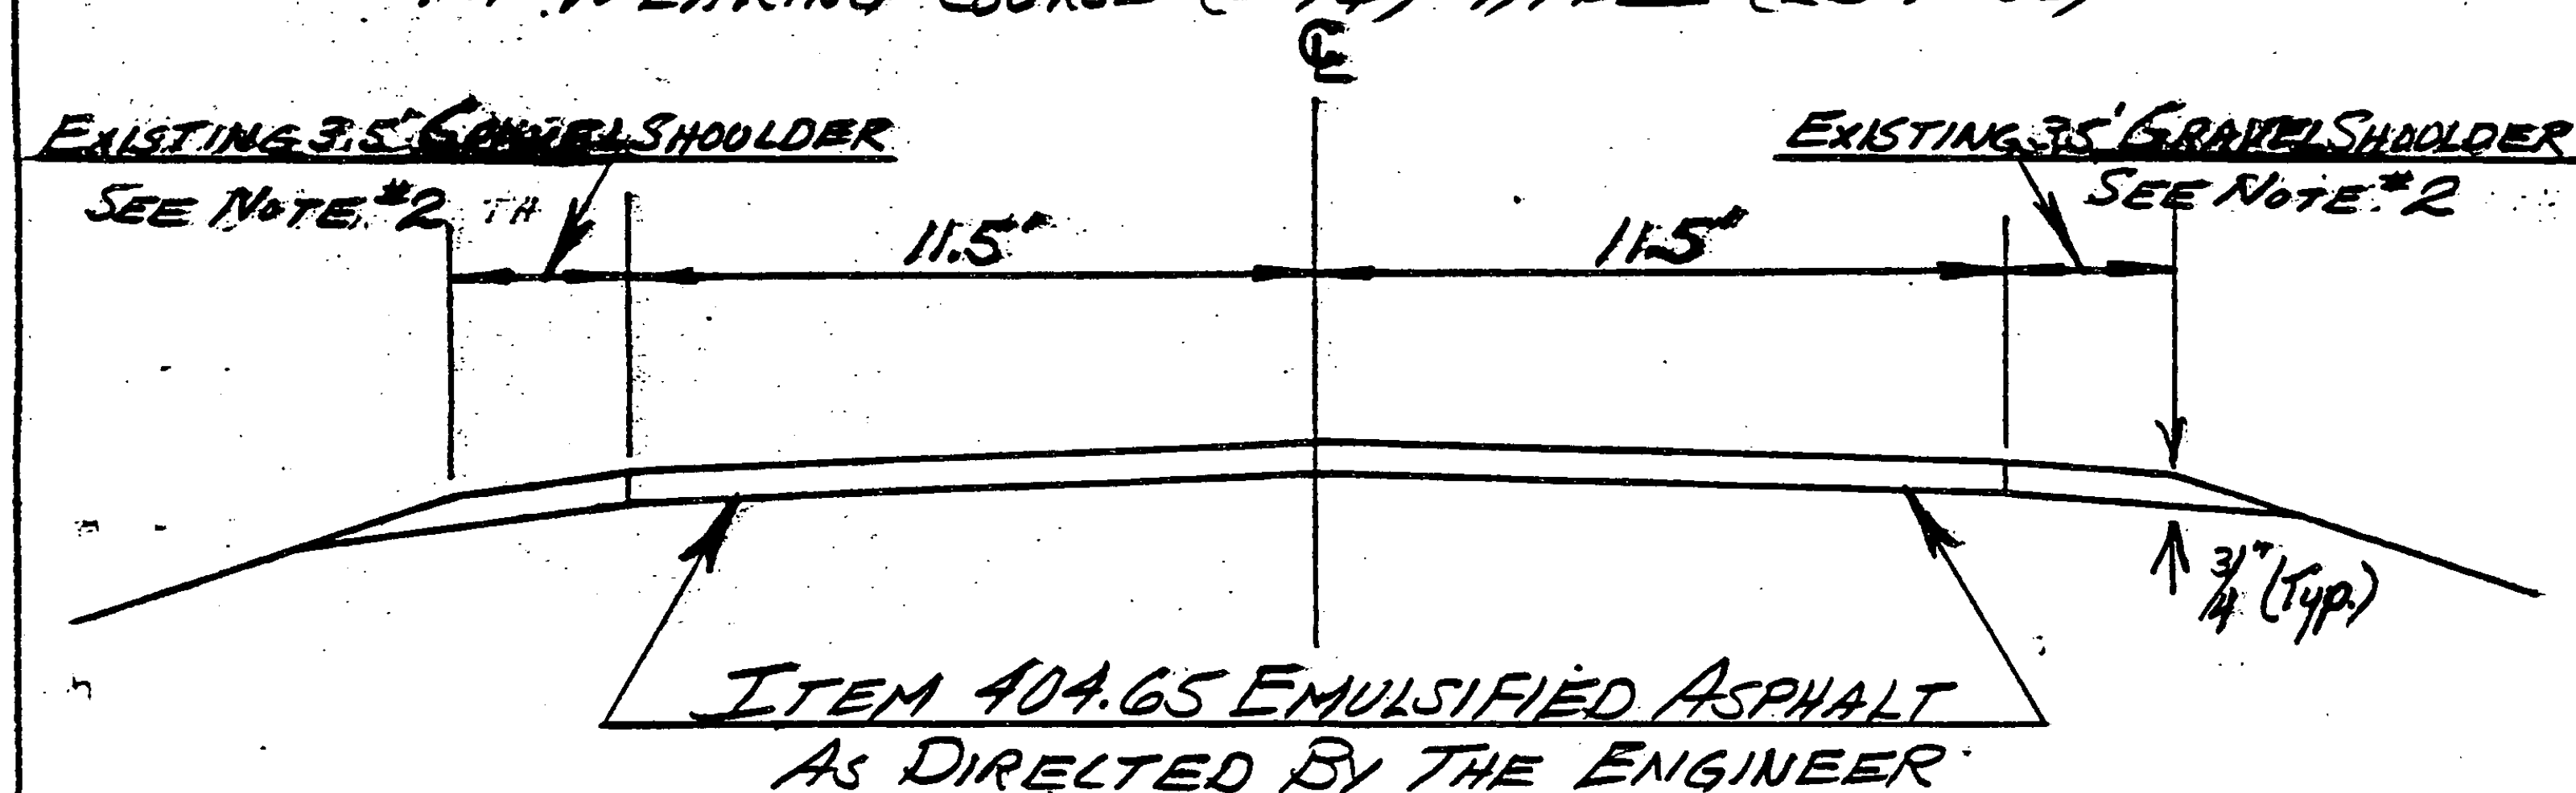

ESSEX MM 2.000 ~ MM 2.200

TRAFFIC DATA  
1982 ADT = 3950  
V = 40

NOTE #1: LEVEL COURSE BASED ON 22' WIDE ROADWAY, QUANTITY FACTORED FOR ACTUAL WIDTH.

NOTE #2: SHOULDERS TO BE PAVED - REFER TO SHEET 60160 FOR DETAILS.

PROJECT ESSEX

NO. M 5400(3) S  
SHEET 4 OF 60