


* NOTE: All Elevations and Dimensions shown on Shear Key.
 Sections may be revised at the discretion of the Engineer.

171732 ~ 171584
 All Stone Fill to be excavated and disposed of prior to excavating for Rock Borrow Shear Key.


17152 RT ~ 2049 R
 New Filter Fabric Material, Type III Item 64912
 17151 RT ~ 2049 R
 Begin New 6" x 288 Underdrain, Item 605101

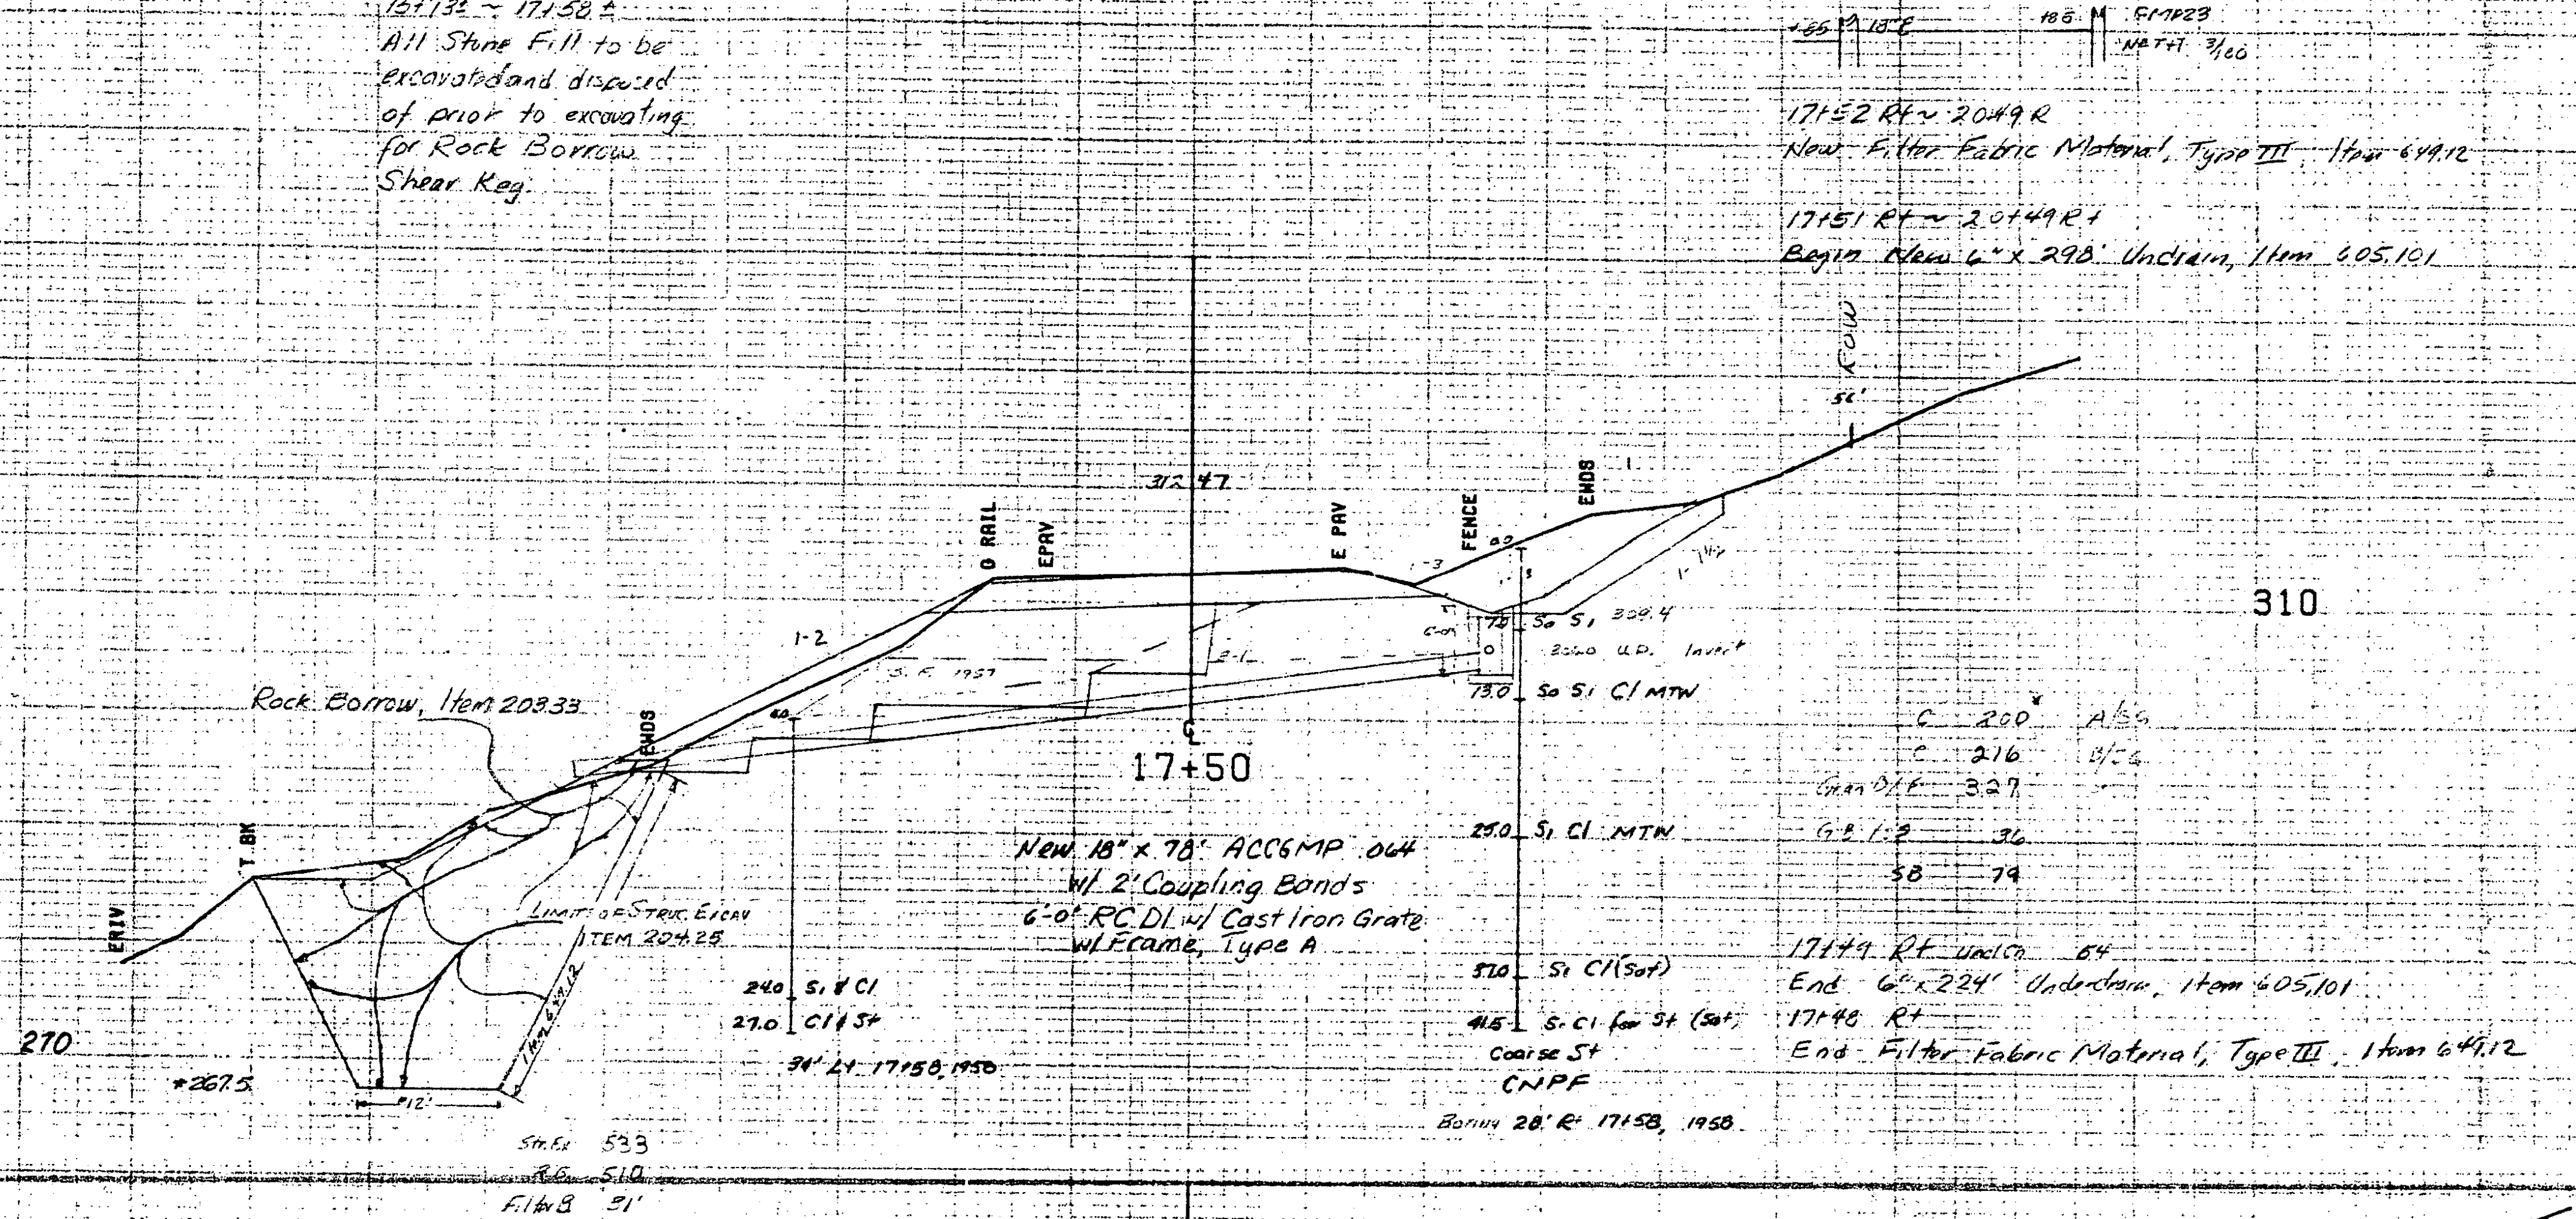

C	200	A/S
C	216	B/S
GRASS	327	
G.S.	32	
S	79	

17149 RT Underdrain 6"
 End 6" x 224' Underdrain, Item 605101
 17148 RT
 End Filter Fabric Material, Type III, Item 64912

SH. E. 996
 R.B. 957
 F.I.B. 42'

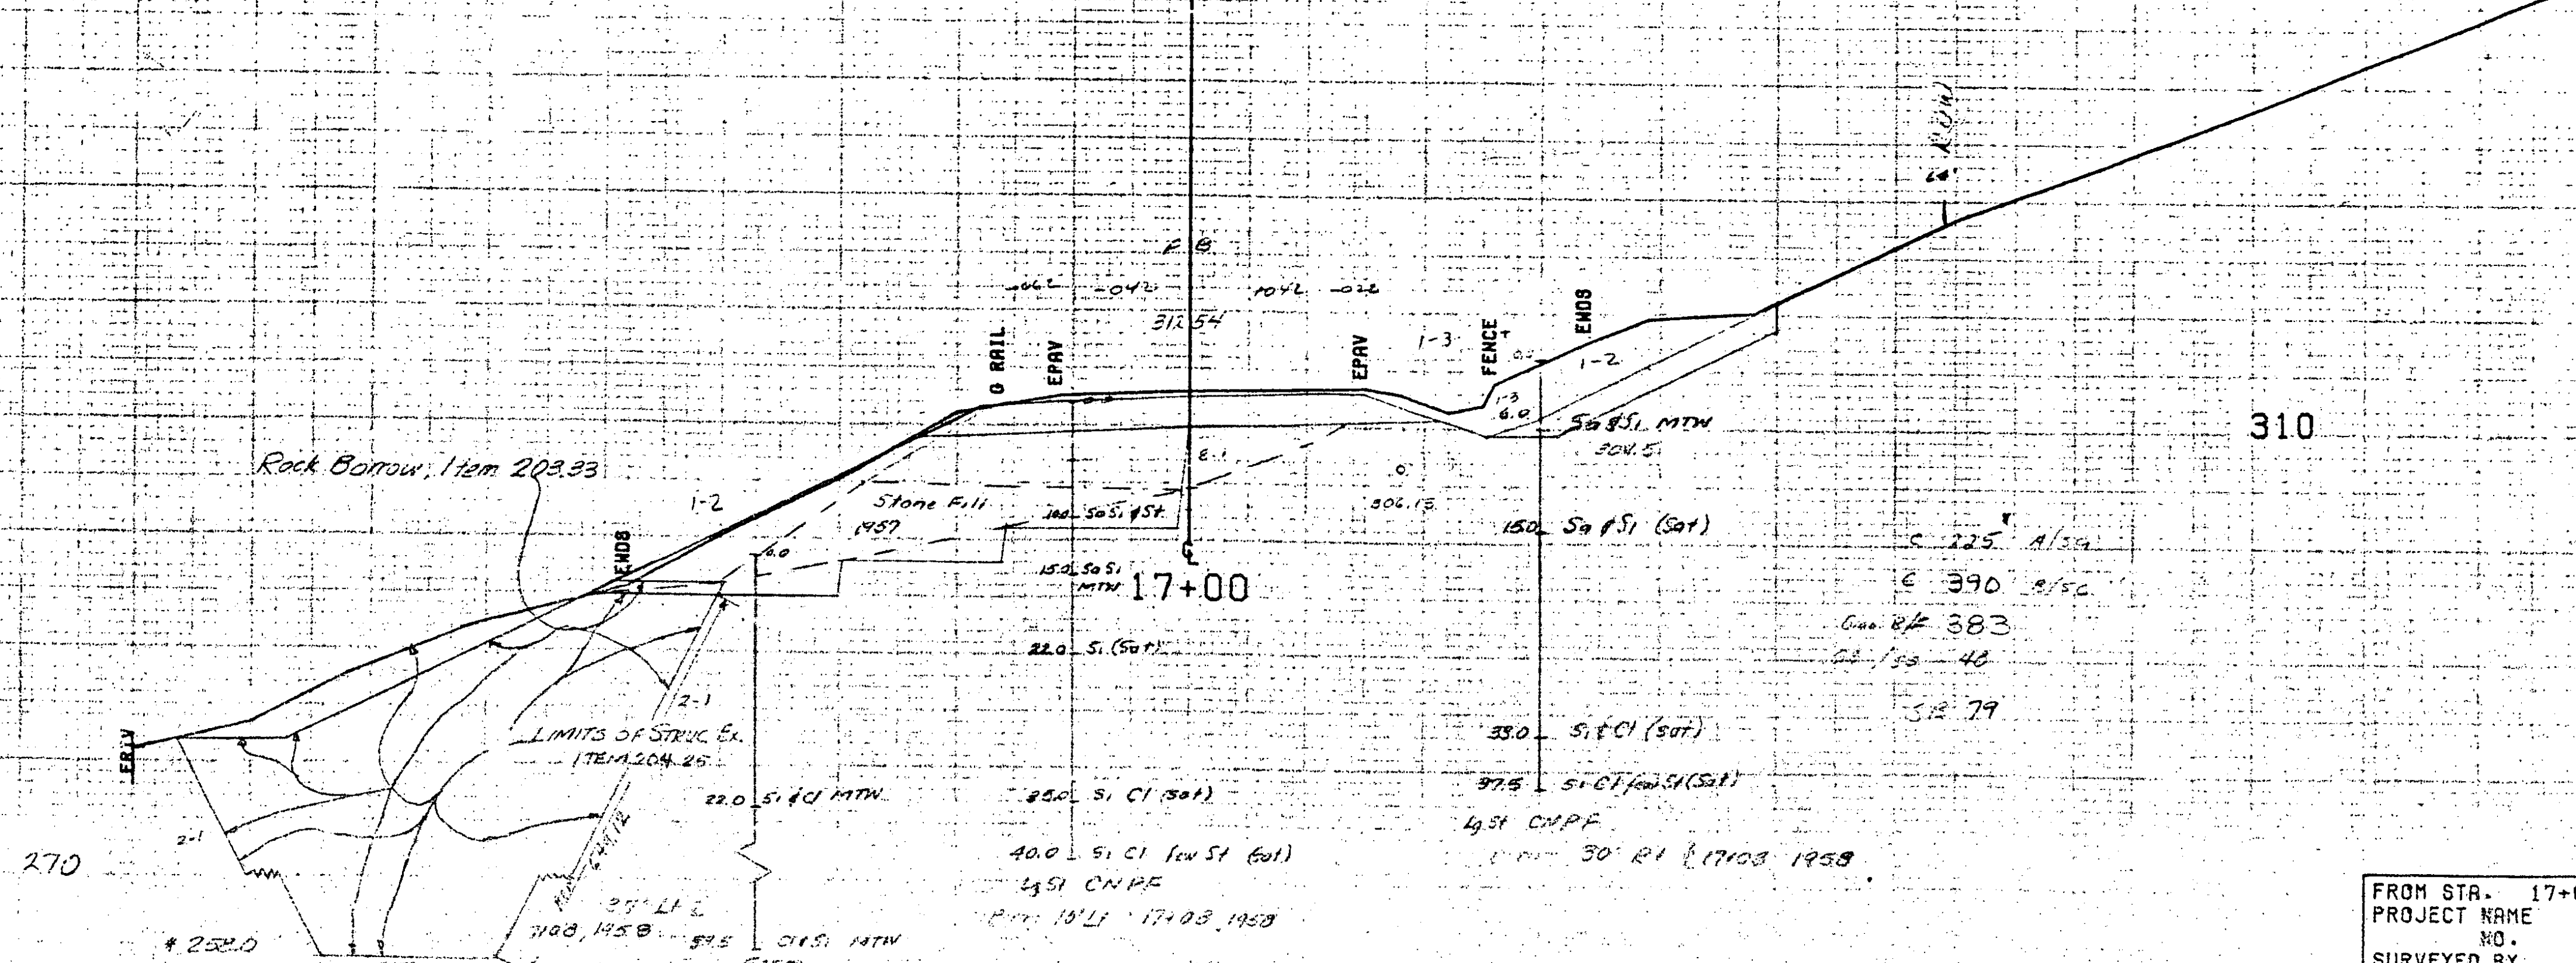

C	225	A/S
C	390	B/S
GRASS	383	
G.S.	40	
S	79	

30' RT (1703 1958)

SCALE 10 FEET