

Record Plans

Contractor: CCS CONSTRUCTORS, INC.
 Resident Engineer: ROBERT SUCKERT
 Construction Began: OCTOBER 19, 2015
 Construction Complete: SEPTEMBER 14, 2017
 Record Plans By: ROBERT SUCKERT


I hereby certify that all construction required by this set of drawings has been accomplished as indicated herein.

BY:  e-Signed by Robert Suckert on 2018-10-09 17:03:33 GMT Resident Engineer

Date: October 09, 2018

NOTE: Any further information concerning final quantities, amounts or other details relative to this project may be found at Central Files in the electronic archives.

STATE OF VERMONT AGENCY OF TRANSPORTATION

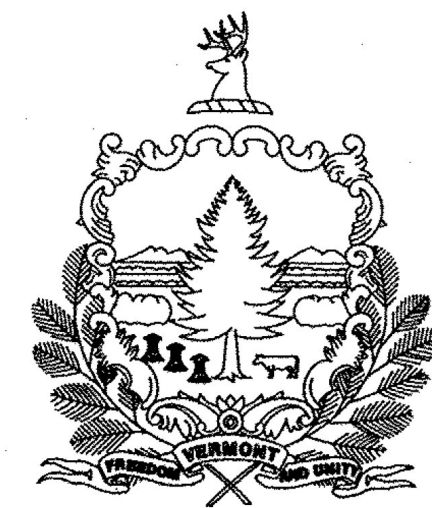


PROPOSED IMPROVEMENT

BRIDGE PROJECT TOWN OF STOWE

COUNTY OF LAMOILLE


VT ROUTE 108 (MAJOR COLLECTOR) BRIDGE NO. 3

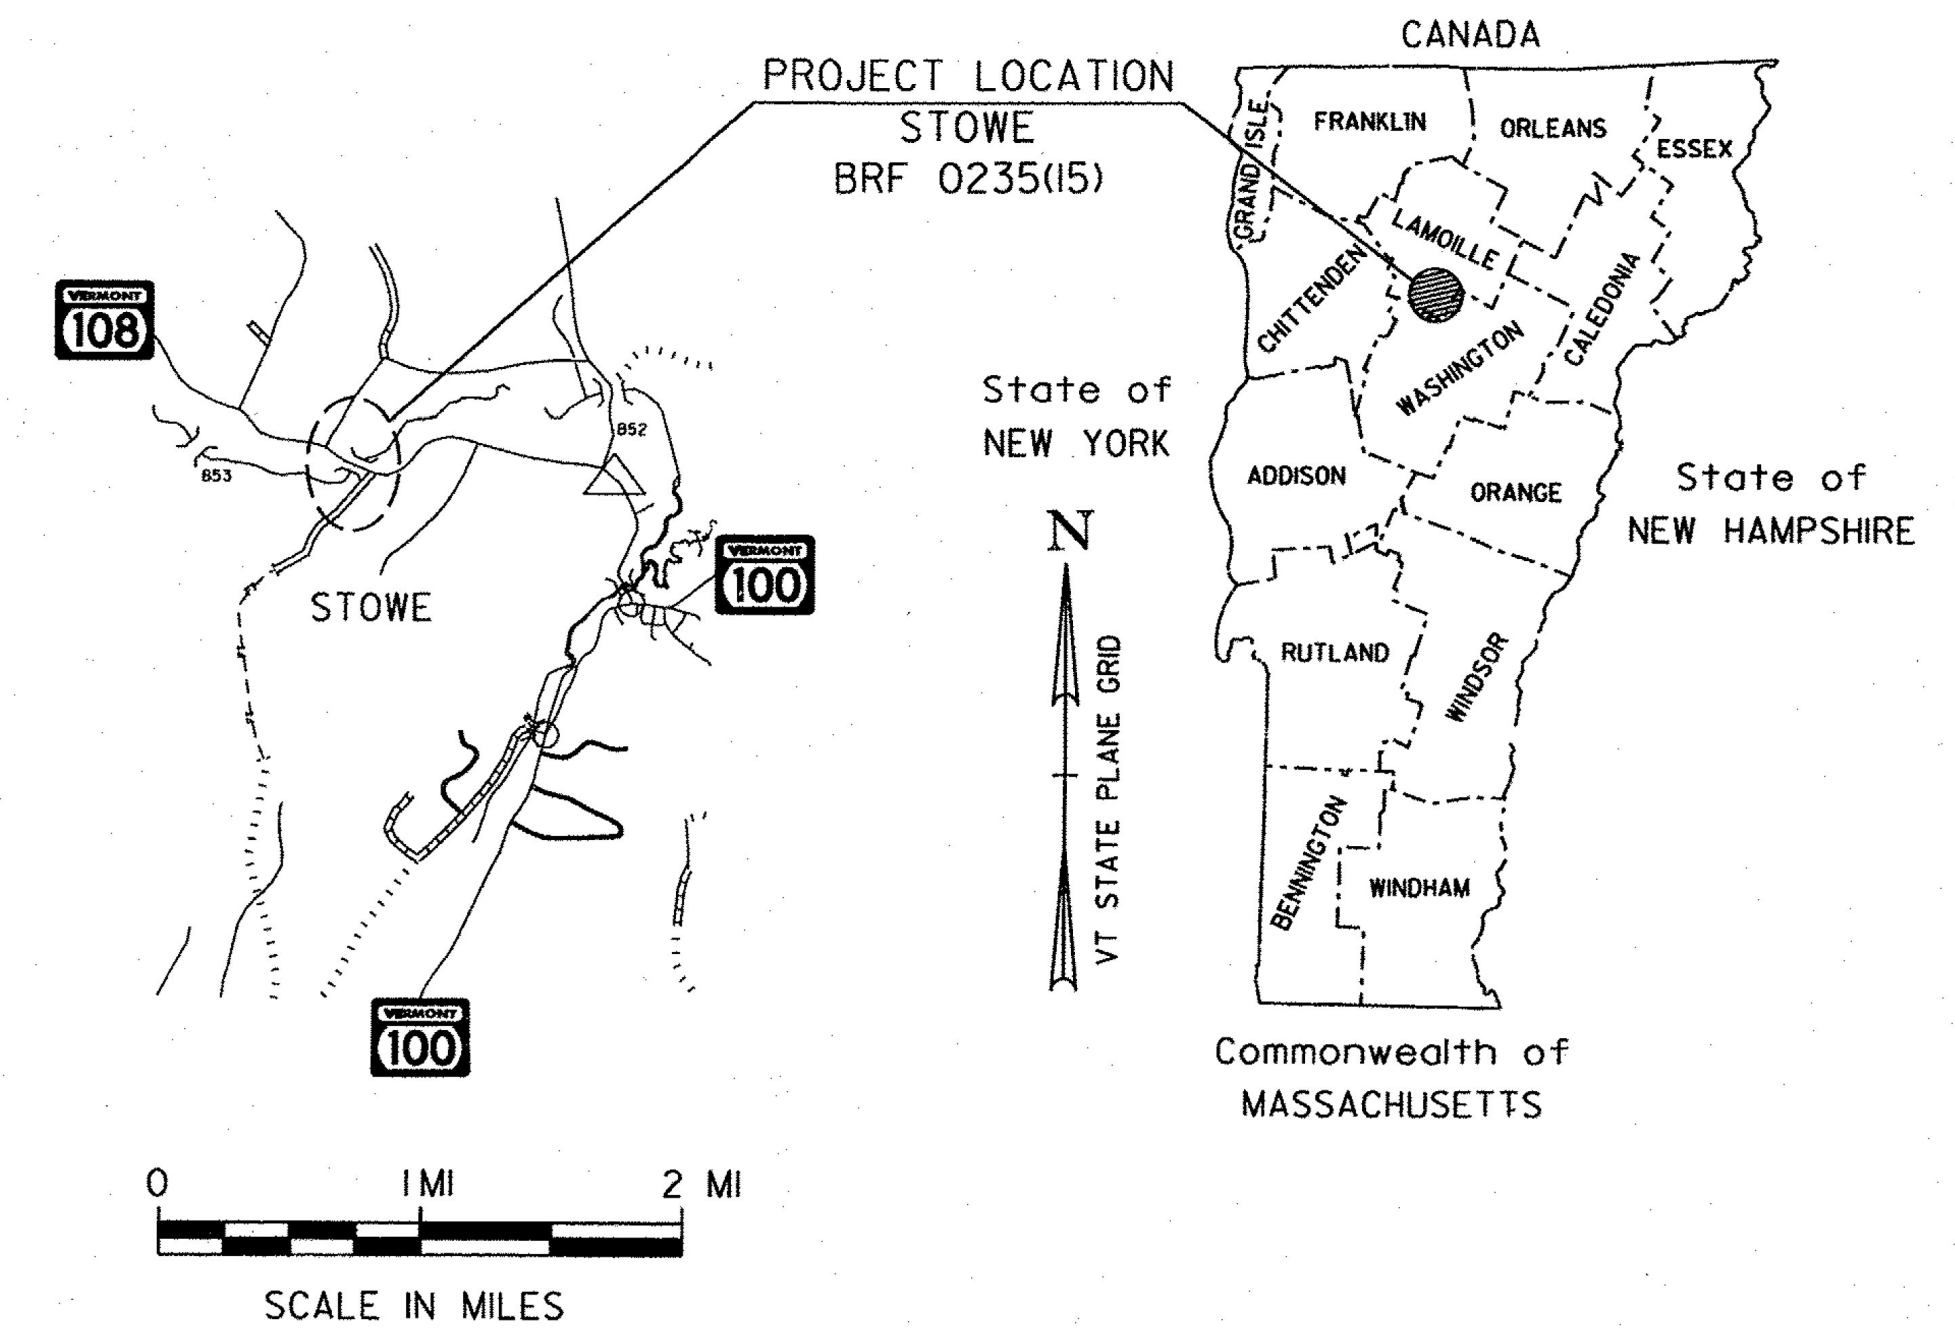

PROJECT LOCATION: LOCATED IN TOWN OF STOWE ON VT ROUTE 108 APPROXIMATELY 1.5 MILES WEST OF THE JUNCTION WITH VT ROUTE 100.

PROJECT DESCRIPTION: WORK TO BE PERFORMED UNDER THIS PROJECT INCLUDES REPLACEMENT OF EXISTING STRUCTURE WITH A NEW STRUCTURE INCLUDING RELATED ROADWAY ITEMS, TEMPORARY BRIDGE, AND CHANNEL WORK.

LENGTH OF STRUCTURE: 146.80 FEET
LENGTH OF ROADWAY: 753.20 FEET
LENGTH OF PROJECT: 900.00 FEET

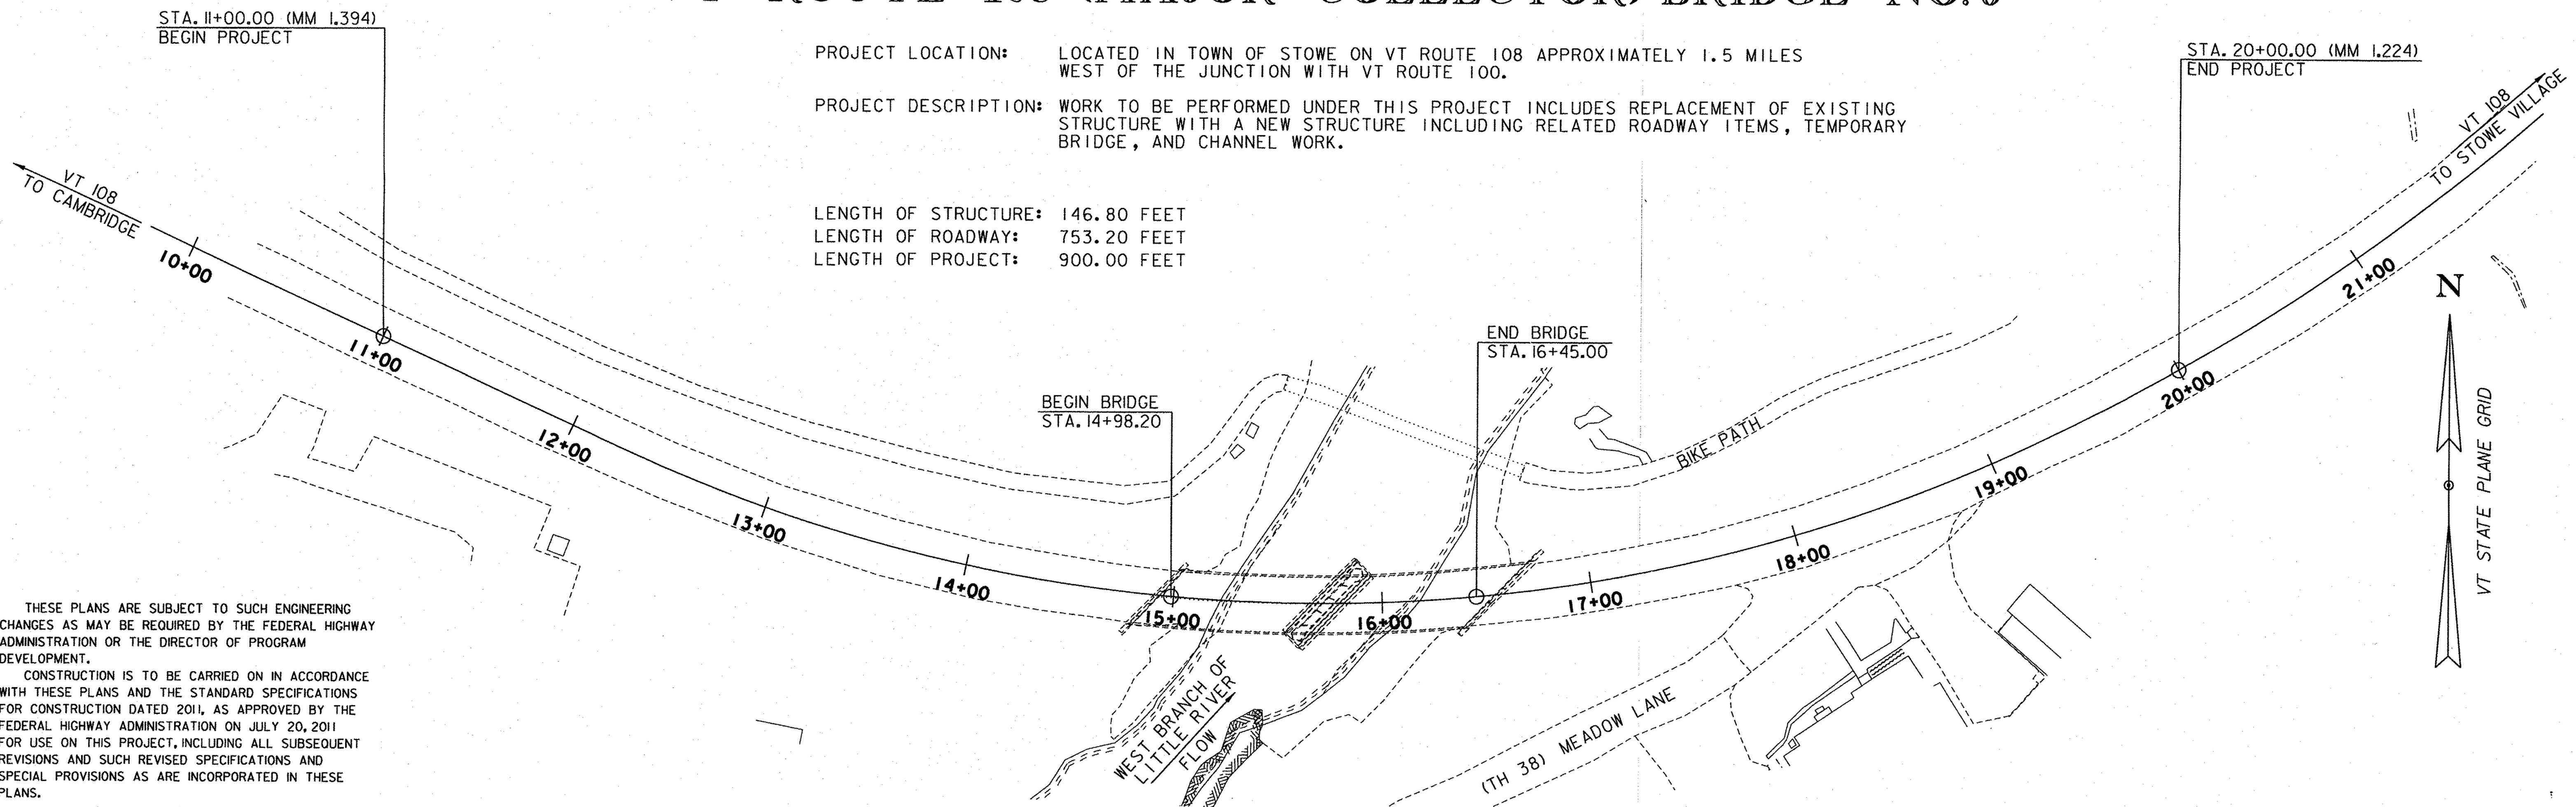

THESE PLANS ARE SUBJECT TO SUCH ENGINEERING CHANGES AS MAY BE REQUIRED BY THE FEDERAL HIGHWAY ADMINISTRATION OR THE DIRECTOR OF PROGRAM DEVELOPMENT.

CONSTRUCTION IS TO BE CARRIED ON IN ACCORDANCE WITH THESE PLANS AND THE STANDARD SPECIFICATIONS FOR CONSTRUCTION DATED 2011, AS APPROVED BY THE FEDERAL HIGHWAY ADMINISTRATION ON JULY 20, 2011 FOR USE ON THIS PROJECT, INCLUDING ALL SUBSEQUENT REVISIONS AND SUCH REVISED SPECIFICATIONS AND SPECIAL PROVISIONS AS ARE INCORPORATED IN THESE PLANS.

QUALITY ASSURANCE PROGRAM : LEVEL 2
SURVEYED BY : VTRANS
SURVEYED DATE : 07/20/2011
DATUM
VERTICAL NAVD 88
HORIZONTAL NAD83 (1996)

SCALE 1" = 40'-0"
 40 0 40

		 540 Commercial Street Manchester, NH 03101 (603) 668-8223 www.cldengineers.com	DIRECTOR OF PROJECT DELIVERY
			APPROVED <i>Kevin J. Marshic</i> DATE 5/1/15
			PROJECT MANAGER : ROB YOUNG, P.E.
			PROJECT NAME : STOWE
			PROJECT NUMBER : BRF 0235 (15)
			SHEET 1 OF 79 SHEETS

MODEL: TITLE
 CLD 12-0120