

QUANTITY SHEET 3


SUMMARY OF ESTIMATED QUANTITIES										TOTALS		DESCRIPTIONS				DETAILED SUMMARY OF QUANTITIES		
				ROADWAY	TRAINING	LANDSCAPING	EROSION CONTROL	BRIDGE	FULL C.E. ITEMS	GRAND TOTAL	FINAL	UNIT	ITEMS	ITEM NUMBER	ROUND	QUANTITIES	UNIT	ITEMS
				2250						2250		LF	TEMPORARY 4 INCH WHITE LINE, PAINT	646.602	1			
				2200						2200		LF	TEMPORARY 4 INCH YELLOW LINE, PAINT	646.612	-			
				15						15		LF	TEMPORARY 24 INCH STOP BAR, PAINT	646.682	4			
				4						4		EACH	TEMPORARY LETTER OR SYMBOL, PAINT	646.692	-			
							230	705		935		SY	GEOTEXTILE UNDER STONE FILL	649.31	5.6			
							560			560		SY	GEOTEXTILE FOR SILT FENCE	649.51	3			
							300			300		SY	GEOTEXTILE FOR SILT FENCE, WOVEN WIRE REINFORCED	649.515	1			
							180			180		SY	GEOTEXTILE FOR FILTER CURTAIN	649.61	6			
							110			110		LB	SEED	651.15	1			
							380			380		LB	FERTILIZER	651.18	3			
							1.5			1.5		TON	AGRICULTURAL LIMESTONE	651.20	0.1			
							1.5			1.5		TON	HAY MULCH	651.25	0.1			
				370						370		CY	TOPSOIL	651.35	8			
							155	133		288		SY	GRUBBING MATERIAL	651.40	3			
							1			1		LS	EPSC PLAN	652.10	-			
							180			180		HR	MONITORING EPSC PLAN	652.20	1			
							4500			4500		LU	MAINTENANCE OF EPSC PLAN (N.A.B.I.)	652.30	25			
							800			800		SY	TEMPORARY EROSION MATTING	653.20	7			
							450			450		LF	BARRIER FENCE	653.50	15			
							1625			1625		LF	PROJECT DEMARCATION FENCE	653.55	9			
										3		EACH	EVERGREEN TREES (PICEA OMORICA) (B&B) (7' - 8' HEIGHT)	656.20	-			
										18		EACH	EVERGREEN TREES (PICES GLAUCA) (B&B) (7' - 8' HEIGHT)	656.20	-			
										20		EACH	DECIDUOUS SHRUBS (CORNUS SERICEA ARCTIC FIRE) (CONT.) (2 GALLON)	656.35	-			
										20		MGAL	LANDSCAPE WATERING	656.65	4			
							225			225		CY	LANDSCAPE BACKFILL, TRUCK MEASUREMENT	656.80	6			
										1		LS	TREE PROTECTION	656.85	-			
				1						1		SF	TRAFFIC SIGNS, TYPE A	675.20	0.16			
				50						50		LF	SQUARE TUBE SIGN POST AND ANCHOR	675.341	-			
				2						2		EACH	REMOVING SIGNS	675.50	-			
				1						1		EACH	ERECTING SALVAGED SIGNS	675.60	-			
				1						1		LU	PRICE ADJUSTMENT, FUEL (N.A.B.I.)	690.50	-			
				13						13		EACH	SPECIAL PROVISION (CPM SCHEDULE)	900.620	-			
				1						1		LU	SPECIAL PROVISION (MAT DENSITY PAY ADJUSTMENT, SMALL QUANTITY) (N.A.B.I.)	900.650	-			
				1						1		LU	SPECIAL PROVISION (MIXTURE PAY ADJUSTMENT) (N.A.B.I.)	900.650	-			
								371		371		SF	SPECIAL PROVISION (RETAINING WALL)	900.670	-			
				25						25		SY	SPECIAL PROVISION (HAND-PLACED BITUMINOUS CONCRETE MATERIAL, DRIVES)	900.675	3			
				1450						1450		TON	SPECIAL PROVISION (BITUMINOUS CONCRETE PAVEMENT, SMALL QUANTITY)	900.680	49			

SPECIAL PROVISION (BITUMINOUS CONCRETE PAVEMENT, SMALL QUANTITY)

792 TON TYPE IIS (VT108)
67 TON TYPE IIS (MEADOW LANE)
542 TON TYPE IIS (VT108)

1401 TON SUBTOTAL
49 TON ROUNDING
1450 TON TOTAL

CLD 12-0120 MODEL: OS*3

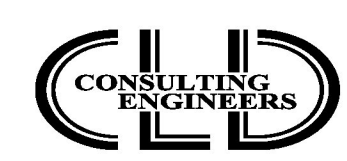

PROJECT NAME: STOWE
PROJECT NUMBER: BRF 0235(15)

FILE NAME: z88ci90qty.dgn
PROJECT LEADER: J. BYATT
DESIGNED BY: K. RUTTER
QUANTITY SHEET 3

PLOT DATE: 5/8/2015
DRAWN BY: K. RUTTER
CHECKED BY: C. GREGORY
SHEET 10 OF 79