

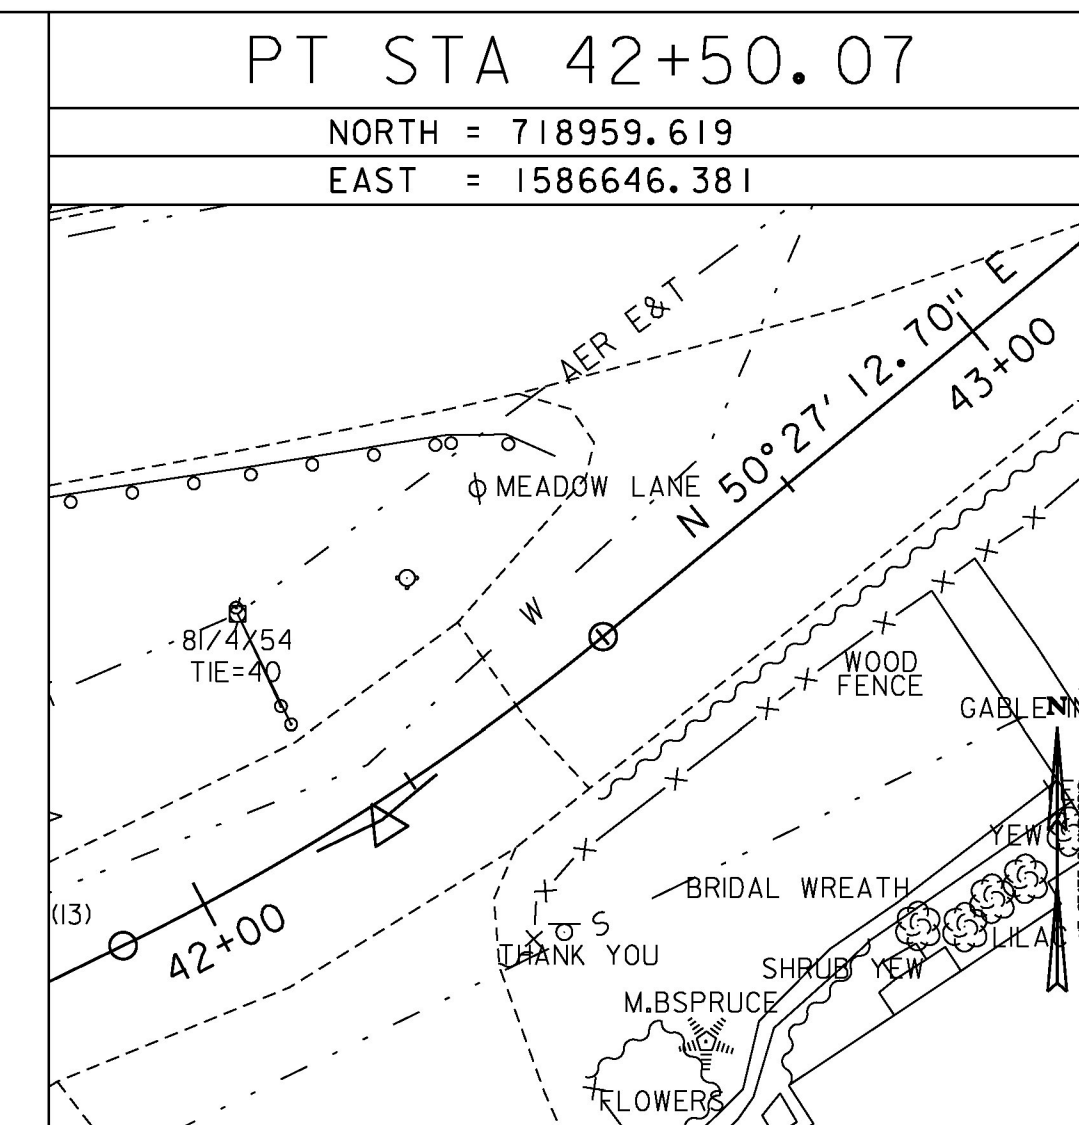
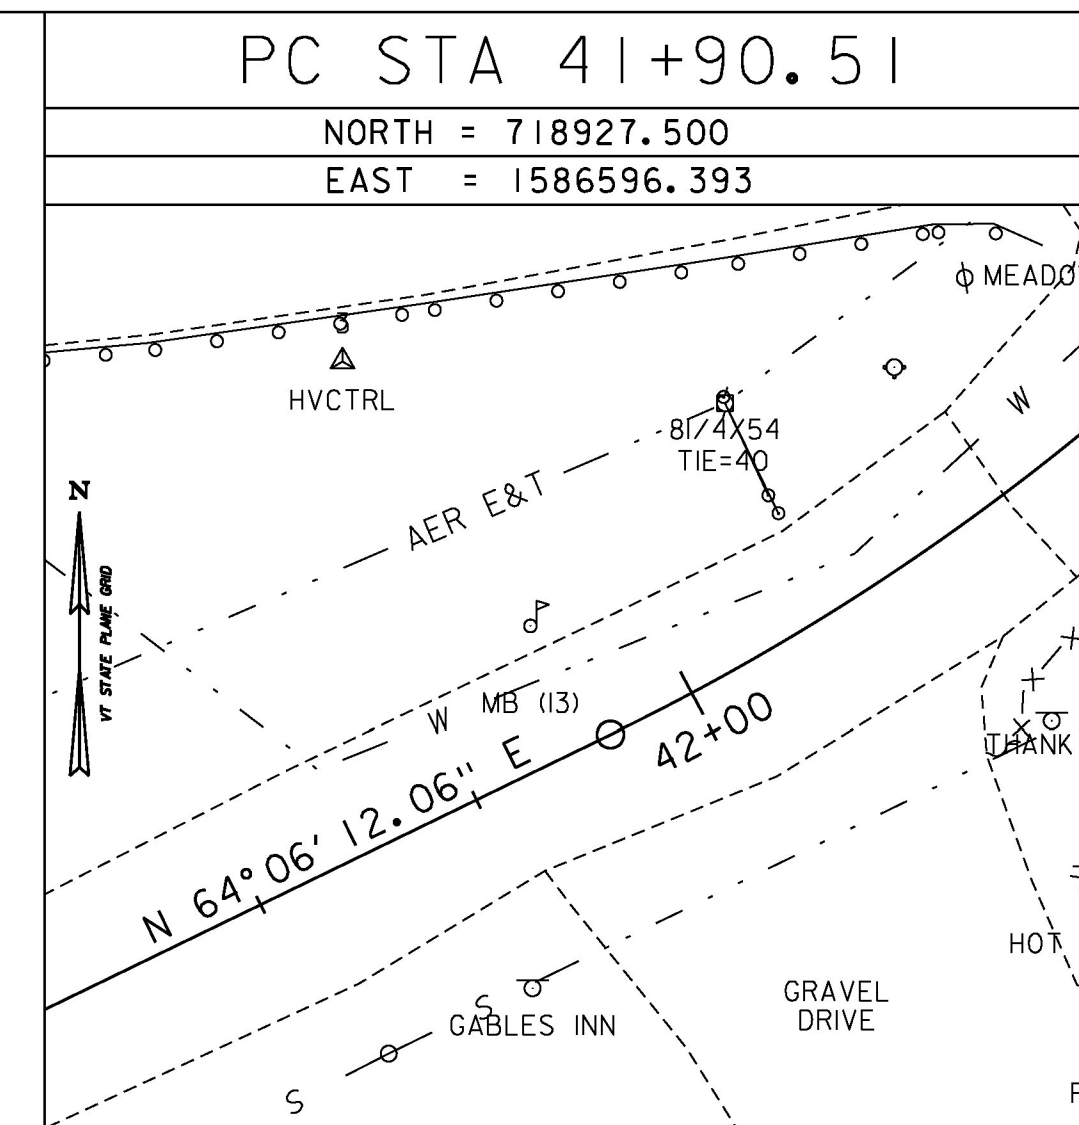
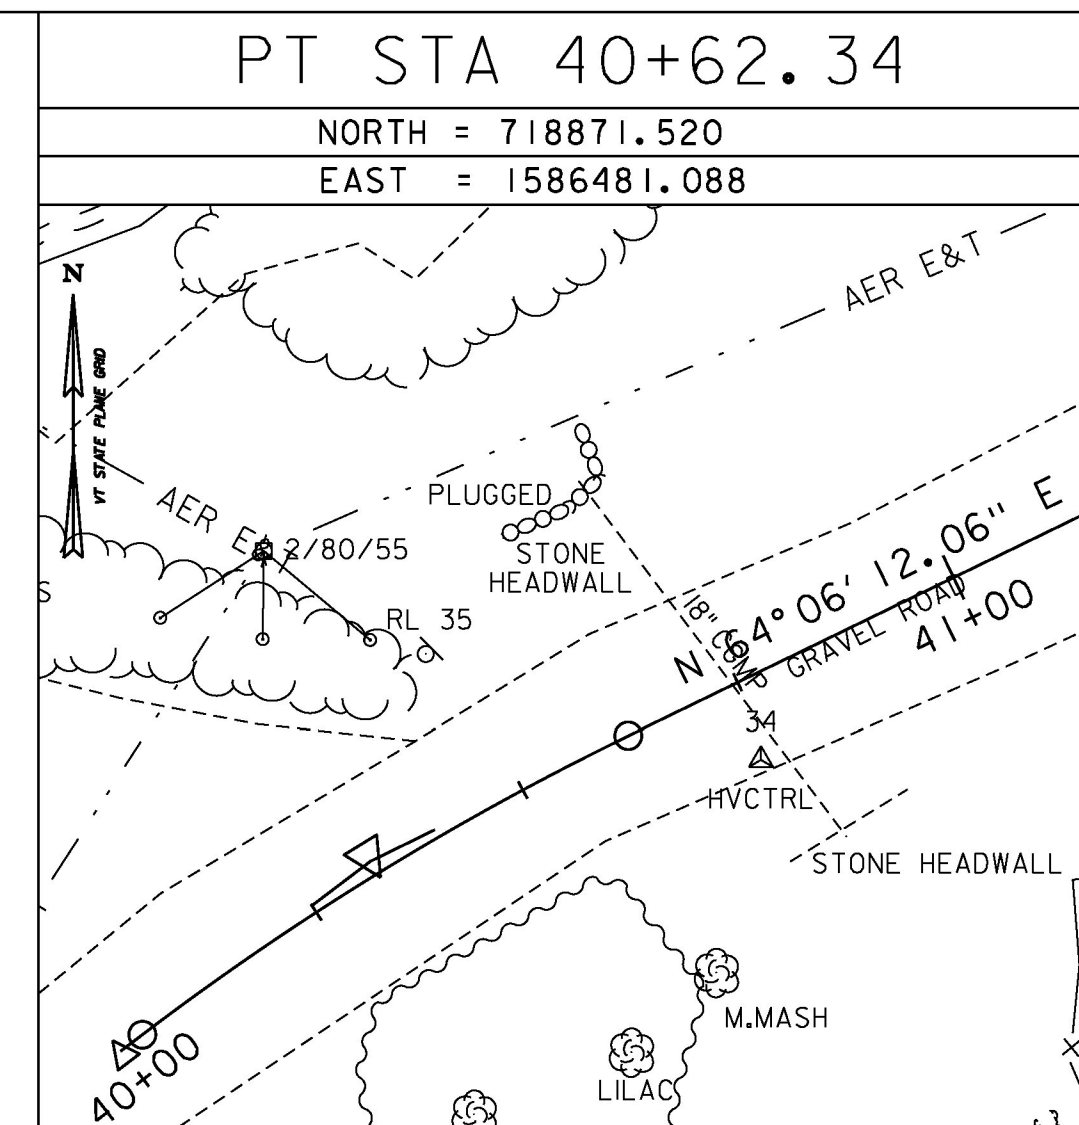
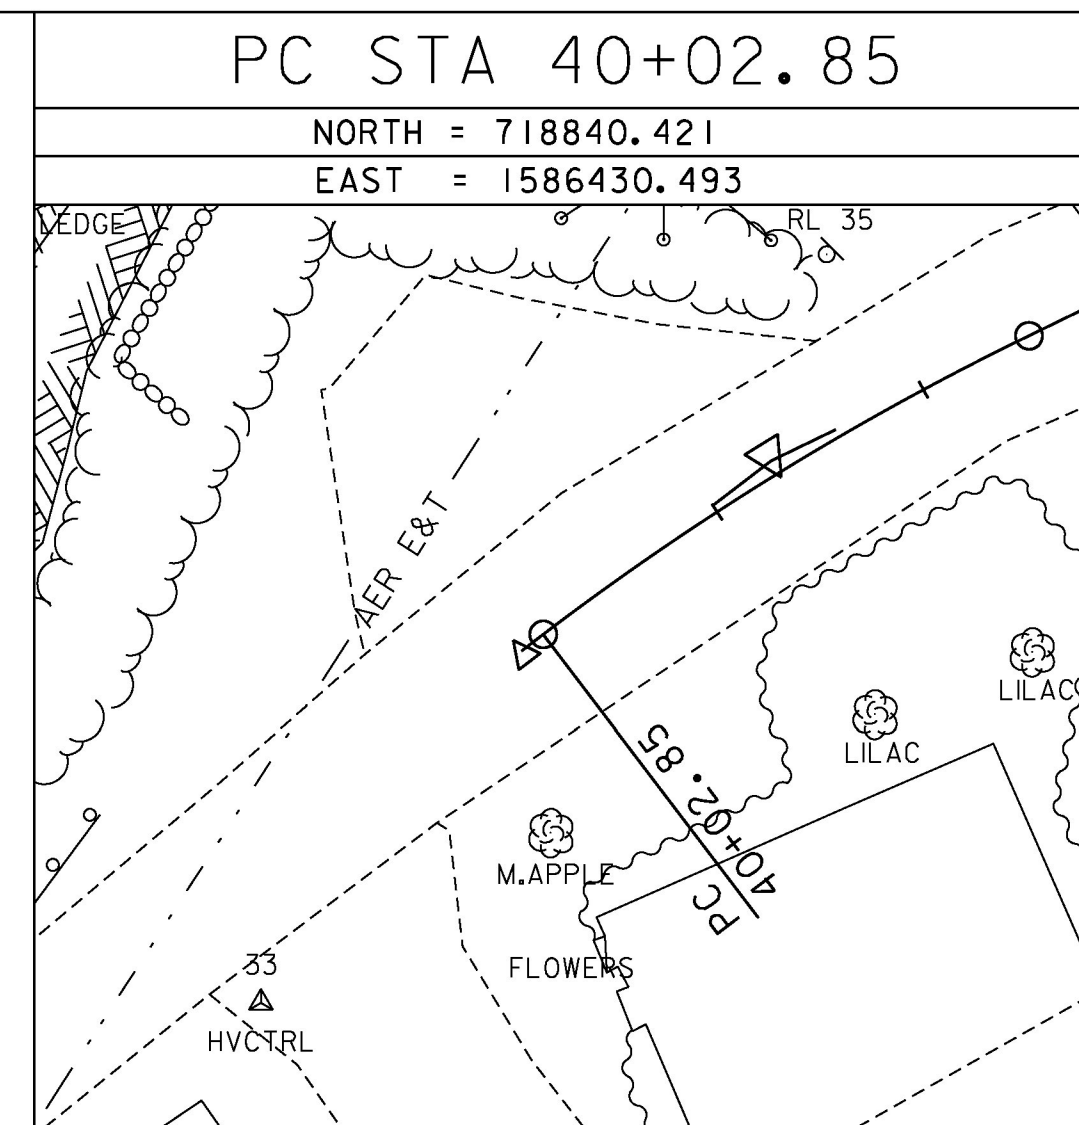
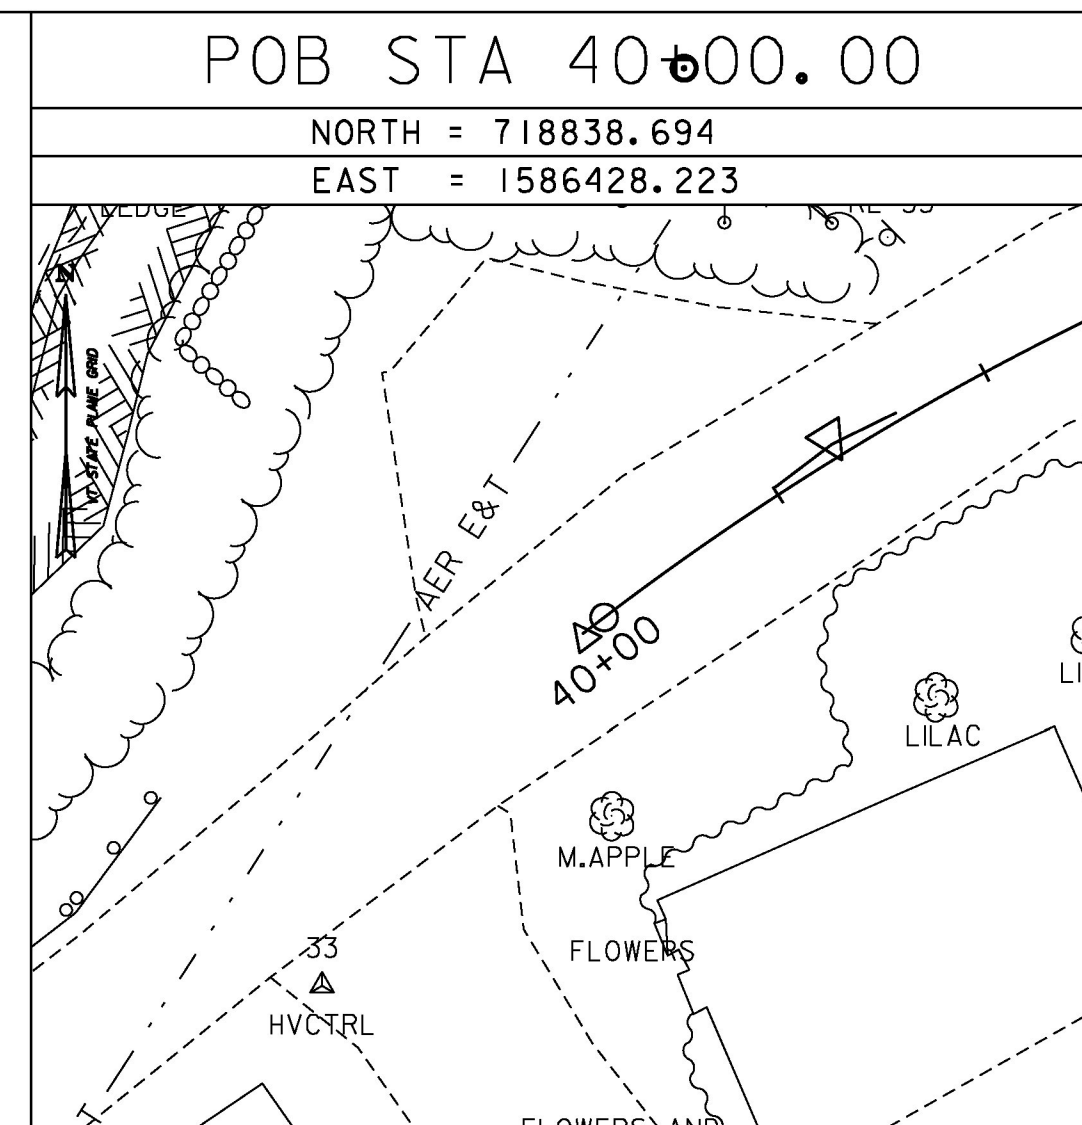
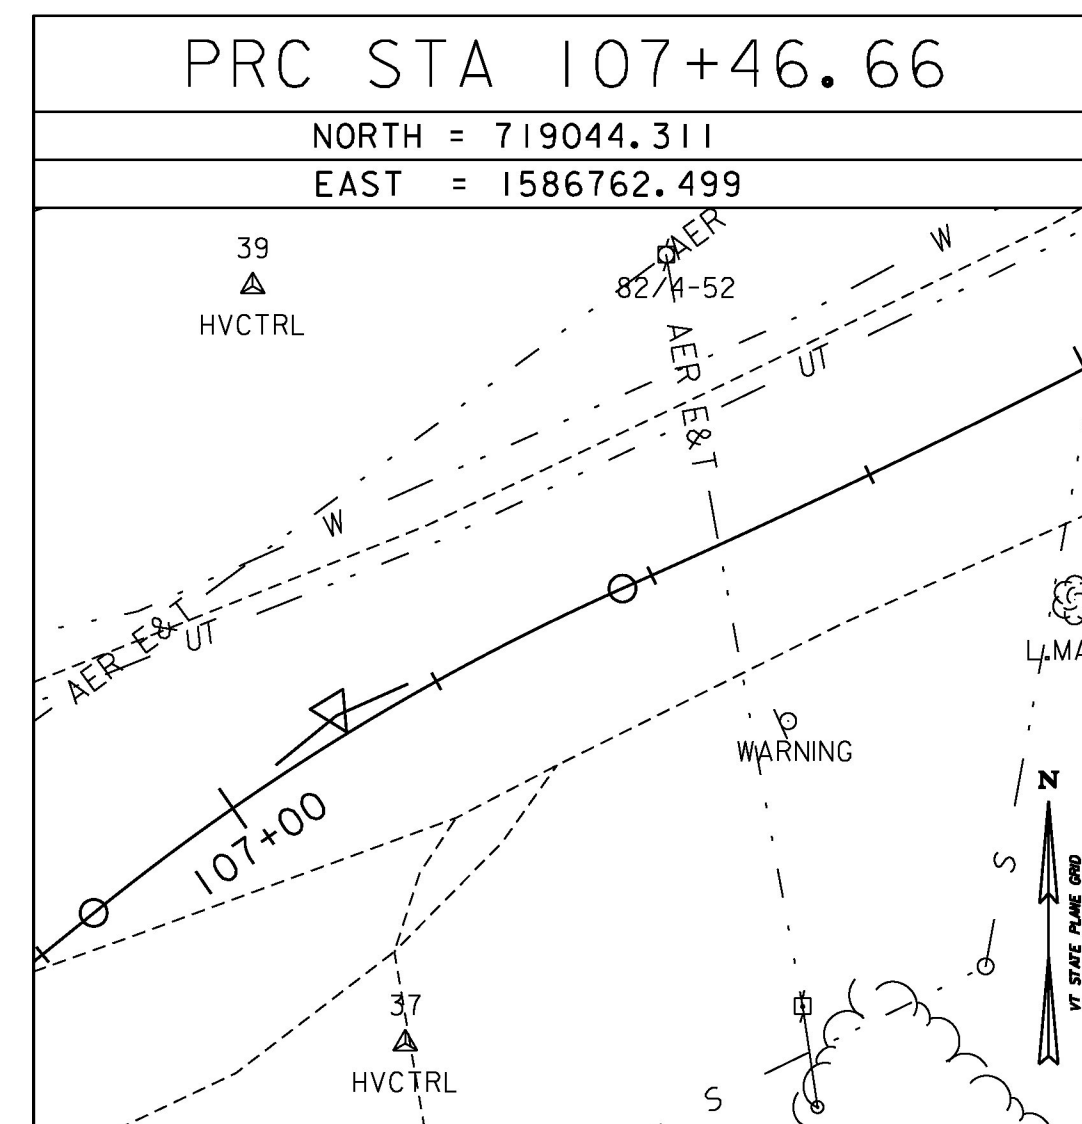
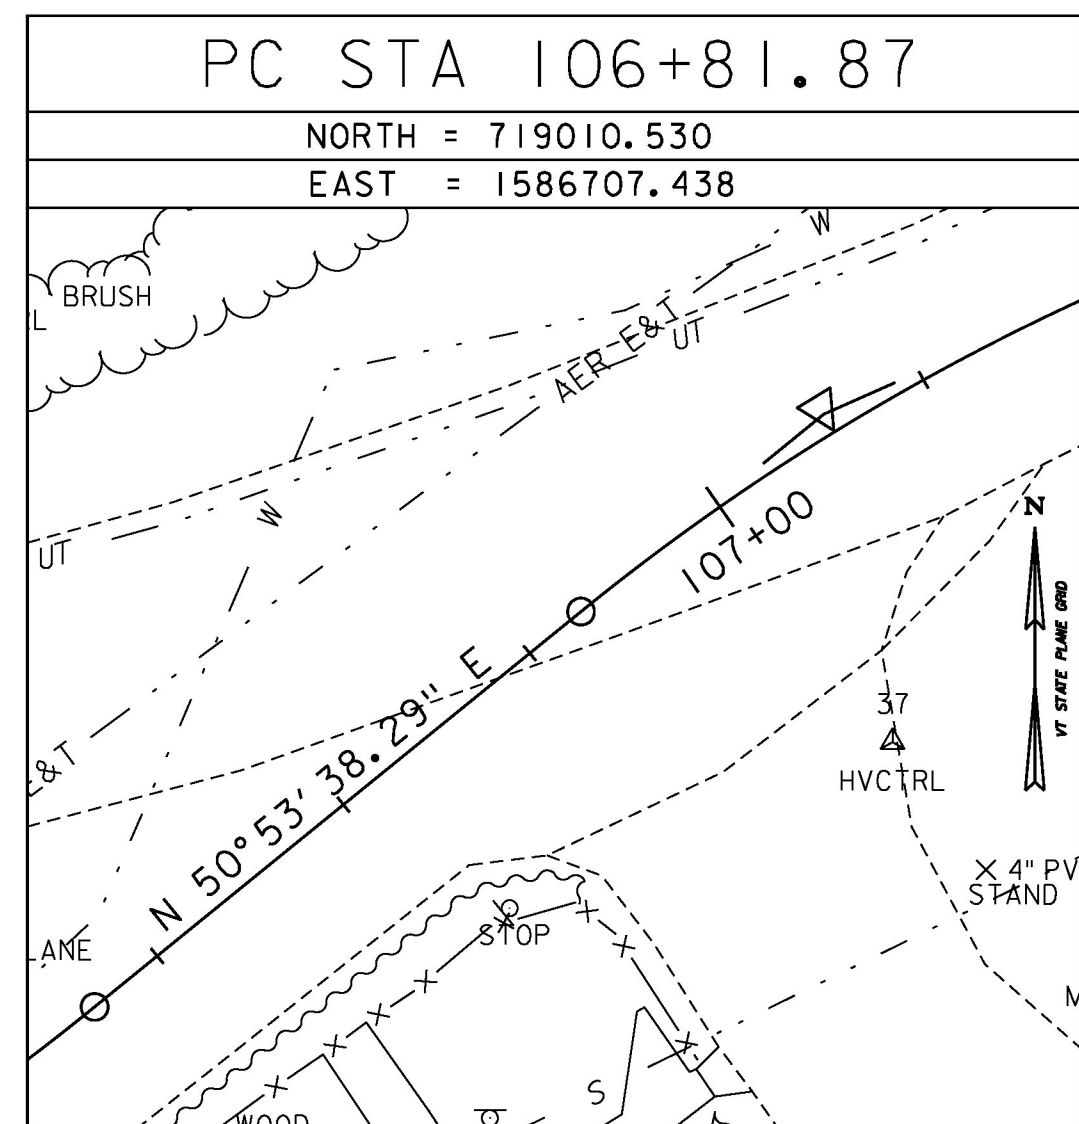
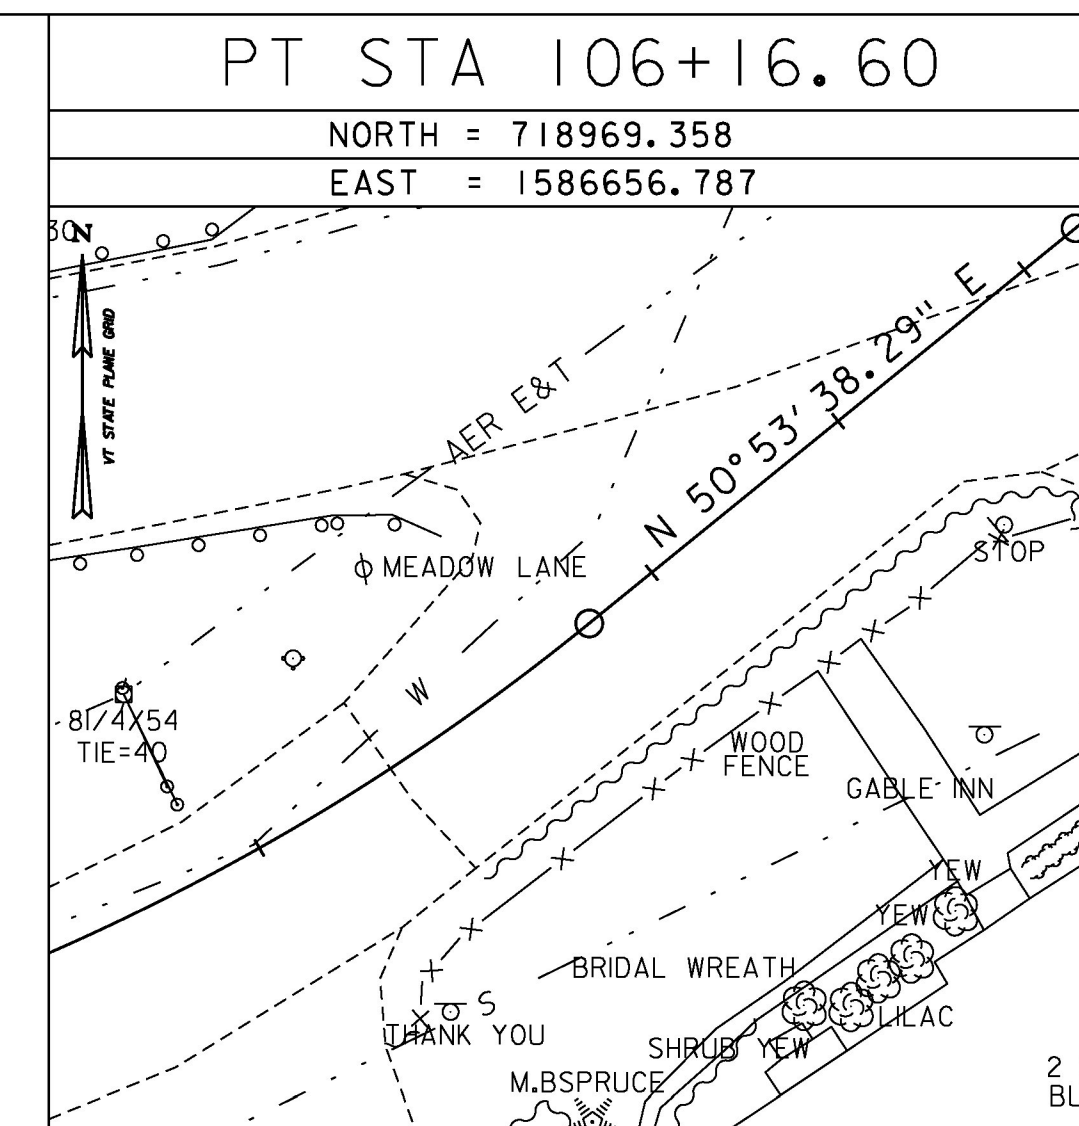
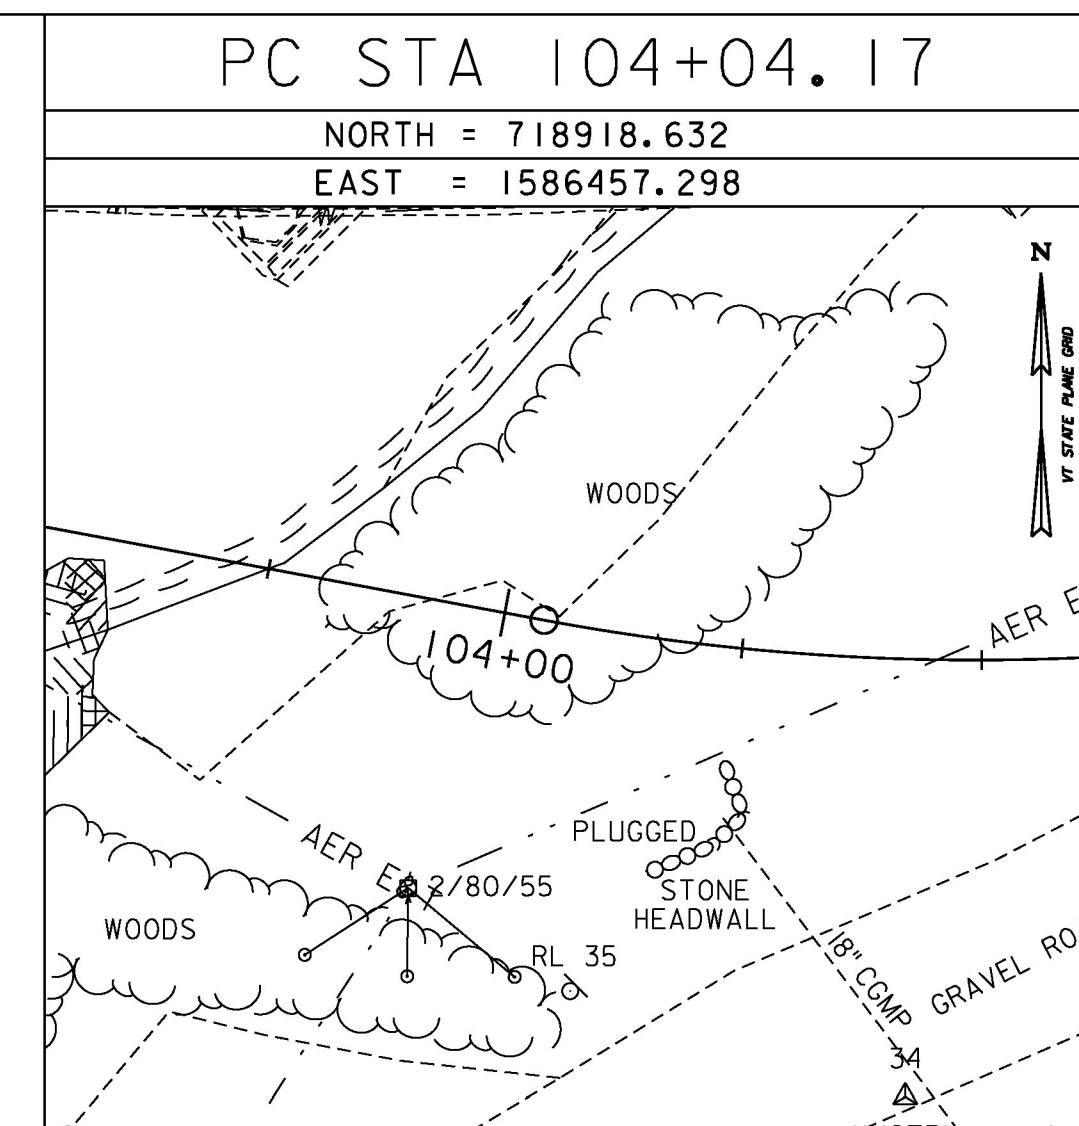
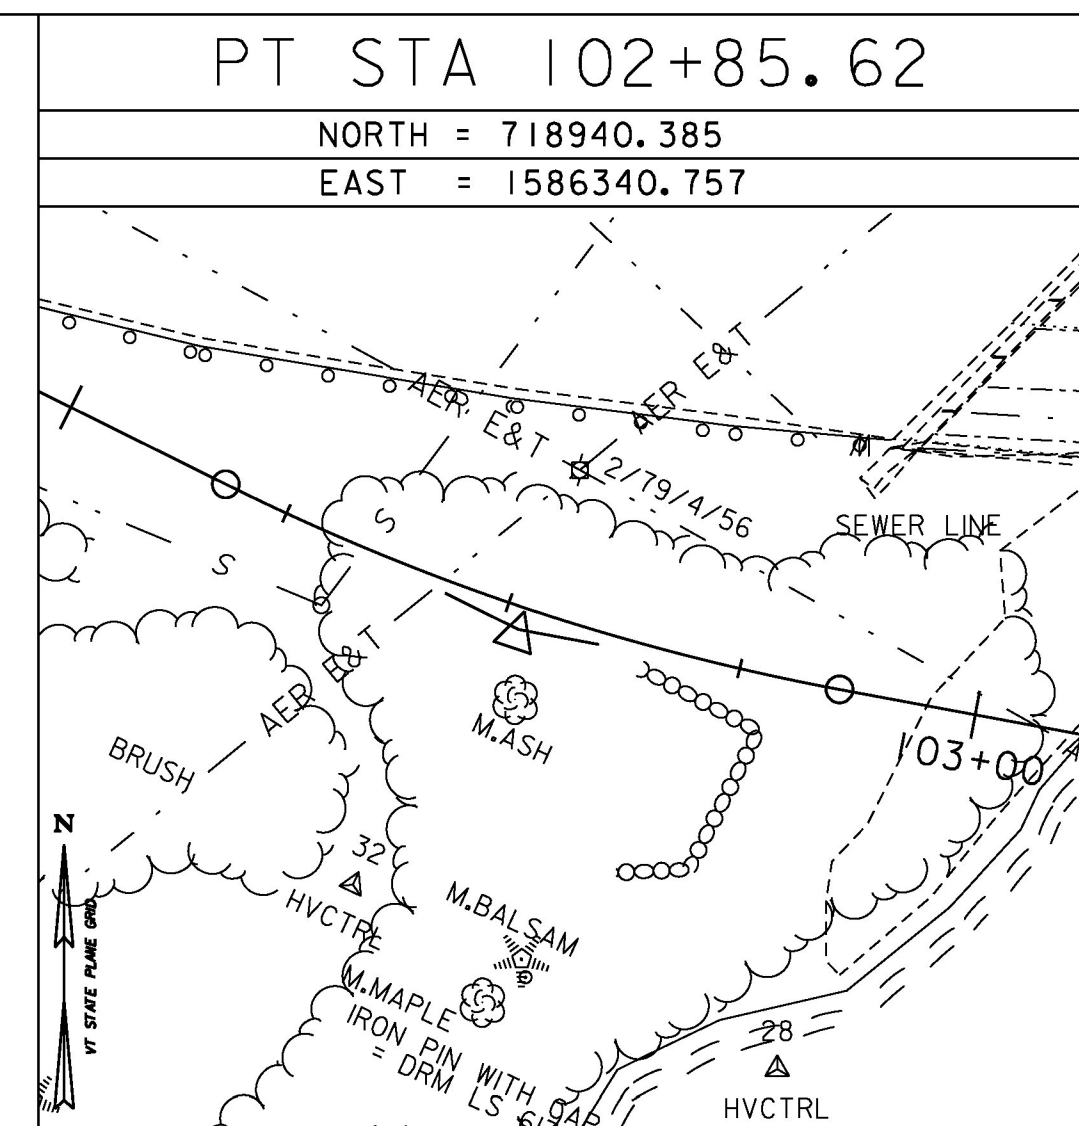


ALIGNMENT TIES

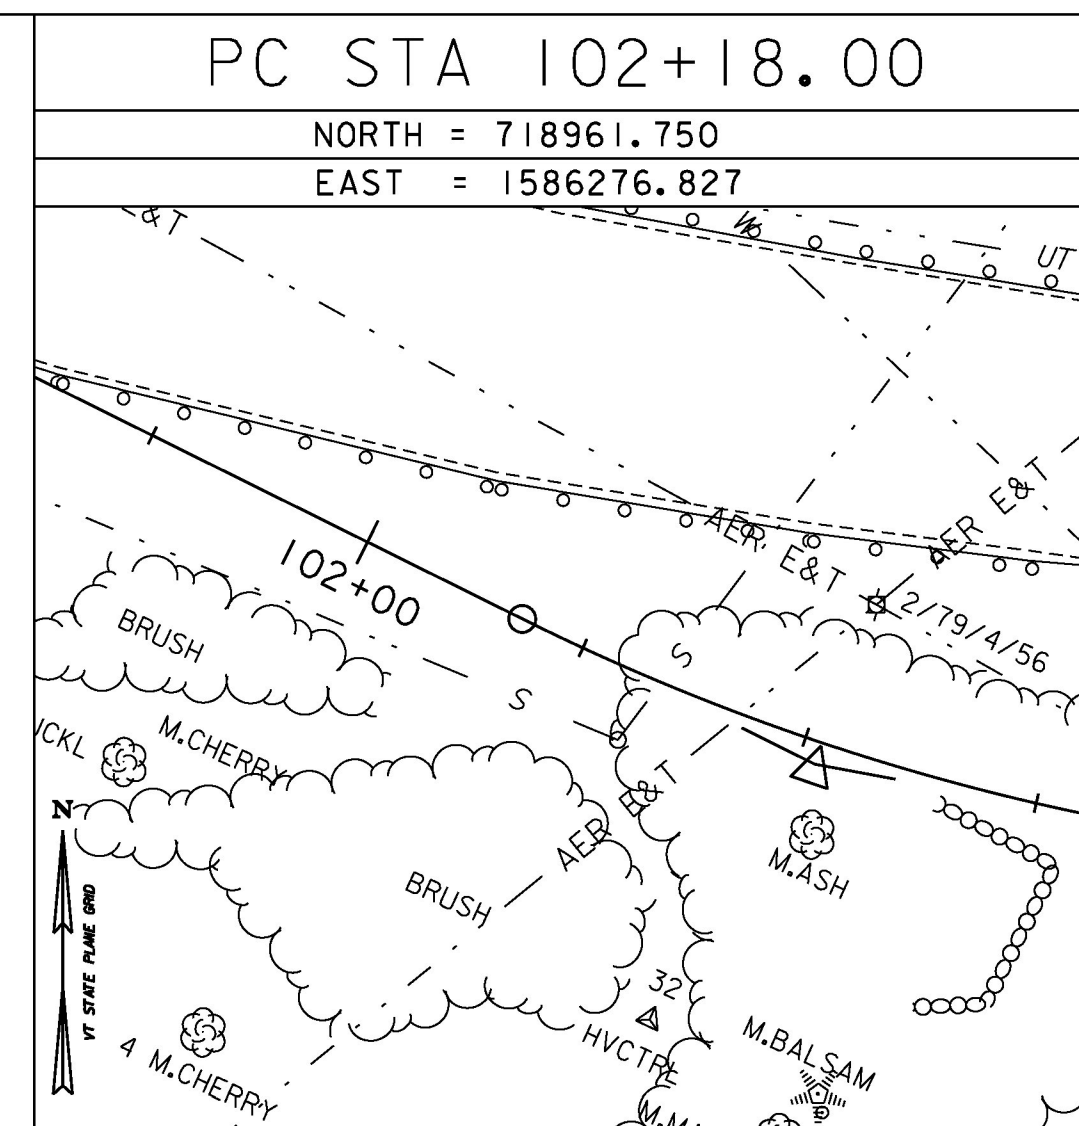

ALIGNMENT TIES

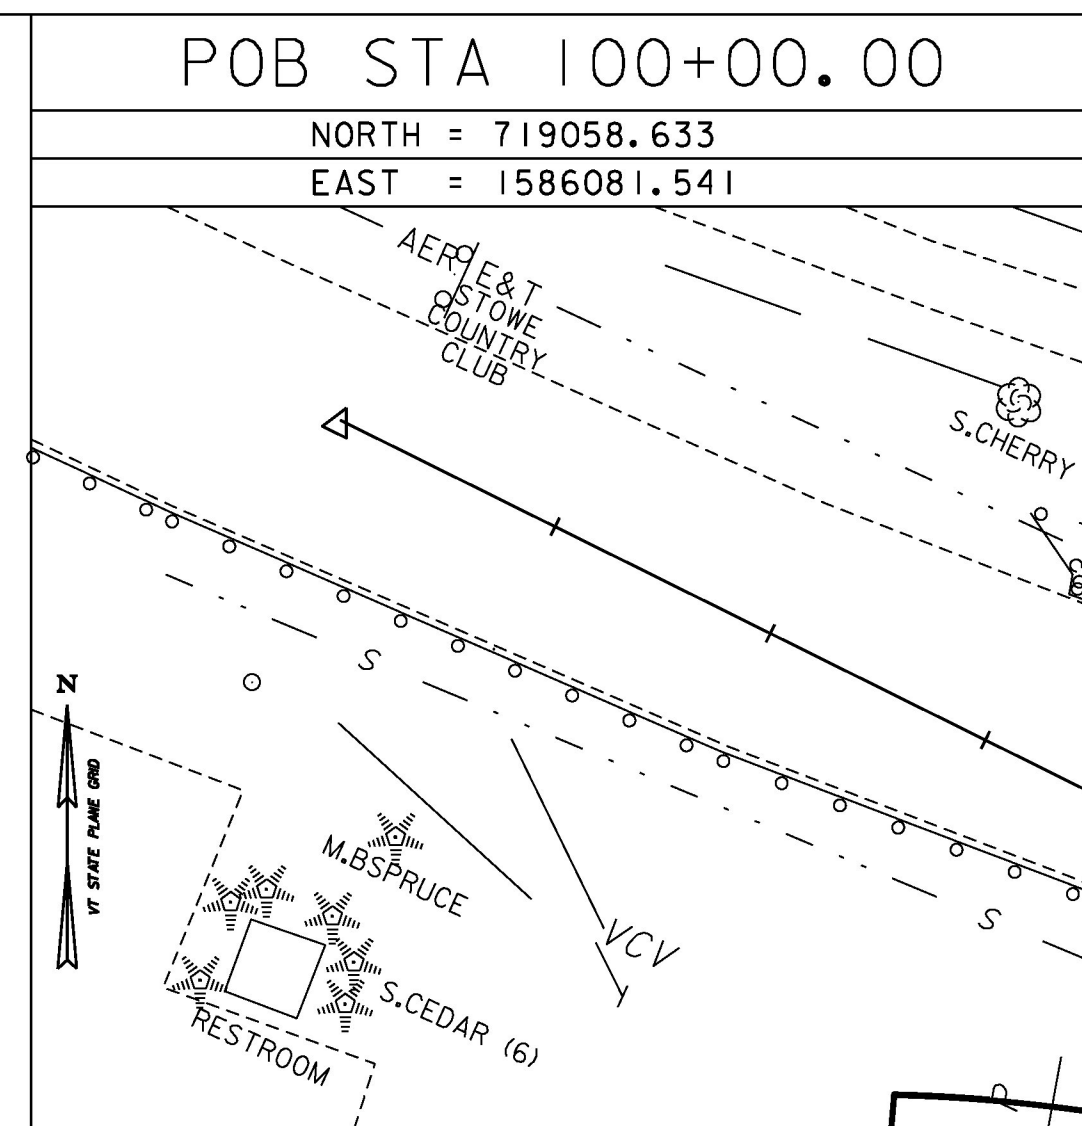

DATUM	
VERTICAL	NAVD 88
HORIZONTAL	NAD 83(96)
ADJUSTMENT	COMPASS

PROJECT NAME:	STOWE
PROJECT NUMBER:	BRF 0235(15)
FILE NAME:	z88c190t1.dgn
DESIGNED BY:	K. RUTTER
TIE SHEET	2
PLOT DATE:	5/8/2015
DRAWN BY:	K. RUTTER
CHECKED BY:	C. GREGORY
SHEET	15
OF	79

