

BOX BEAM GUARDRAIL
 STA 11+14.0 TO 14+59.6 RT
 STA 12+81.3 TO 14+66.9 LT

**GUARDRAIL APPROACH SECTION,
 GALVANIZED 3 RAIL BOX BEAM**
 STA 14+59.6 TO 14+90.9 RT
 STA 14+66.9 TO 15+02.5 LT

MANUFACTURED TERMINAL SECTION, TANGENT
 STA 11+00.1 TO 11+14.0 RT
 STA 12+67.1 TO 12+81.3 LT

REMOVAL AND DISPOSAL OF GUARDRAIL
 STA 11+19 TO 14+75 RT
 STA 12+71 TO 14+75 LT

RELOCATE UTILITY POLE, BY OTHERS
 STA 13+07 LT
 STA 14+48 RT

VT ROUTE 108
 CURVE (1)
 DELTA = 48°37'25" LT
 D = 7°09'43"
 R = 800.00'
 T = 361.41'
 L = 678.91'
 E = 77.85'
 BANKING = 0.048%

STONE FILL, TYPE II
 STA 12+00 TO 13+00 RT
ELIMINATED PER R.E.
SUCKERT


BEGIN PROJECT
 STA 11+00.00

BEGIN APPROACH
 STA 10+00.00

**VT 108 STA 12+00.00 =
 DETOUR STA 100+00.00**

**PERMANENT CONSTRUCTION
 LIMITS**

**PROPOSED 12" WATER
 BY OTHERS**

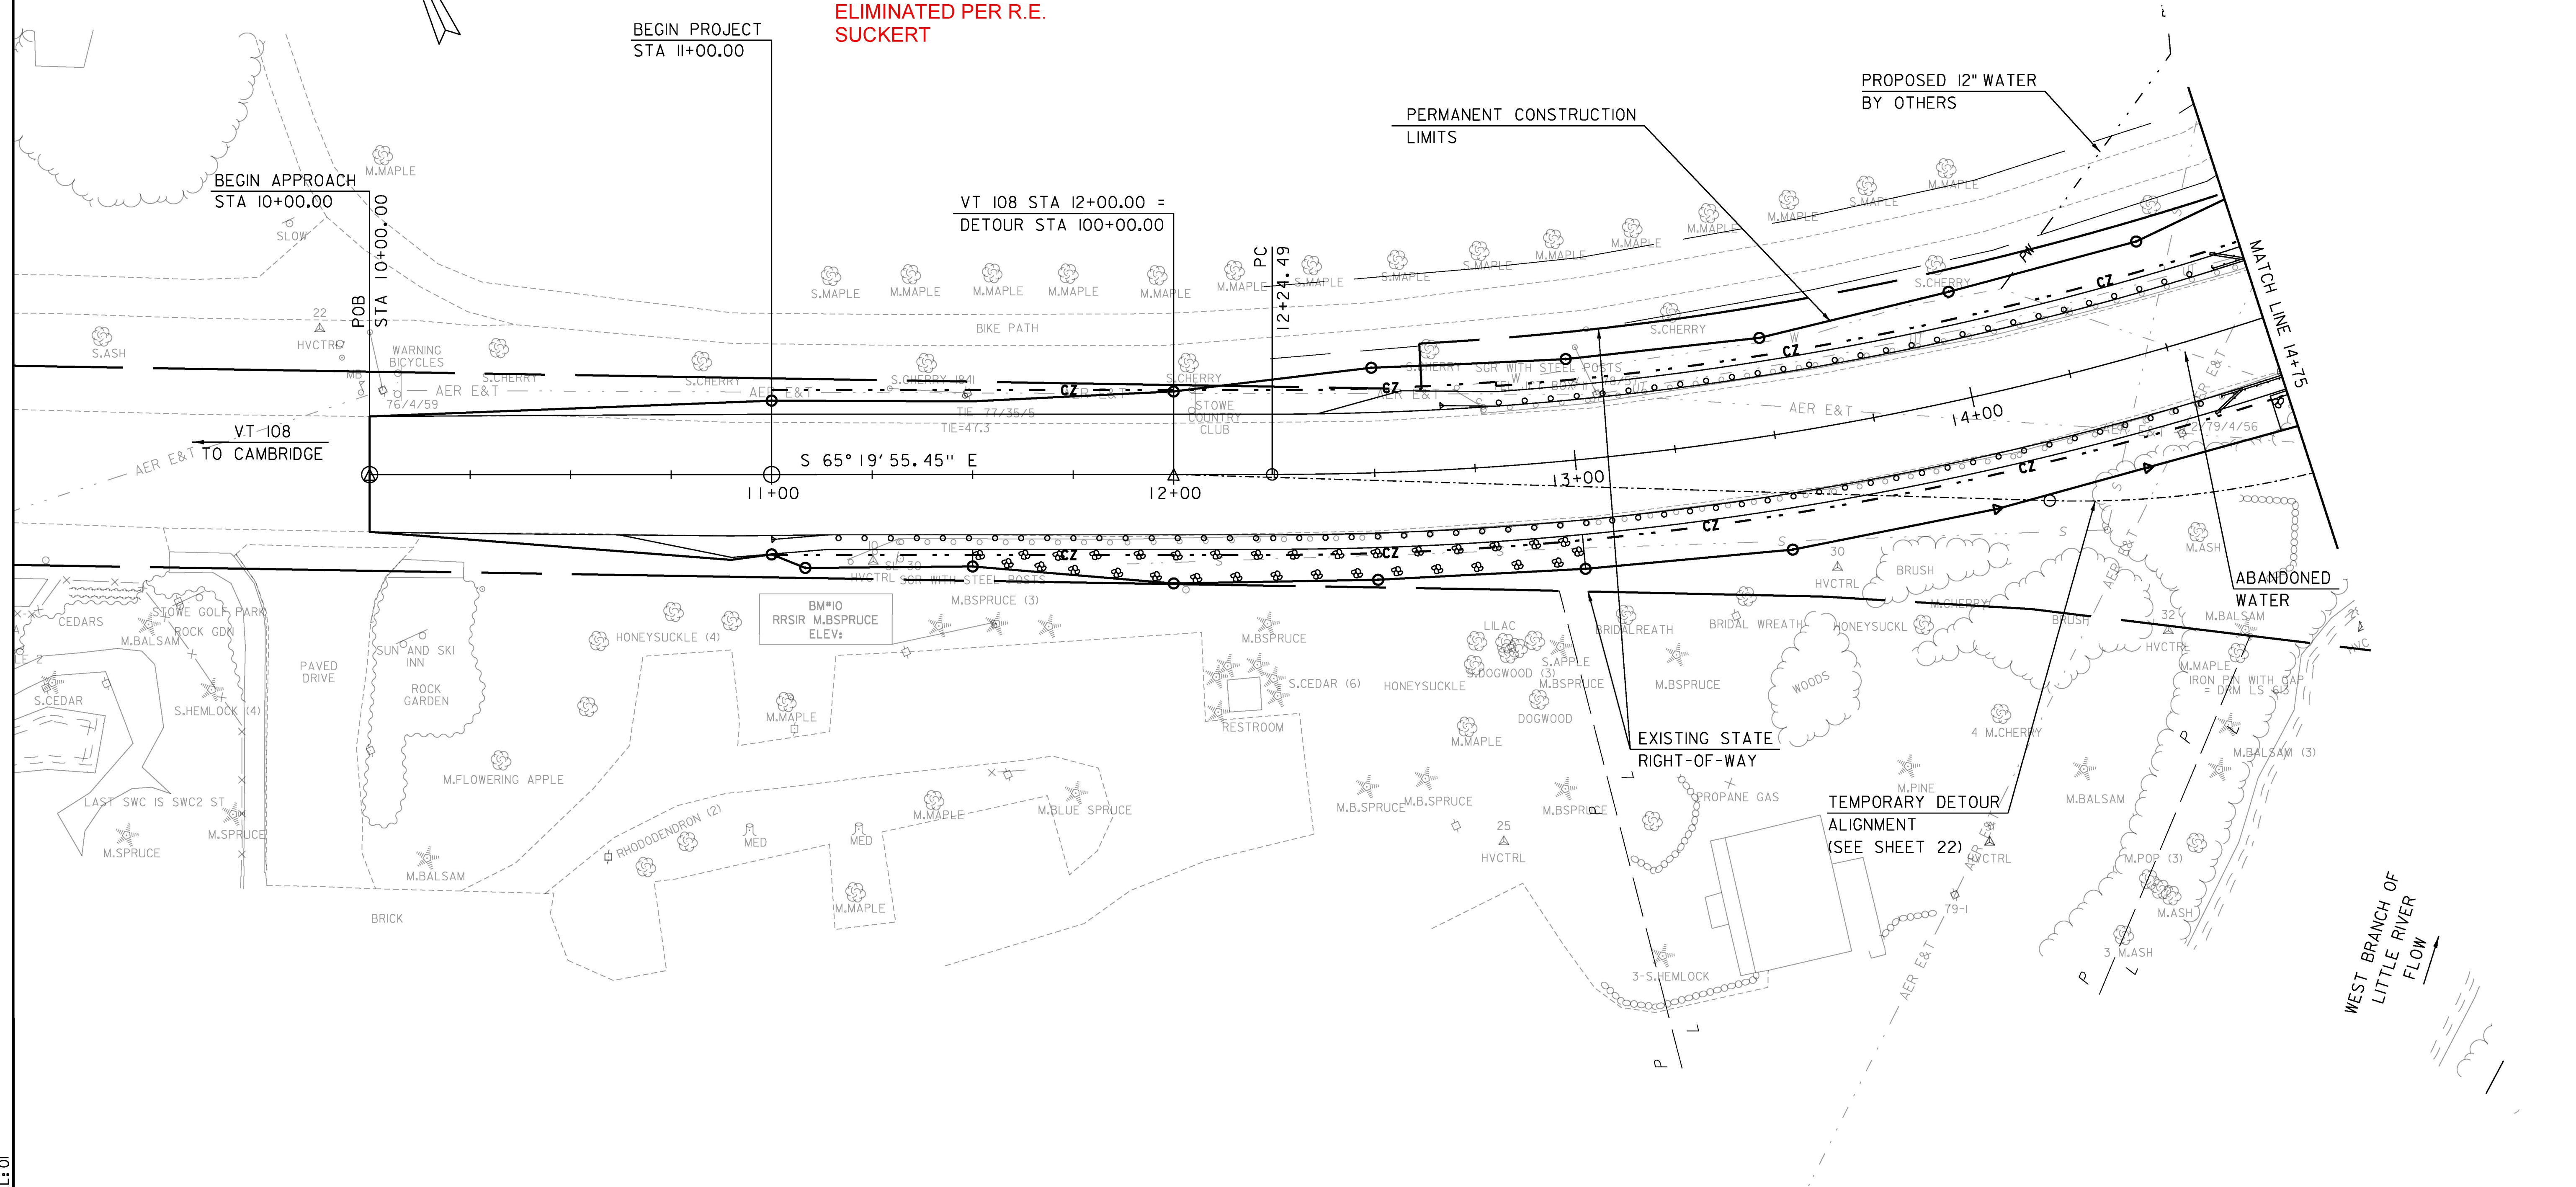

CLD 12-0120 MODEL:01

SCALE 1" = 20' - 0"
 20 0 20



PROJECT NAME:	STOWE	PLOT DATE:	5/8/2015
PROJECT NUMBER:	BRF 0235(15)	DRAWN BY:	S. FORTIER
FILE NAME:	z88c190bdr.dgn	DESIGNED BY:	K. RUTTER
PROJECT LEADER:	J. BYATT	CHECKED BY:	C. GREGORY
LAYOUT SHEET 1		SHEET	16 OF 79