



VT 108 BANKING DIAGRAM  
 HOR. SCALE 1" = 20'-0"  
 VER. SCALE 1" = .02'

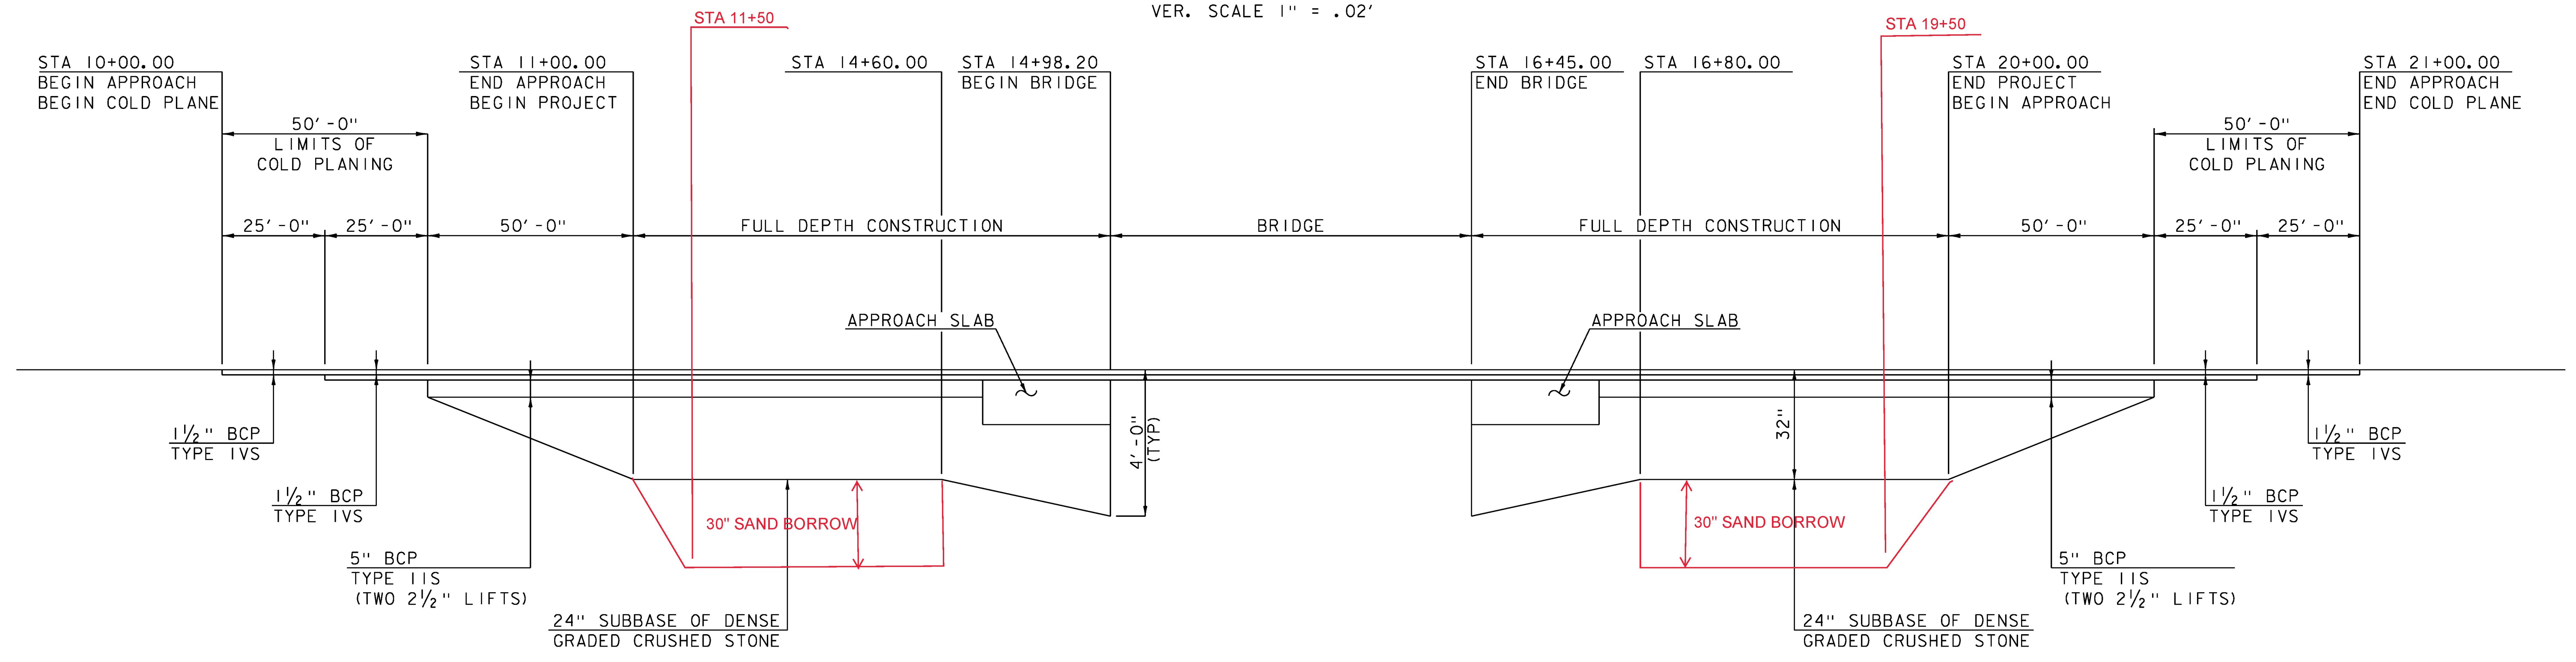

VT 108 MATERIAL TRANSITION DIAGRAM  
 NOT TO SCALE

REVISED MATERIAL TRANSITION DETAIL TO INCORPORATE SAND BORROW TAPER.

PROJECT NAME:	STOWE
PROJECT NUMBER:	BRF 0235(15)
FILE NAME:	z88cl90bank.dgn
PROJECT LEADER:	J. BYATT
DESIGNED BY:	K. RUTTER
MATERIAL TRANSITION & BANKING DIAGRAM	CHECKED BY: C. GREGORY
	PLOT DATE: 5/8/2015
	DRAWN BY: K. RUTTER
	SHEET 20 OF 79

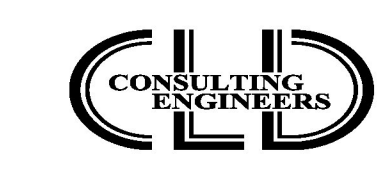

MODEL: 01  
 CLD 12-0120