

END APPROACH  
 END DETOUR  
 VT 108 STA 20+36.73 =  
 DETOUR STA 108+80.00

BEGIN APPROACH  
 BEGIN DETOUR  
 VT 108 STA 12+00.00 =  
 DETOUR STA 100+00.00

UNDERGROUND TELEPHONE  
 (TO BE REMOVED OR  
 ABANDONED)

PROPOSED 12" WATER  
 BY OTHERS

ABANDONED 6" AND 12"  
 WATERLINES (TO BE  
 FILLED OR REMOVED)


AERIAL AND  
 UNDERGROUND  
 SERVICES TO  
 BE MAINTAINED

NOTES:

1. THE REMOVAL OF THE ABANDONED WATER LINES (6" AND 12") AND THE UNDERGROUND TELEPHONE ON THE BRIDGE ARE INCIDENTAL TO ITEM 529.15, REMOVAL OF STRUCTURE.
2. ABANDONED UTILITIES (6" WATER LINE, 12" TOWN WATER LINE, AND UNDERGROUND TELEPHONE) WITHIN THE EXCAVATION LIMITS OF THE PROJECT SHALL BE REMOVED. THE REMOVAL OF THE ABANDONED UTILITIES ARE INCIDENTAL TO ITEM 203.15, COMMON EXCAVATION.
3. IN AREAS WHERE THE 12" ABANDONED TOWN WATER LINE IS OUTSIDE OF THE EXCAVATION LIMITS, THE PIPE SHALL BE FILLED WITH CONTROLLED DENSITY (FLOWABLE) FILL, ITEM 541.45.
4. IN AREAS WHERE THE 6" ABANDONED WATER LINE IS OUTSIDE OF THE EXCAVATION LIMITS THE LINE SHALL BE ABANDONED IN PLACE.
5. IN AREAS WHERE THE UNDERGROUND TELEPHONE IS OUTSIDE OF THE EXCAVATION LIMITS, THE LINE SHALL BE ABANDONED IN PLACE.
6. SEE SHEET 79 FOR THE RELOCATED 12" TOWN WATER MAIN.

MARK	STATION	OFFSET	NORTHING	EASTING	PHASE (PRE-CONSTRUCTION/FINAL)	REMARKS	POLE NUMBER
UP#1	11+49	20' LT	719098.43	1586043.40	PRE-CONSTRUCTION	REPLACE WITH TALLER UTILITY POLE. CONNECT LINES TO UP#10.	77/35/5
UP#2	14+22	53' RT	718937.17	1586281.65	PRE-CONSTRUCTION	INSTALL NEW UTILITY POLE WITH PUSH BRACE. CONNECT LINES TO UP#10.	NEW
UP#3	15+40	122' RT	718853.95	1586404.61	PRE-CONSTRUCTION	INSTALL NEW UTILITY POLE WITH PUSH BRACE. CONNECT LINES TO UP#2, UP#4 AND UP#8.	NEW
UP#4	17+34	31' RT	EXISTING	EXISTING	PRE-CONSTRUCTION	CLEAN GUY WIRES TO FIT. CONNECT LINES TO UP#3.	81/4/54
UP#4A	17+50	70.6' RT	718926.90	1586632.88	PRE-CONSTRUCTION	INSTALL TEMPORARY UTILITY POLE AND 10' GUY. CONNECT TO UP #4.	TEMP.
					FINAL	REMOVE TEMPORARY POLE AND GUY.	
UP#5	13+07	16' LT	EXISTING	EXISTING	PRE-CONSTRUCTION	REMOVE EXISTING UTILITY POLE AND LINES	78/57
UP#6	14+47	22' RT	EXISTING	EXISTING	PRE-CONSTRUCTION	REMOVE EXISTING UTILITY POLE AND LINES	2/79/4/56
UP#7	14+97	30' LT	EXISTING	EXISTING	PRE-CONSTRUCTION	REMOVE EXISTING UTILITY POLE AND LINES	95
UP#8	15+11	208' RT	EXISTING	EXISTING	PRE-CONSTRUCTION	CONNECT LINES TO UP#3.	22/1
UP#9	15+74	85' RT	EXISTING	EXISTING	PRE-CONSTRUCTION	REMOVE EXISTING UTILITY POLE AND LINES	2/80/55
UP#10	12+82	18' RT	719043.33	1586162.75	FINAL	INSTALL NEW UTILITY POLE, 2 DEAD ENDS AND 14' GUY. CONNECT LINES TO UP#1 AND UP#2.	NEW

SCALE 1" = 30' - 0"  
 30 0 30

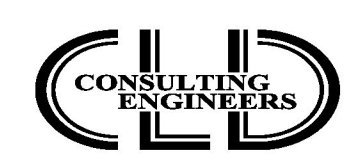

PROJECT NAME: STOWE	PLOT DATE: 5/8/2015
PROJECT NUMBER: BRF 0235(15)	DRAWN BY: K. RUTTER
FILE NAME: z88ci90bdruti.dgn	CHECKED BY: C. GREGORY
PROJECT LEADER: J. BYATT	UTILITY RELOCATION SHEET
DESIGNED BY: K. RUTTER	SHEET 22 OF 79

CLD 12-010 MODEL+01