
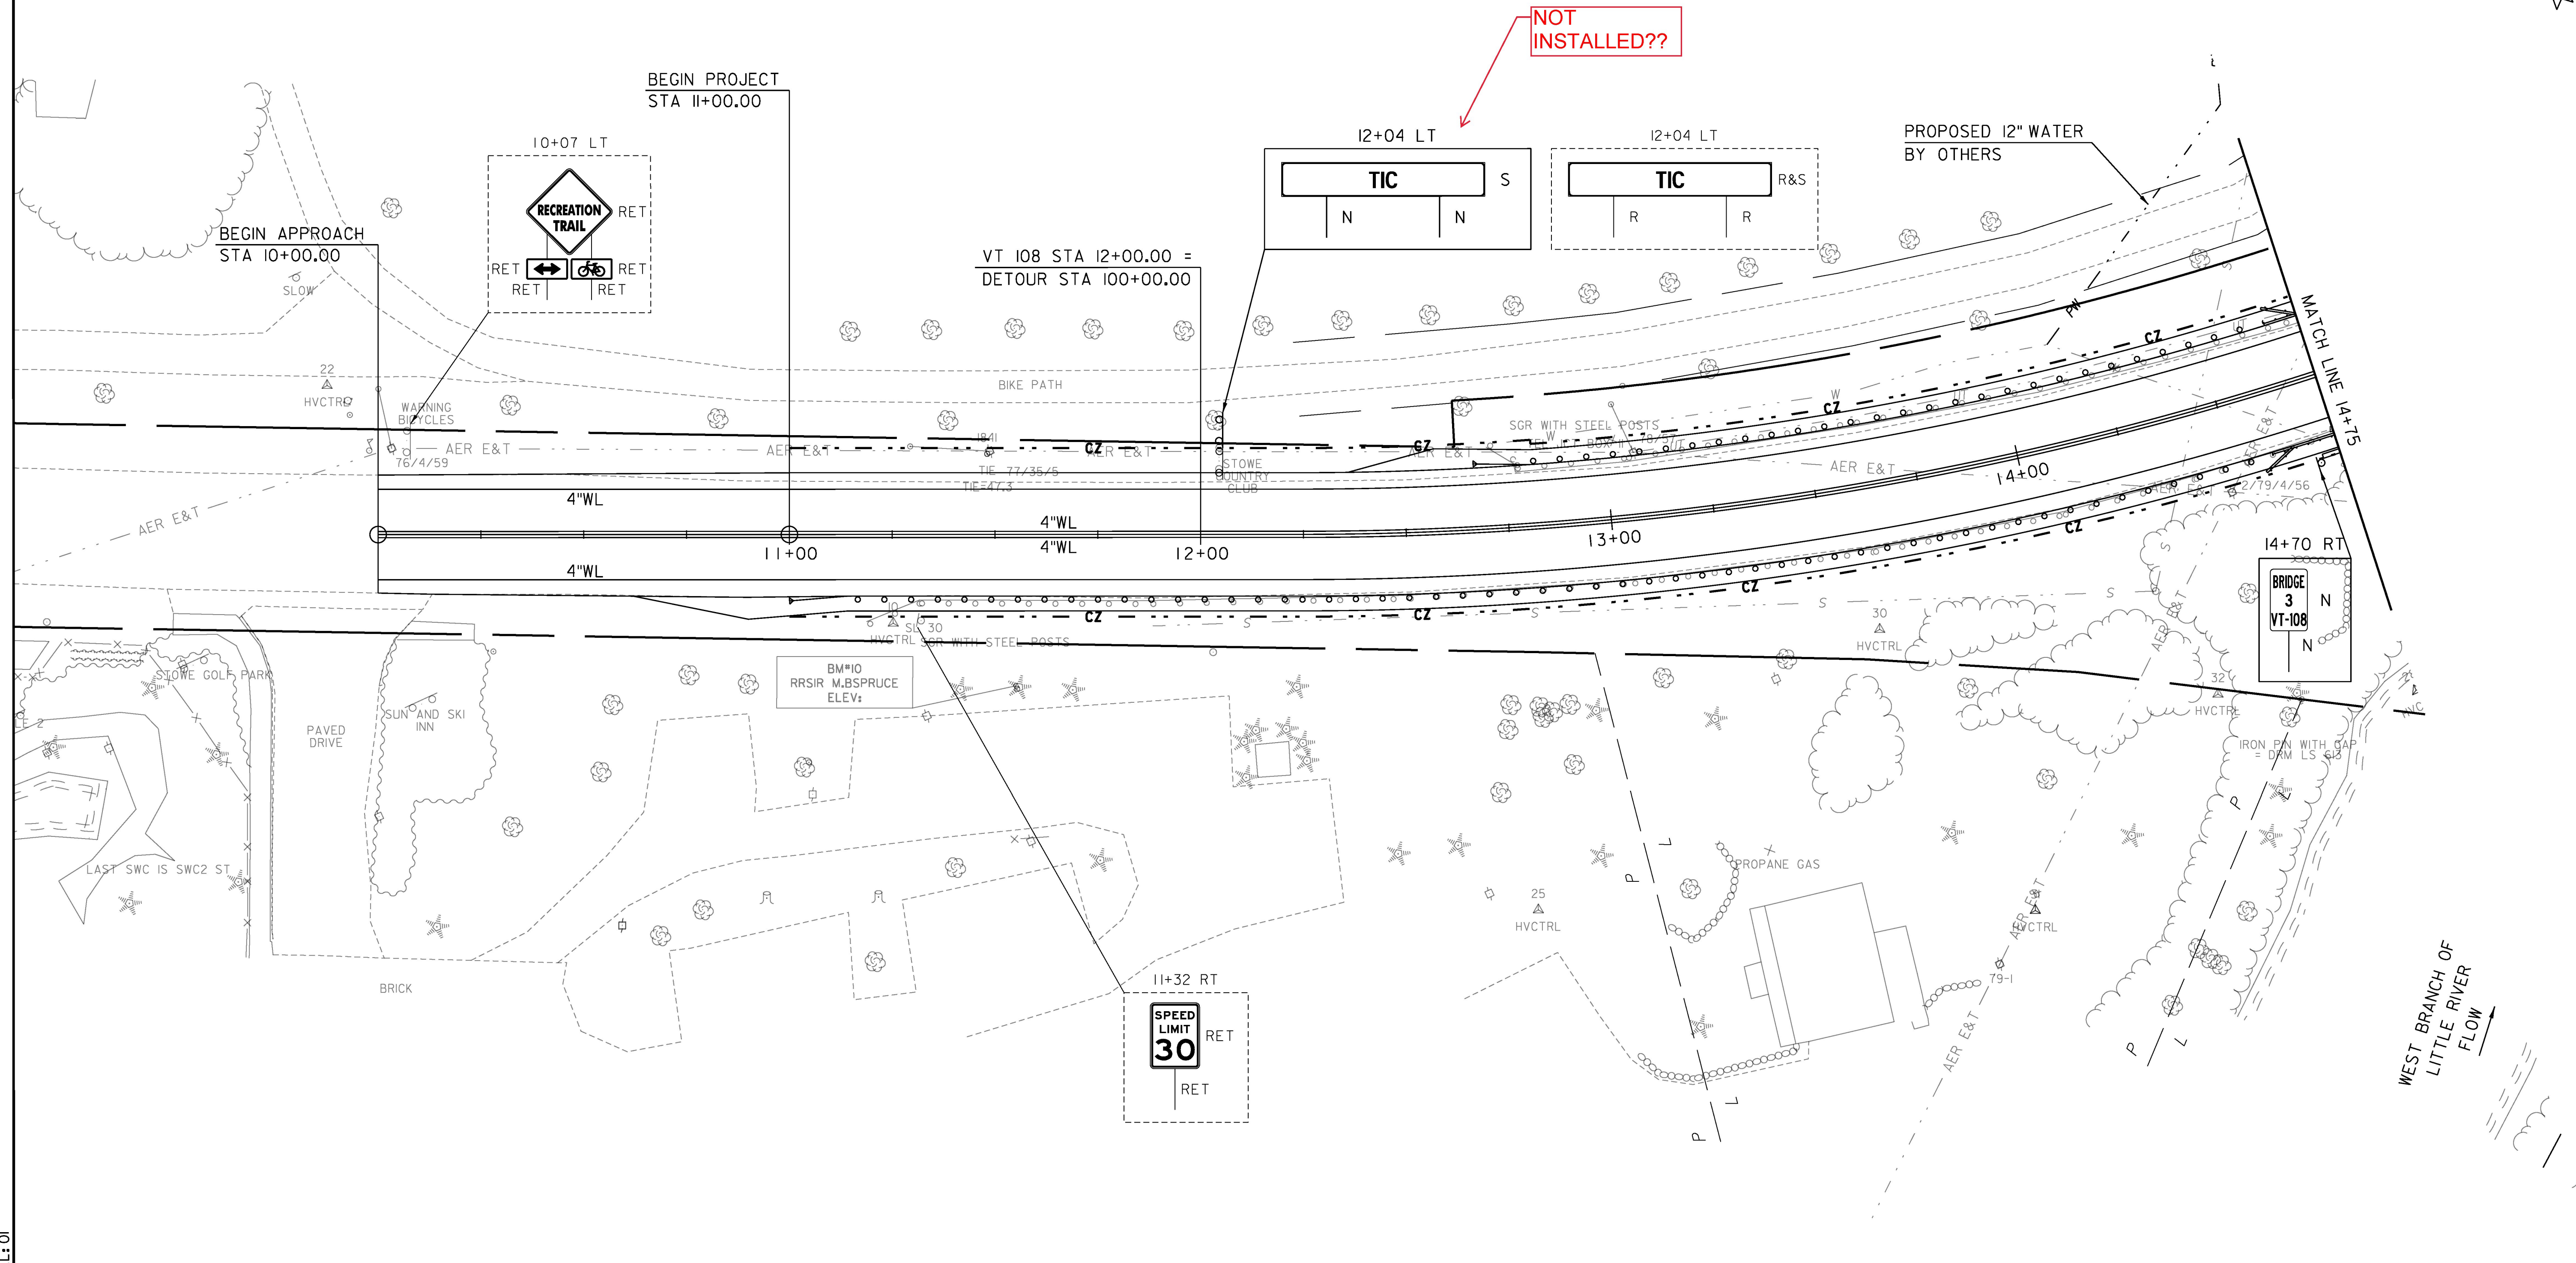


TEMPORARY 4 INCH WHITE LINE, PAINT  
 DURABLE 4 INCH WHITE LINE (OPTION BID ITEM)  
 STA 10+00 TO 14+75 SOLID LT & RT

TEMPORARY 4 INCH YELLOW LINE, PAINT  
 DURABLE 4 INCH YELLOW LINE (OPTION BID ITEM)  
 STA 10+00 TO 14+75 SOLID LT & RT


REMOVING SIGNS  
 AS SHOWN - 1

ERECTING SALVAGED SIGNS  
 AS SHOWN - 1

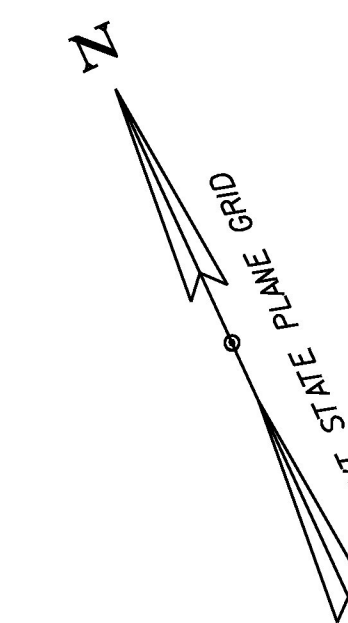

CLD 12-0120 MODEL: 01

SCALE 1" = 20' - 0"  
 20 0 20

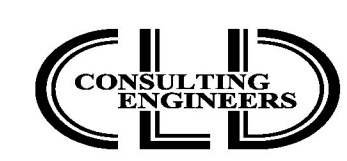

|                                    |                        |
|------------------------------------|------------------------|
| PROJECT NAME: STOWE                | PLOT DATE: 5/8/2015    |
| PROJECT NUMBER: BRF 0235(15)       | DRAWN BY: S. GOODWIN   |
| FILE NAME: z88c190bdrts.dgn        | CHECKED BY: C. GREGORY |
| PROJECT LEADER: J. BYATT           | SHEET 26 OF 79         |
| DESIGNED BY: K. RUTTER             |                        |
| TRAFFIC SIGN & LINE LAYOUT SHEET 1 |                        |