

TEMPORARY 4 INCH WHITE LINE, PAINT
 DURABLE 4 INCH WHITE LINE (OPTION BID ITEM)
 STA 14+75 TO 21+00 SOLID LT
 STA 14+75 TO 17+56 SOLID RT
 STA 17+50 TO 17+56 SOLID RT (TH 38)
 STA 17+58 TO 19+01 SOLID RT (TH 38)
 STA 19+01 TO 21+00 SOLID RT

TEMPORARY 4 INCH YELLOW LINE, PAINT
 DURABLE 4 INCH YELLOW LINE (OPTION BID ITEM)
 STA 14+75 TO 17+93 SOLID LT & RT
 STA 17+54 TO 18+13 DOUBLE SOLID RT (TH 38)
 STA 18+33 TO 21+00 SOLID LT & RT

TEMPORARY 24 INCH STOP BAR, PAINT
 DURABLE 24 INCH STOP BAR (OPTION BID ITEM)
 STA 18+14 TO 18+17 RT

TEMPORARY LETTER OR SYMBOL, PAINT
 DURABLE LETTER OR SYMBOL (OPTION BID ITEM)
 STA 18+08 RT - "STOP"






REMOVING SIGNS
 AS SHOWN - 1

ITEMS NOT USED.



END APPROACH
 STA 21+00.00

VT 108 STA 20+36.73 =
 DETOUR STA 108+80.00

END PROJECT
 STA 20+00.00

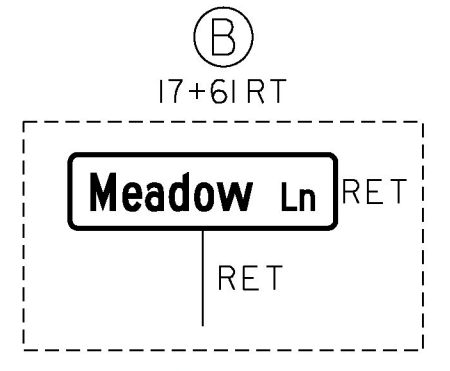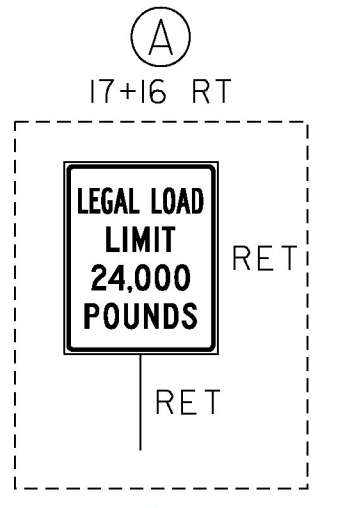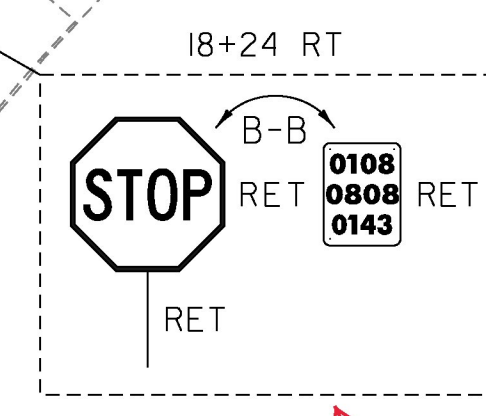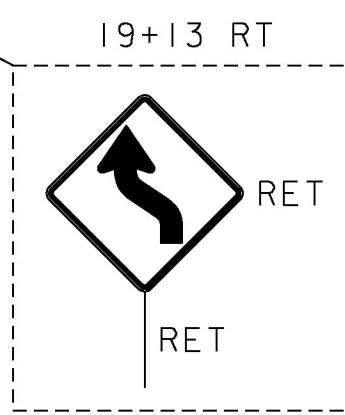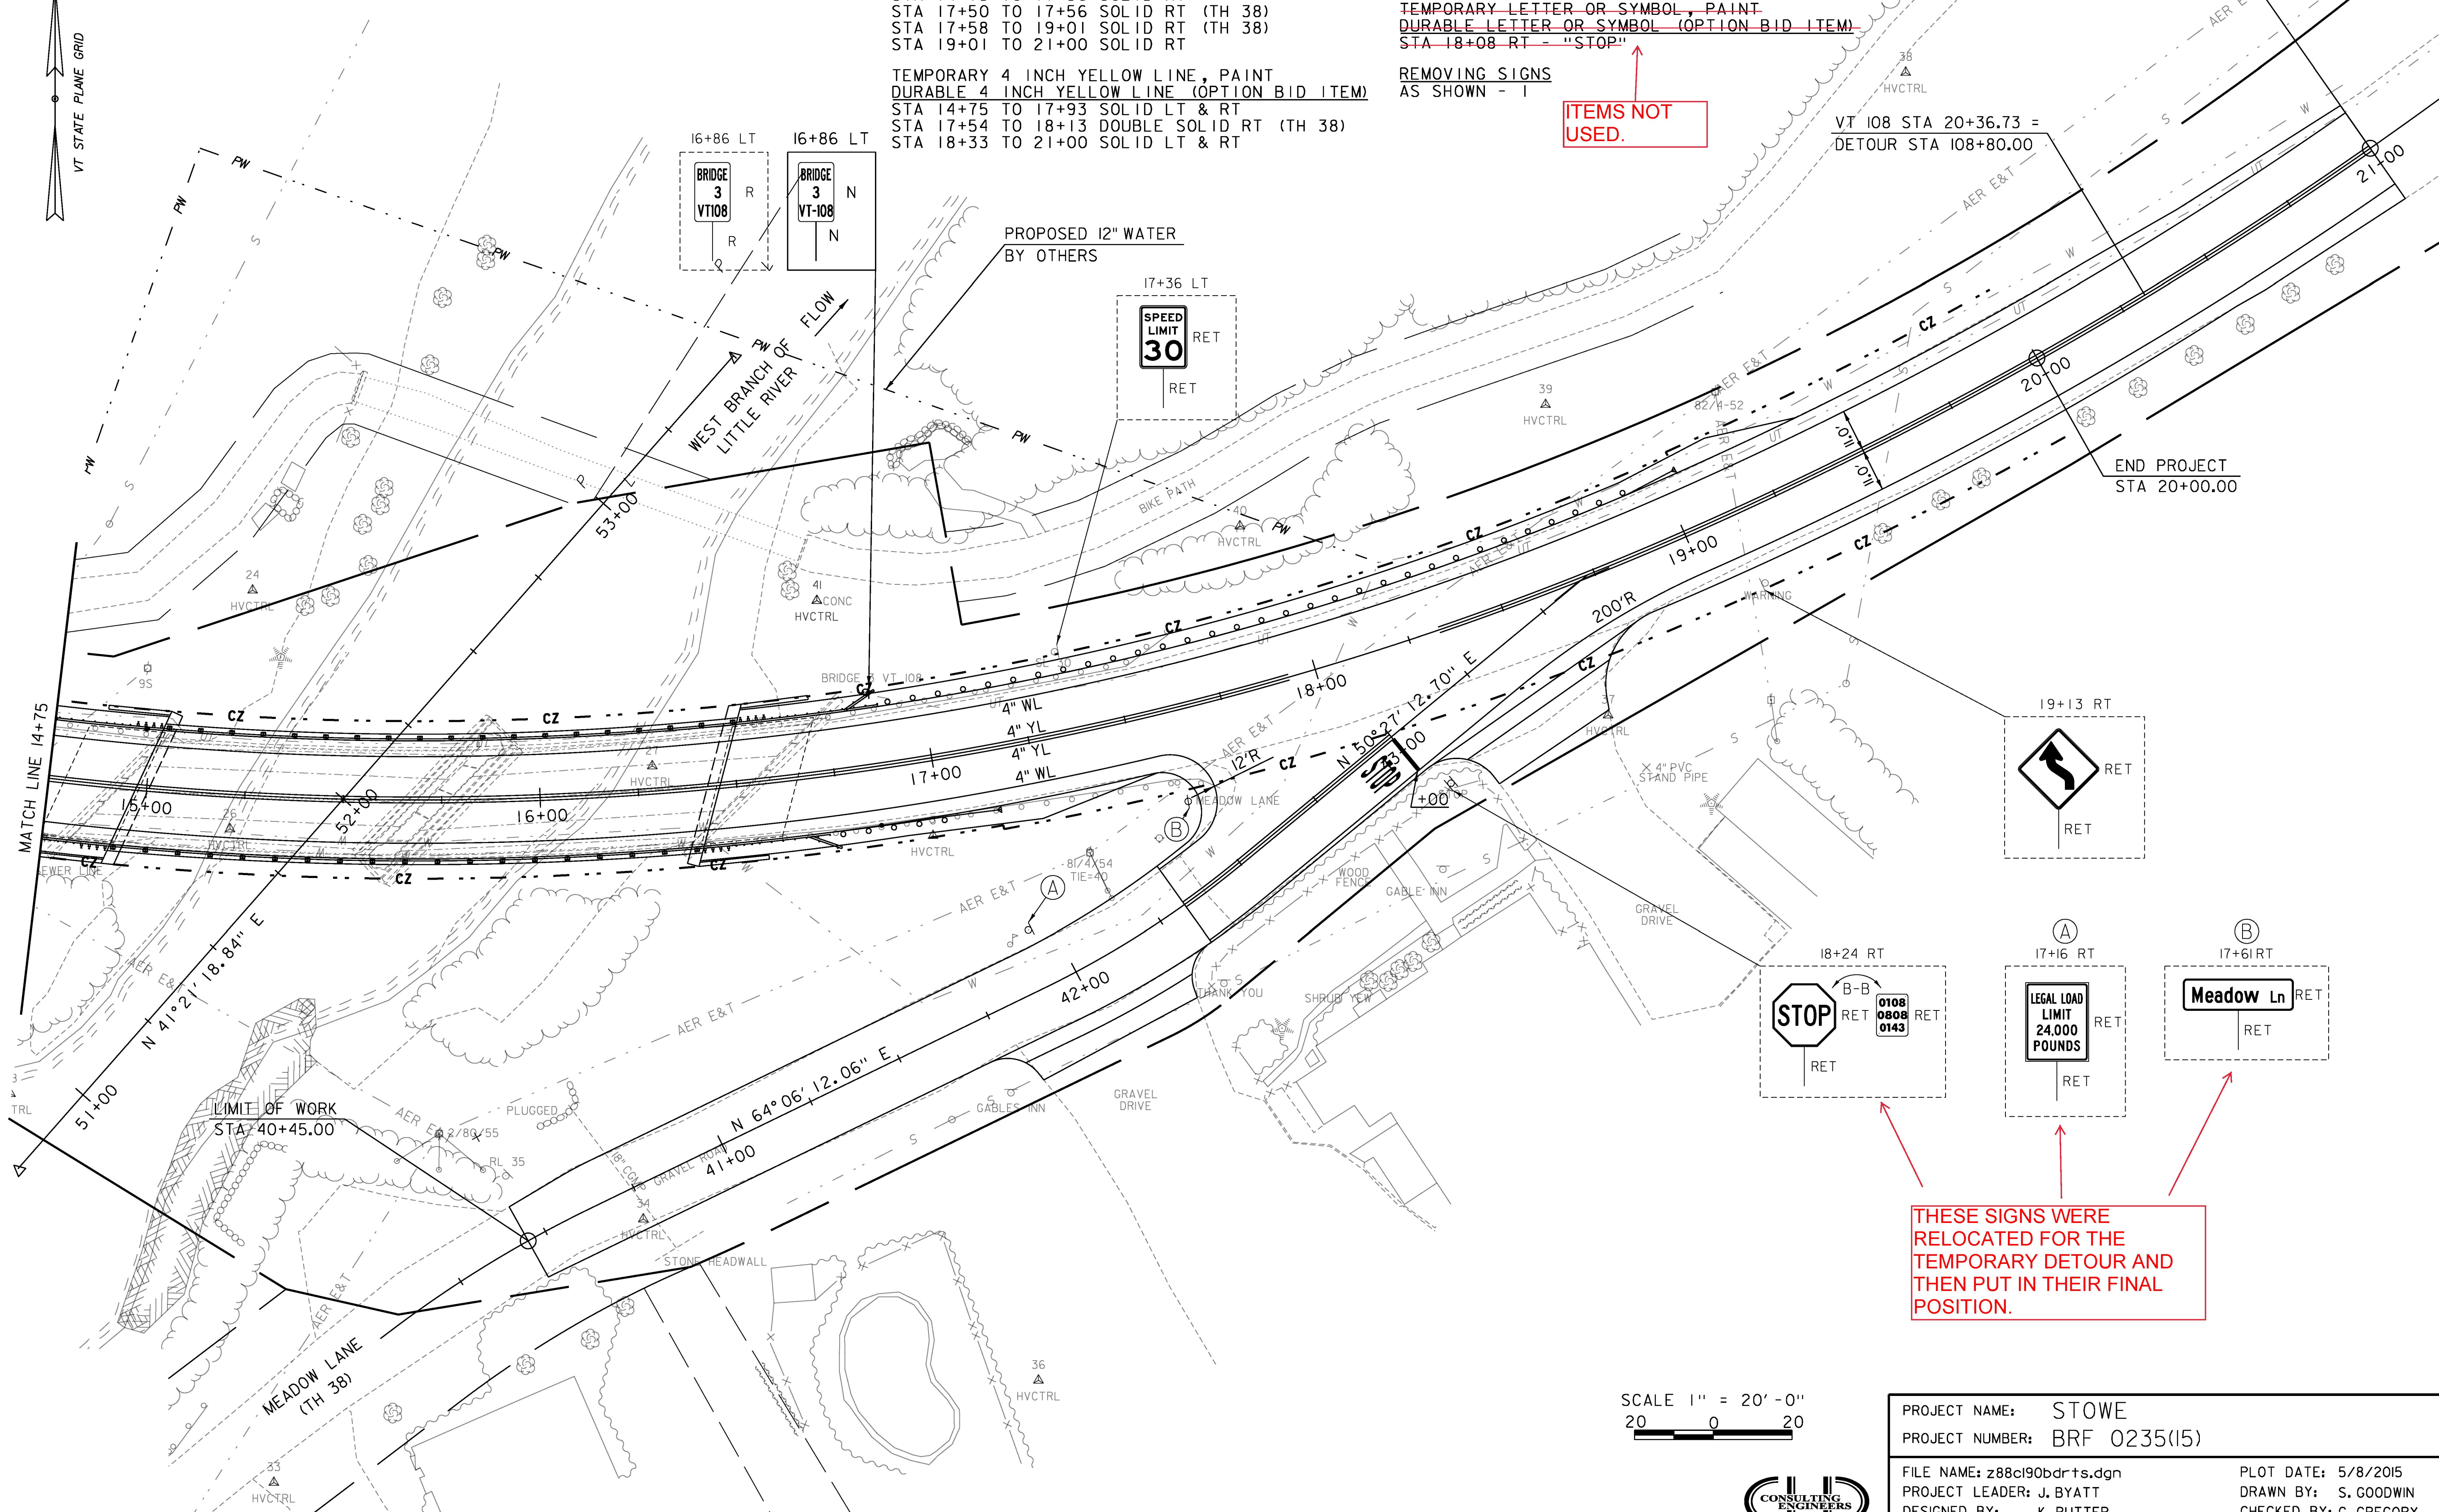

THESE SIGNS WERE RELOCATED FOR THE TEMPORARY DETOUR AND THEN PUT IN THEIR FINAL POSITION.

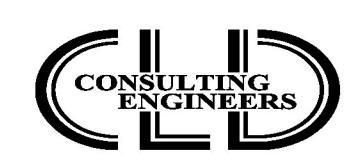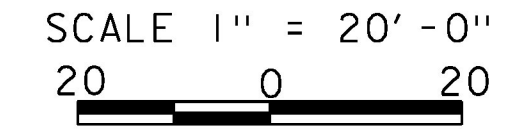

PROJECT NAME: STOWE
 PROJECT NUMBER: BRF 0235(15)
 FILE NAME: z88c190bdrts.dgn
 PROJECT LEADER: J. BYATT
 DESIGNED BY: K. RUTTER
 TRAFFIC SIGN & LINE LAYOUT SHEET 2

PLOT DATE: 5/8/2015
 DRAWN BY: S. GOODWIN
 CHECKED BY: C. GREGORY
 SHEET 27 OF 79

CLD 12-0120 MODEL:02