


DECK TYPICAL  
SCALE: 1/2" = 1'-0"

\* RADIAL DIMENSION

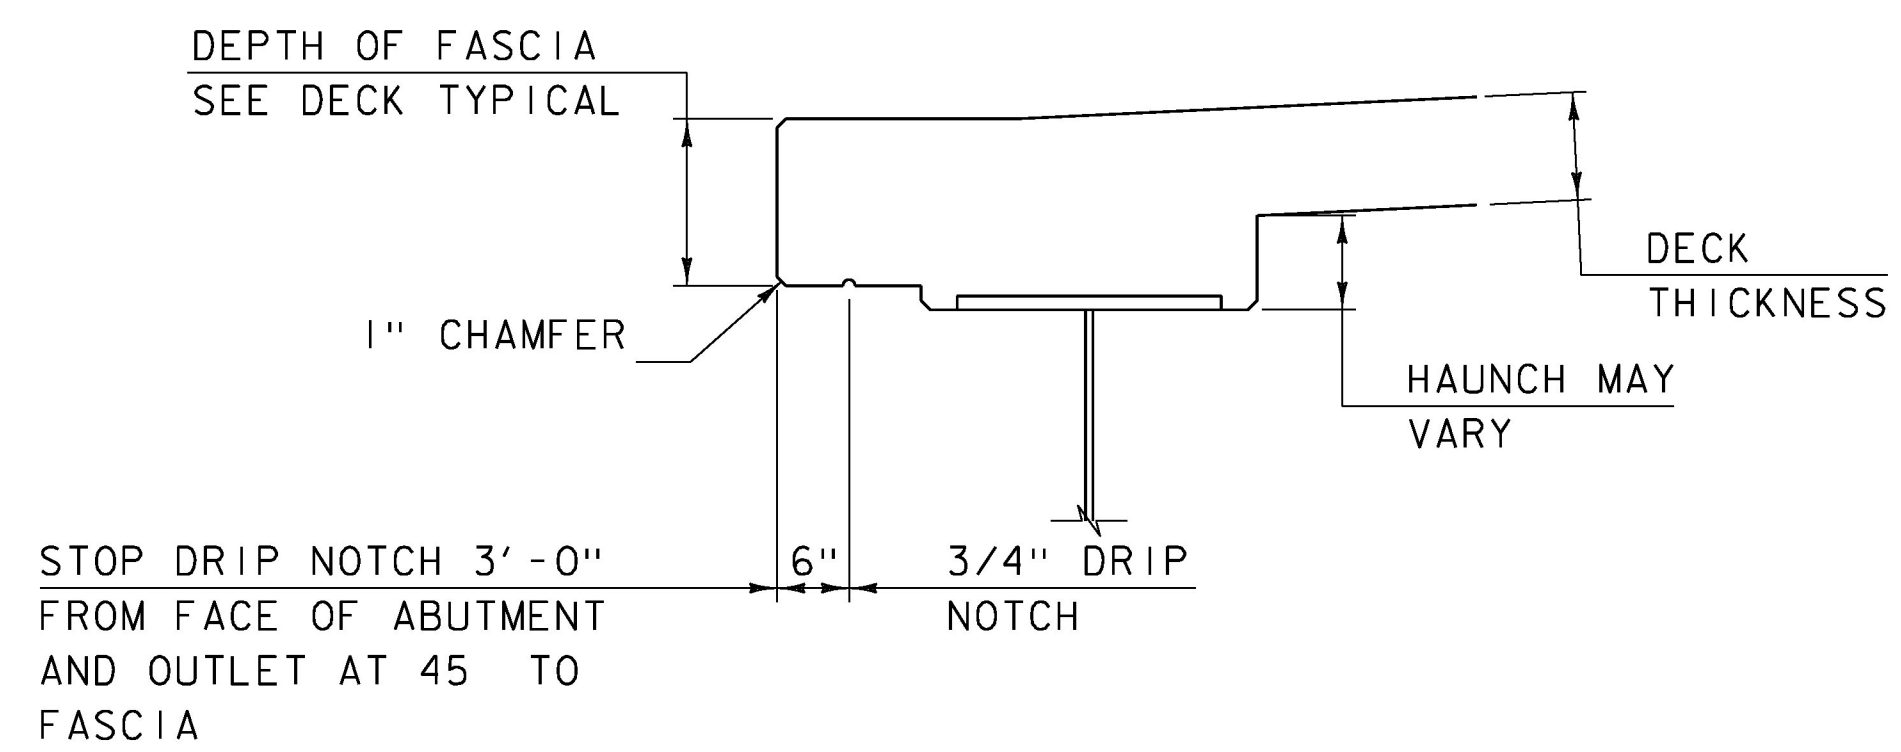

FASCIA & DRIP NOTCH DETAIL  
SCALE: 3/8" = 1'-0"

CLD 12-0120 MODEL: Deck Reinforcement

PROJECT NAME: STOWE	
PROJECT NUMBER: BRF 0235(15)	
FILE NAME: z88cl90sup.dgn	PLOT DATE: 5/8/2015
PROJECT LEADER: J. BYATT	DRAWN BY: M. SMITH
DESIGNED BY: J. FRENCH	CHECKED BY: J. BYATT
TYPICAL BRIDGE SECTION	SHEET 35 OF 79

