


REINFORCING STEEL SCHEDULE

ITEM	EACH	SIZE	LENGTH	MARK	TYPE	A	B	C	D	E	F	G	H	J	K	R	O	ITEM	EACH	SIZE	LENGTH	MARK	TYPE	A	B	C	D	E	F	G	H	J	K	R	O						
DECK																																									
	210	5	39'- 9"	S501.2	STR	39'- 9"																																			
*	▲	183	5	34'- 11"	S502.2	STR	34'- 11"																																		
*	▲	274	5	30'- 11"	S503.2	STR	30'- 11"																																		
		546	6	4'- 6"	S601.2	22		2'- 6"	2'- 0"	0'- 0"			0'- 2"	0'- 0"	2'- 6"	0'- 0"																									
*		75	7	20'- 0"	S701.2	STR	20'- 0"																																		
ABUTMENT #1																																									
	354	4	3'- 7"	1A401	16	0'- 6"	2'- 7"	0'- 0"	0'- 6"					0'- 4"	0'- 4"																										
*		25	5	21'- 11"	1A501	STR	21'- 11"																																		
		51	5	6'- 11"	1A502	17		2'- 2"	2'- 7"	2'- 2"																															
		8	5	7'- 1"	1A503	14	2'- 2"	0'- 0"	0'- 0"	2'- 9"	2'- 2"			0'- 10"	2'- 5"																										
		16	6	22'- 2"	1A601	STR	22'- 2"																																		
	330	4	3'- 7"	1A401.2	16	0'- 6"	2'- 7"	0'- 0"	0'- 6"					0'- 4"	0'- 4"																										
*		15	5	22'- 2"	1A501.2	STR	22'- 2"																																		
		31	5	3'- 5"	1A502.2	17		2'- 2"	1'- 3"	0'- 0"																															
		9	5	7'- 1"	1A503.2	14	2'- 2"	0'- 0"	0'- 0"	2'- 9"	2'- 2"			0'- 10"	2'- 5"																										
		32	5	5'- 8"	1A504.2	1	0'- 11"		3'- 10"				0'- 11"		0'- 5"																										
		34	5	6'- 0"	1A505.2	22		3'- 6"	2'- 6"	0'- 0"			2'- 6"		2'- 6"																										
		12	5	9'- 7"	1A506.2	17		3'- 6"	2'- 7"	3'- 6"																															
		35	5	10'- 0"	1A507.2	STR	10'- 0"																																		
		9	5	6'- 11"	1A508.2	17	6'- 11"																																		
	114	7	13'- 4"	1A701.2	17		2'- 7"	10'- 9"	0'- 0"																																
	114	7	6'- 3"	1A702.2	STR	6'- 3"																																			
*		35	7	11'- 0"	1A703.2	17		7'- 6"	3'- 6"	0'- 0"																															
ABUTMENT #2																																									
	354	4	3'- 7"	2A401	16	0'- 6"	2'- 7"	0'- 0"	0'- 6"					0'- 4"	0'- 4"																										
	24	5	21'- 11"	2A501	STR	21'- 11"																																			
	51	5	6'- 11"	2A502	17		2'- 2"	2'- 7"	2'- 2"																																
	8	5	7'- 1"	2A503	14	2'- 2"	0'- 0"	0'- 0"	2'- 9"	2'- 2"				0'- 11"	2'- 5"																										
*		17	6	22'- 2"	2A601	STR	22'- 2"																																		
	330	4	3'- 7"	2A401.2	16	0'- 6"	2'- 7"	0'- 0"	0'- 6"					0'- 4"	0'- 4"																										
	14	5	22'- 2"	2A501.2	STR	22'- 2"																																			
	31	5	3'- 5"	2A502.2	17		2'- 2"	1'- 3"	0'- 0"																																
	9	5	7'- 1"	2A503.2	14	2'- 2"	0'- 0"	0'- 0"	2'- 9"	2'- 2"				0'- 11"	2'- 5"																										
	32	5	5'- 8"	2A504.2	1	0'- 11"		3'- 10"					0'- 11"		0'- 5"																										
	34	5	6'- 0"	2A505.2	22		3'- 6"	2'- 6"	0'- 0"				2'- 6"		2'- 6"																										
	12	5	9'- 7"	2A506.2	17		3'- 6"	2'- 7"	3'- 6"																																
	35	5	10'- 0"	2A507.2	STR	10'- 0"																																			
	9	5	6'- 11"	2A508.2	17	6'- 11"																																			
	114	7	13'- 1"	2A701.2	17		2'- 7"	10'- 6"	0'- 0"																																
	114	7	6'- 3"	2A702.2	STR	6'- 3"																																			
	34	7	11'- 0"	2A703.2	17		7'- 6"	3'- 6"	0'- 0"																																
APPROACH SLAB #1																																									
▲	19	5	30'- 4"	1EAS501	STR	30'- 4"																																			
*	▲	36	9	20'- 2"	1EAS901	1	1'- 6"	18'- 8"							0'- 11"																										
APPROACH SLAB #2																																									
▲	20	5	30'- 8"	2EAS501	STR	30'- 8"																																			
▲	36	9	21'- 8"	2EAS901	1	1'- 5"	20'- 3"								0'- 11"																										
SHEET PILE CONCRETE CAP																																									
▲	7	5	4'- 6"	1C501	STR	4'- 6"																																			
▲	6	5	9'- 6"	1C502	STR	9'- 6"																																			
	48	5	3'- 3"	1C503	STR	3'- 3"																																			
	8	5	27'- 1"	1C504	STR	27'- 1"																																			

~ NOTES ~

- UNLESS OTHERWISE DESIGNATED, ALL BAR REINFORCEMENT FOR CONCRETE IN SIZES UP TO AND INCLUDING NO. 18 SHALL CONFORM TO THE REQUIREMENTS OF THE "SPECIFICATIONS FOR DEFORMED BILLET-STEEL BARS FOR CONCRETE REINFORCEMENT", AASHTO M31 (ASTM A615-SI). ALL BARS SHALL BE GRADE 60, UNLESS OTHERWISE DESIGNATED.
- FOR TYPICAL BENDING DETAILS, RECOMMENDED PIN DIAMETER "D" OF BENDS AND HOOKS, AND OTHER STANDARD PRACTICE, SEE CURRENT CONCRETE REINFORCING STEEL INSTITUTE "MANUAL OF STANDARD PRACTICE".
- BARS WHICH REQUIRE MORE ACCURATE BENDING THAN STANDARD PRACTICES SHOULD HAVE LIMITS INDICATED.
- ALL DIMENSIONS ARE OUT TO OUT OF BAR EXCEPT "A" AND "G" ON STANDARD 180 DEGREE AND 135 DEGREE HOOKS.
- "J" DIMENSION ON 180 DEGREE HOOKS TO BE SHOWN ONLY WHERE NECESSARY TO RESTRICT HOOK SIZE. OTHERWISE, STANDARD HOOKS ARE TO BE USED.
- "H" DIMENSION ON STIRRUPS TO BE SHOWN ONLY WHEN NECESSARY TO MAINTAIN CLEARANCES.
- WHERE SLOPE DIFFERS FROM 45 DEGREES, DIMENSIONS "H" AND "K" MUST BE SHOWN.
- ▲ DENOTES BARS TO BE CUT IN FIELD.
- * DENOTES ONE EXTRA BAR ADDED FOR TESTING PURPOSES.
- △ DENOTES TWO EXTRA BARS ADDED FOR TESTING PURPOSES.
- E IN BAR MARK PREFIX DENOTES EPOXY COATED REINFORCING STEEL.

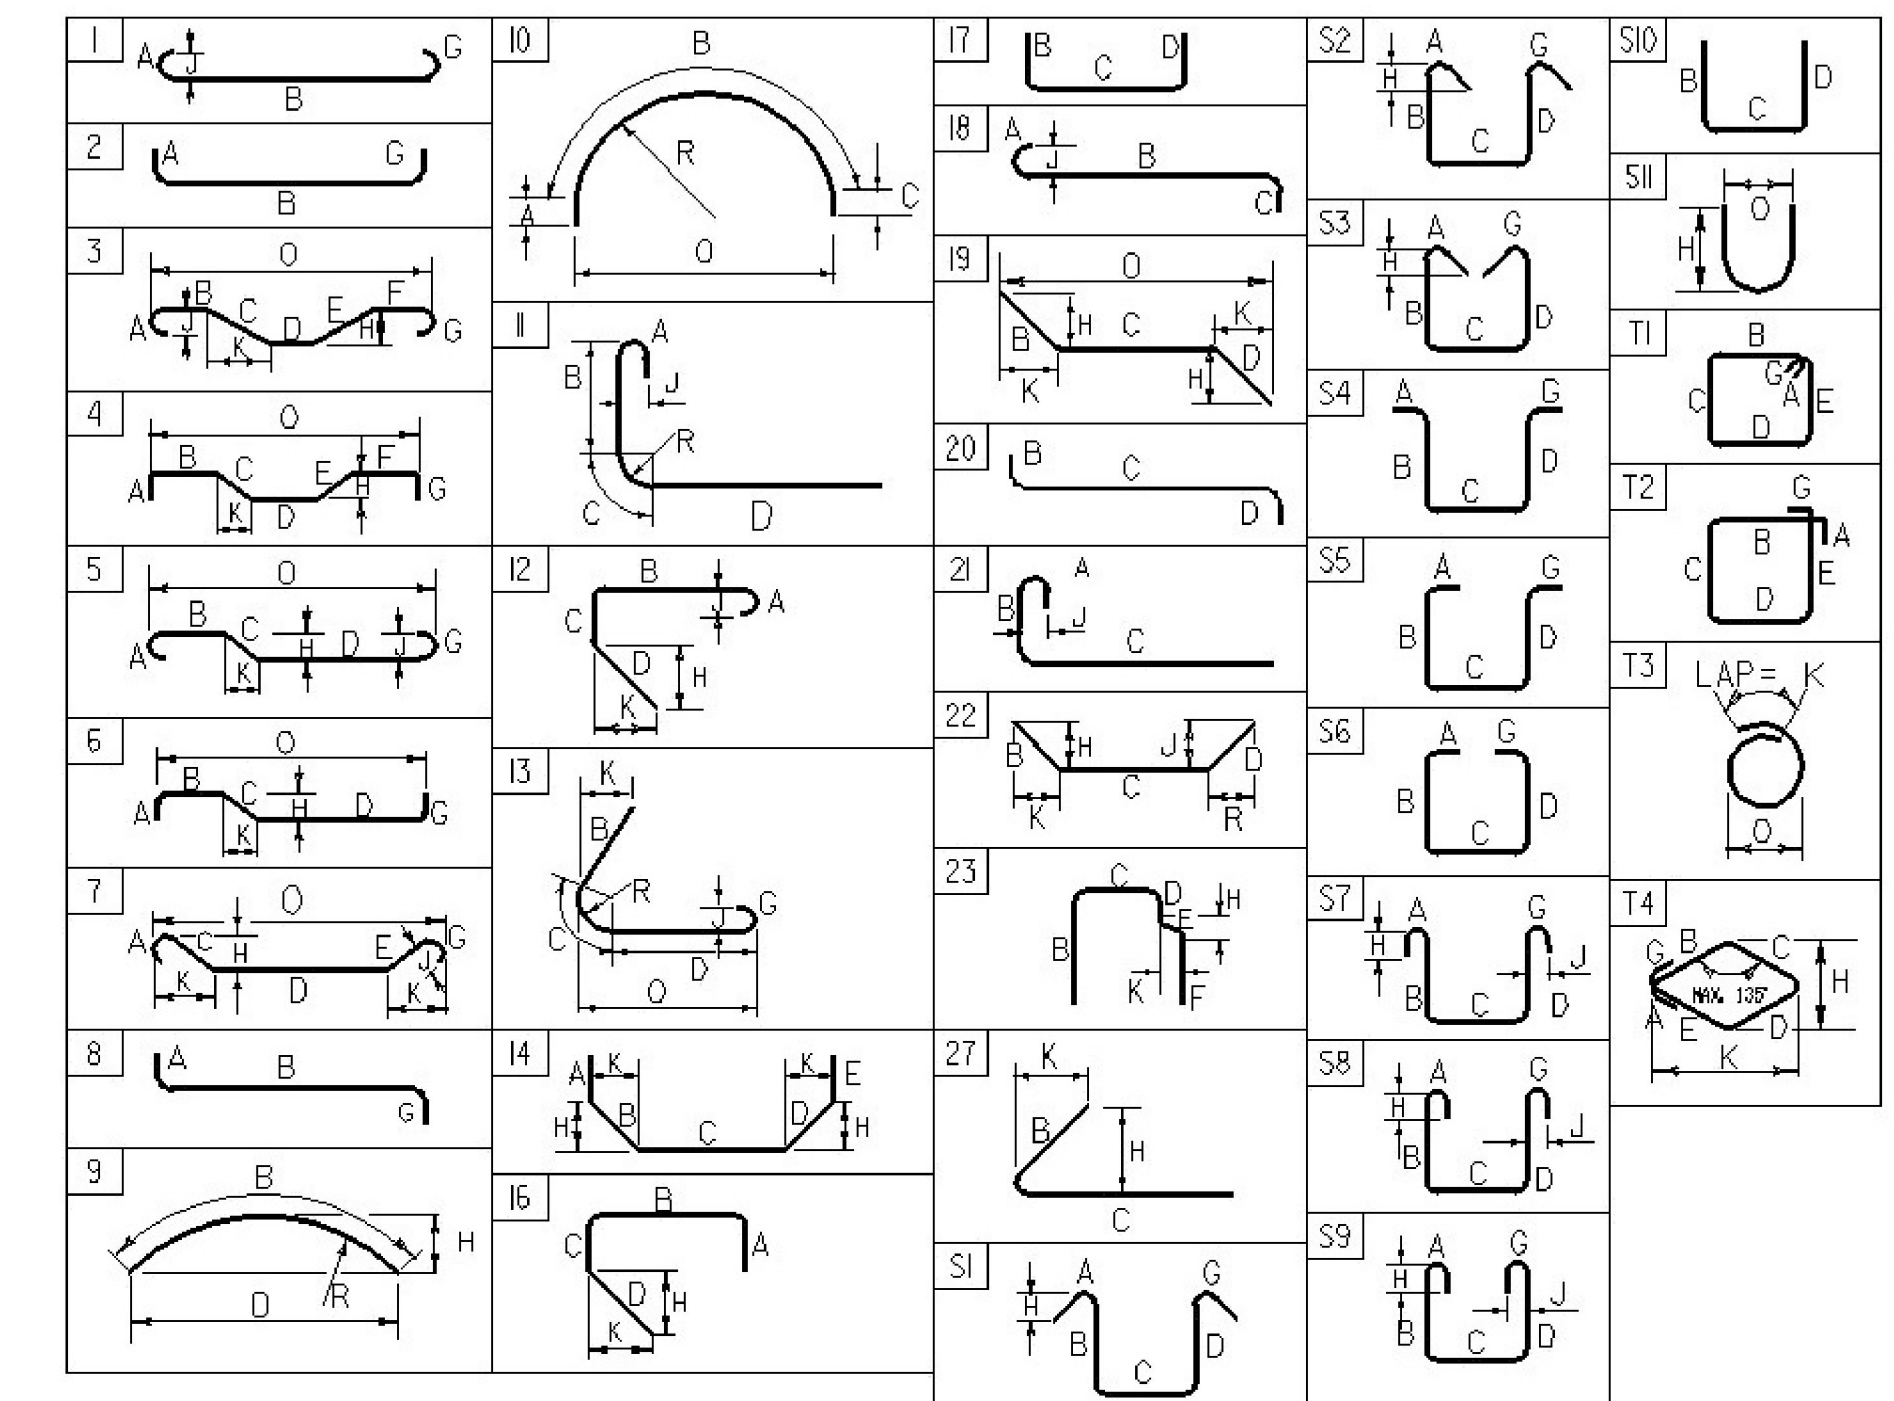

ASTM STANDARD REINFORCING BARS				
BAR SIZE DESIGNATION	WEIGHT POUNDS PER FOOT	NOMINAL DIMENSIONS ROUND SECTION		
		DIAMETER INCHES	AREA INCHES ²	PERIMETER INCHES
#3	0.376	0.375	0.11	1.178
#4	0.668	0.500	0.20	1.571
#5	1.043	0.625	0.31	1.963
#6	1.502	0.750	0.44	2.356
#7	2.044	0.875	0.60	2.749
#8	2.670	1.000	0.79	3.142
#9	3.400	1.128	1.00	3.544
#10	4.303	1.270	1.27	3.990
#11	5.313	1.410	1.56	4.430
#14	7.65	1.693	2.25	5.32
#18	13.60	2.257	4.00	7.09

PROJECT NAME: **STOWE**
 PROJECT NUMBER: **BRF 0235(15)**
 FILE NAME: z88ci90schedule.dgn
 PROJECT MANAGER: J. BYATT
 DESIGNED BY: A. GIRALDI
 REINFORCING STEEL SCHEDULE SHEET

PLOT DATE: 5/6/2015
 DRAWN BY: M. SMITH
 CHECKED BY: J. FRENCH
 SHEET 51 OF 79