




CLD 12-0120 MODEL: VTI08 XS 3

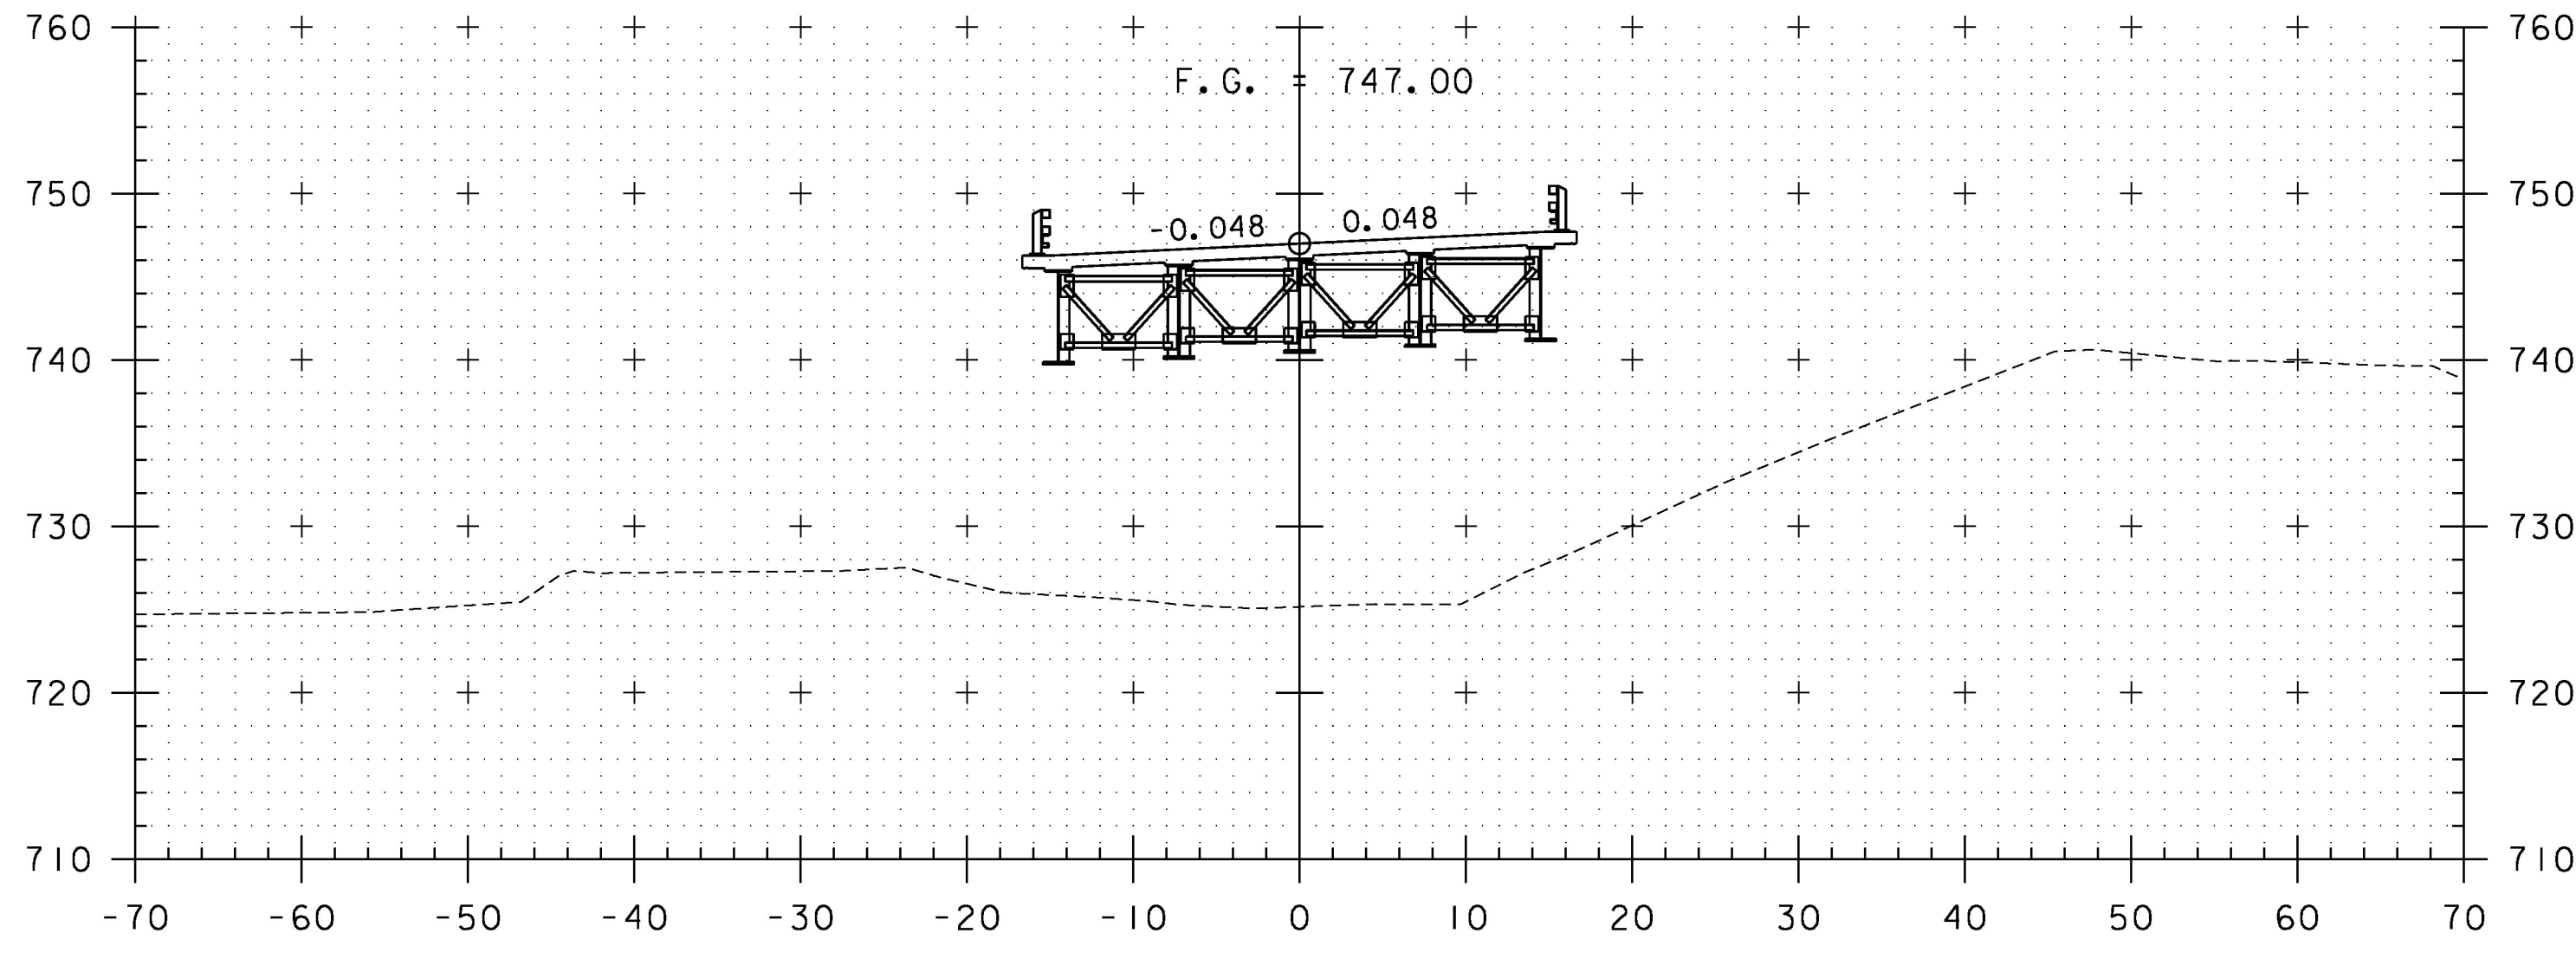


16+00

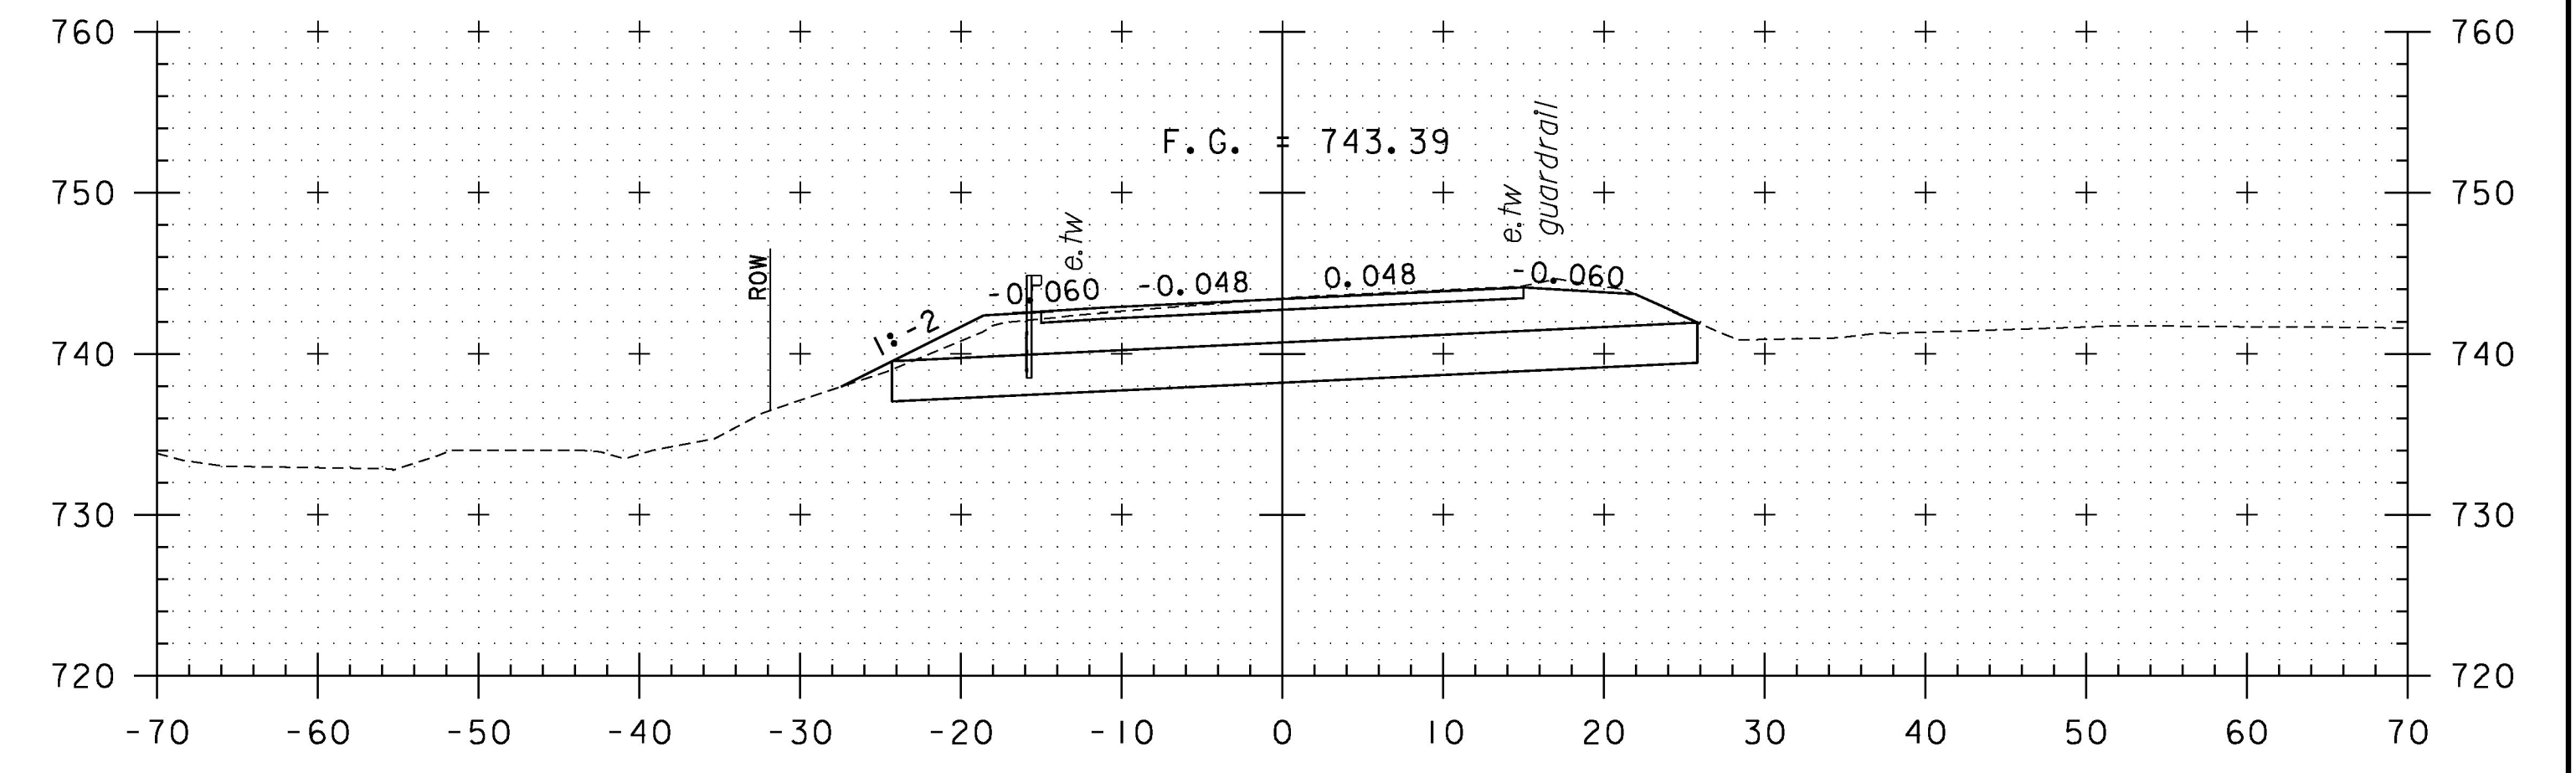


17+50

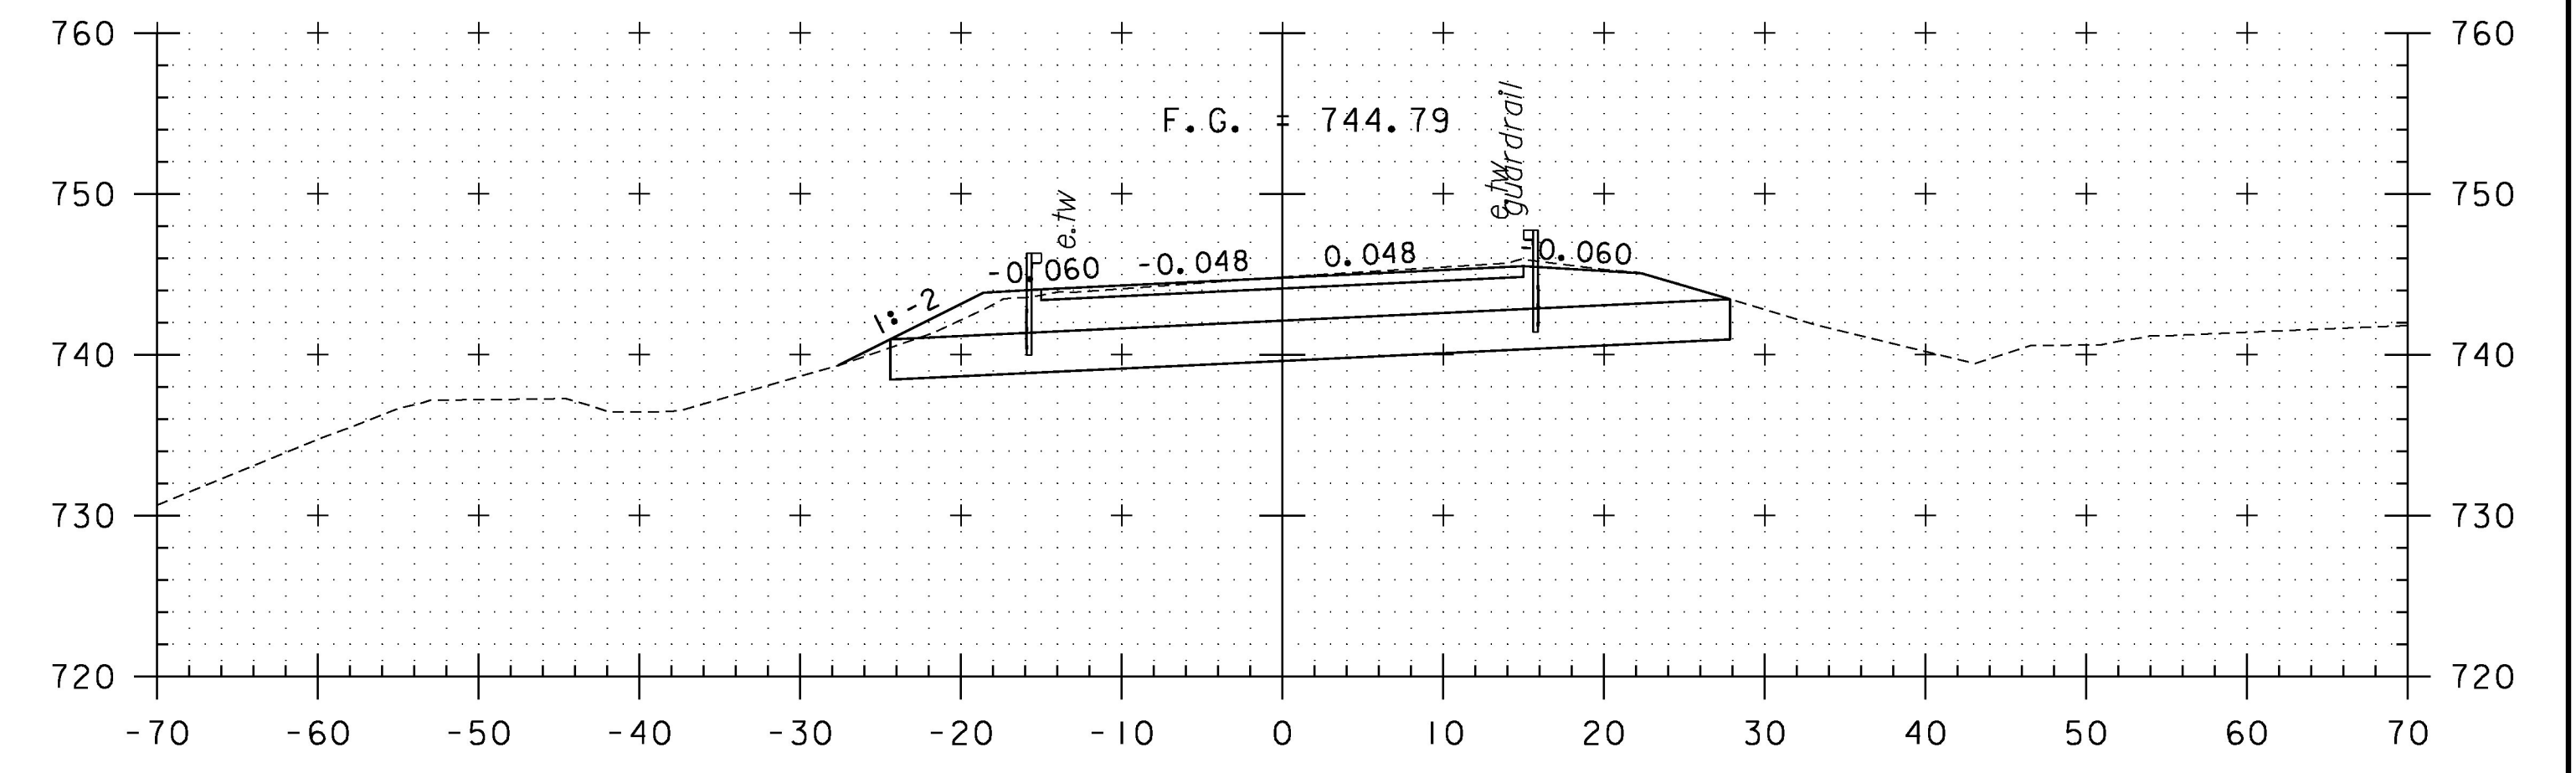

17+00

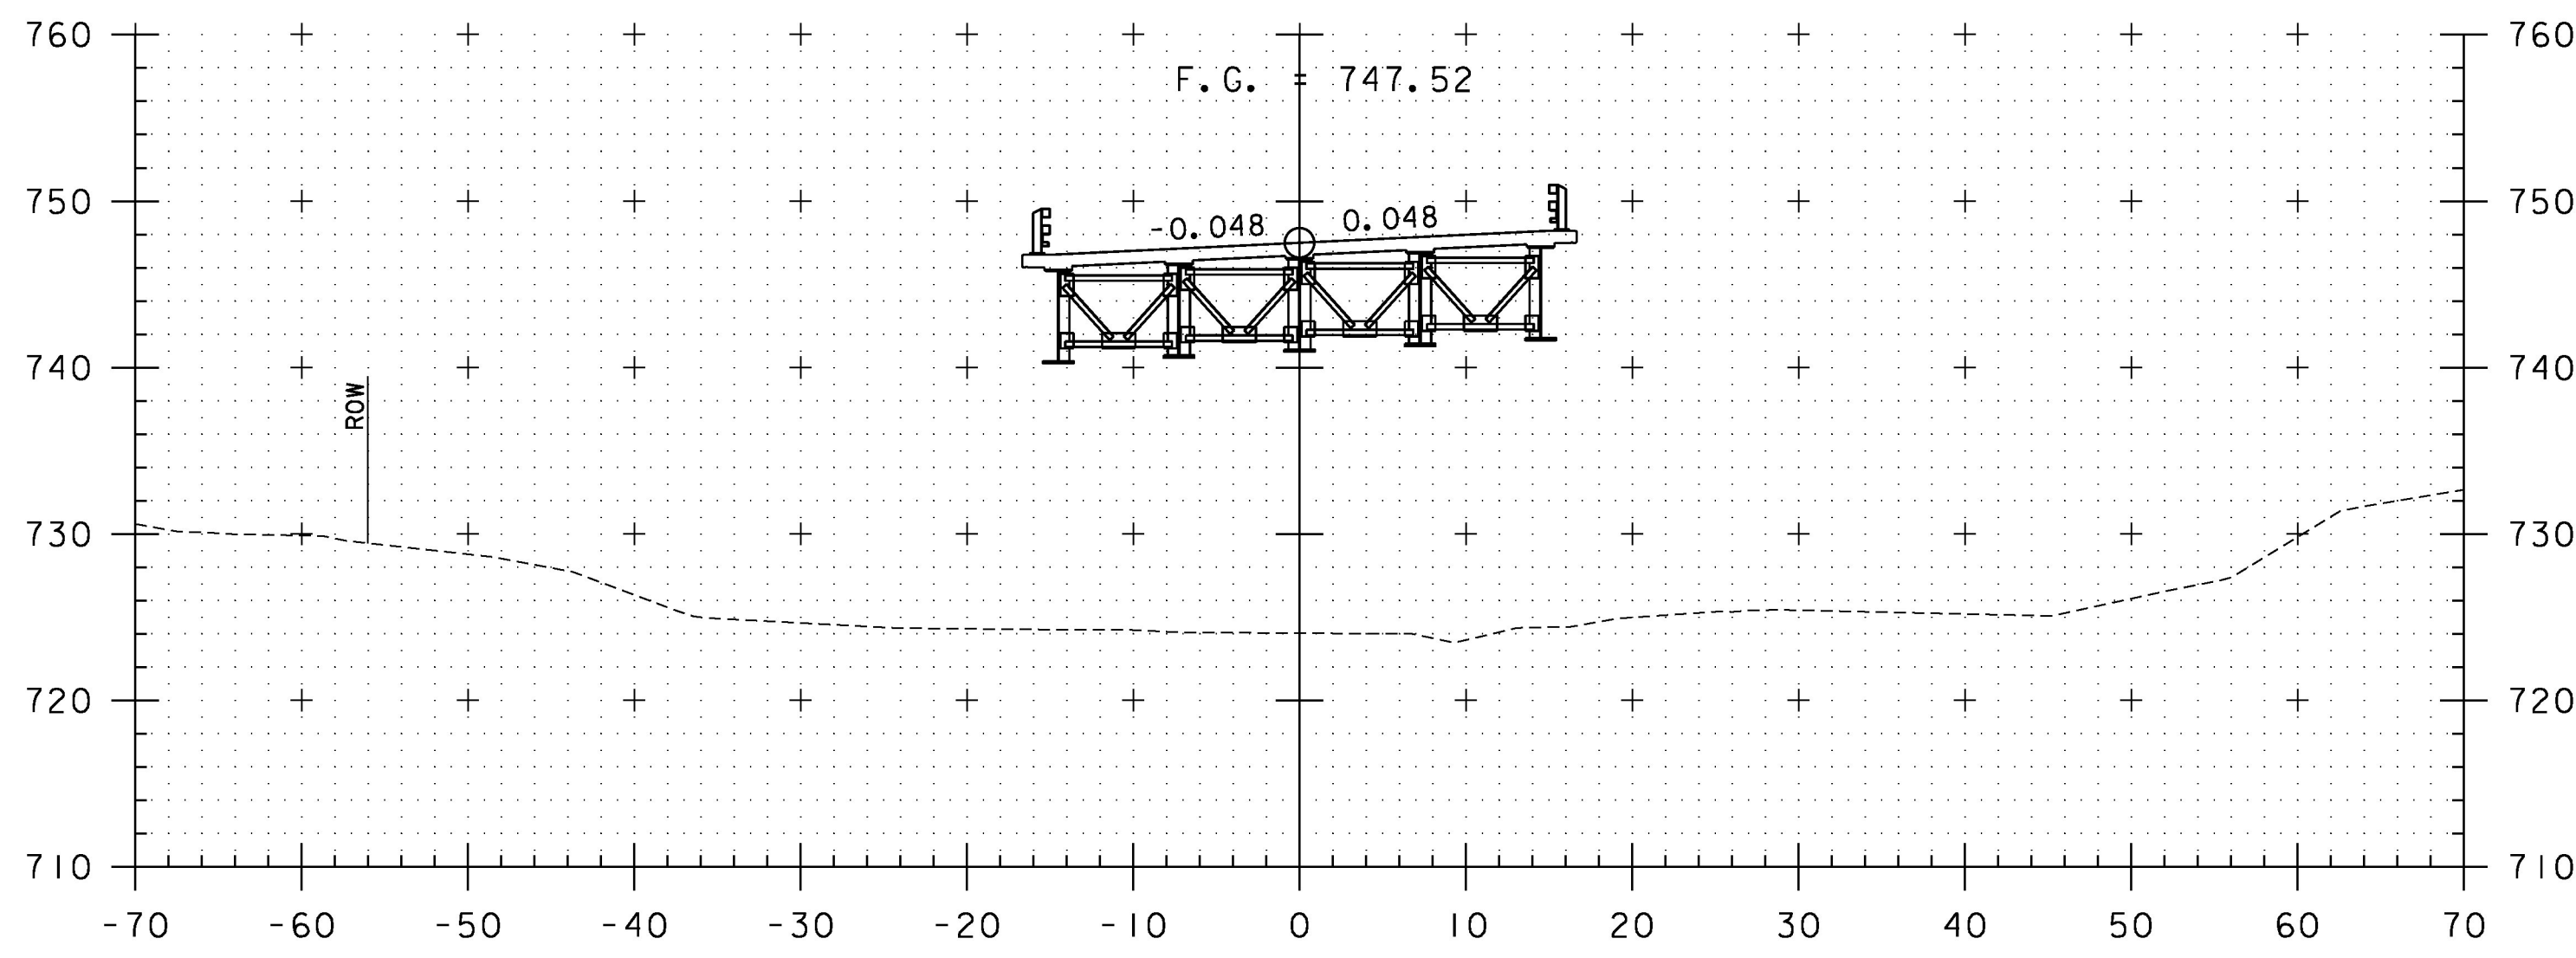

15+50

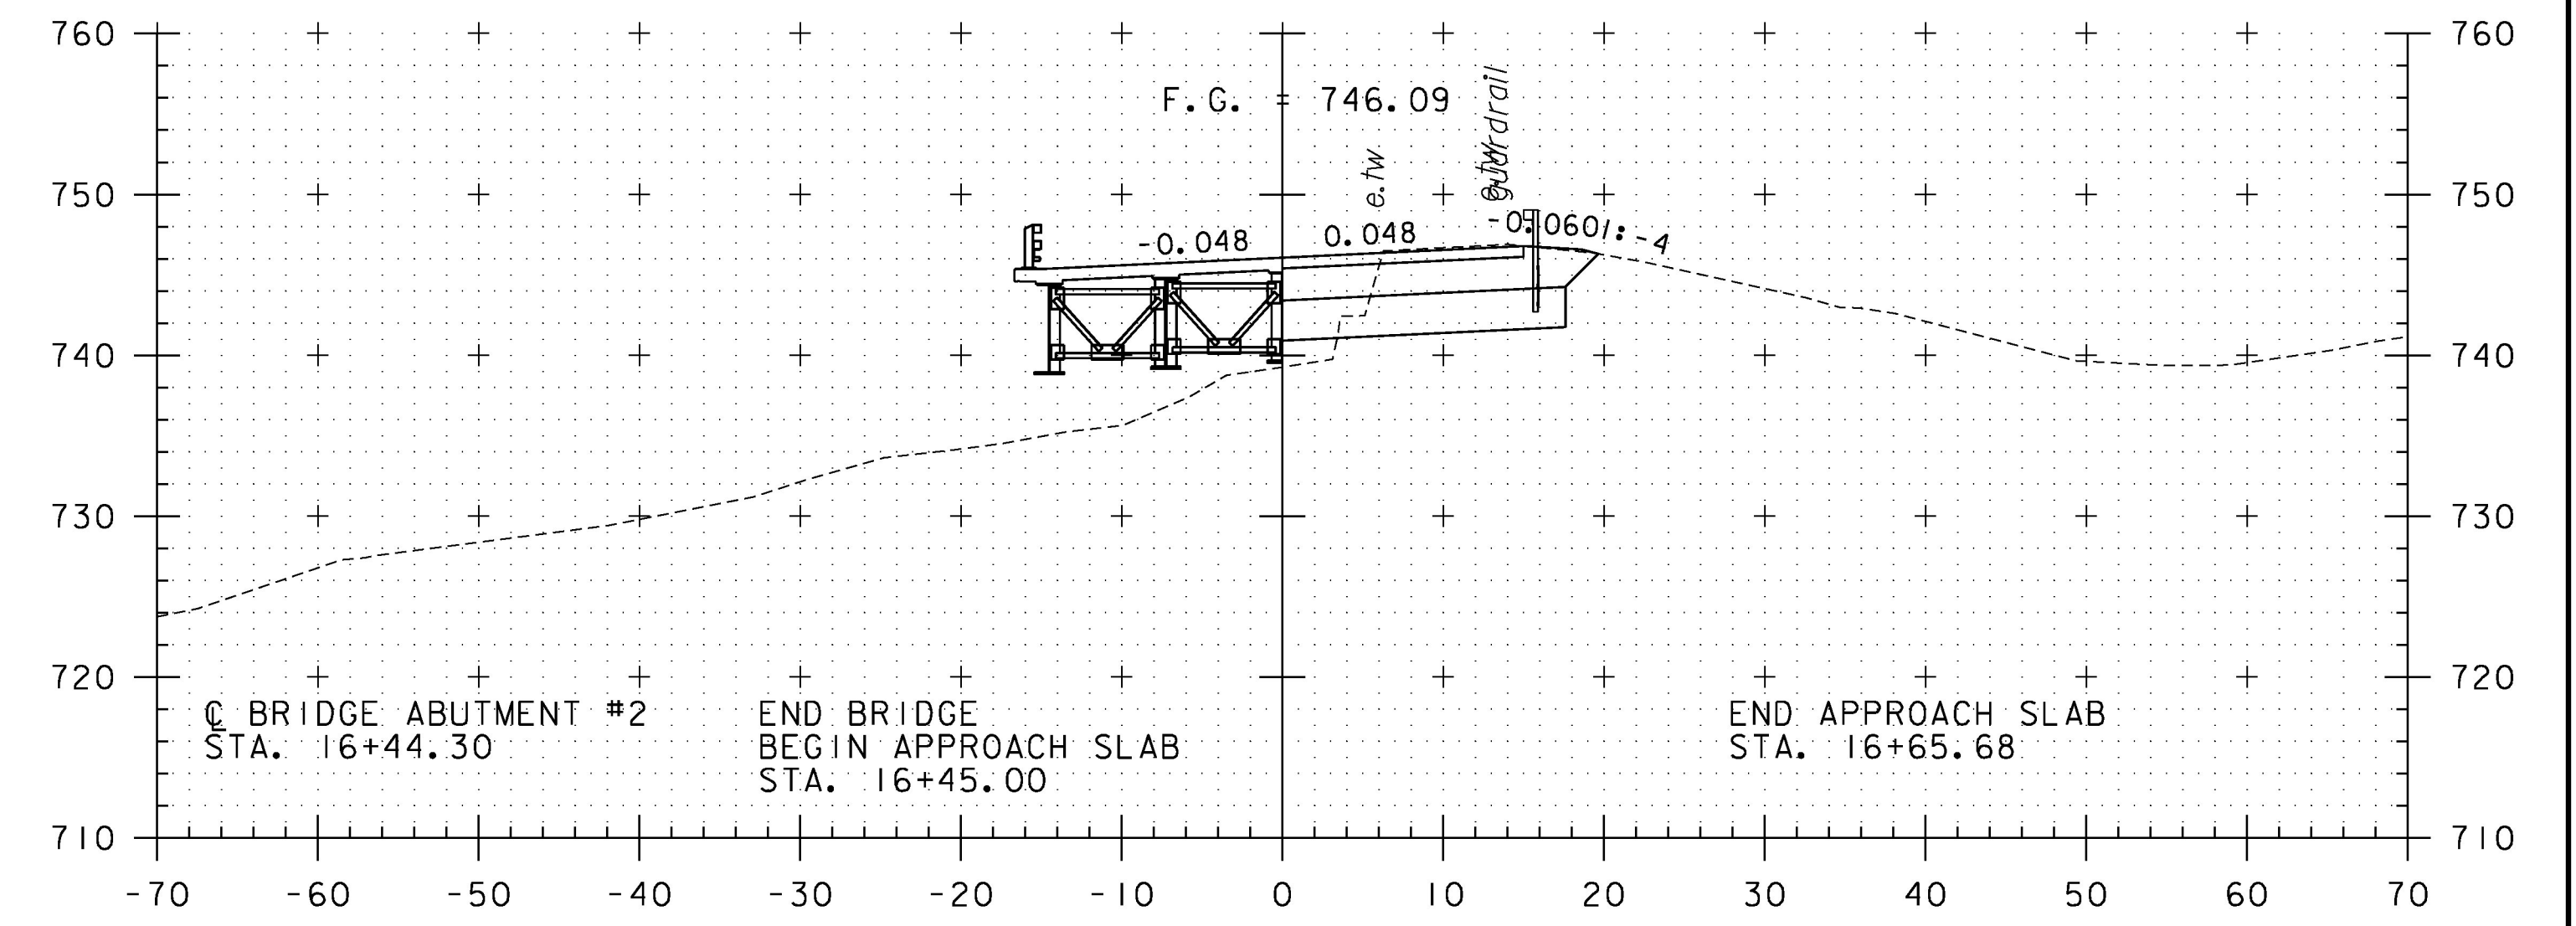

16+50

STA. 15+50 TO STA. 17+50

PROJECT NAME:	STOWE
PROJECT NUMBER:	BRF 0235(15)
FILE NAME:	z88c190xsl.dgn
PROJECT LEADER:	J. BYATT
DESIGNED BY:	K. RUTTER
VT 108 CROSS SECTIONS	
PLOT DATE:	5/8/2015
DRAWN BY:	K. RUTTER
CHECKED BY:	C. GREGORY
SHEET	55 OF 79

