




CLD 12-0120 MODEL: MEADOW LANE XS 2

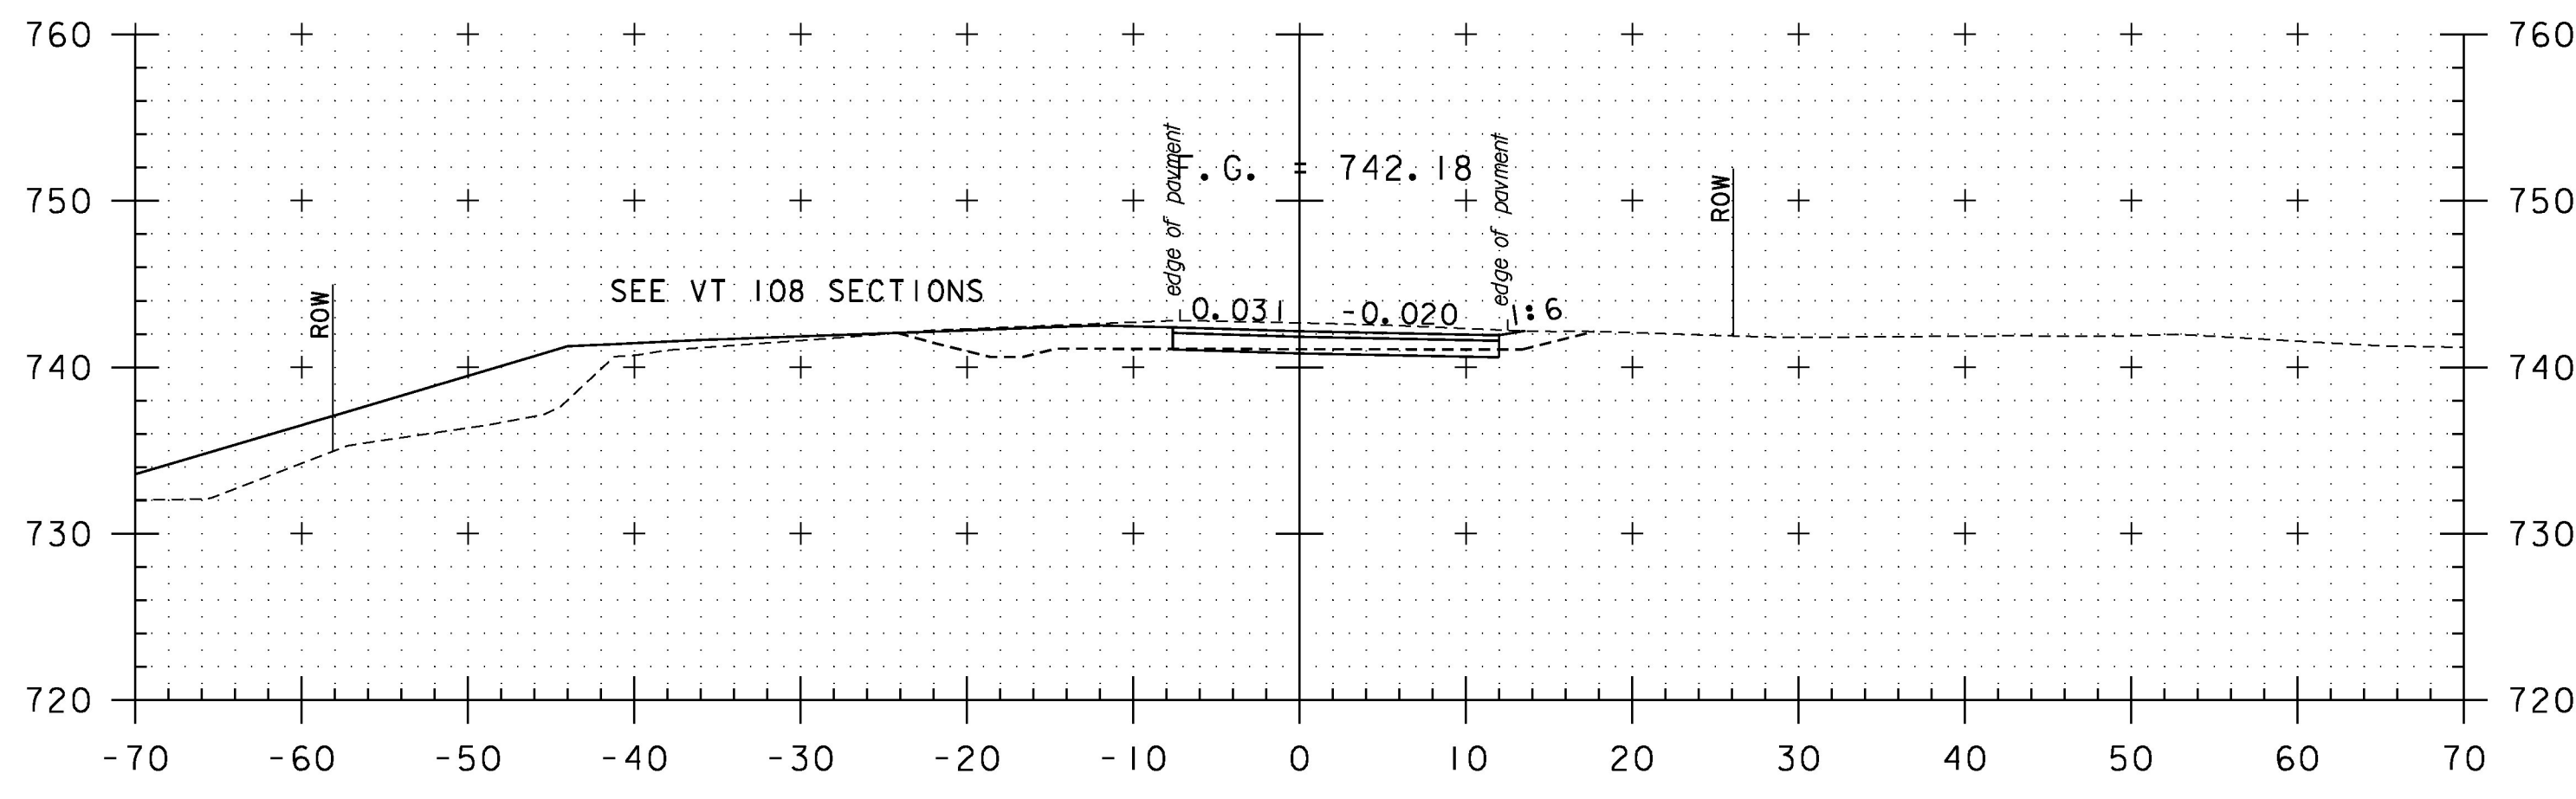


43+00

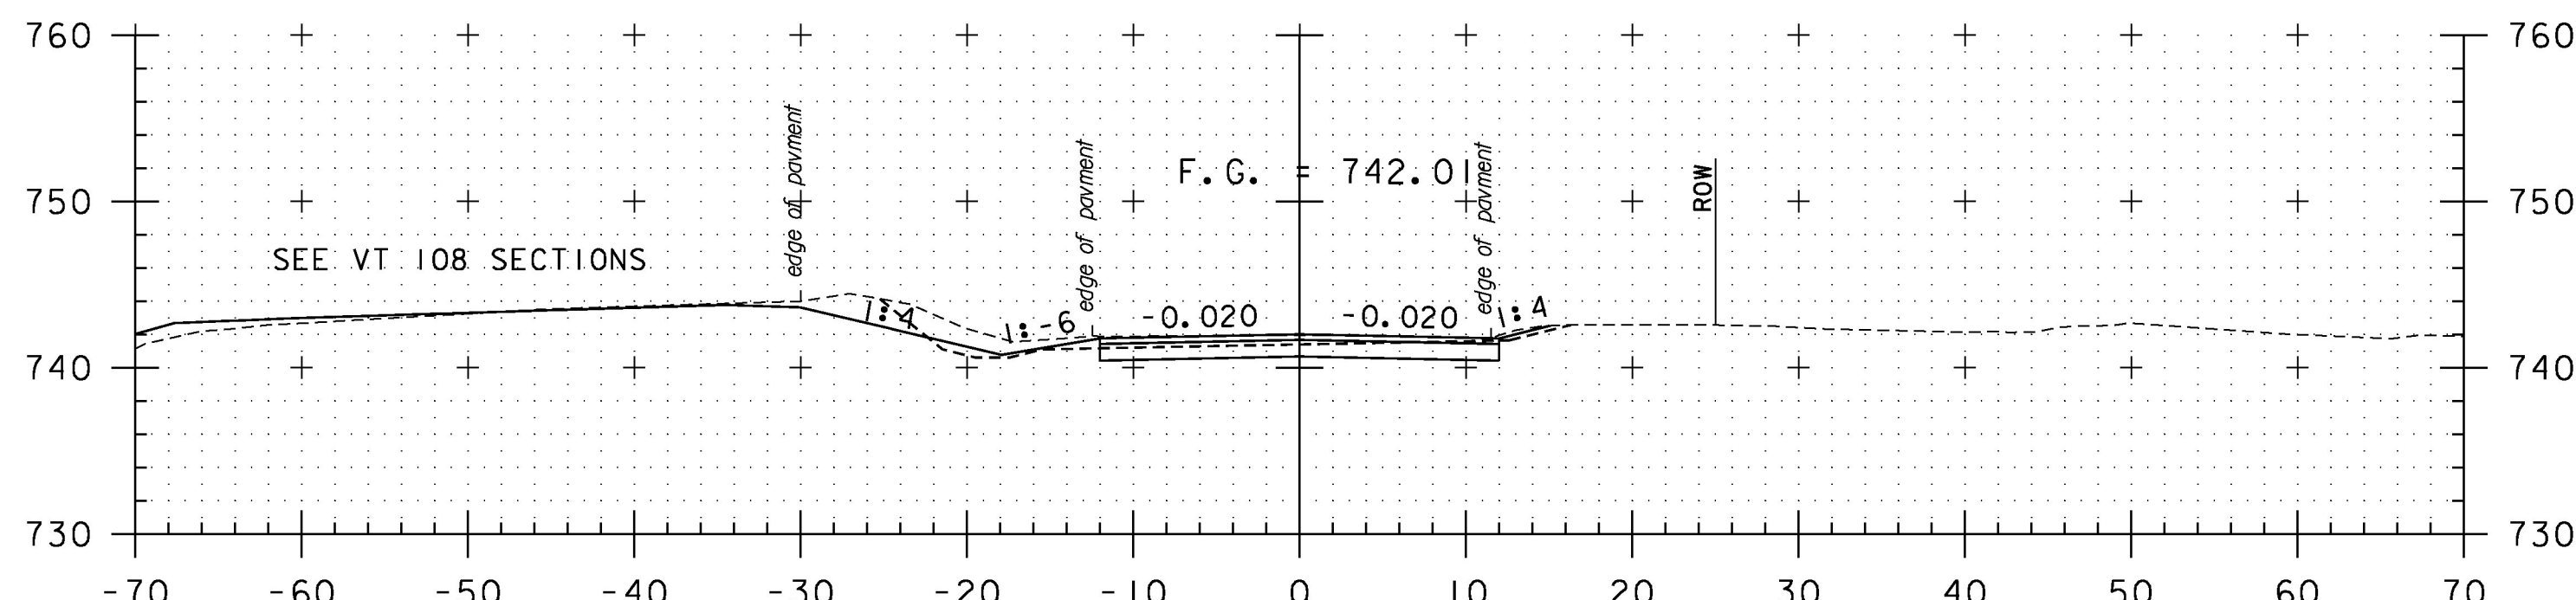


42+50

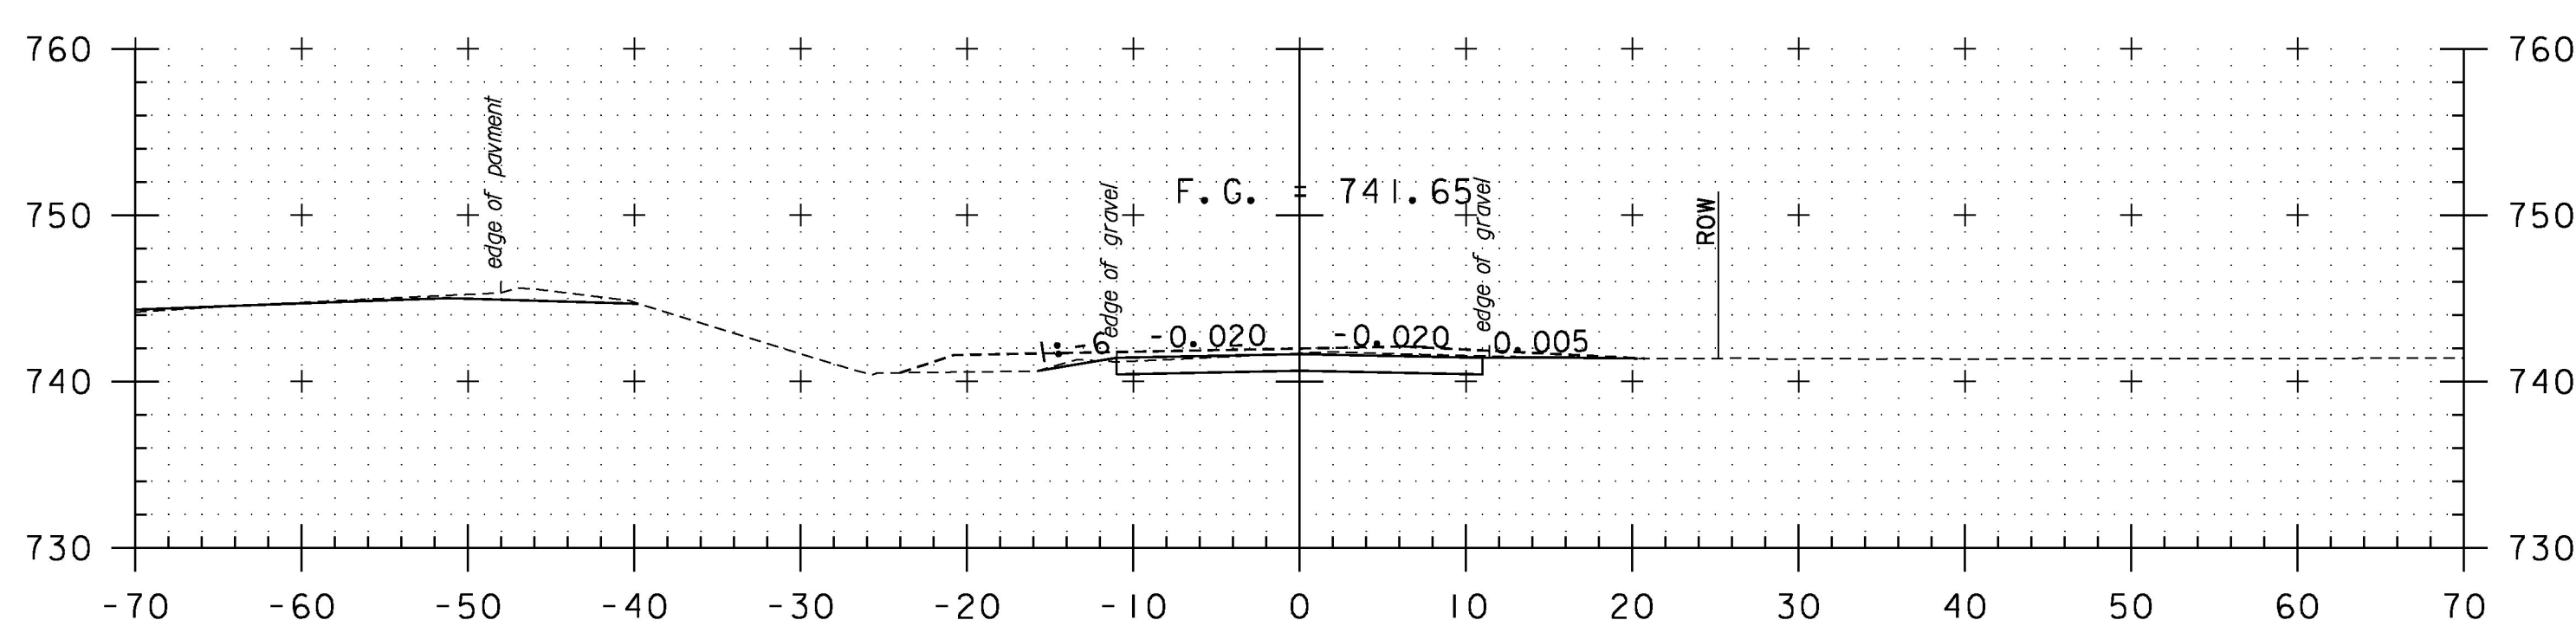


42+00
DRIVE RT

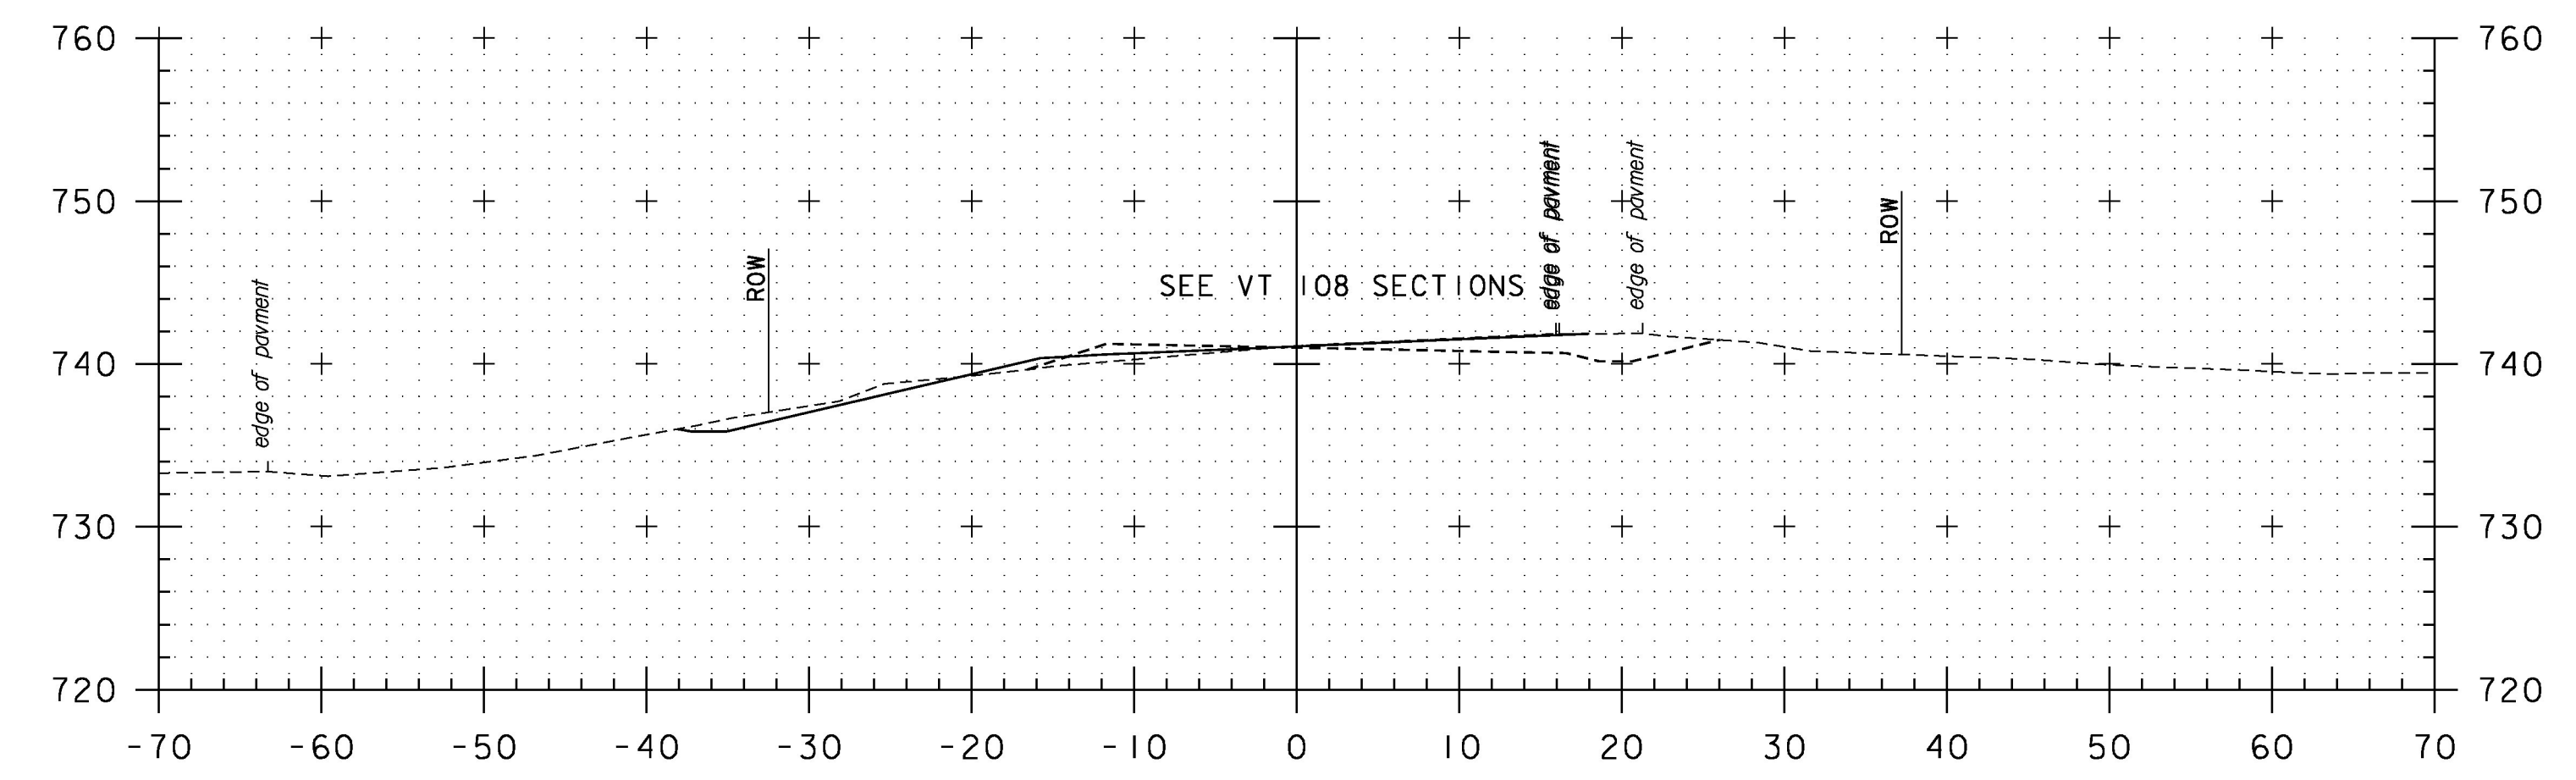

43+65

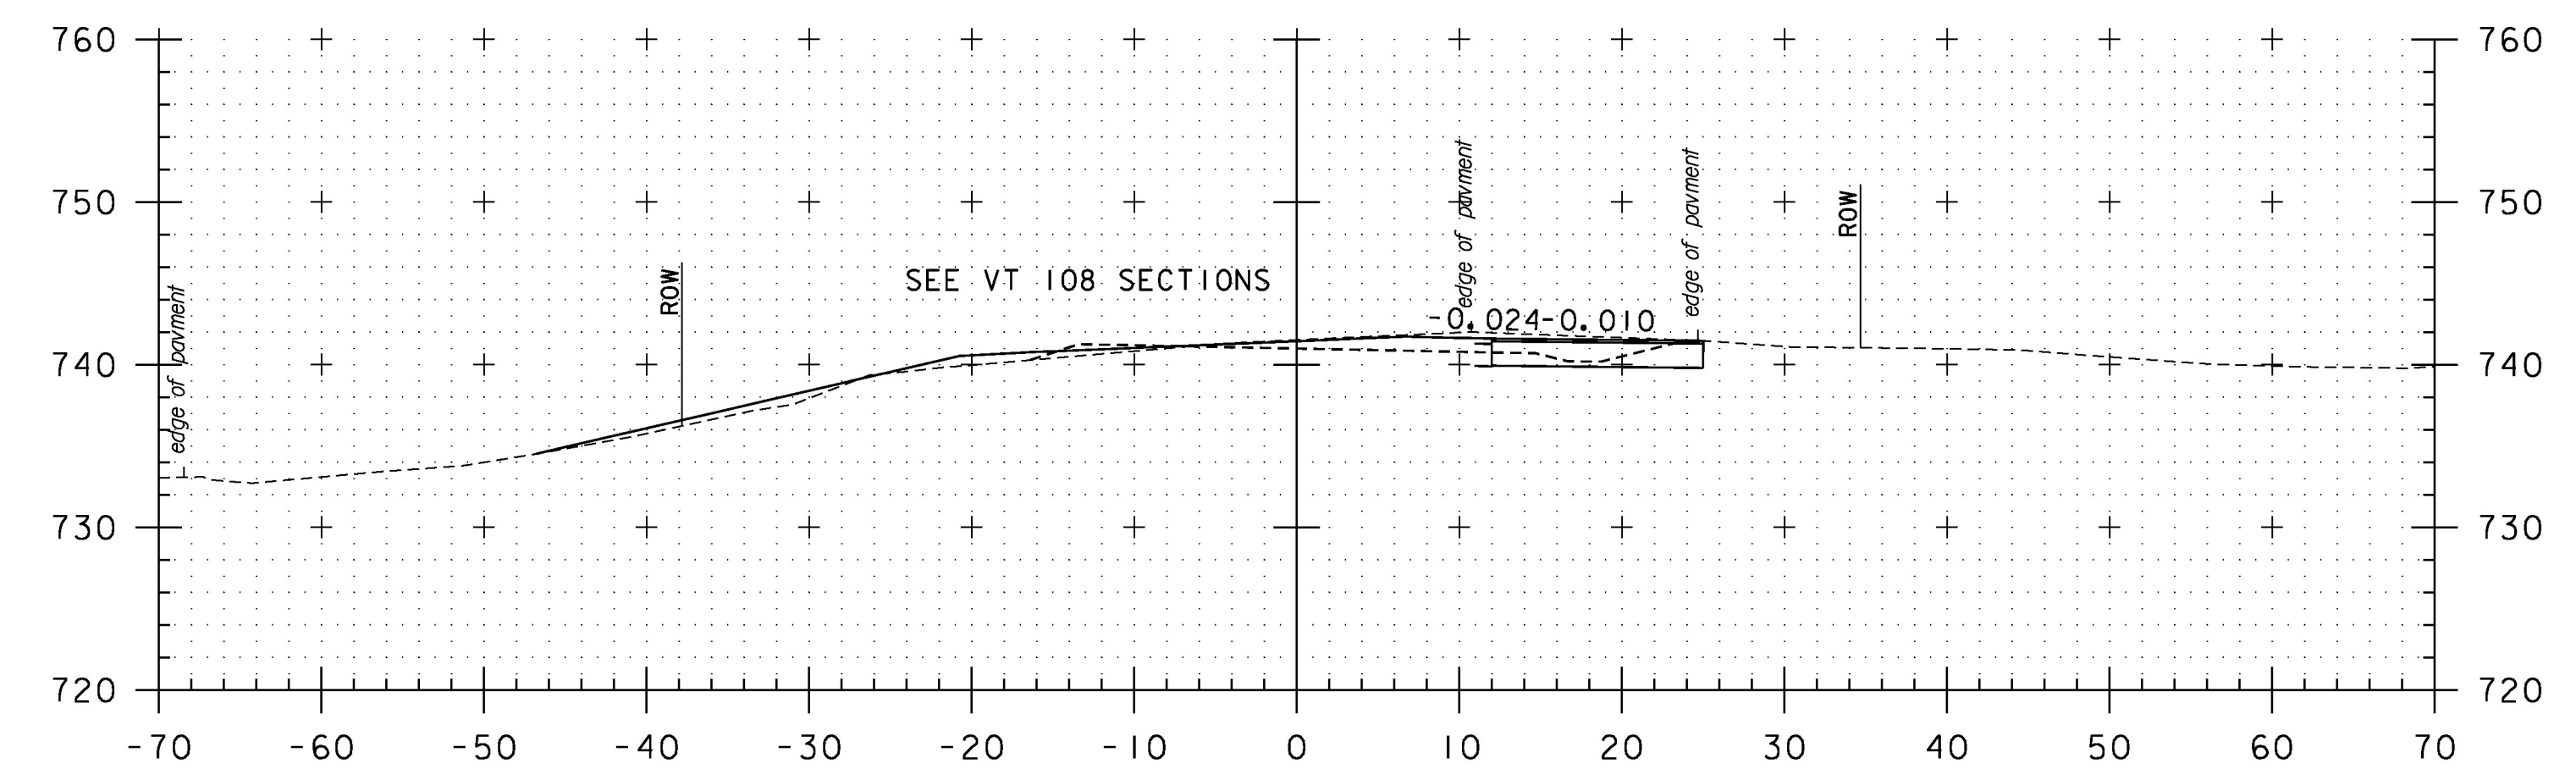

43+50

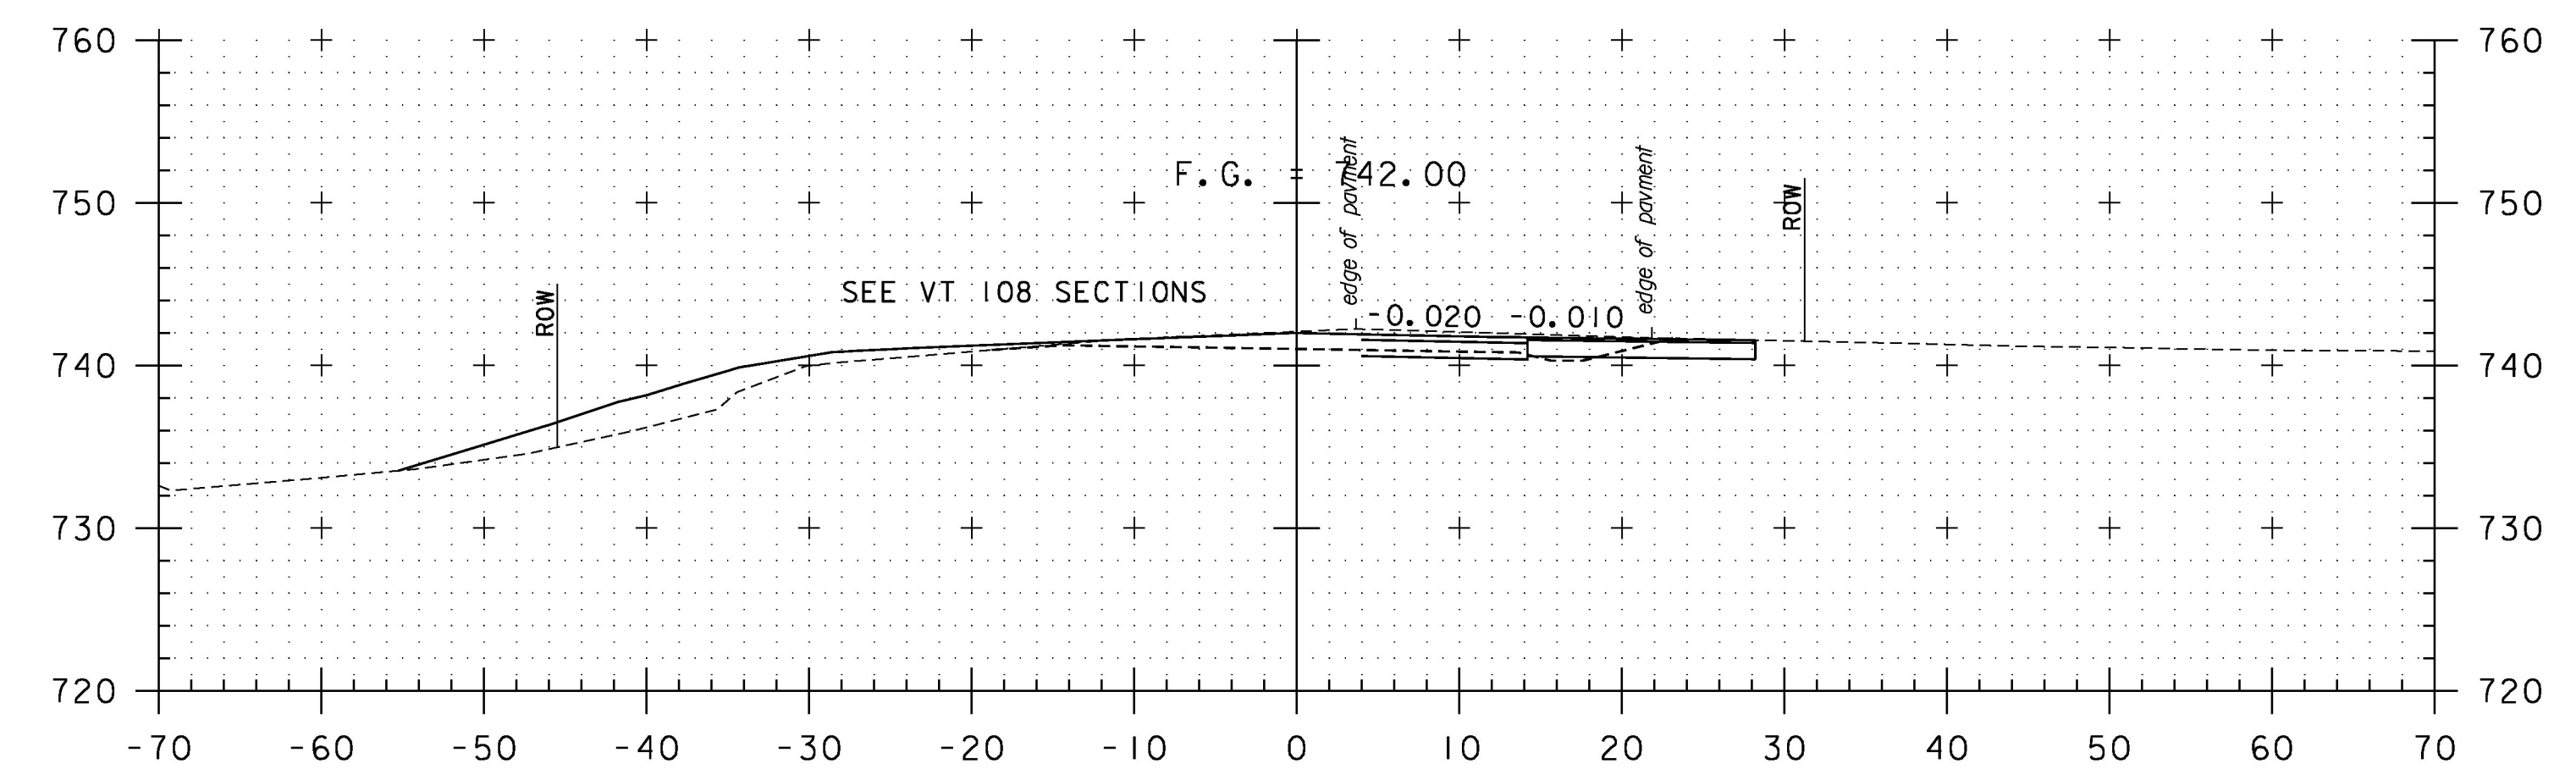

43+30
DRIVE RT

STA. 42+00 TO STA. 43+65

PROJECT NAME:	STOWE	PLOT DATE:	5/8/2015
PROJECT NUMBER:	BHF 0235(15)	DRAWN BY:	K. RUTTER
FILE NAME:	z88c190xsMeadow.dgn	CHECKED BY:	C. GREGORY
PROJECT LEADER:	J. BYATT	MEADOW LANE CROSS SECTIONS	SHEET 59 OF 79
DESIGNED BY:	K. RUTTER		

