




CLD 12-0120 MODEL+TEMP BRIDGE XS 1

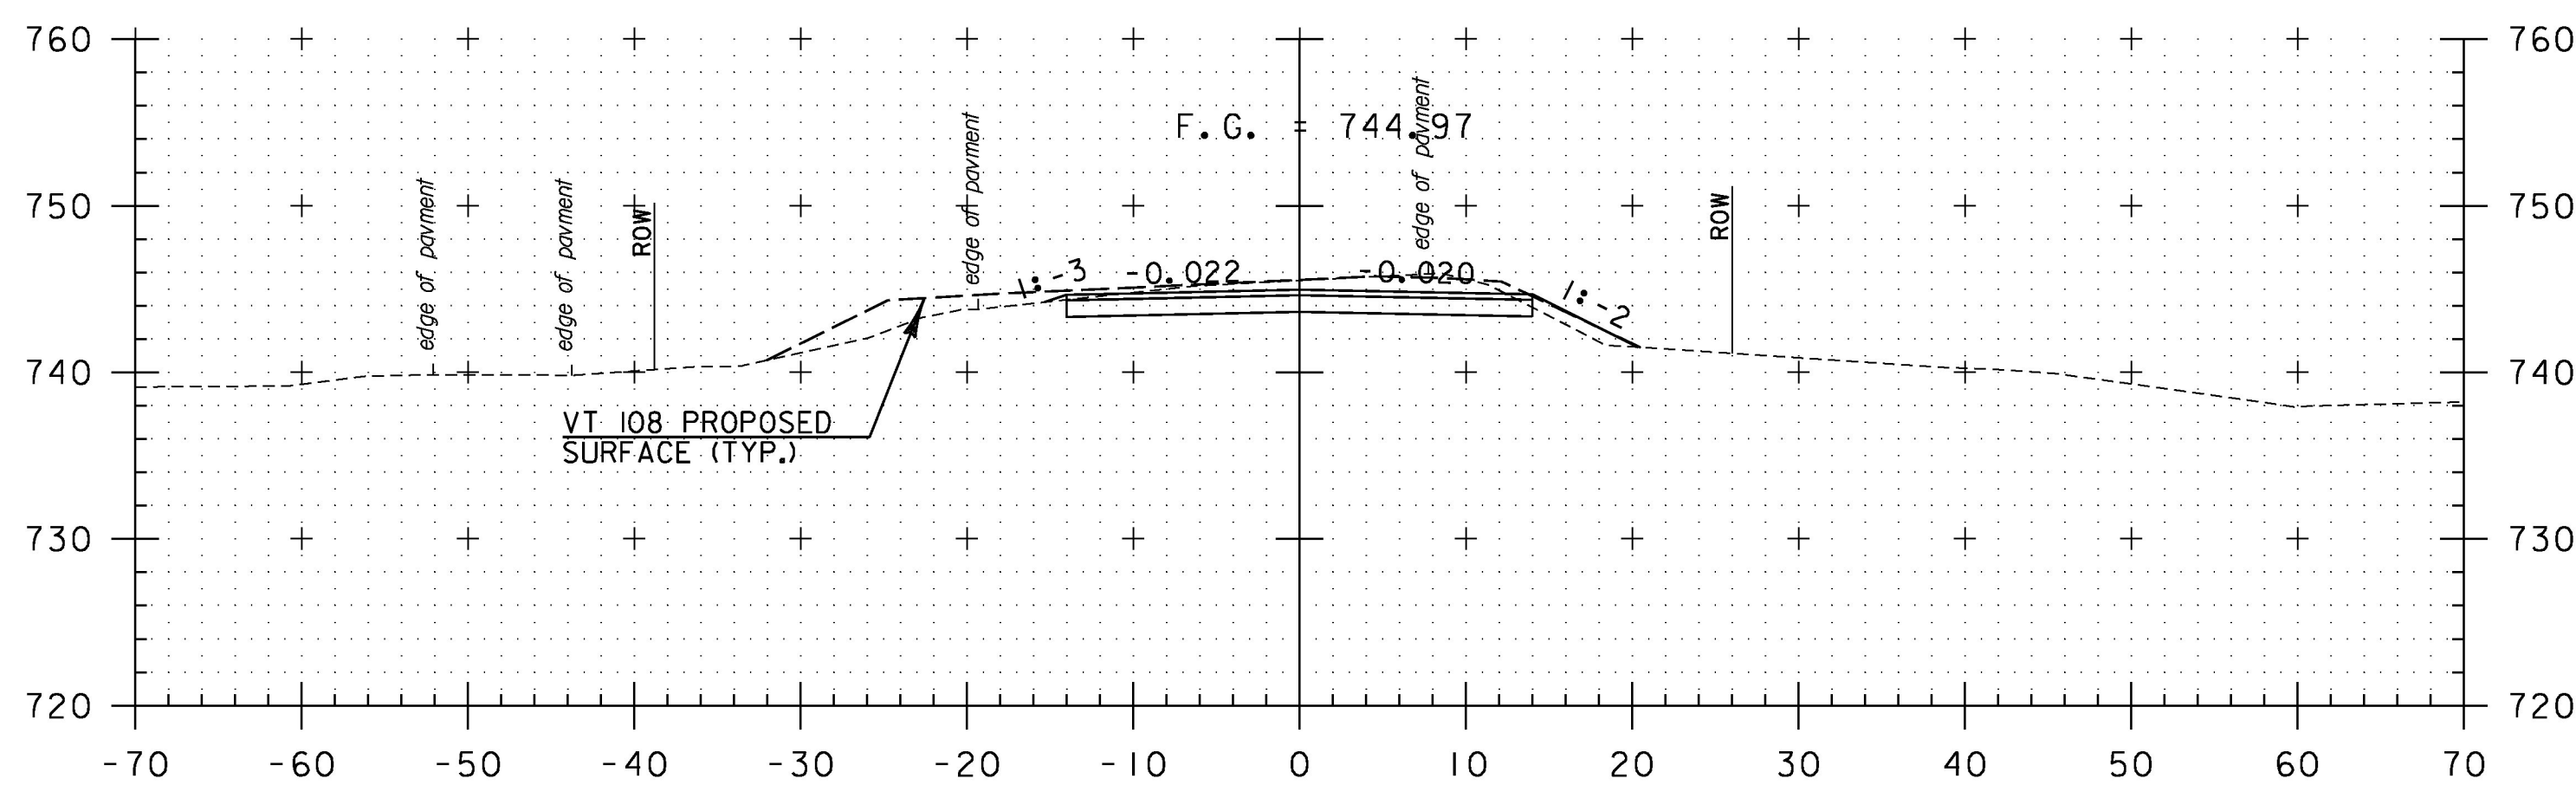


101+00

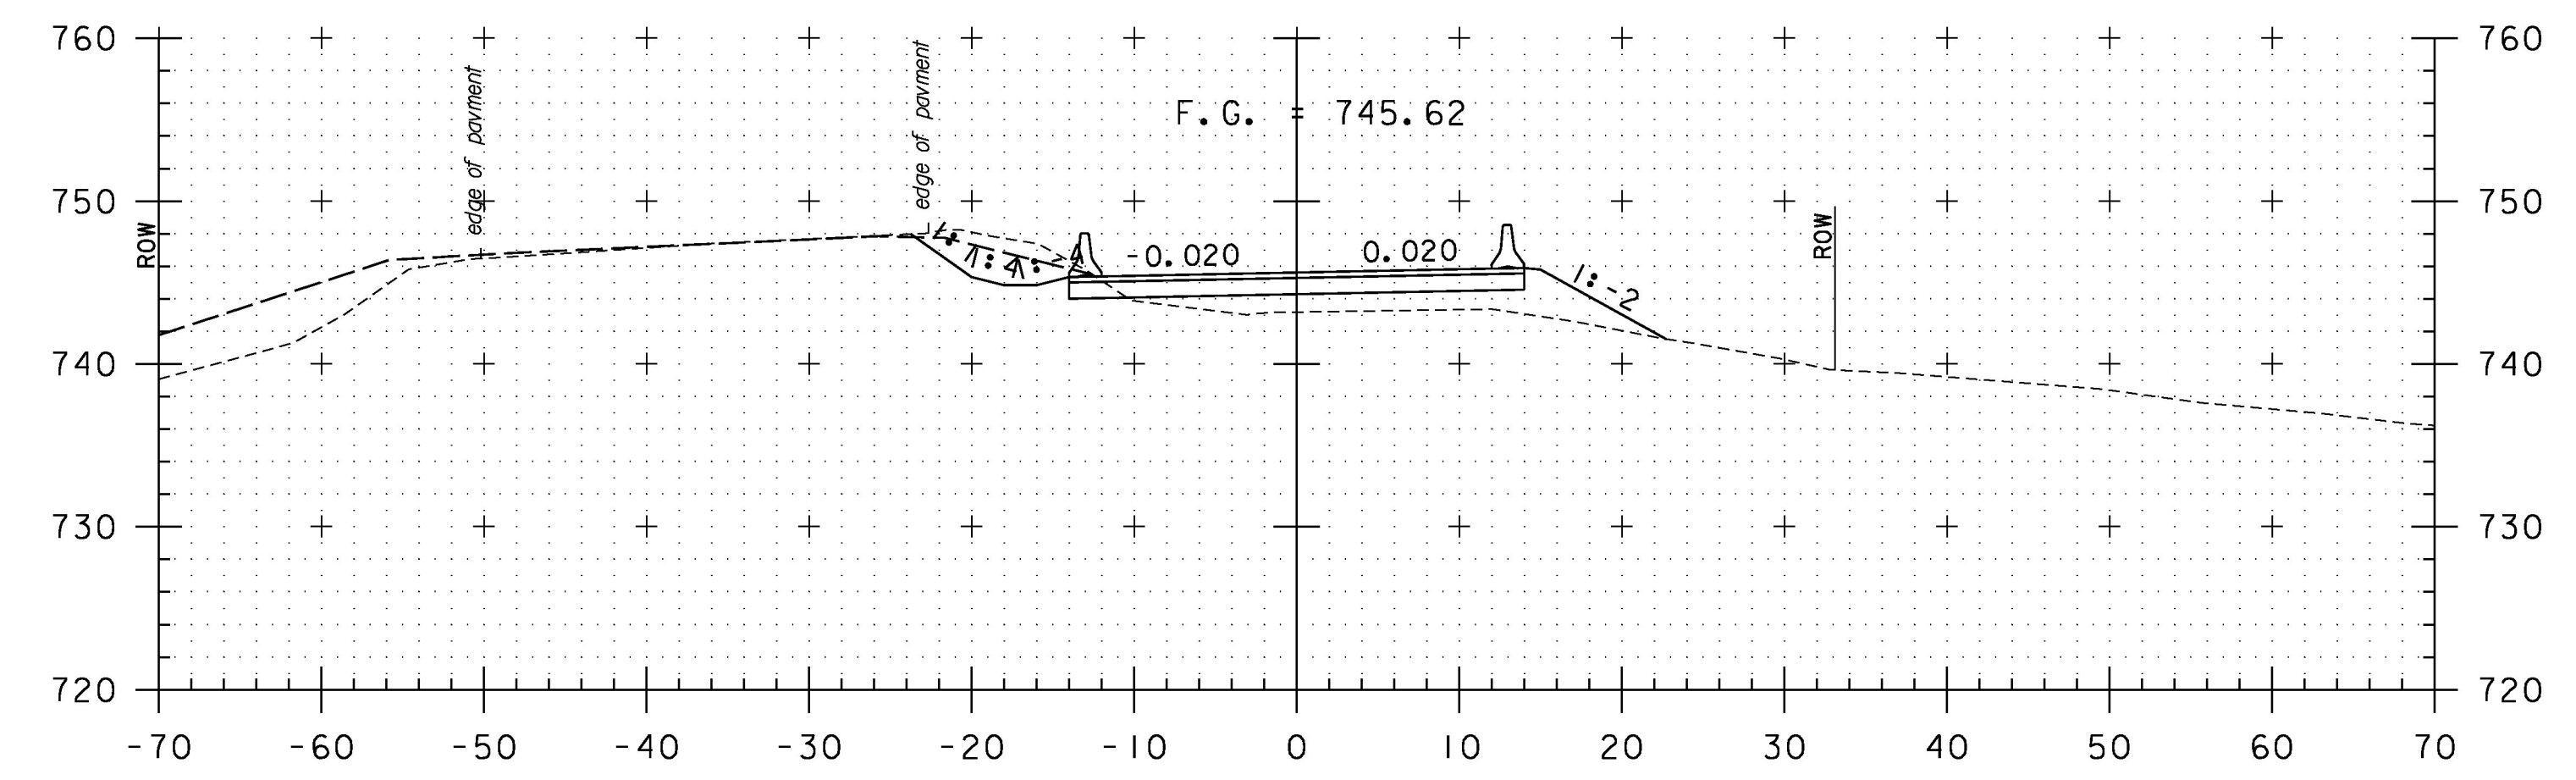


102+50

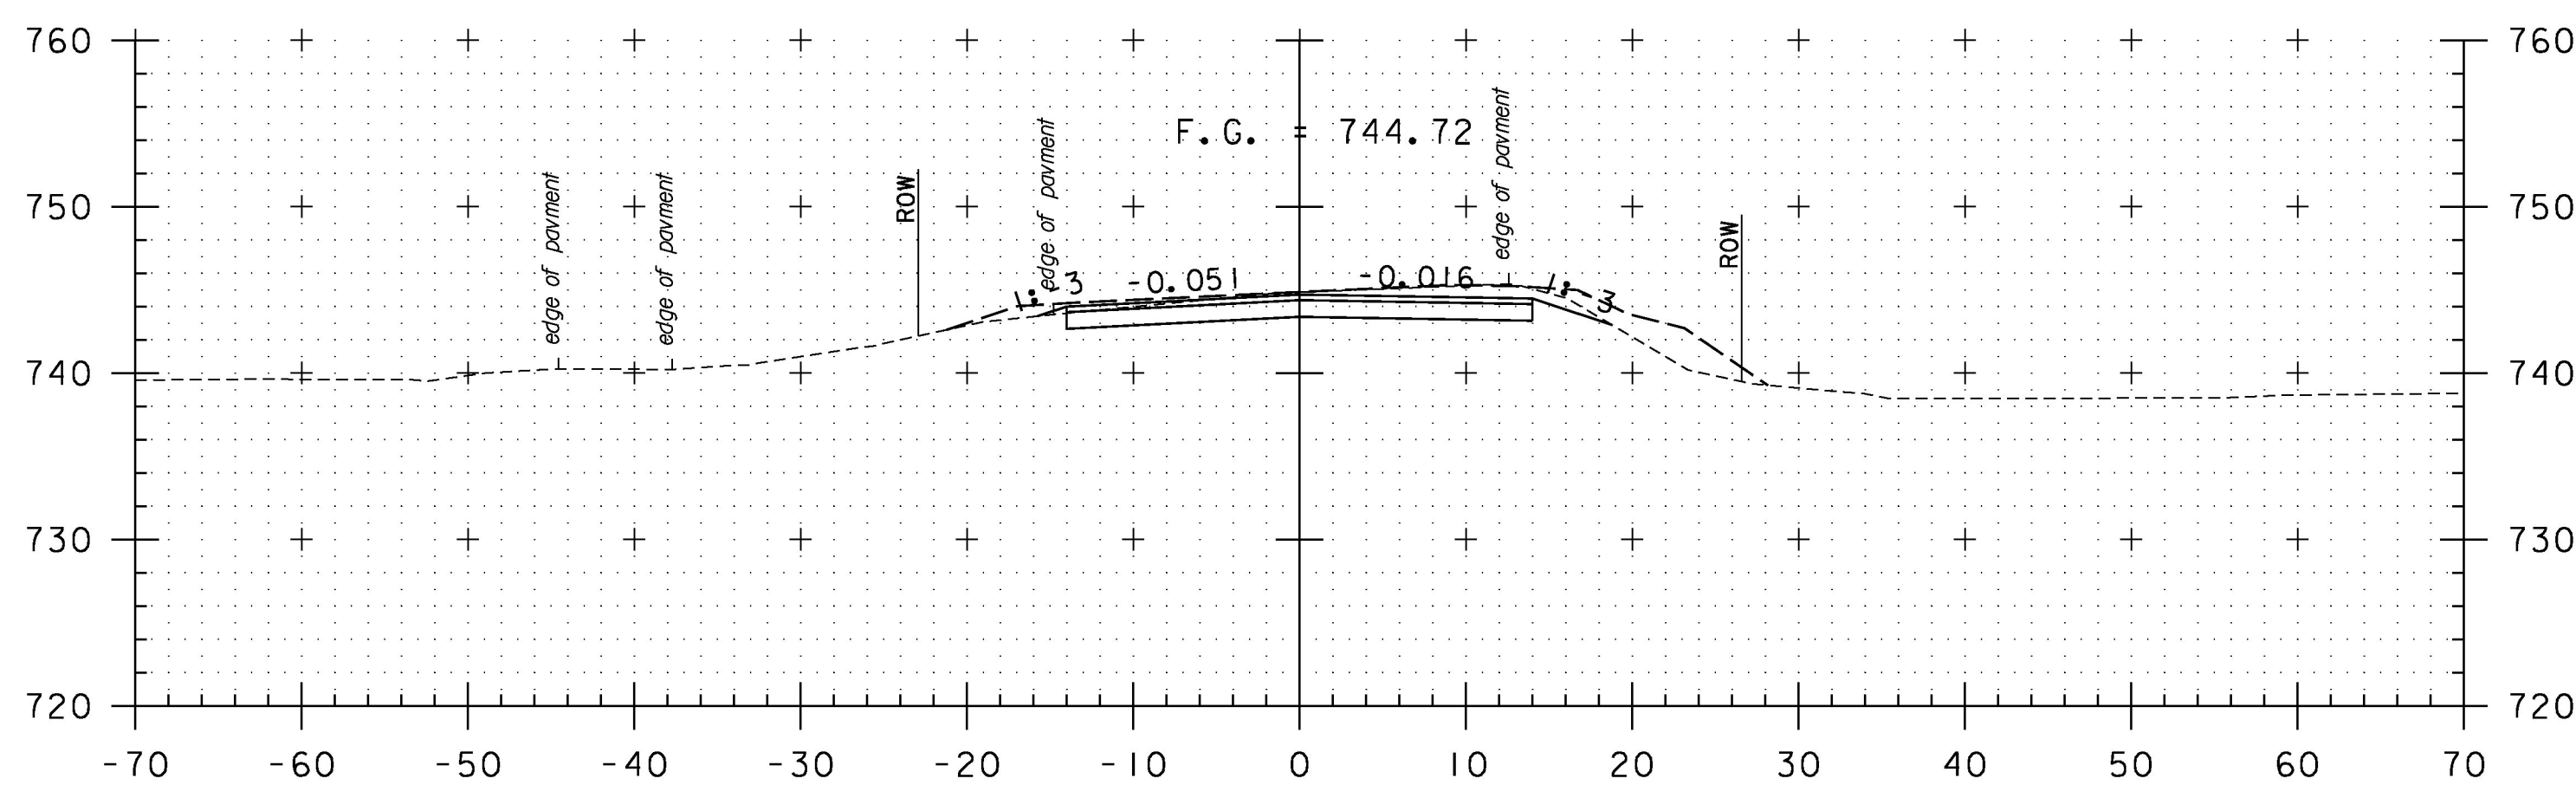


100+50

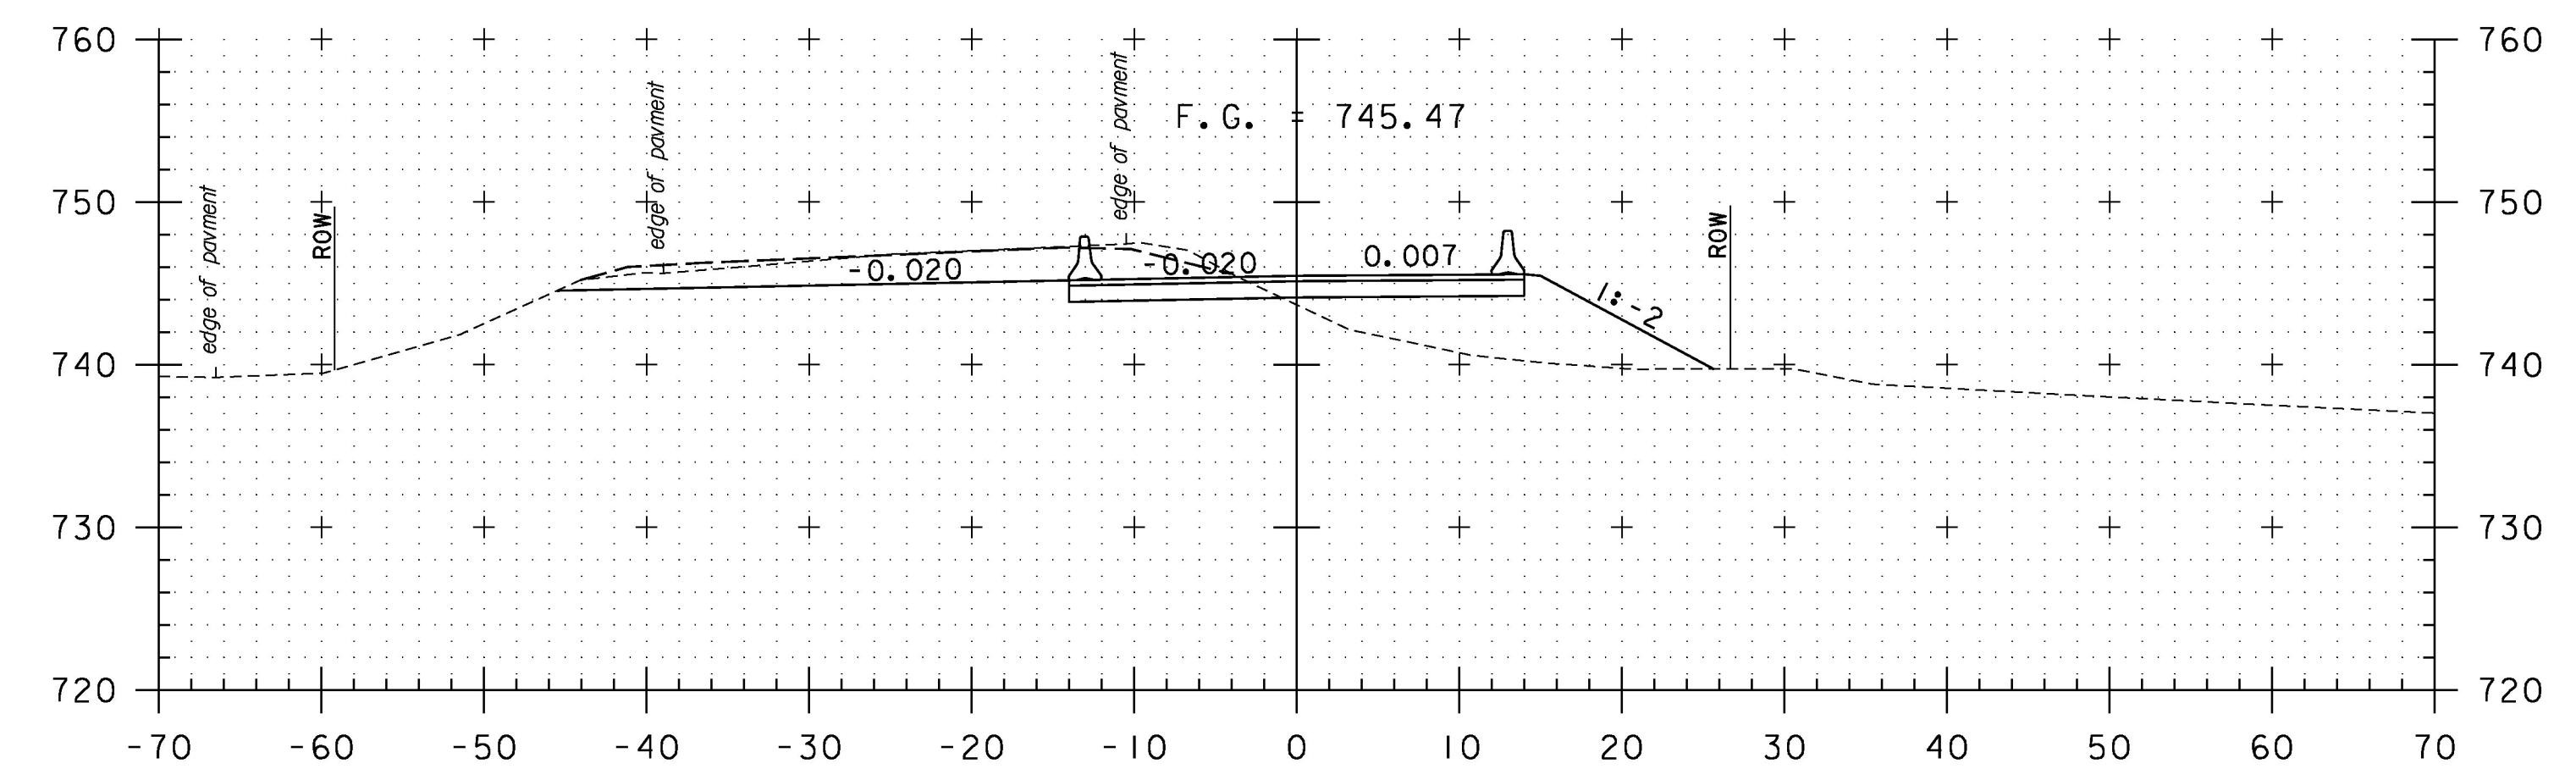

102+00

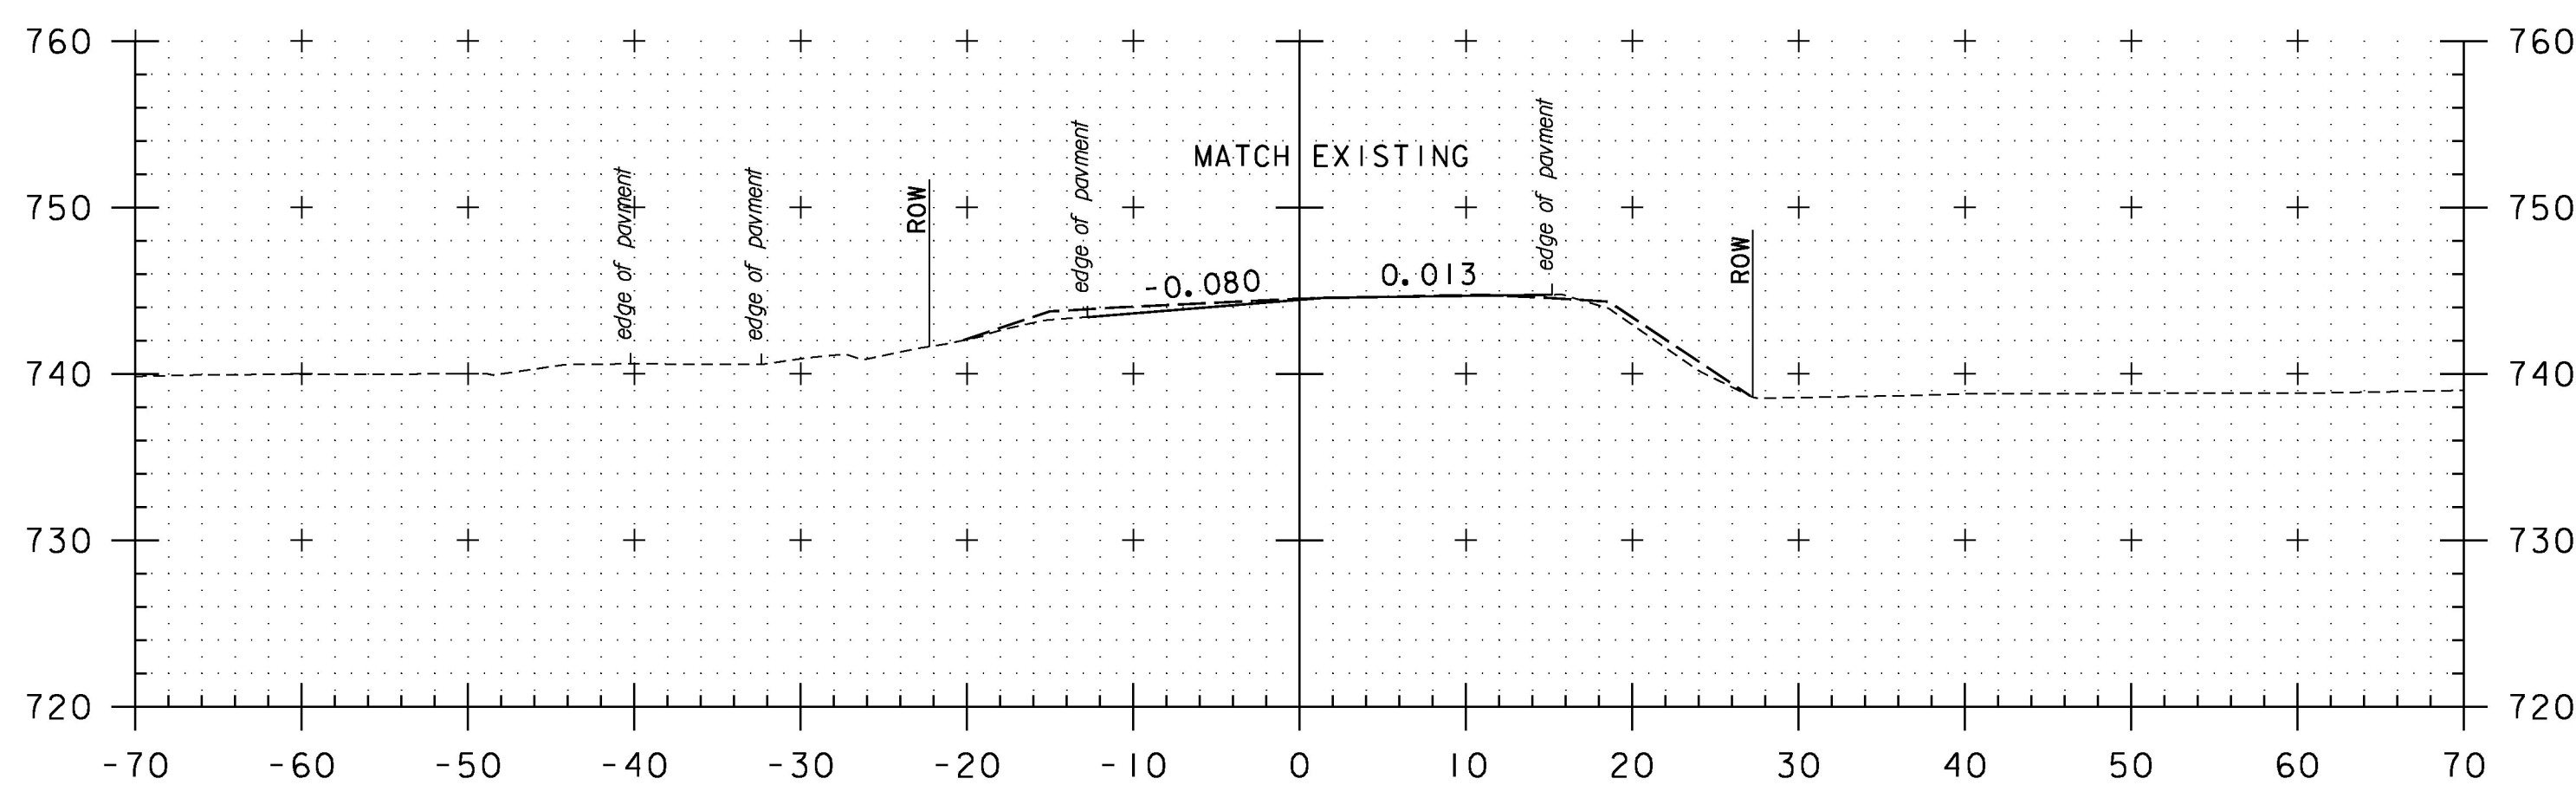

100+00

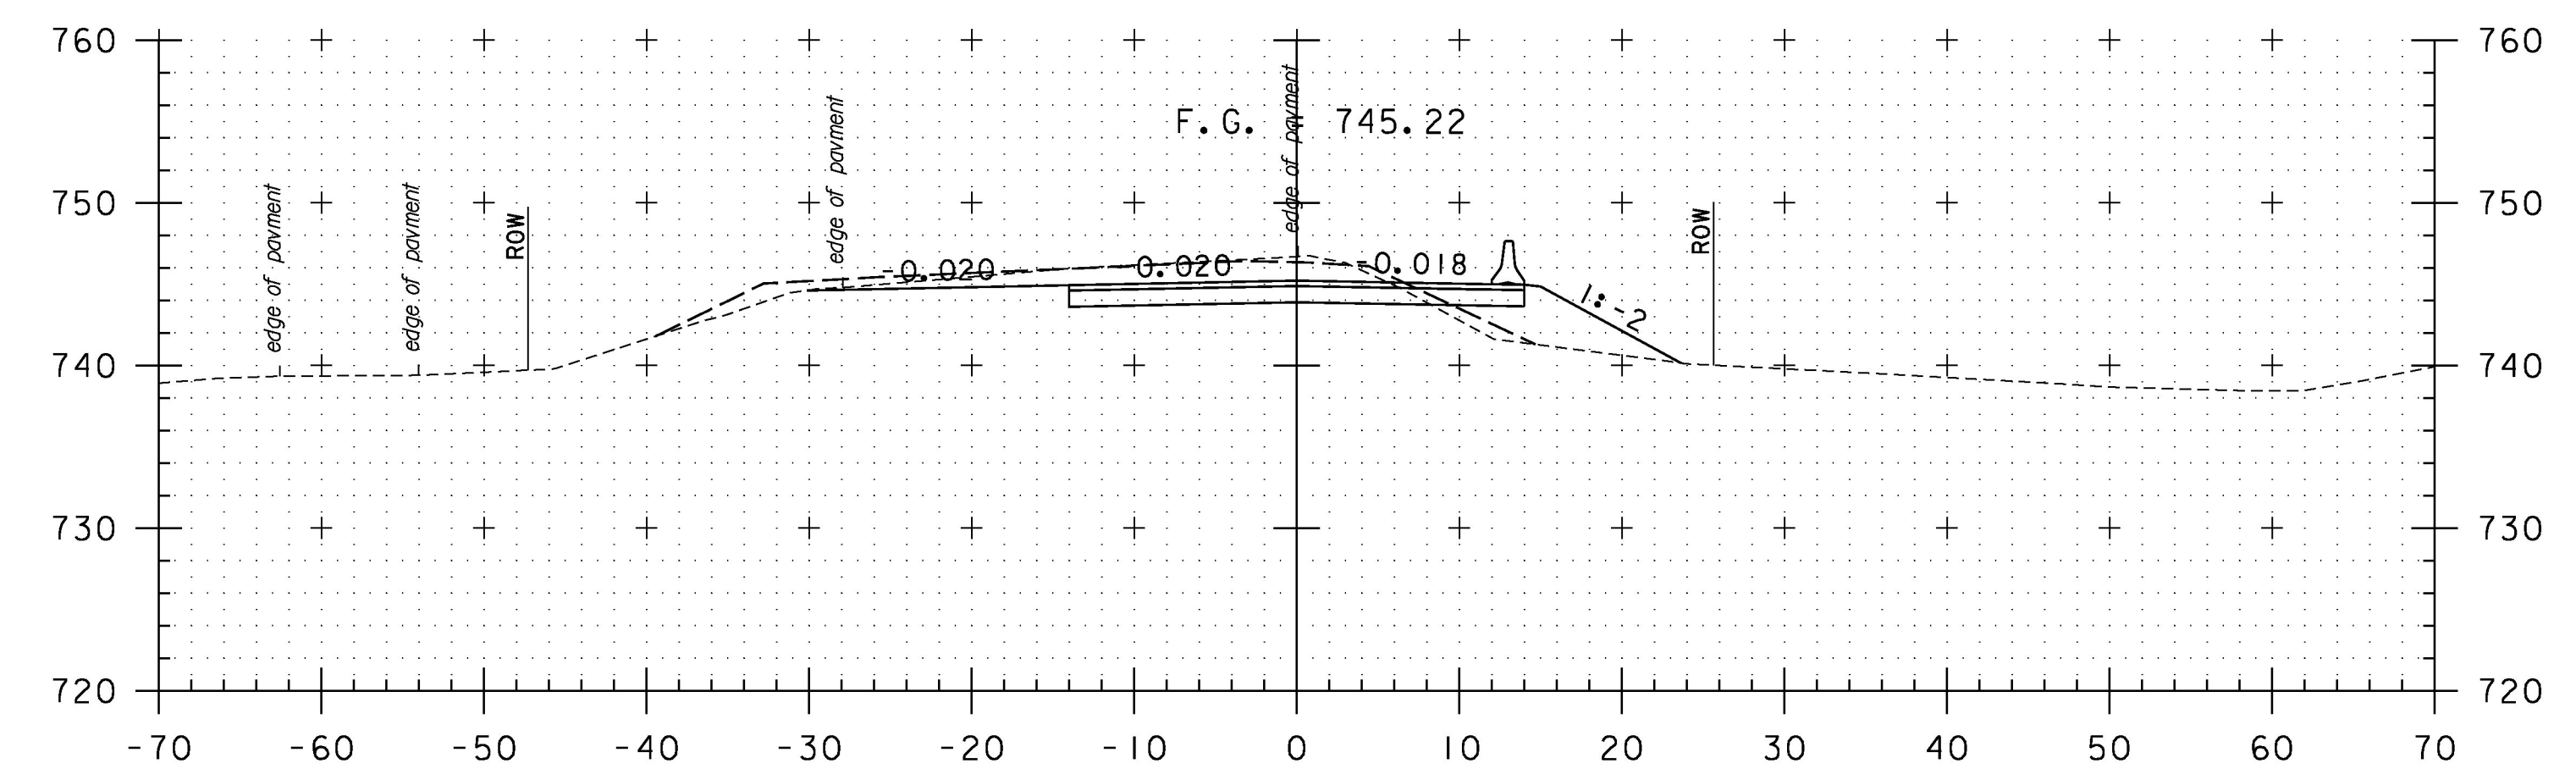

101+50

STA. 100+00 TO STA. 102+50

PROJECT NAME:	STOWE	PLOT DATE:	5/8/2015
PROJECT NUMBER:	BRF 0235(15)	DRAWN BY:	K. RUTTER
FILE NAME:	z88ci90xsDetour.dgn	CHECKED BY:	C. GREGORY
DESIGNED BY:	K. RUTTER	SHEET	60 OF 79
TEMP DETOUR CROSS SECTIONS			

