




CLD 12-0120 MODEL: TEMP BRIDGE XS 2

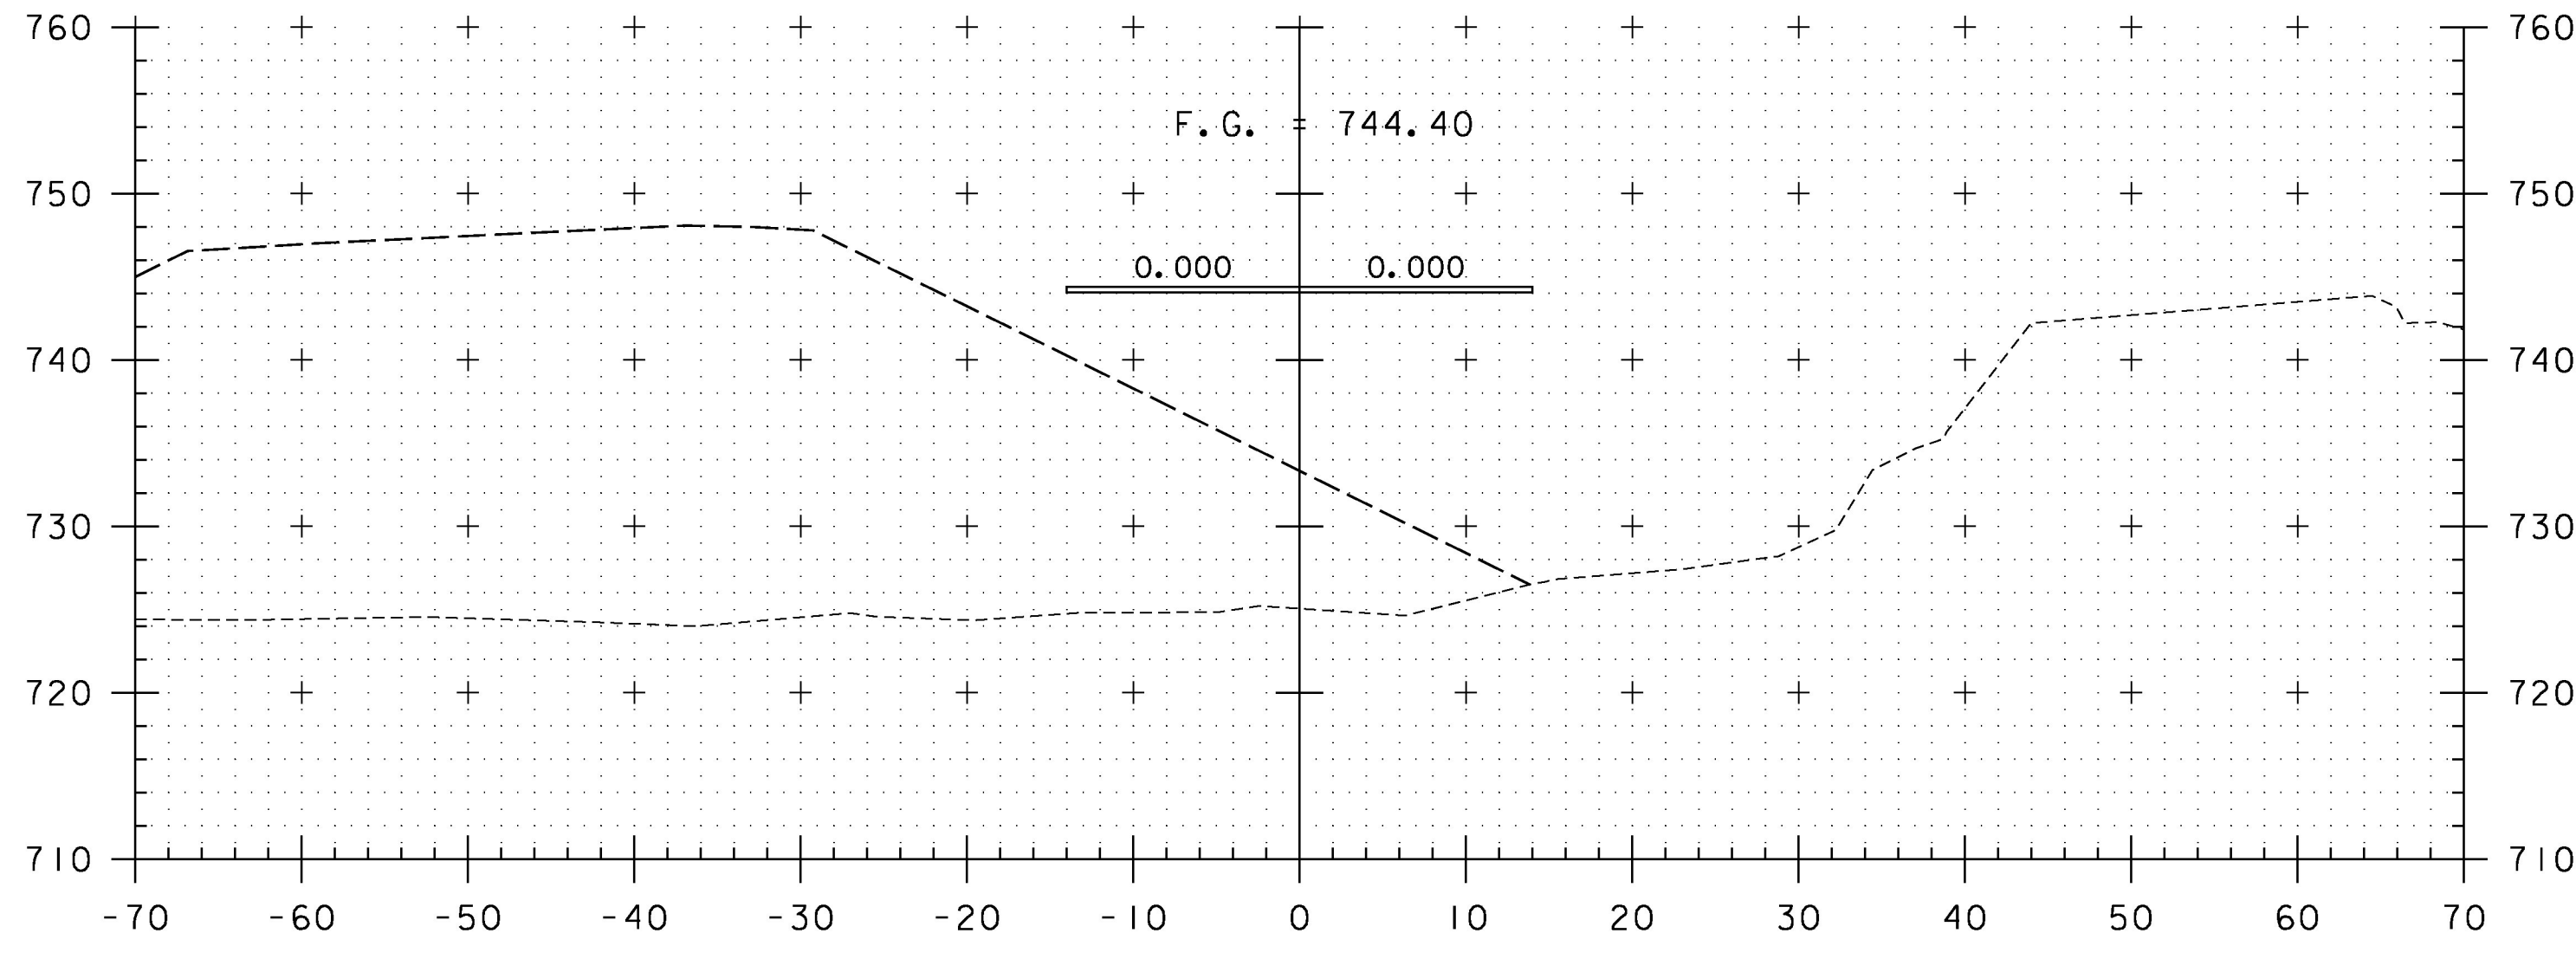


103+50

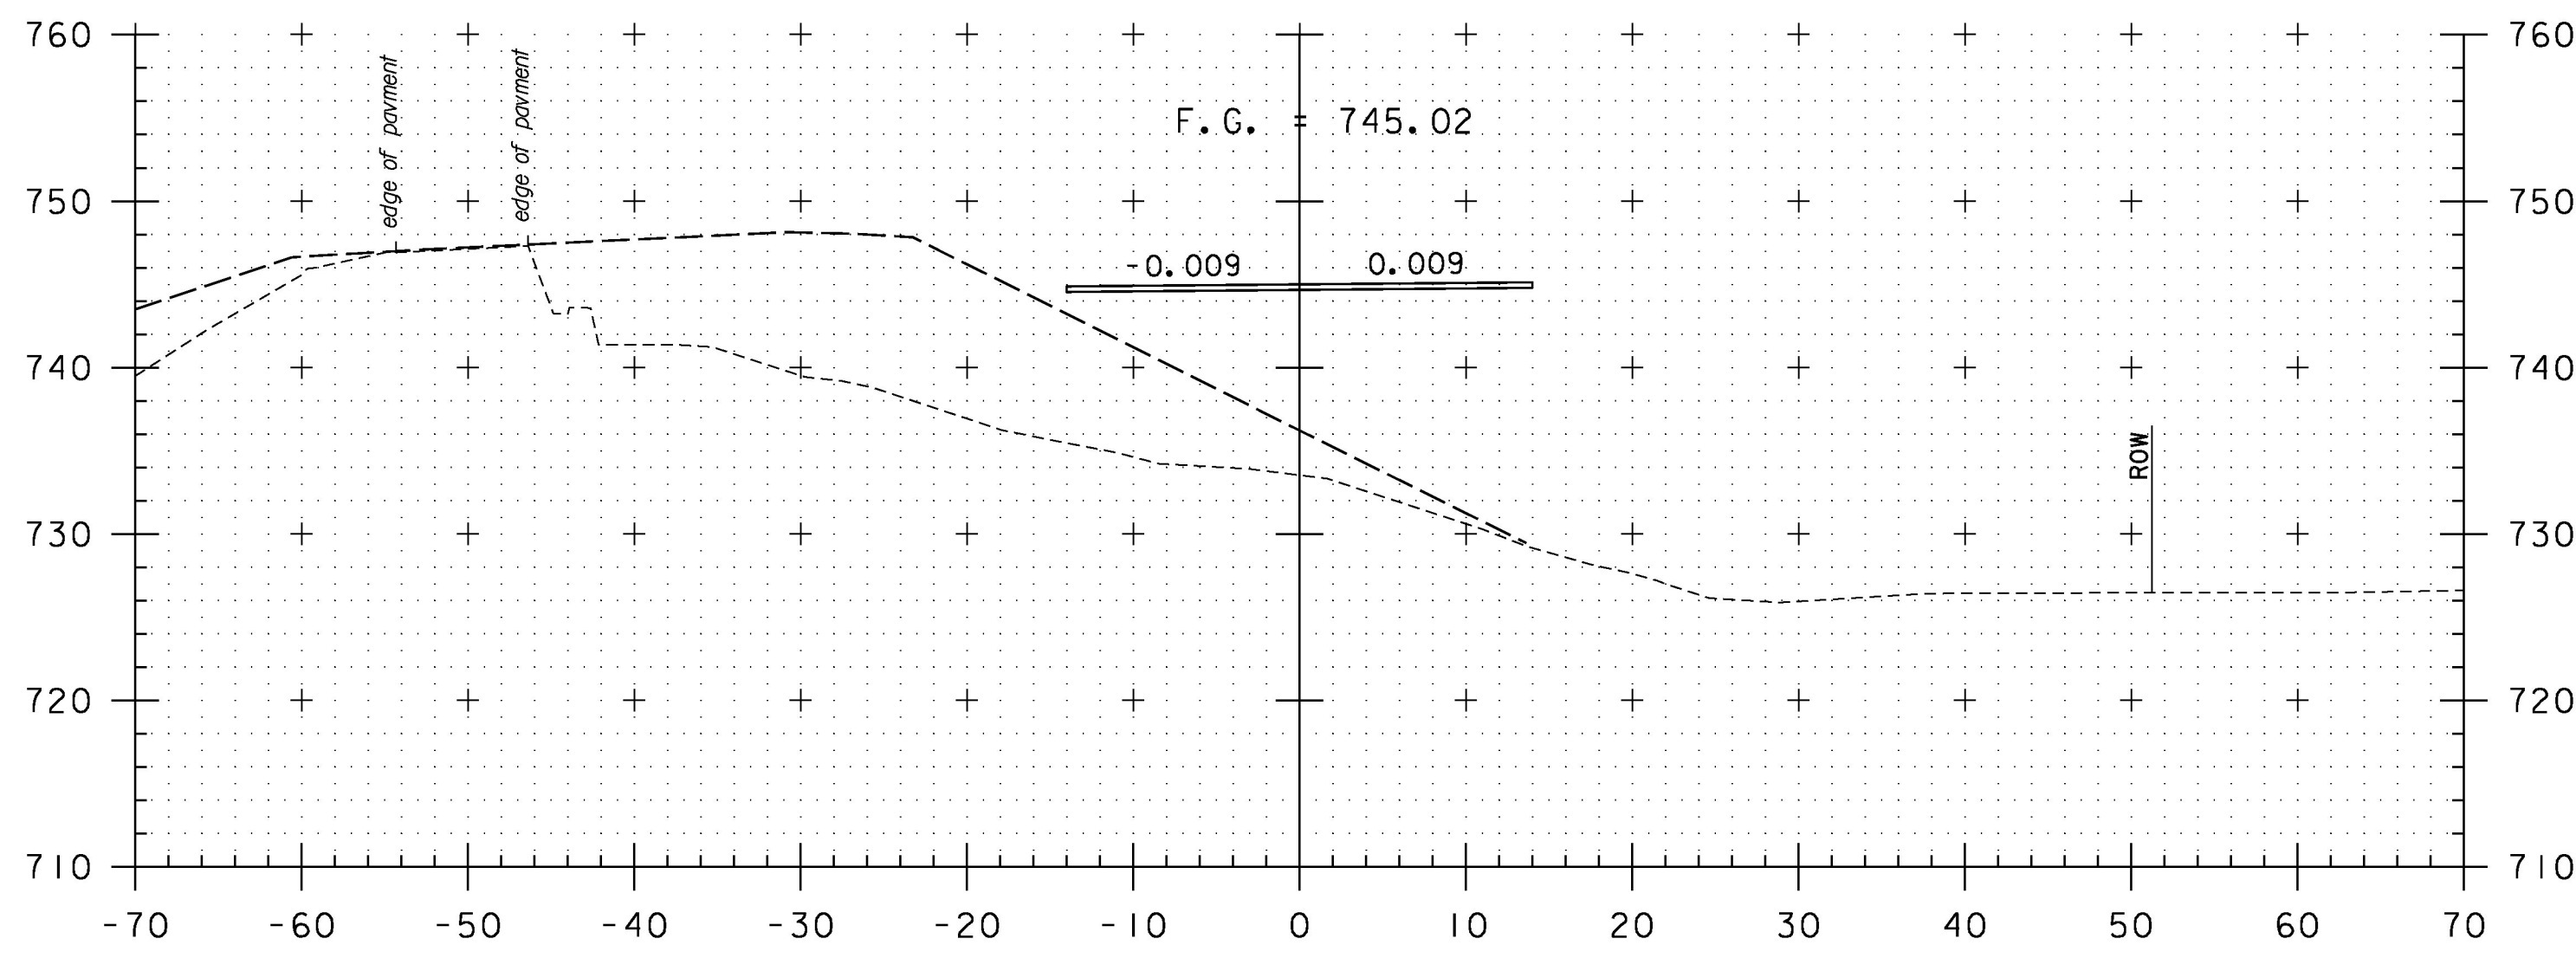


103+00

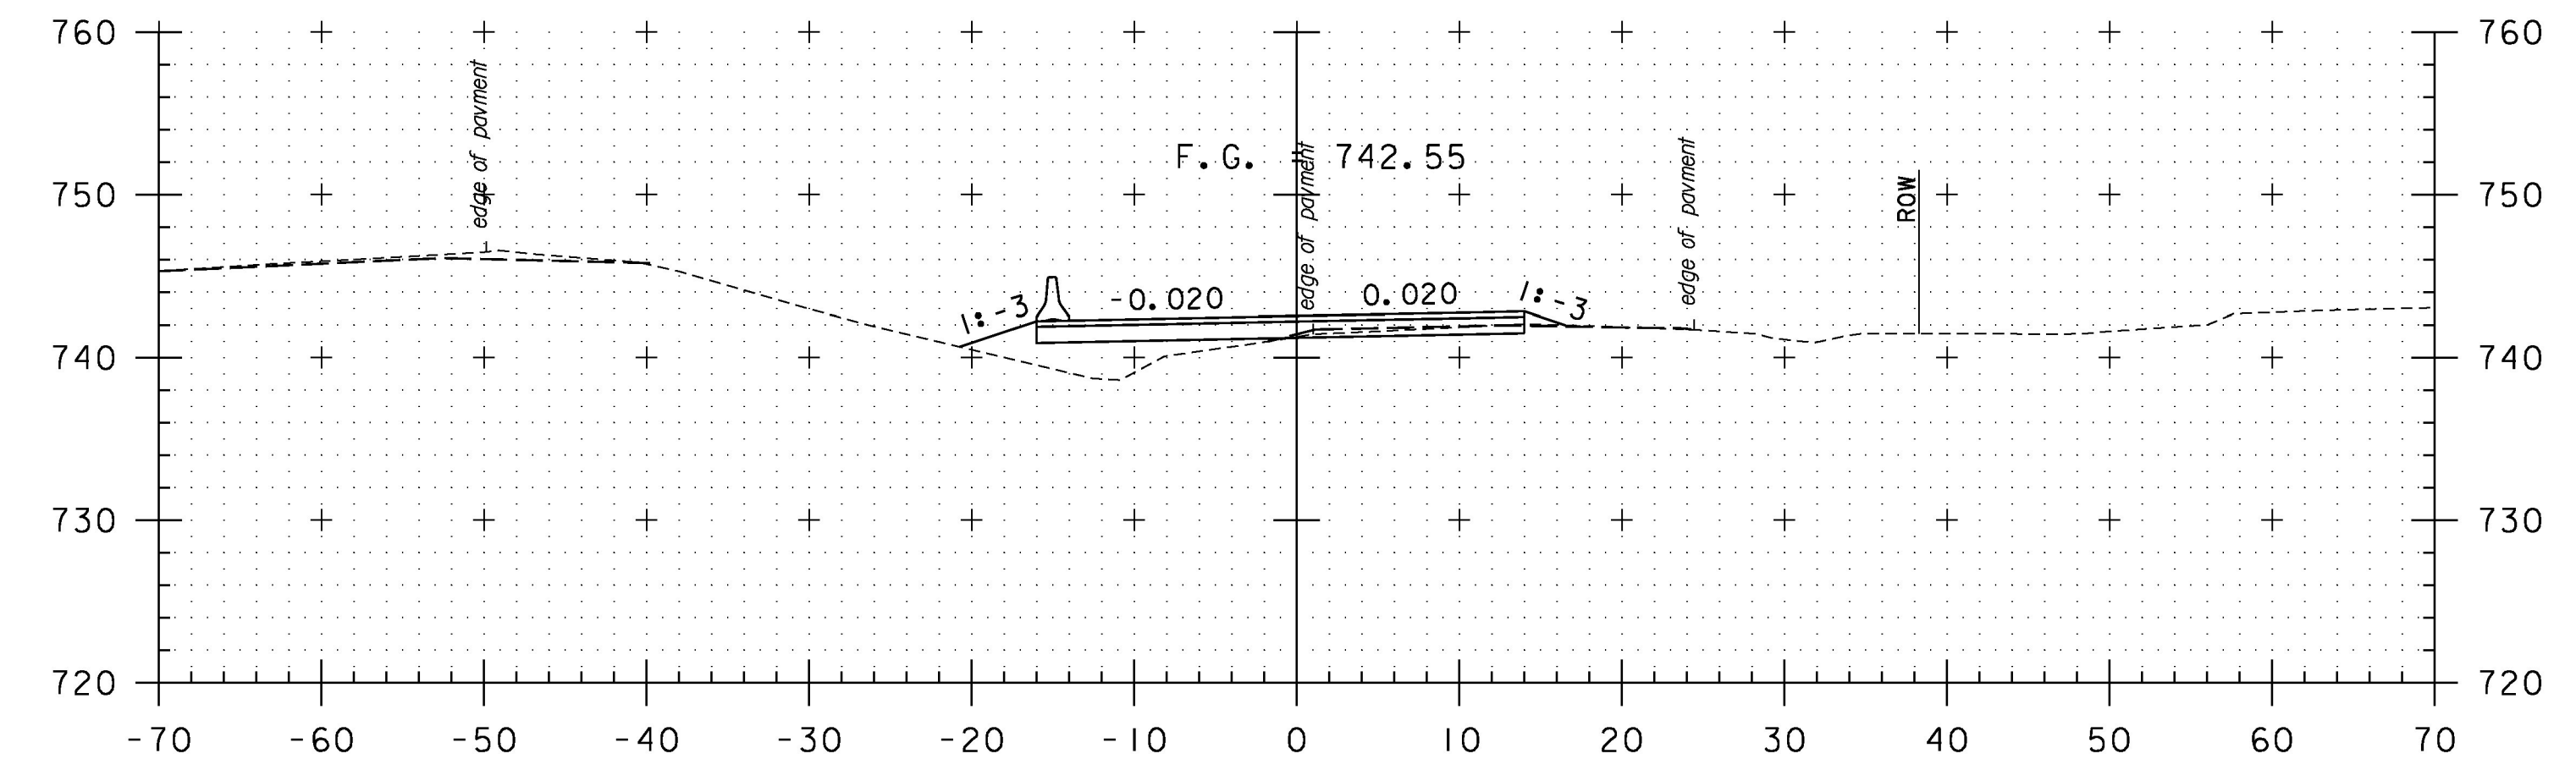

105+00

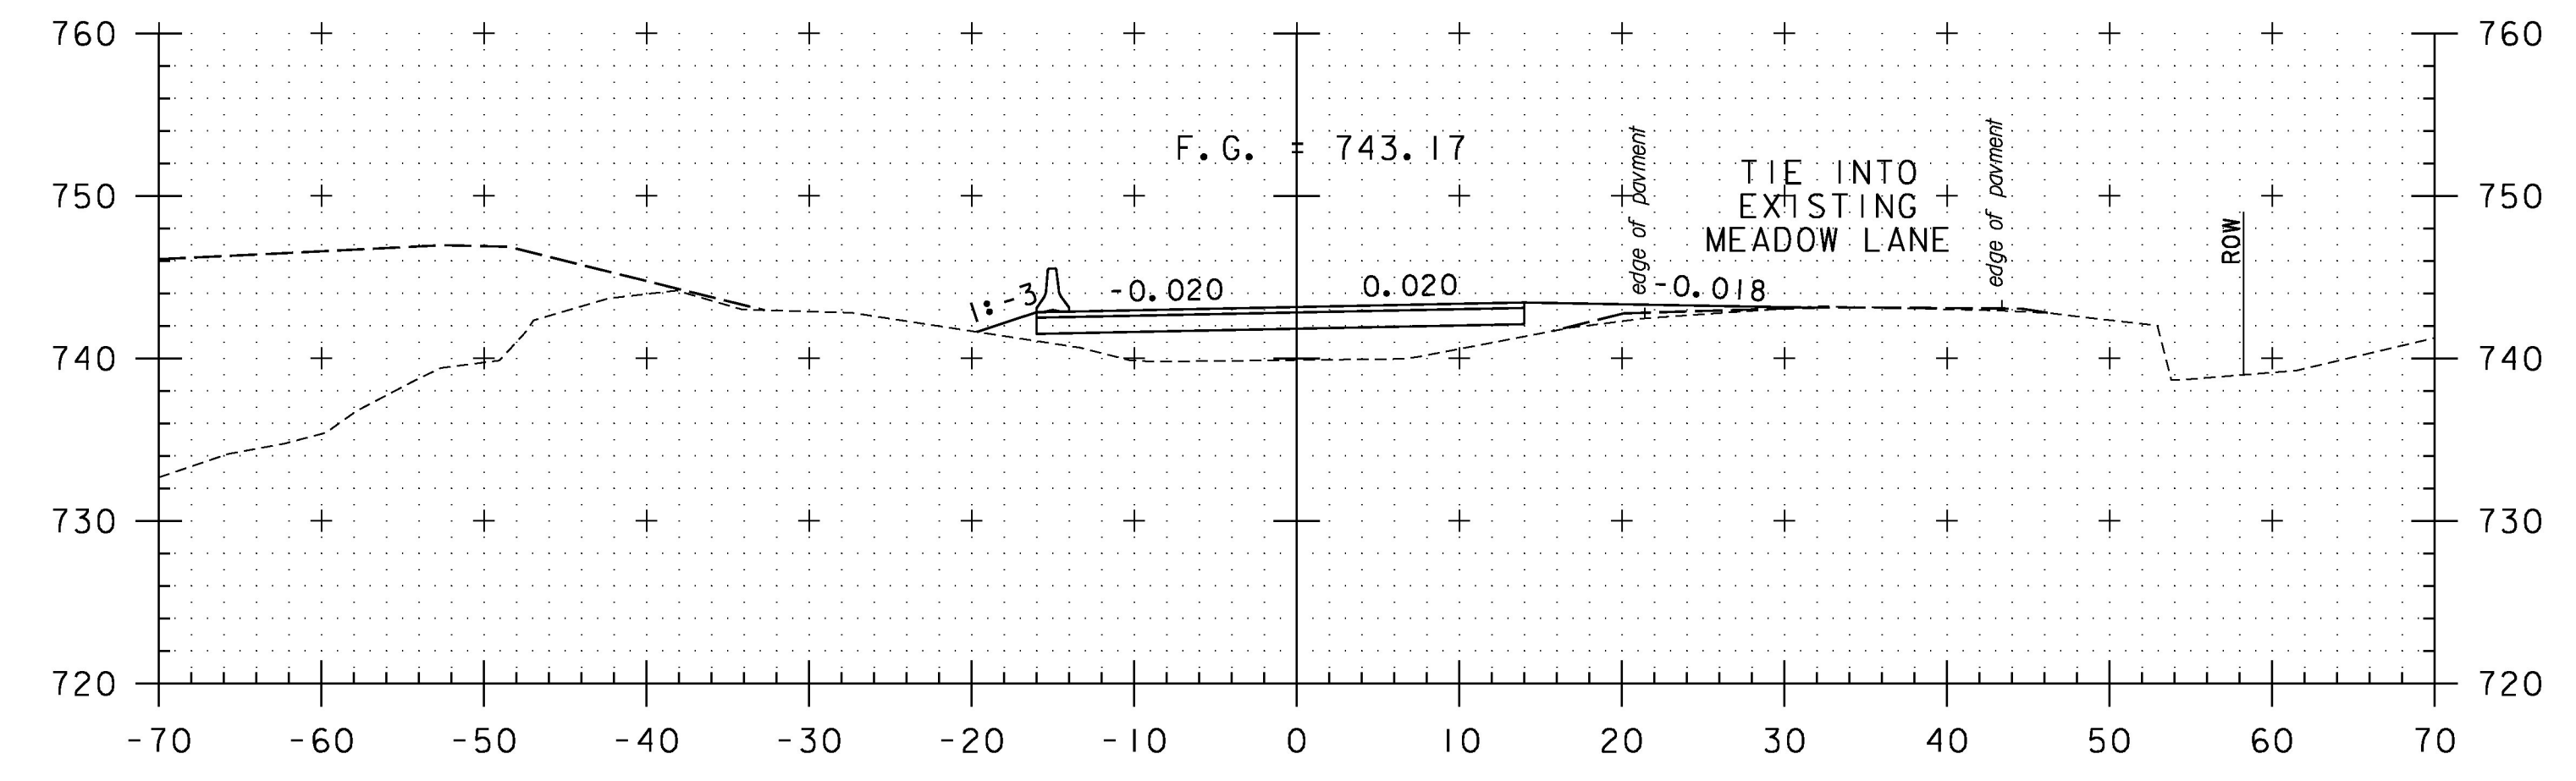

104+50

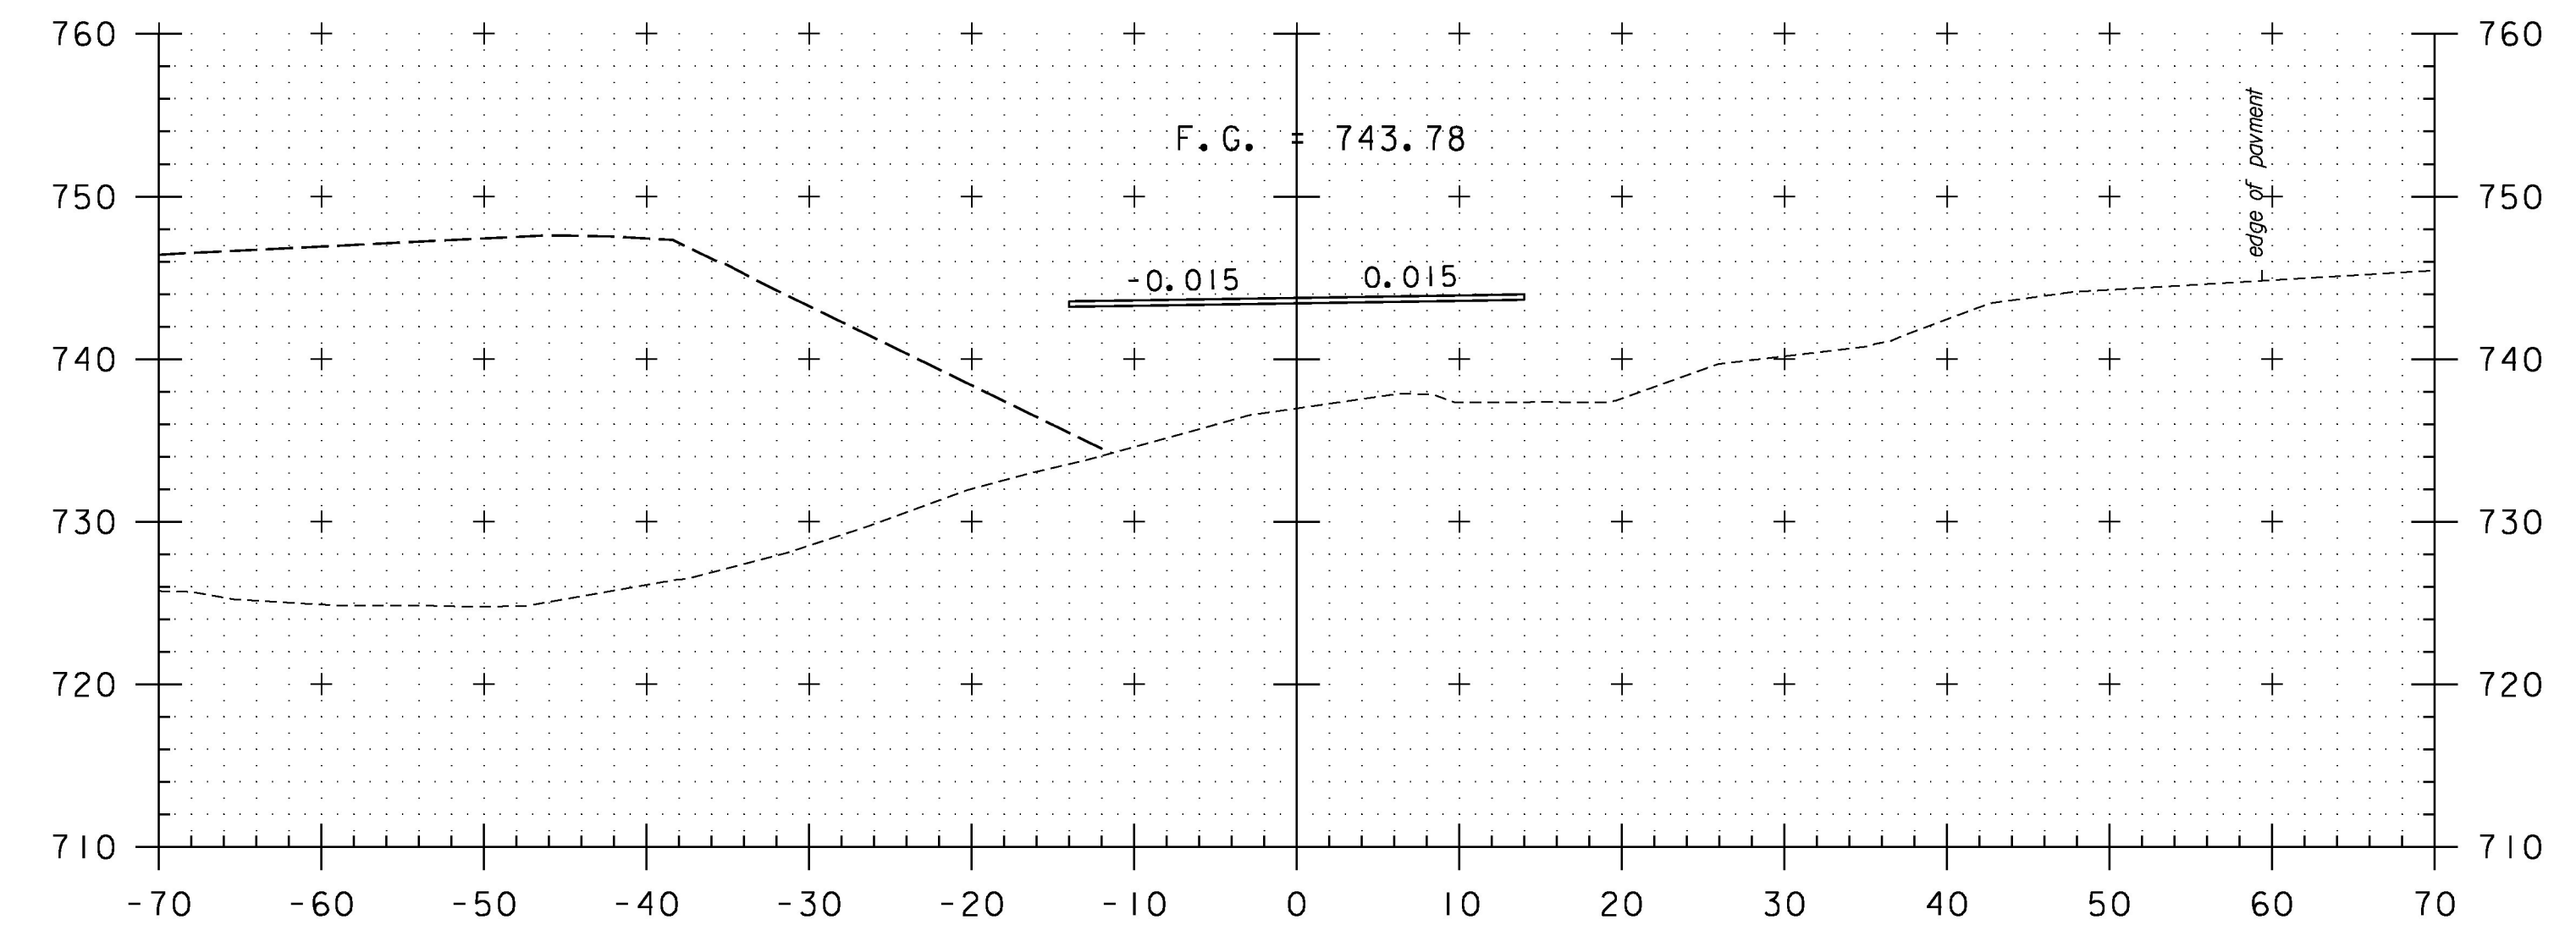

104+00

STA. 103+00 TO STA. 105+00

PROJECT NAME:	STOWE	PLOT DATE:	5/8/2015
PROJECT NUMBER:	BRF 0235(15)	DRAWN BY:	K. RUTTER
FILE NAME:	z88ci90xsDetour.dgn	CHECKED BY:	C. GREGORY
PROJECT LEADER:	J. BYATT		
DESIGNED BY:	K. RUTTER		
TEMP DETOUR CROSS SECTIONS			

