




CLD 12-0120 MODEL+TEMP BRIDGE XS 3

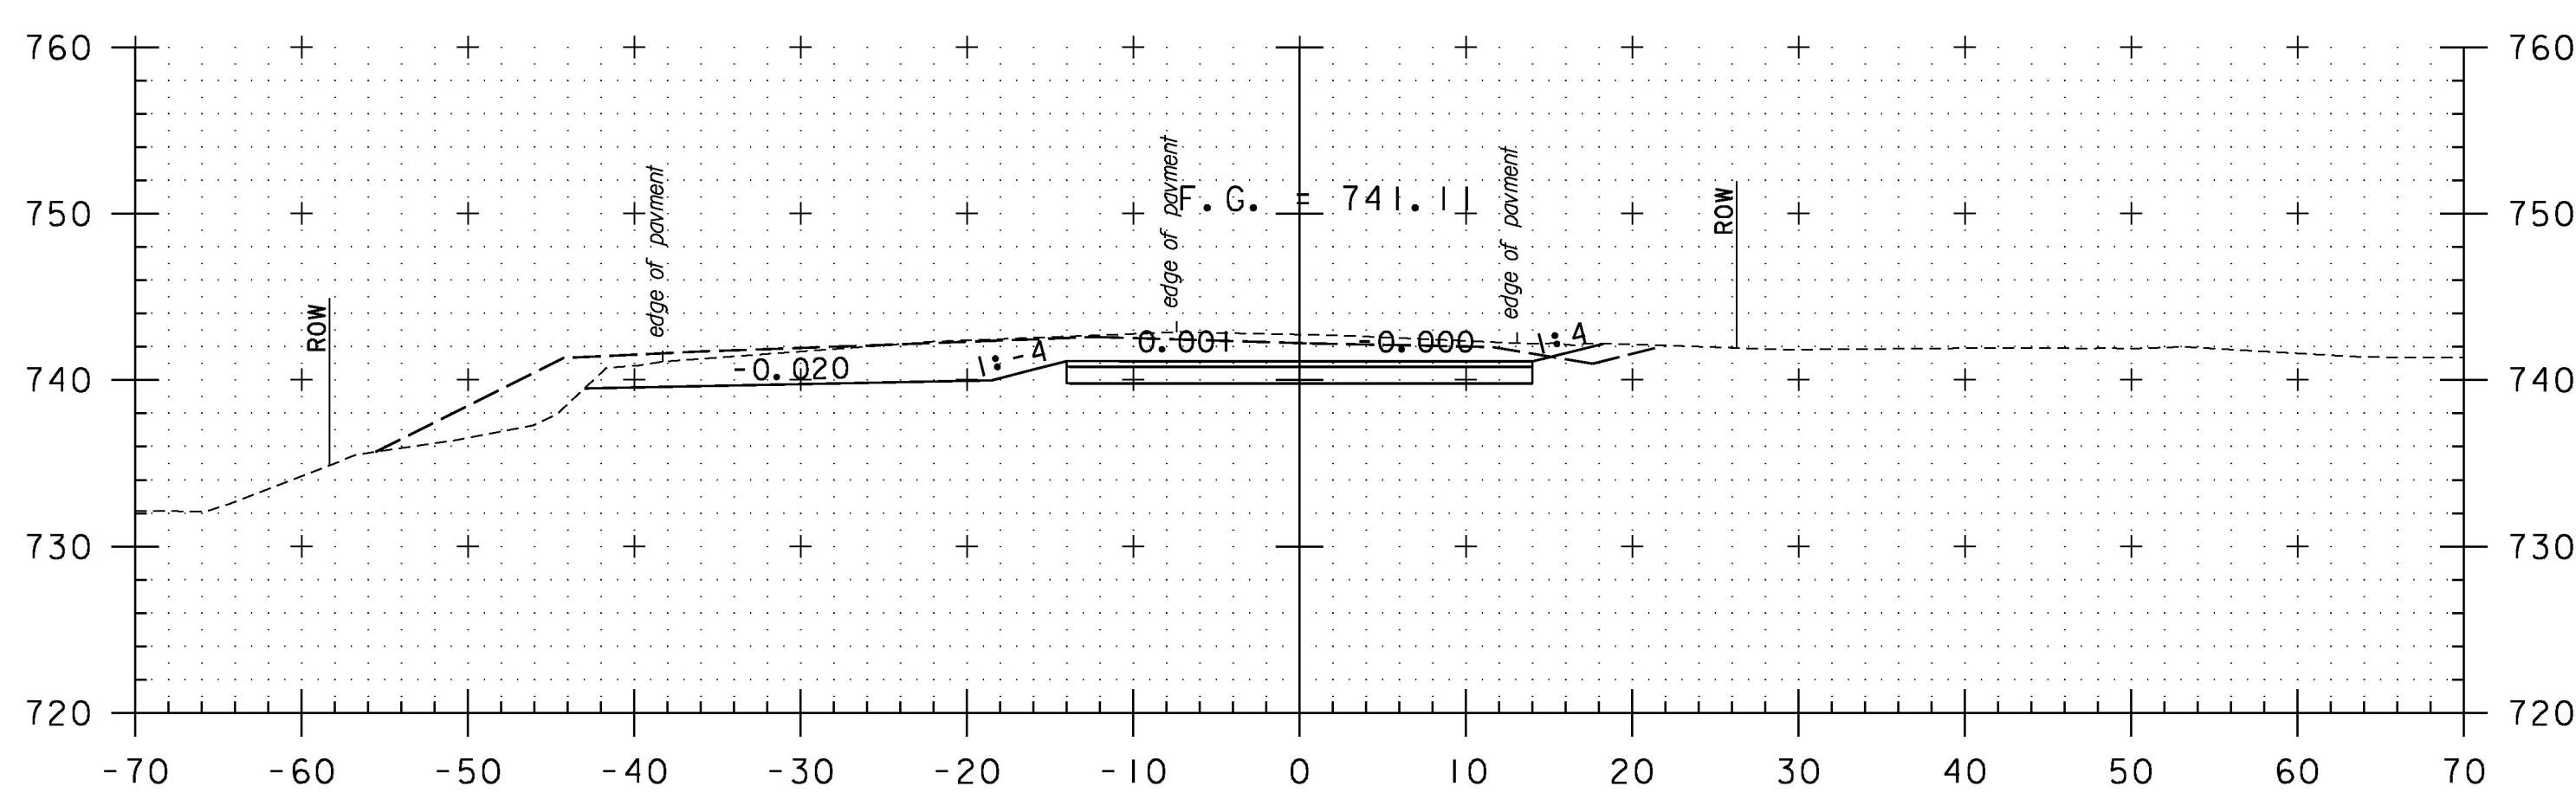


106+50

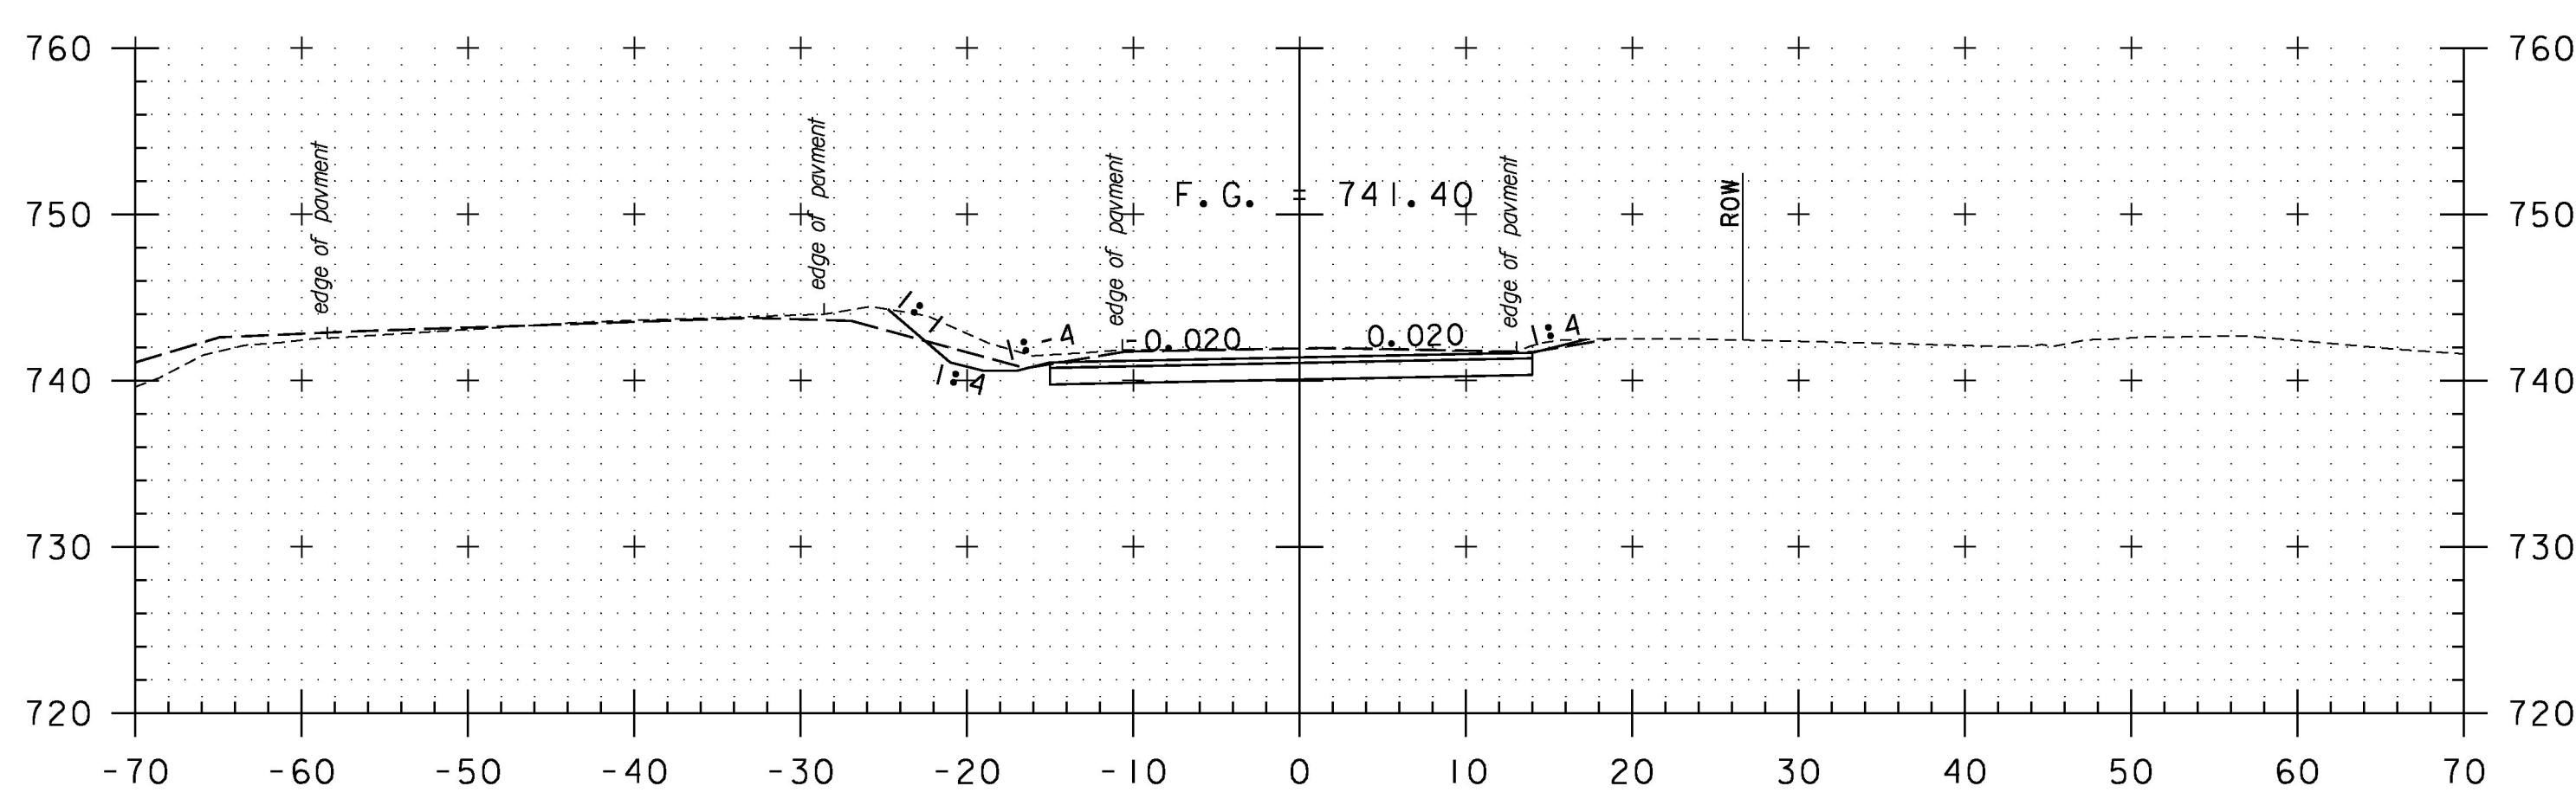


106+00

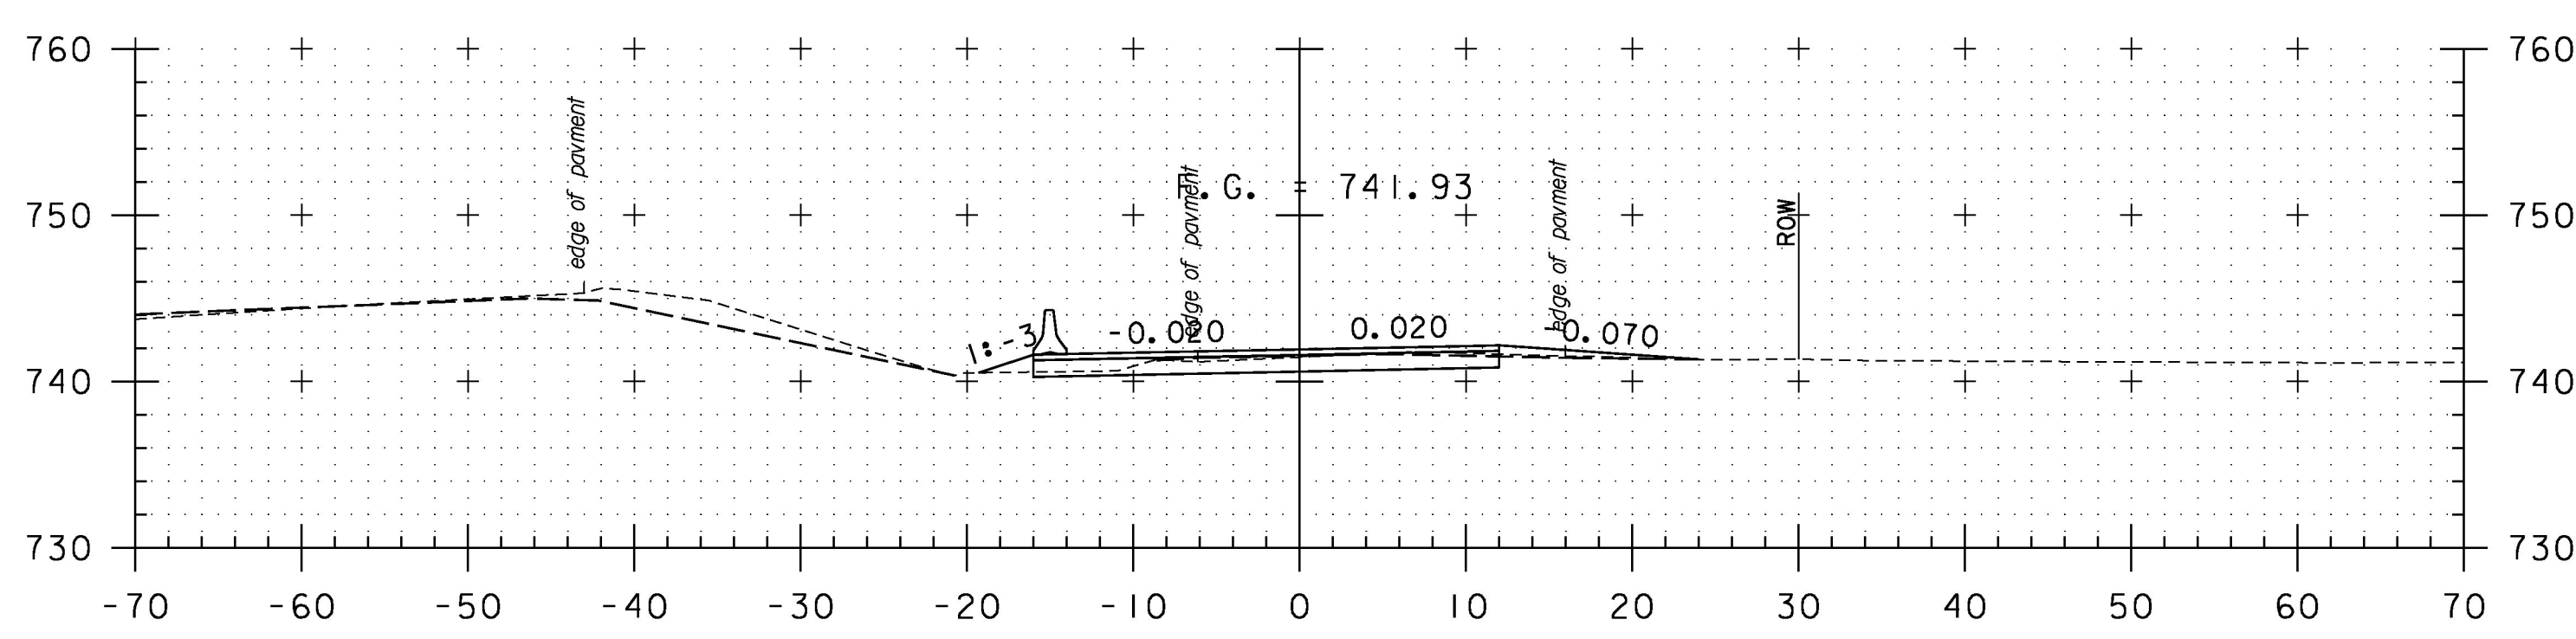


105+50

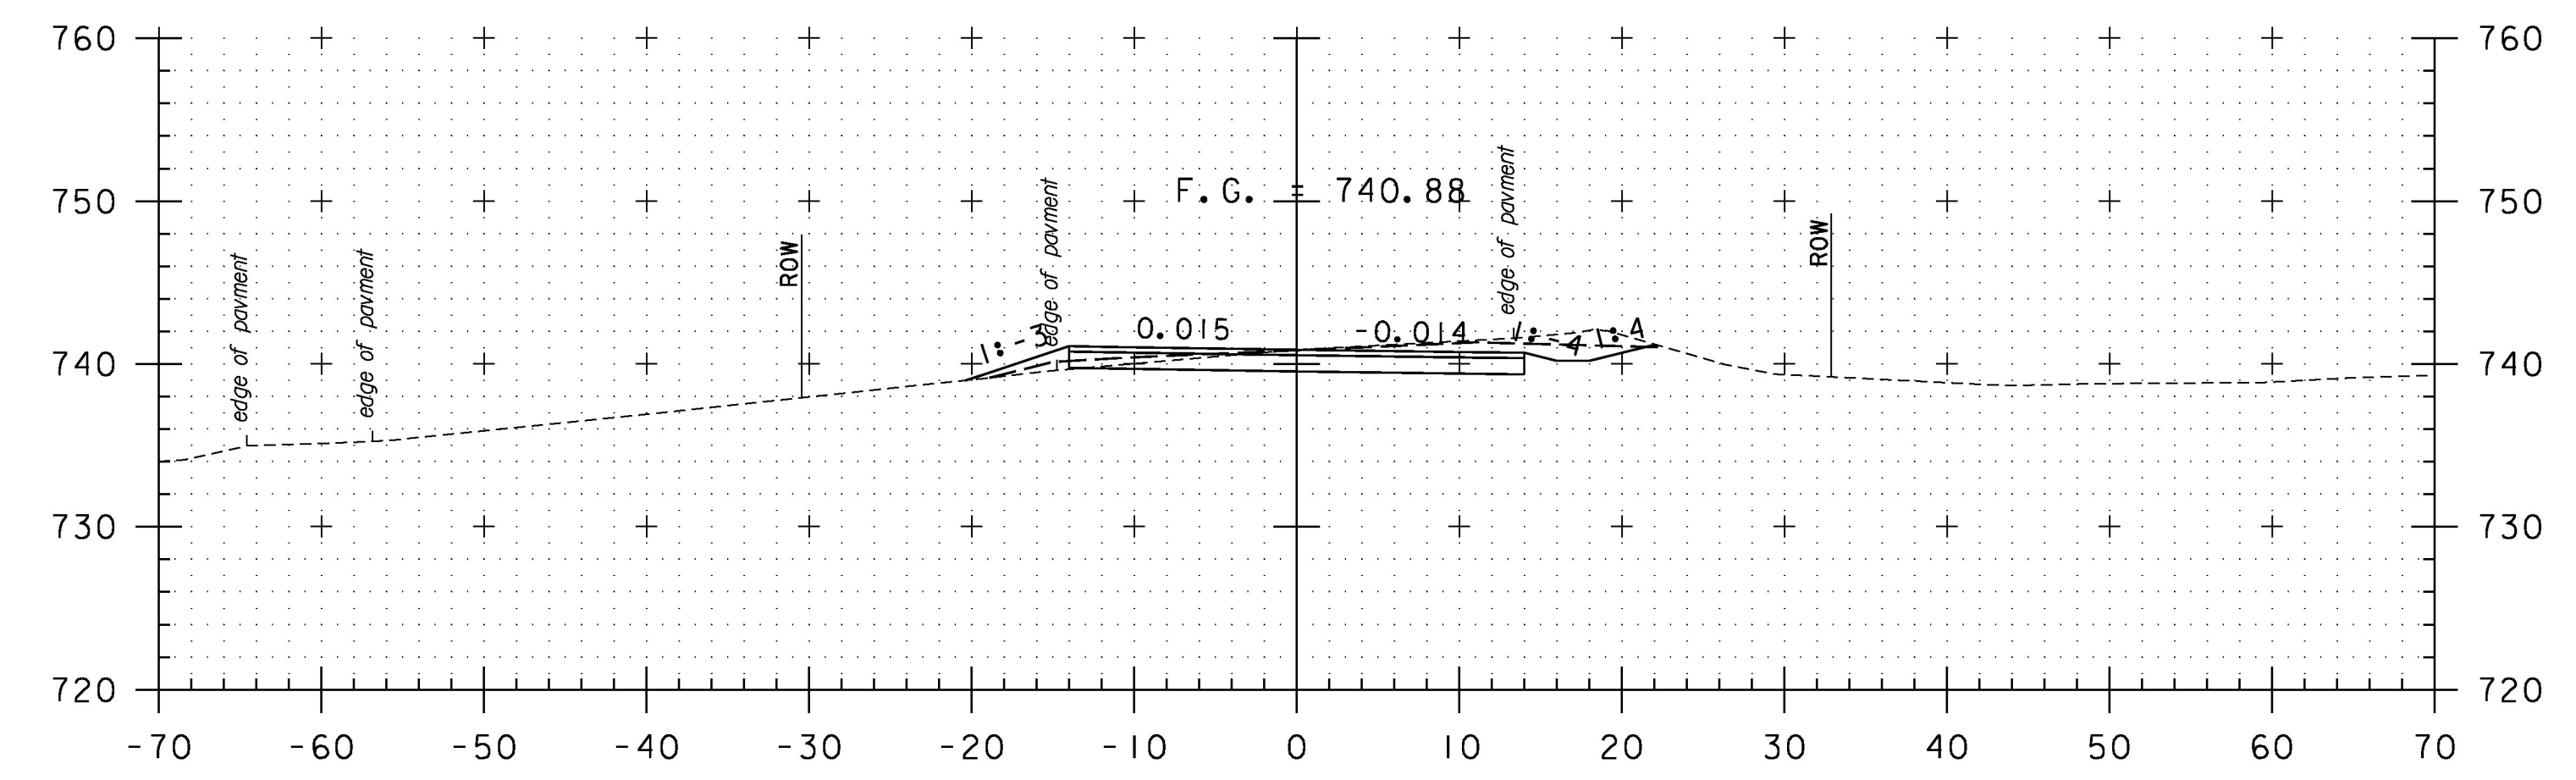

107+50

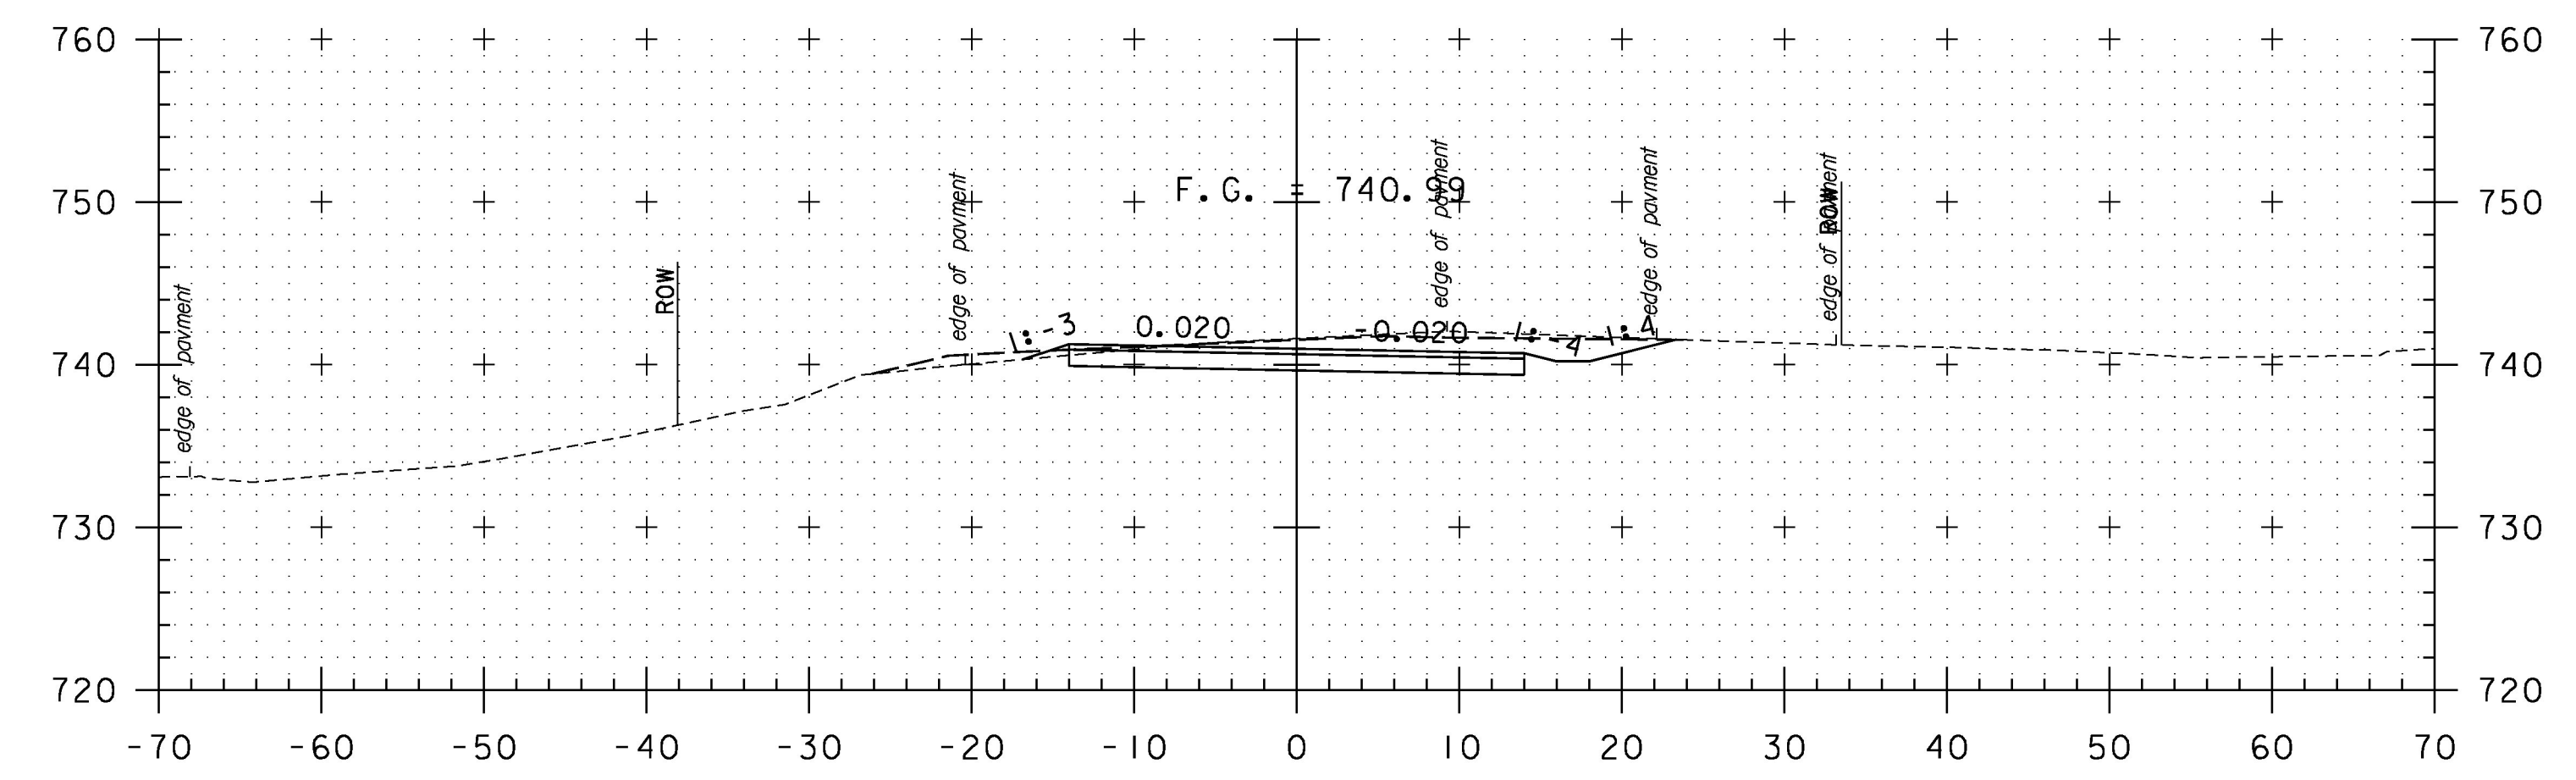

107+00

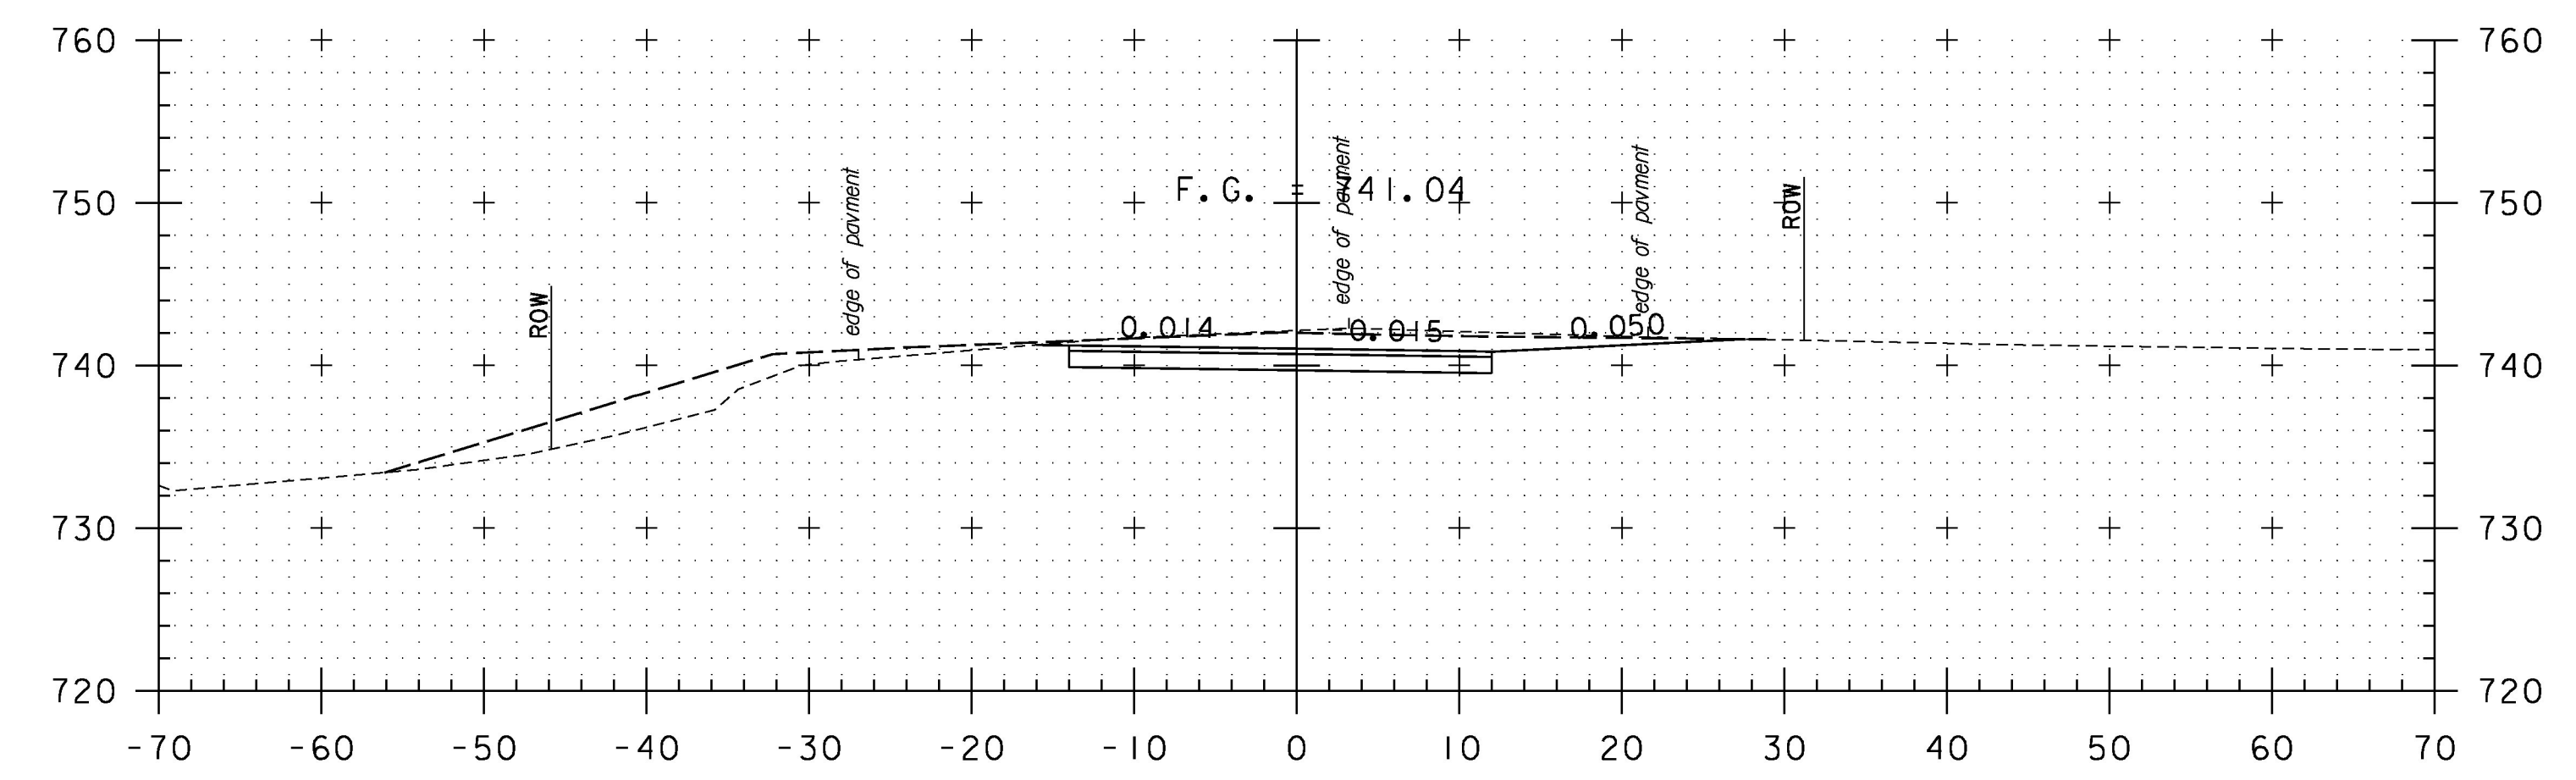

106+80

STA. 105+50 TO STA. 107+50

PROJECT NAME:	STOWE	PLOT DATE:	5/8/2015
PROJECT NUMBER:	BRF 0235(15)	DRAWN BY:	K. RUTTER
FILE NAME:	z88ci90xsDetour.dgn	CHECKED BY:	C. GREGORY
DESIGNED BY:	K. RUTTER	SHEET	62 OF 79
TEMP DETOUR CROSS SECTIONS			

