




108+50

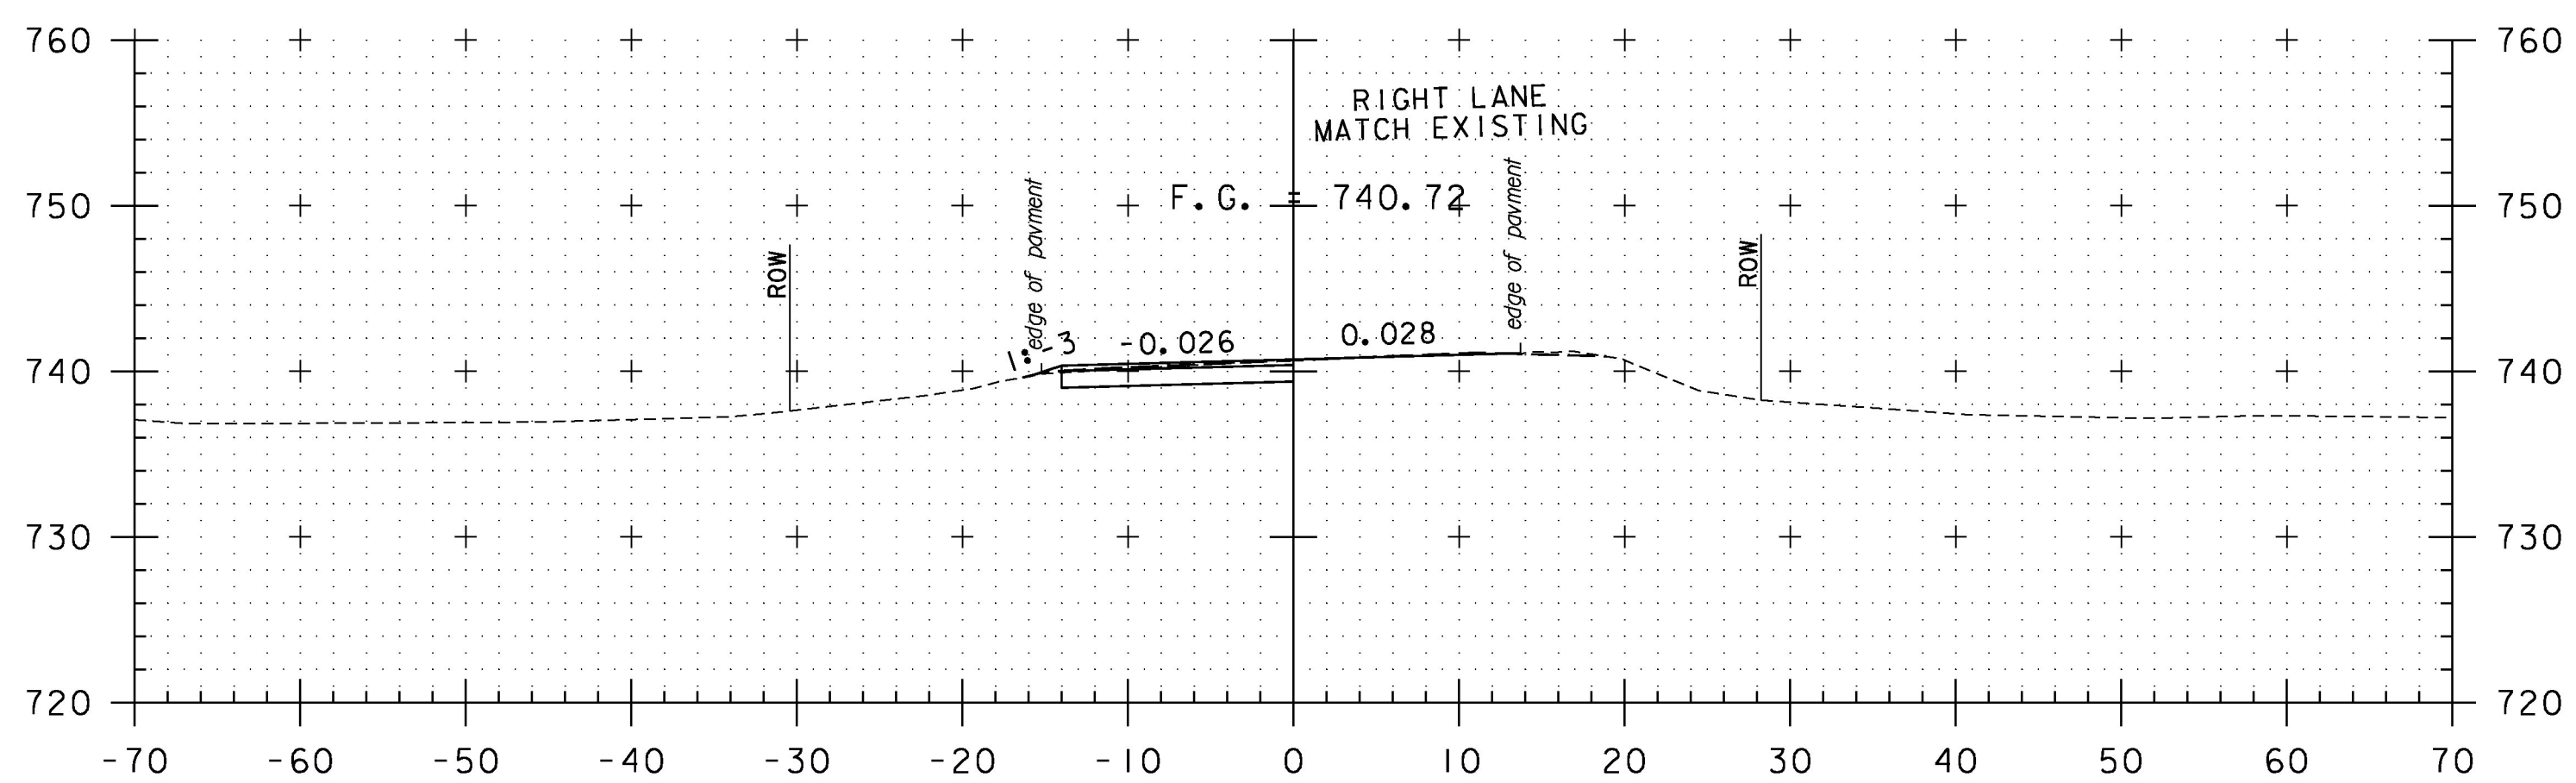


108+20

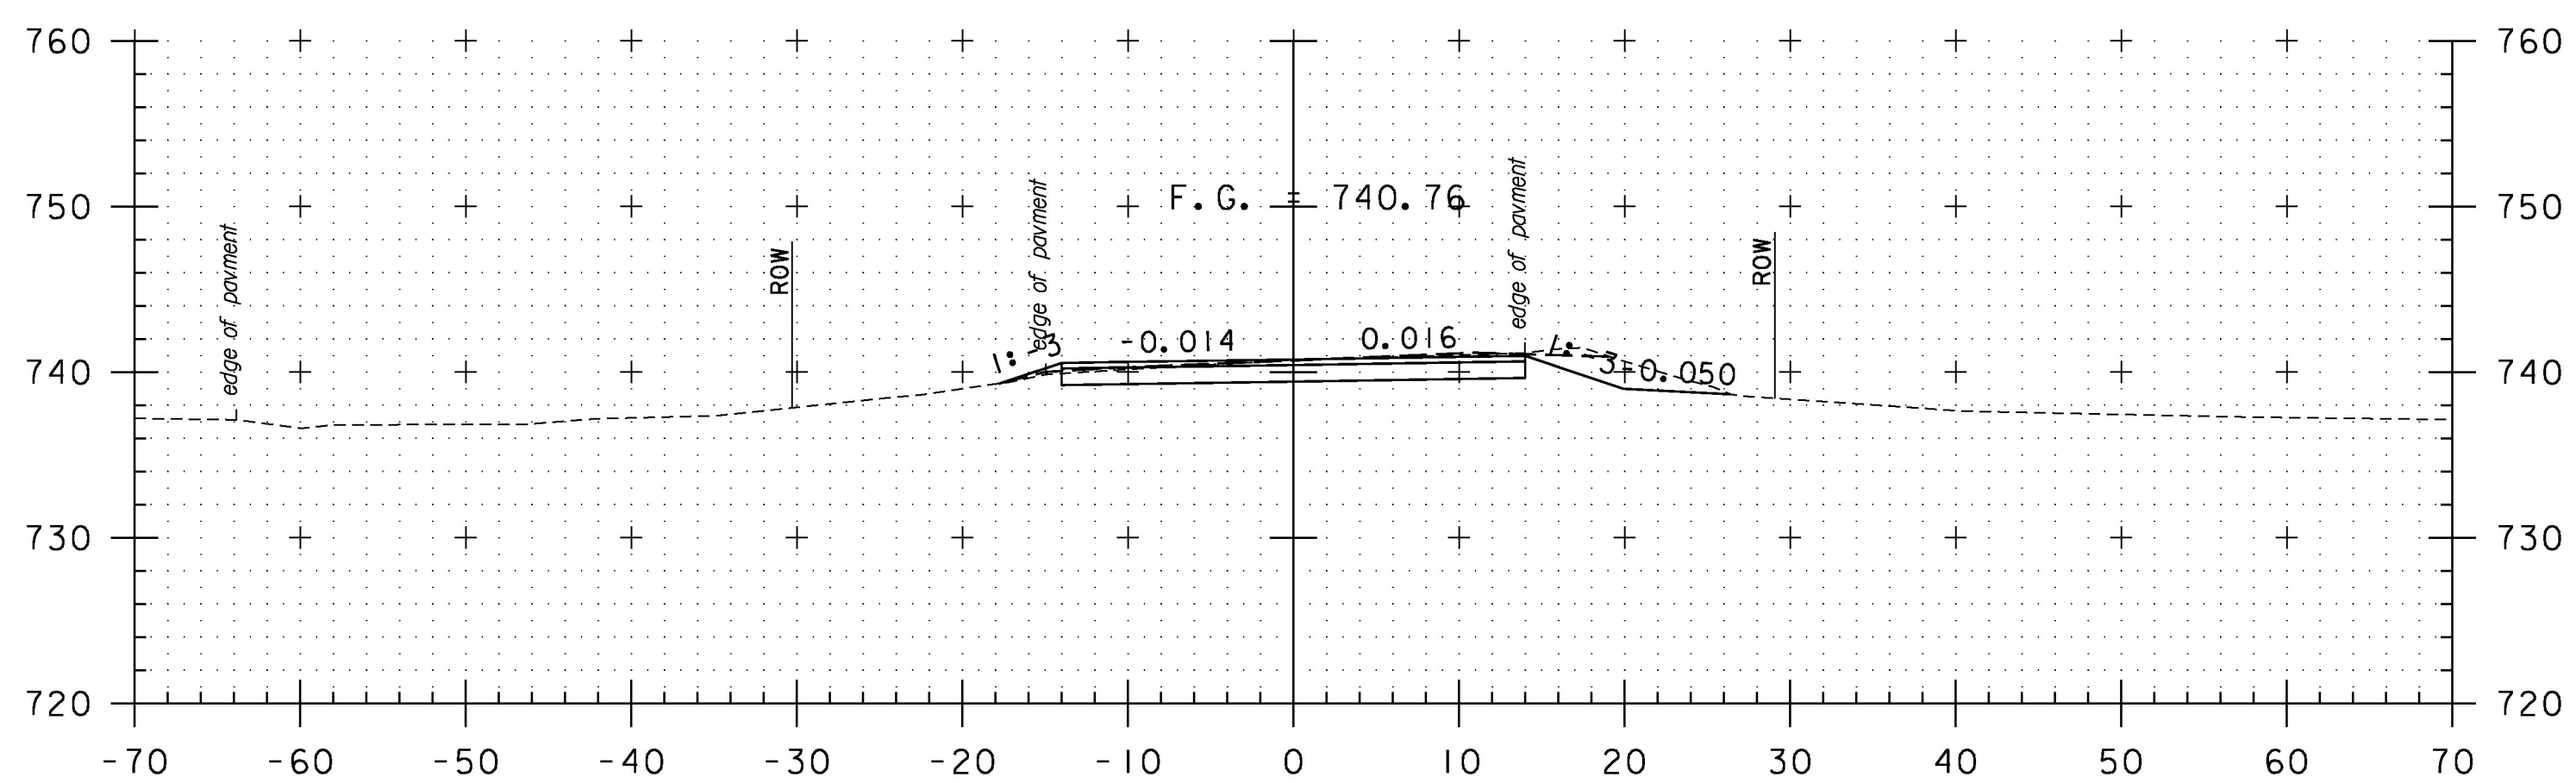

108+00

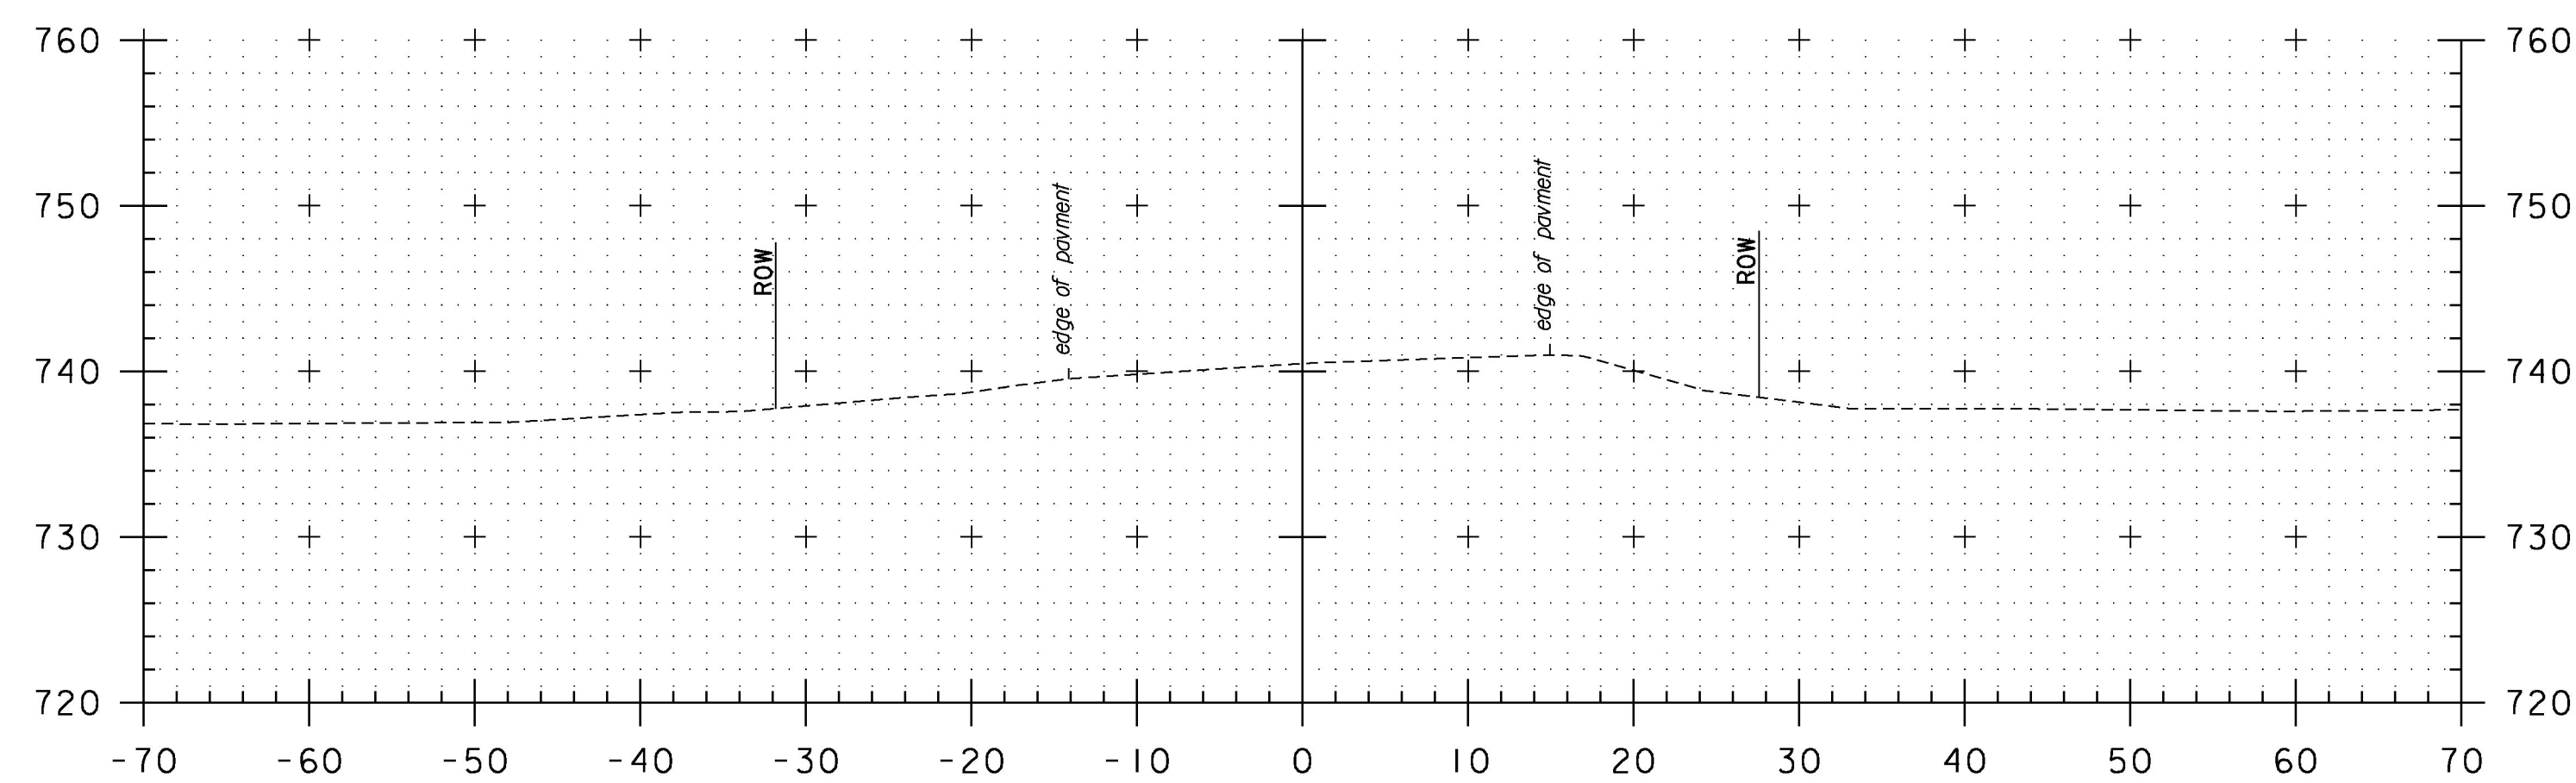

109+00

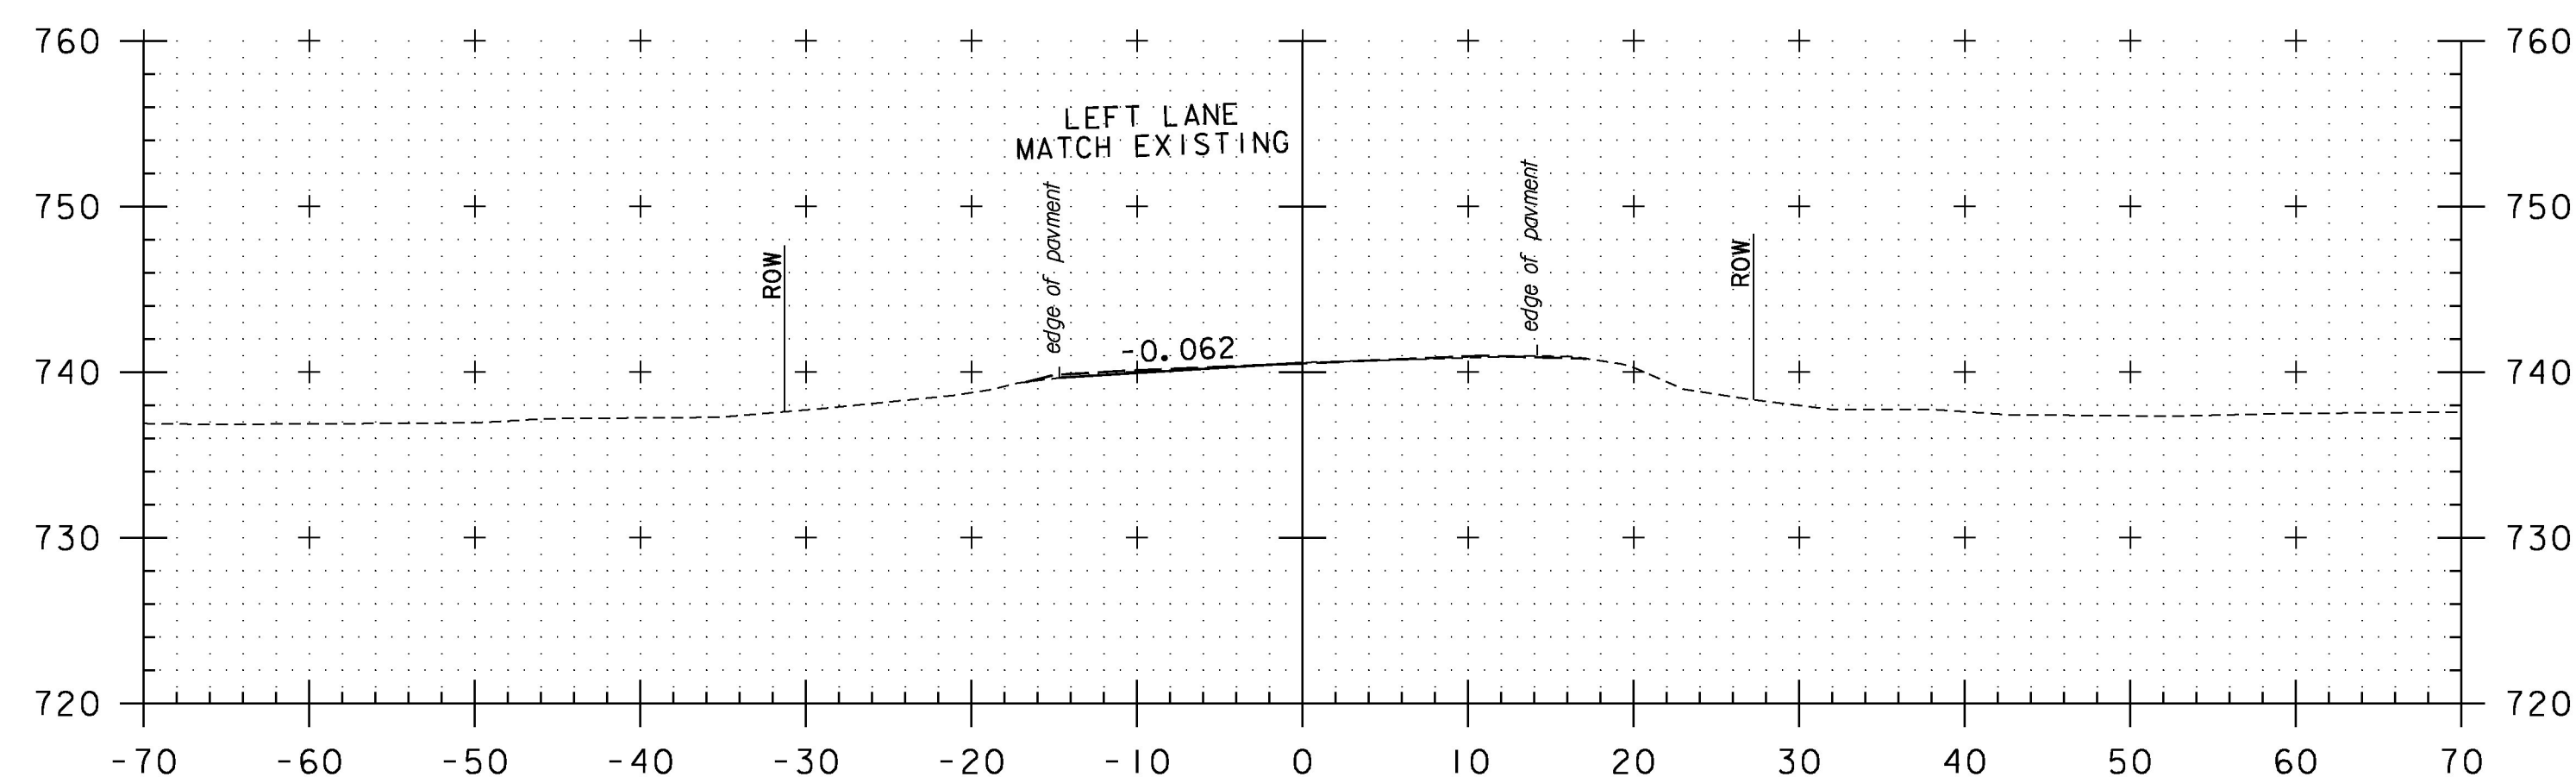

108+80

STA. 108+00 TO STA. 109+00

PROJECT NAME:	STOWE
PROJECT NUMBER:	BRF 0235(15)
FILE NAME:	z88ci90xsDetour.dgn
PROJECT LEADER:	J. BYATT
DESIGNED BY:	K. RUTTER
TEMP DETOUR CROSS SECTIONS	
PLOT DATE:	5/8/2015
DRAWN BY:	K. RUTTER
CHECKED BY:	C. GREGORY
SHEET	63 OF 79

