



CLD 12-0120 MODEL: CHANNEL XS 1

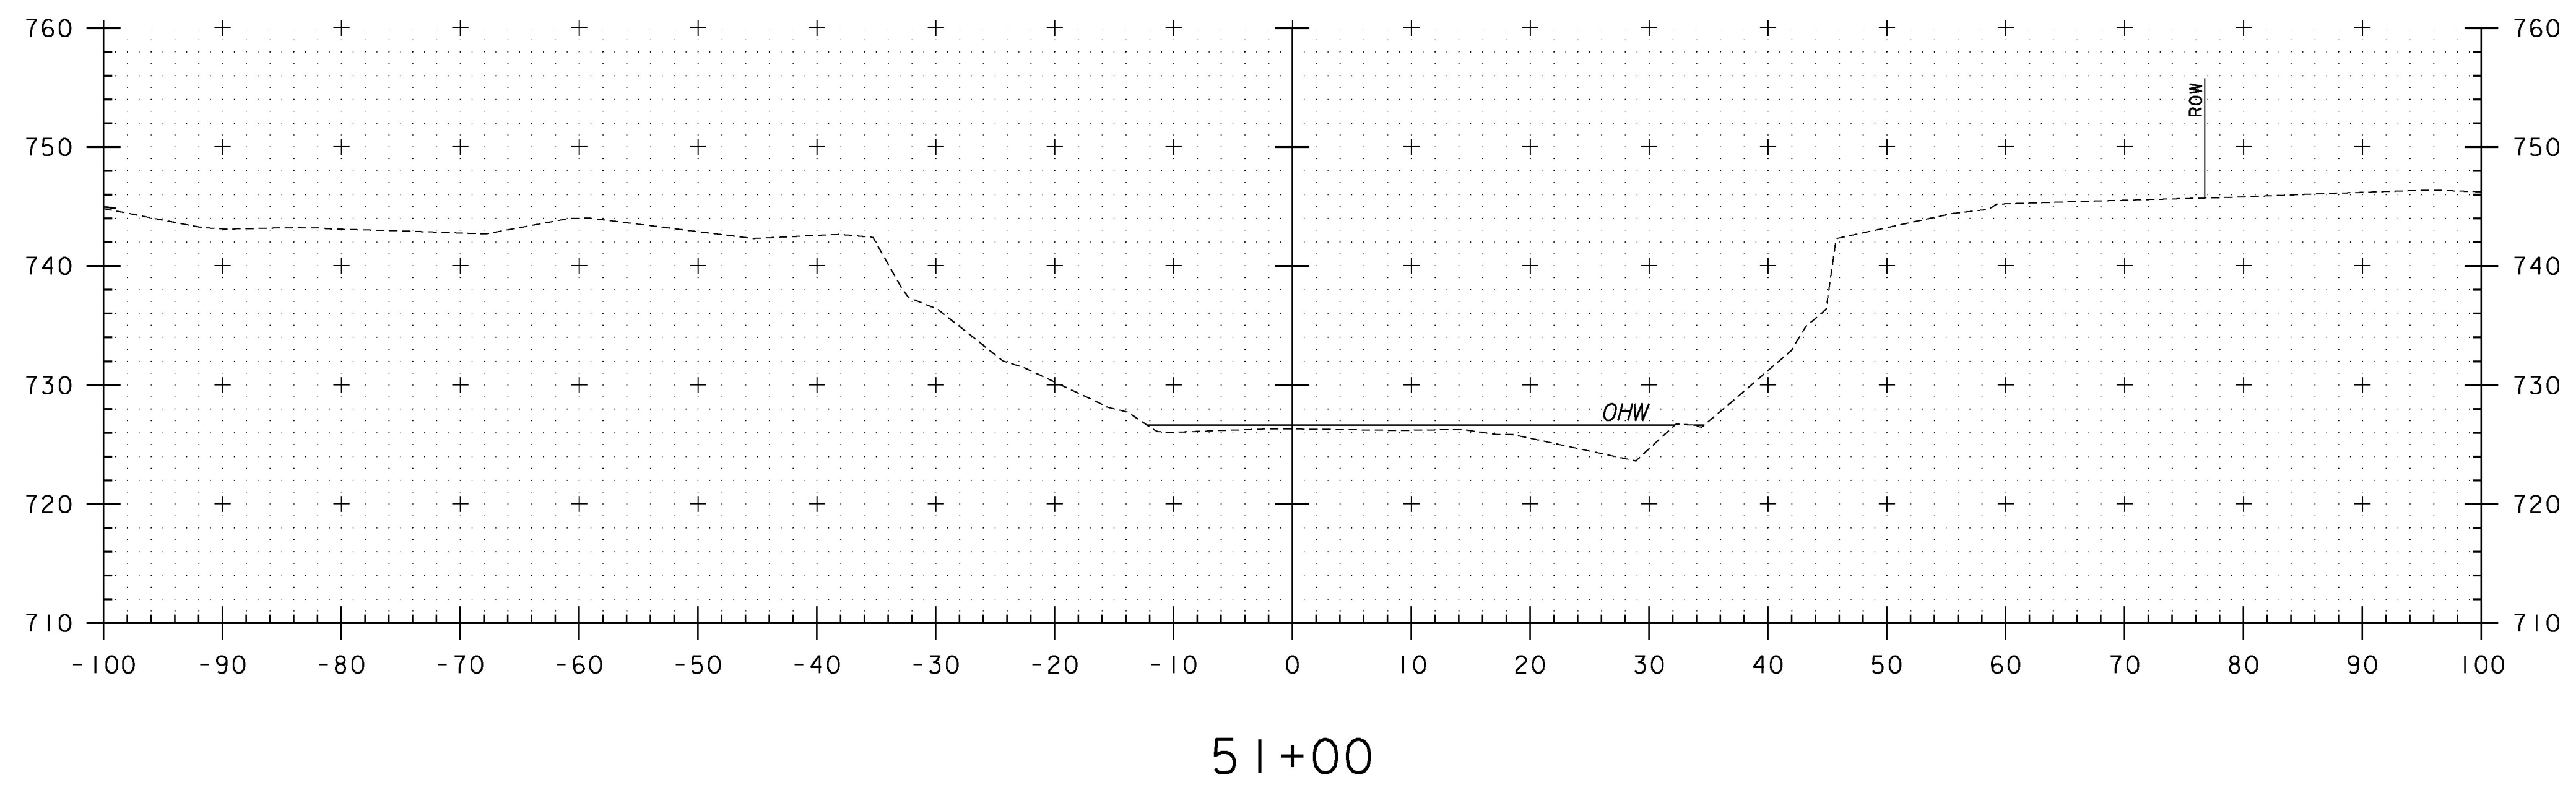

STA. 51+00 TO STA. 51+25

PROJECT NAME:	STOWE	PLOT DATE:	5/8/2015
PROJECT NUMBER:	BRF 0235(15)	DRAWN BY:	M. SMITH
FILE NAME:	z88c190xsChan.dgn	DESIGNED BY:	J. FRENCH
PROJECT LEADER:	J. BYATT	CHECKED BY:	J. BYATT
CHANNEL CROSS SECTIONS			SHEET 64 OF 79

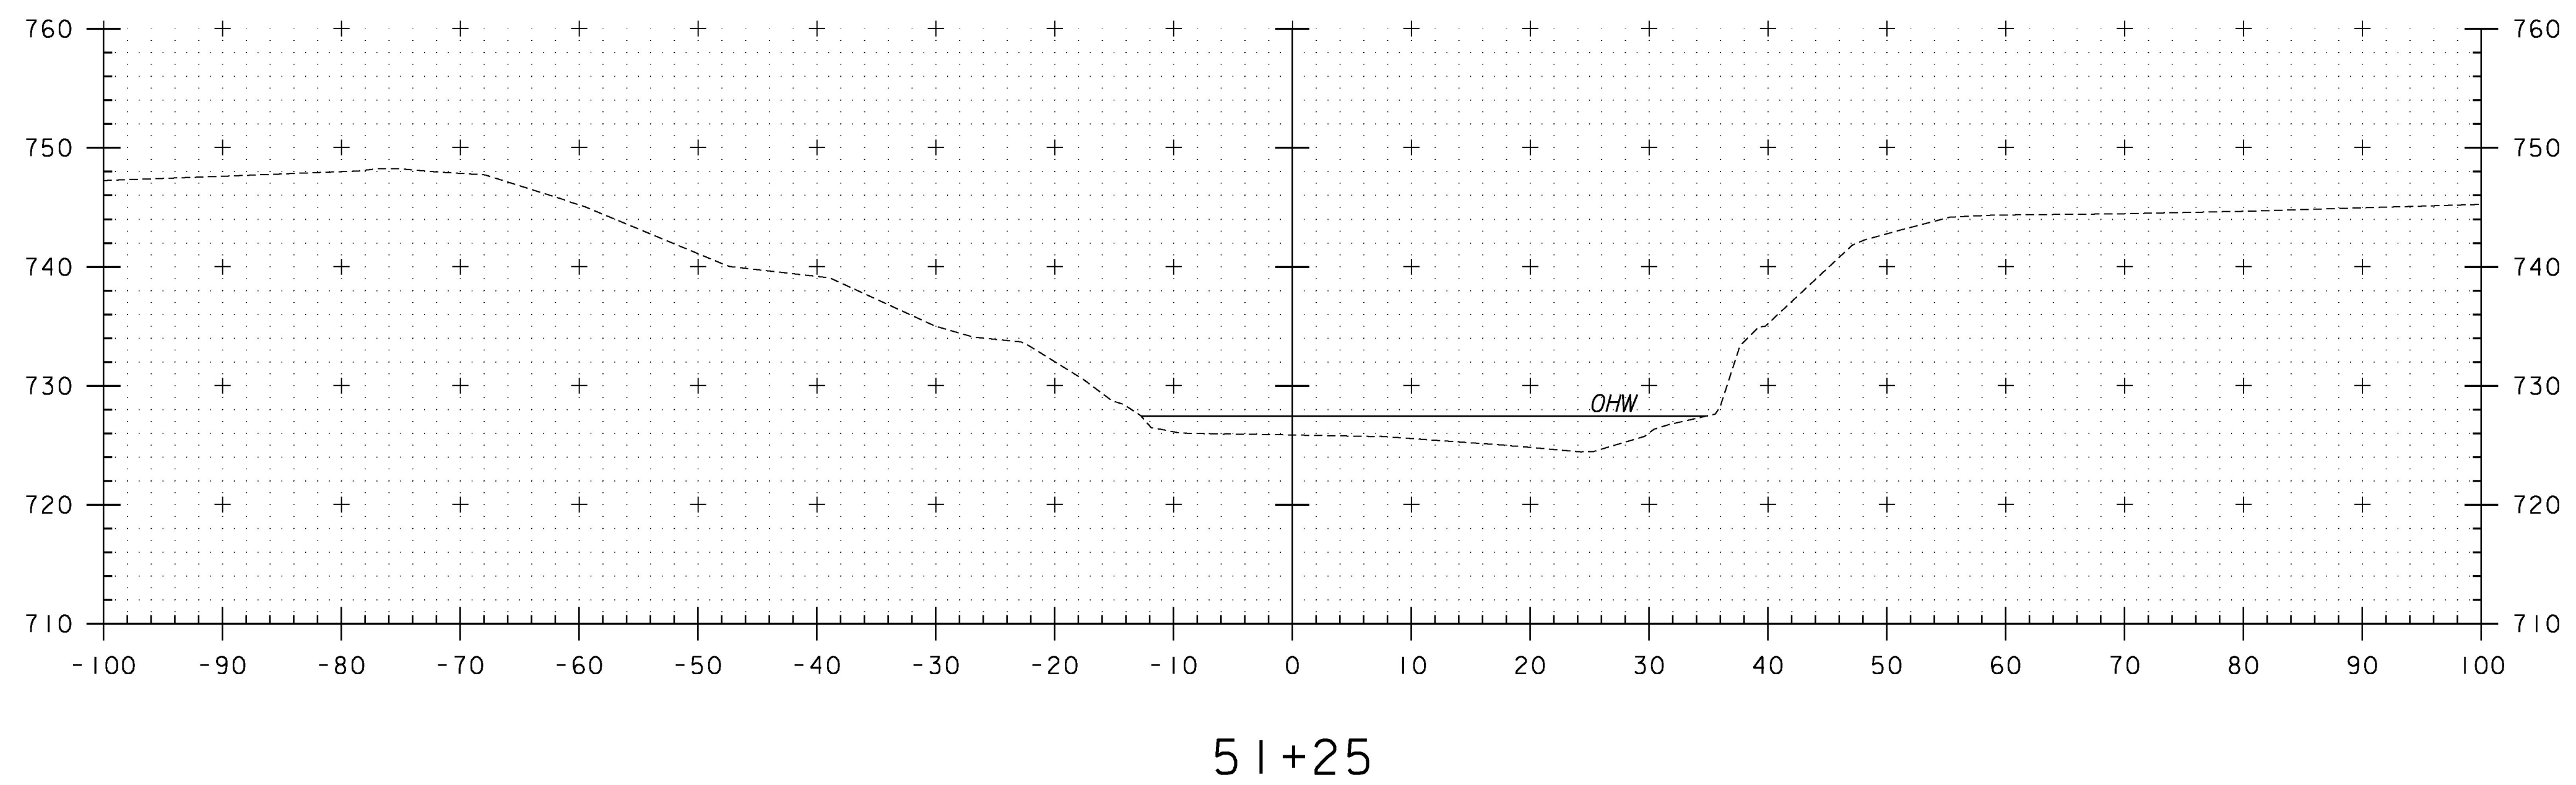