



CLD 12-0120 MODEL: CHANNEL XS 5

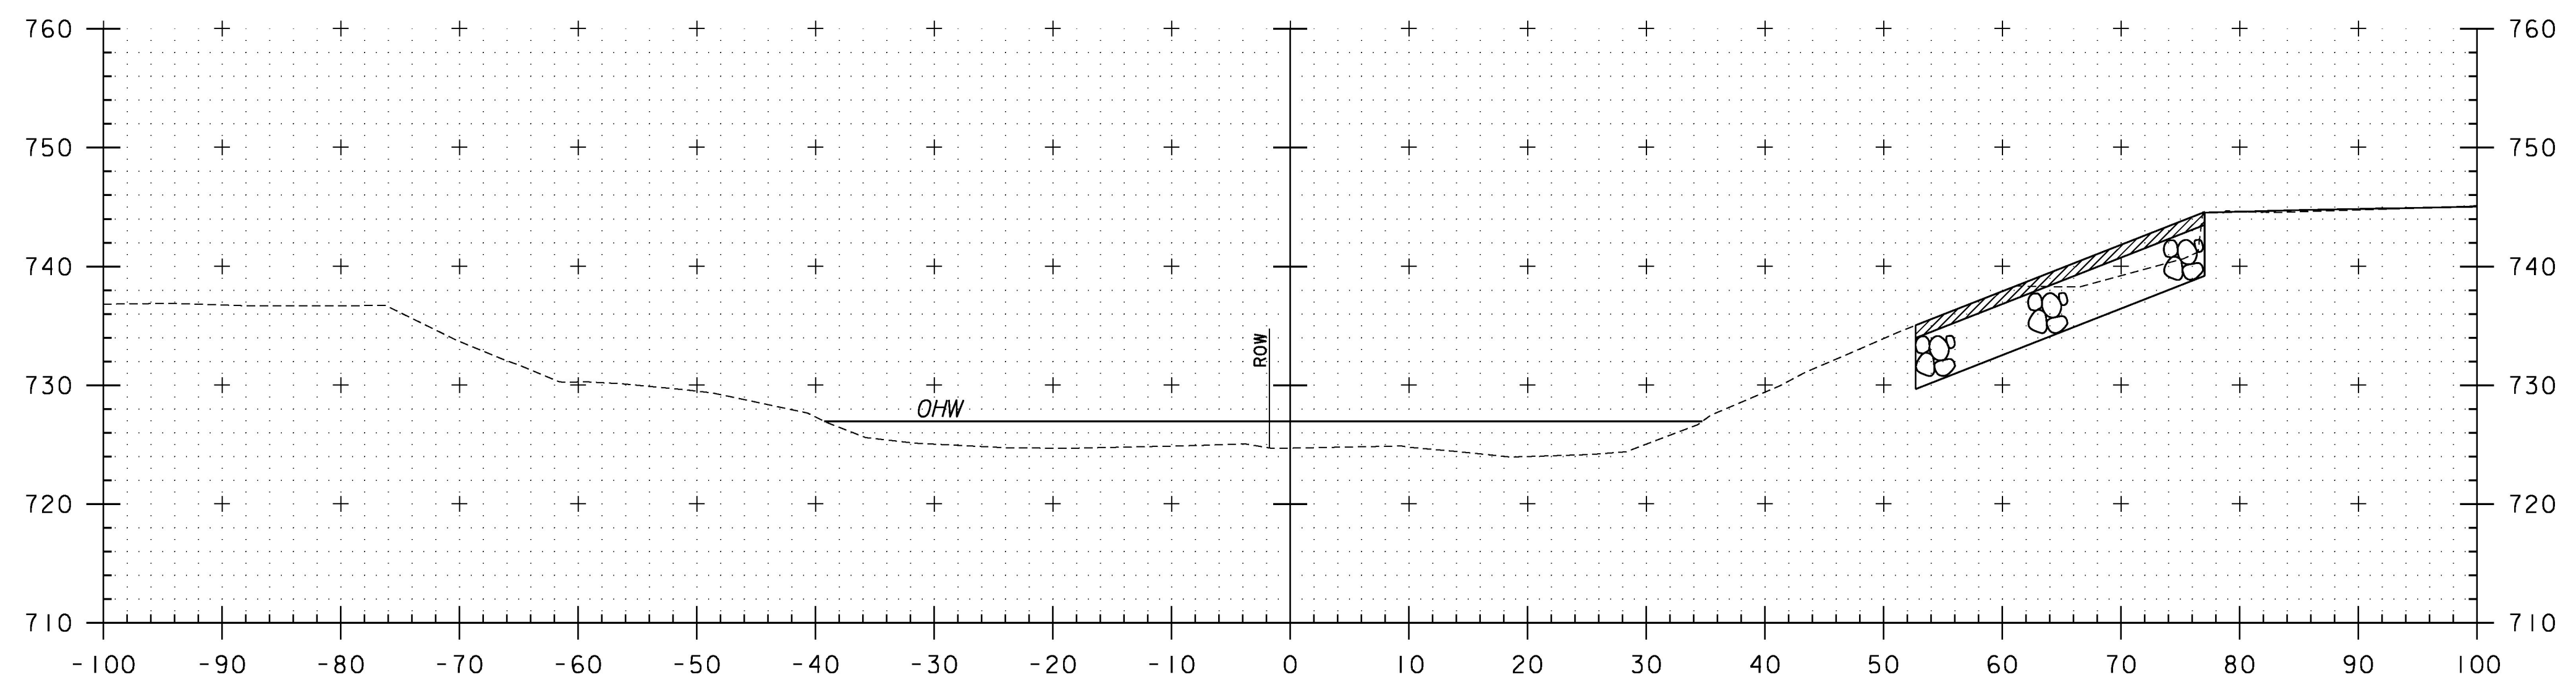

53+00

STA. 53+10.5 RT  
 END UNCLASSIFIED CHANNEL EXCAVATION  
 END GEOTEXTILE UNDER STONE FILL  
 END STONE FILL, TYPE IV  
 END GRUBBING MATERIAL

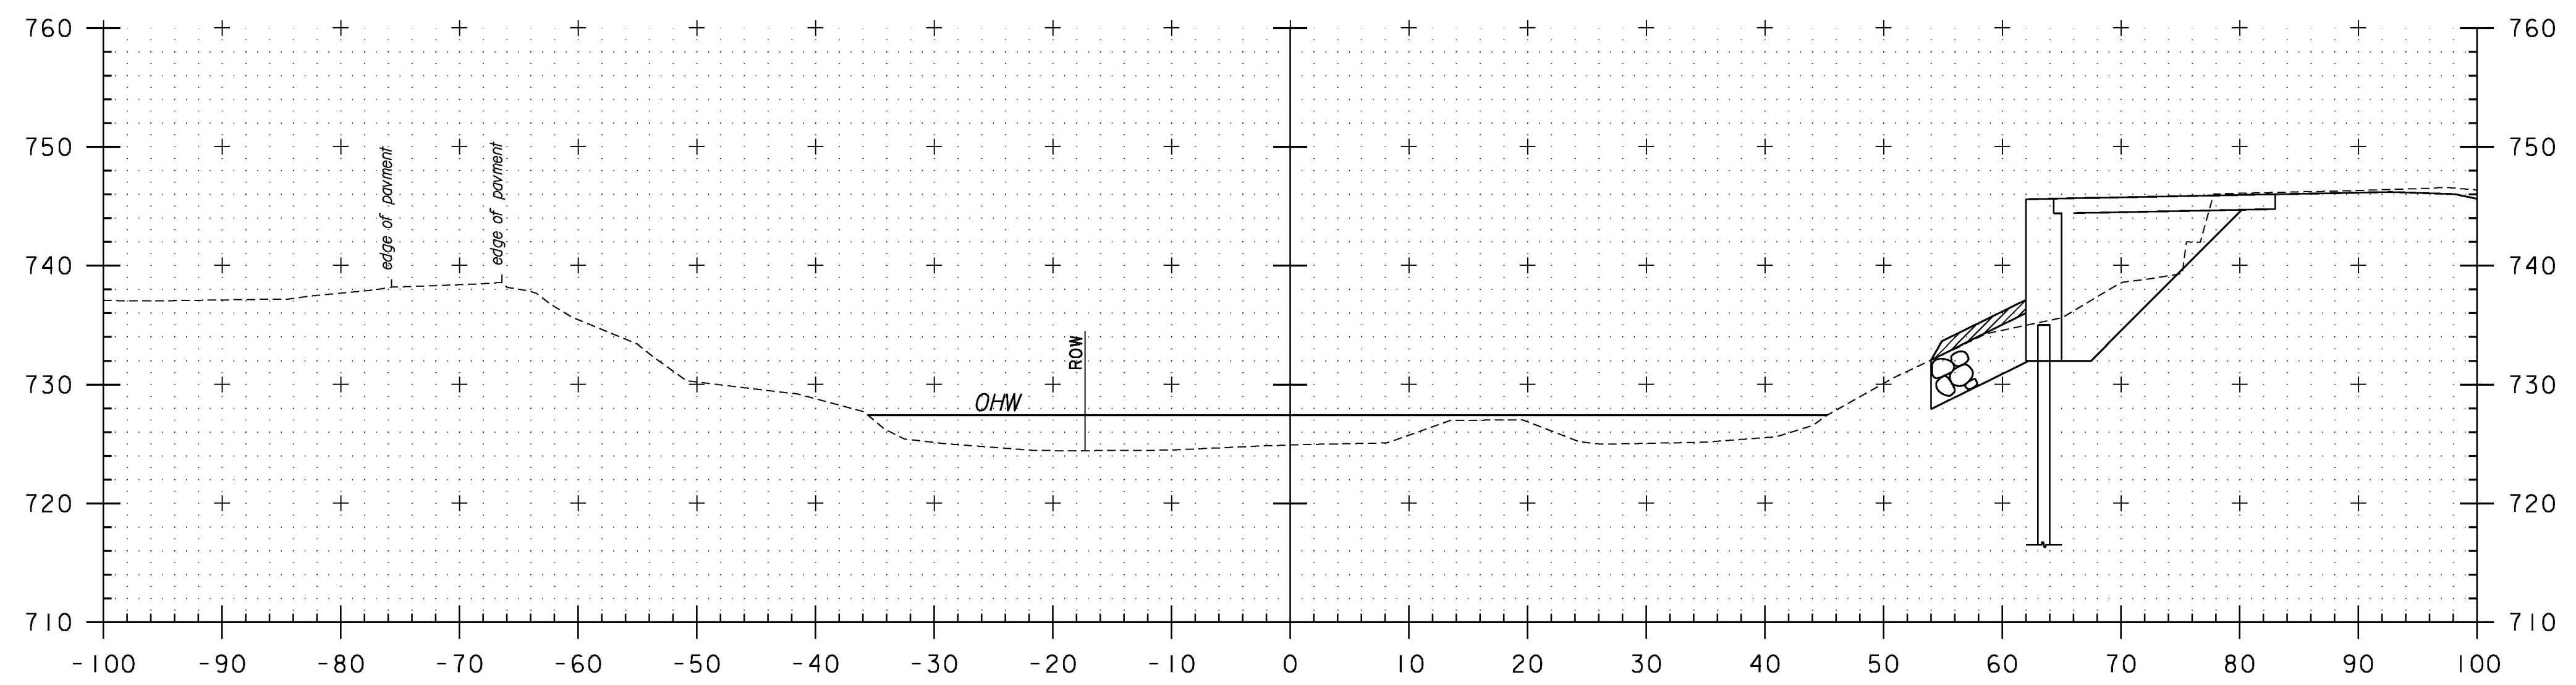

52+75

STA. 52+75 TO STA. 53+00

PROJECT NAME:	STOWE	PLOT DATE:	5/8/2015
PROJECT NUMBER:	BRF 0235(15)	DRAWN BY:	M. SMITH
FILE NAME:	z88cl90xsChan.dgn	DESIGNED BY:	J. FRENCH
PROJECT LEADER:	J. BYATT	CHECKED BY:	J. BYATT
CHANNEL CROSS SECTIONS		SHEET	68 OF 79

