



PERMANENT EROSION MATTING
 13+00 TO 14+75 LT
 13+00 TO 14+71 RT

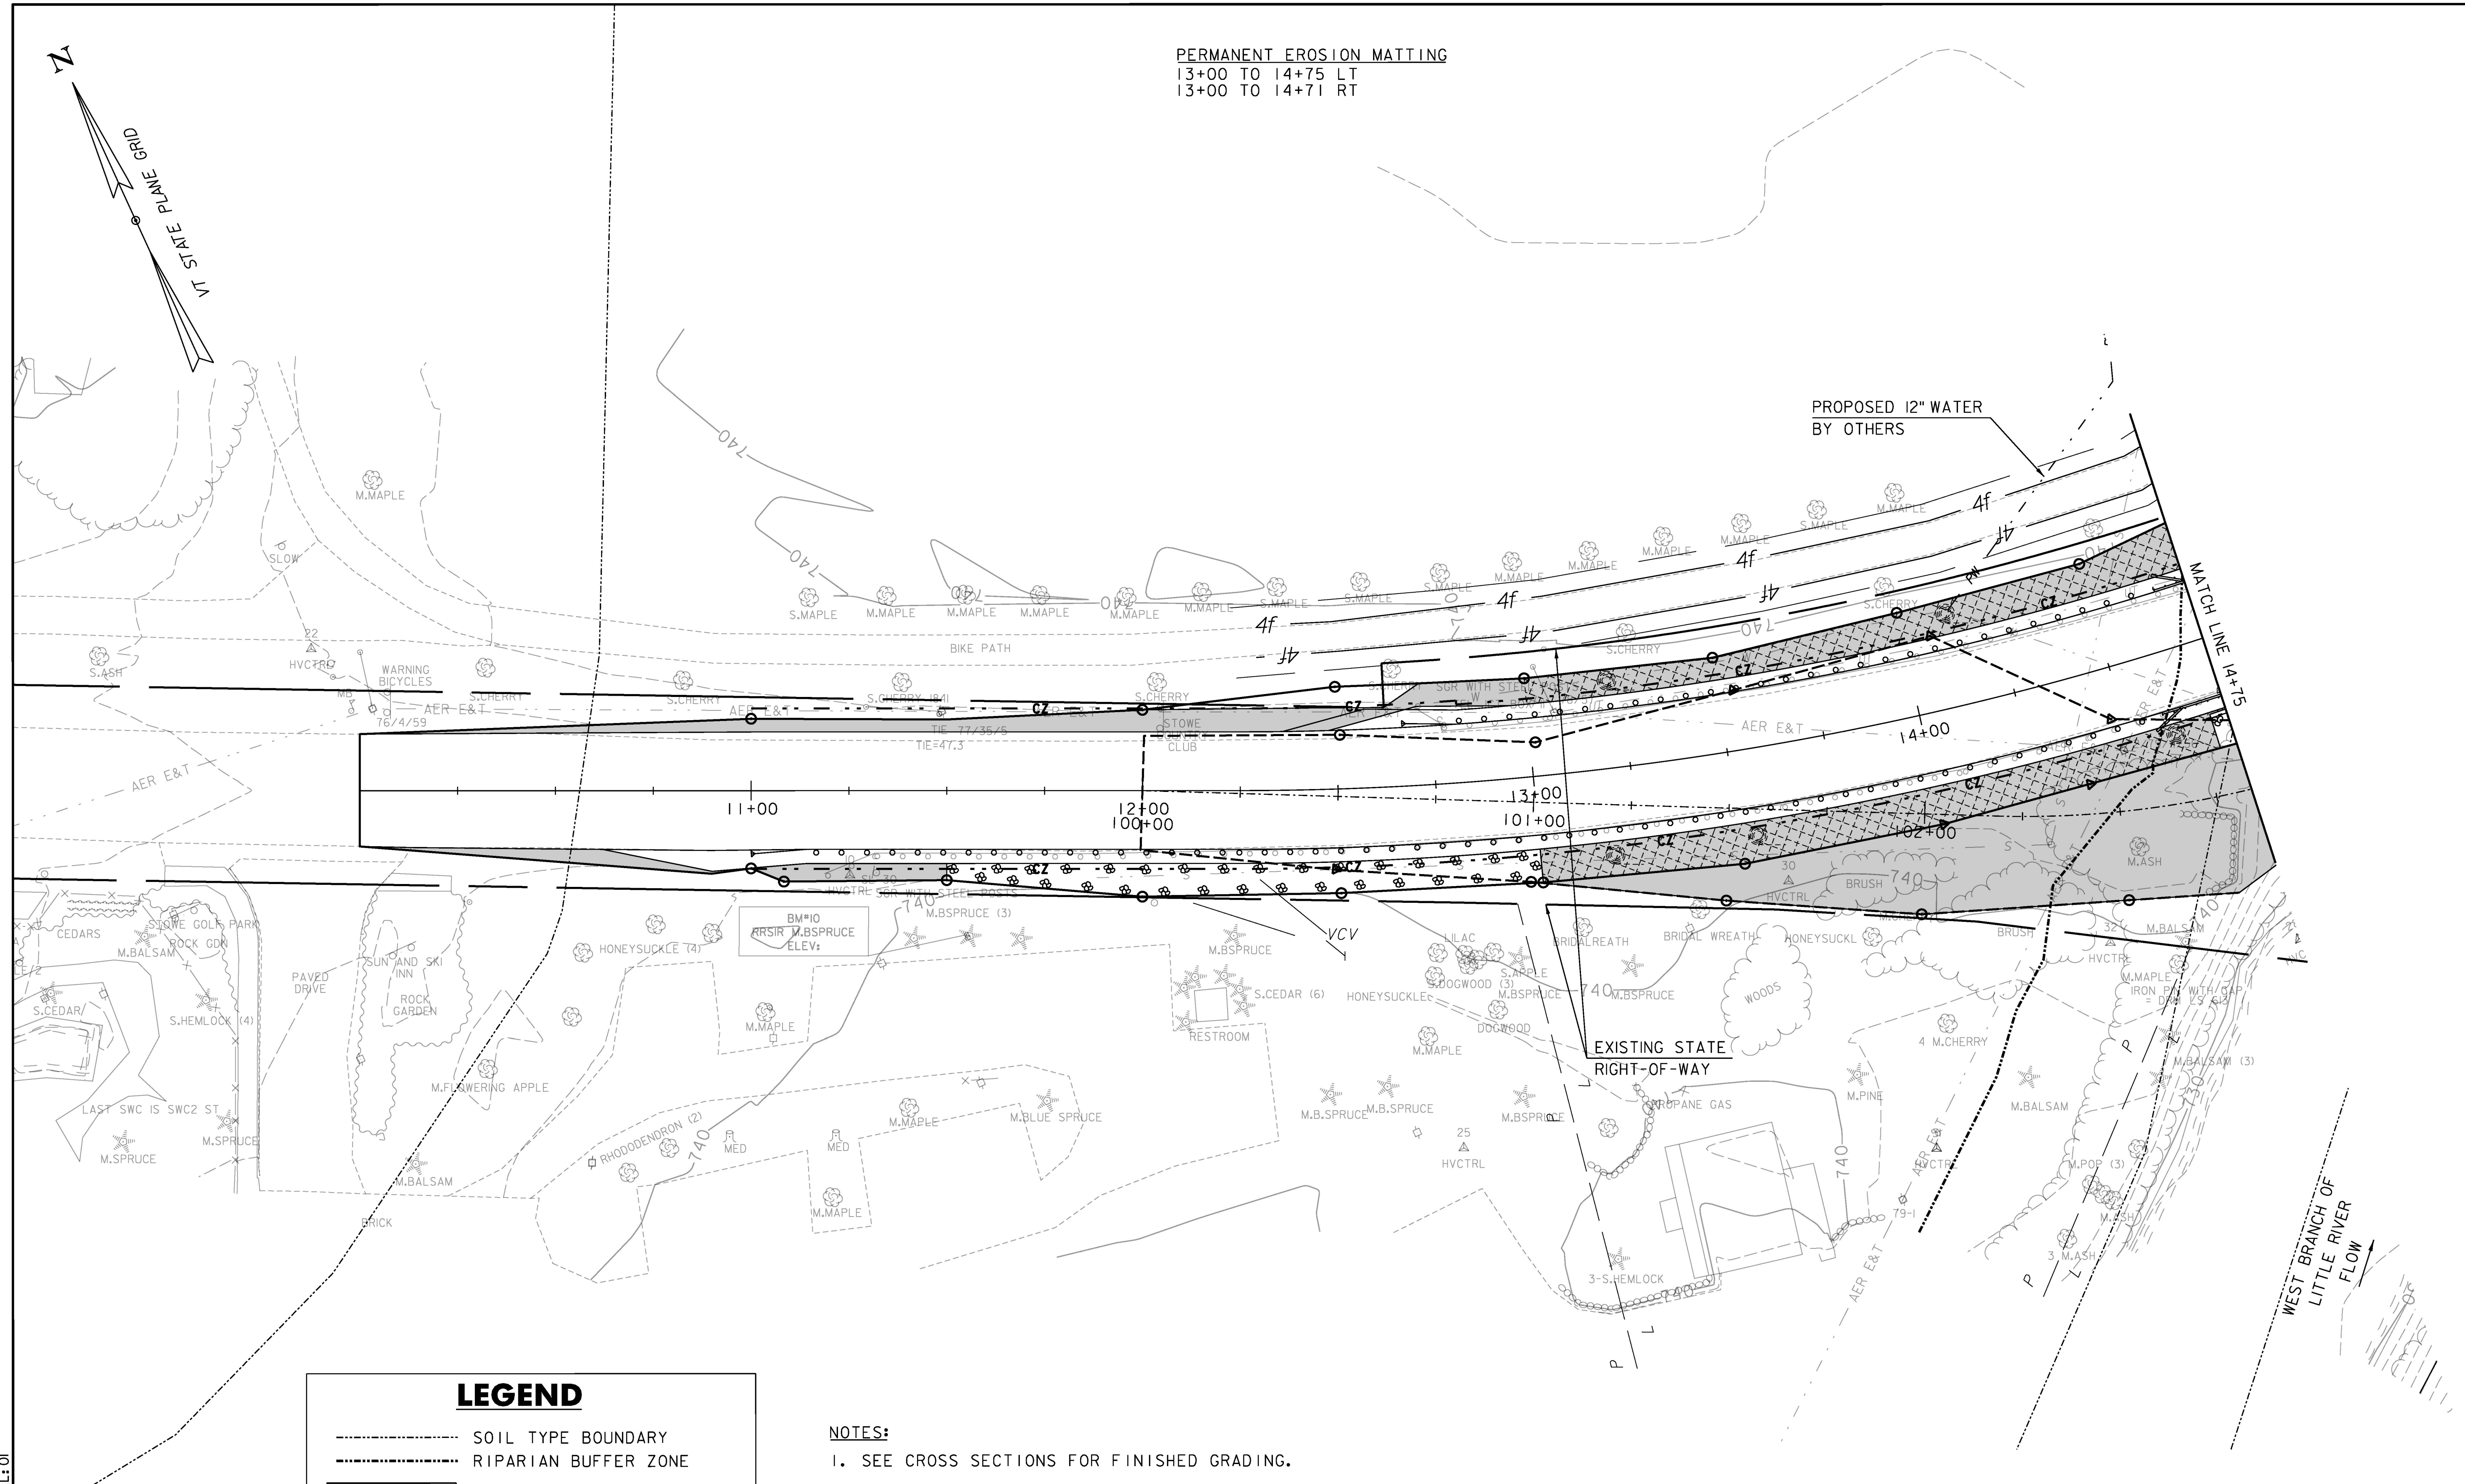

LEGEND	
	SOIL TYPE BOUNDARY
	RIPARIAN BUFFER ZONE
	DISTURBED AREAS REQUIRING RE-VEGETATION
	TEMPORARY EROSION MATTING
	STONE FILL, TYPE II

NOTES:
 1. SEE CROSS SECTIONS FOR FINISHED GRADING.

SCALE 1" = 20' - 0"
 20 0 20

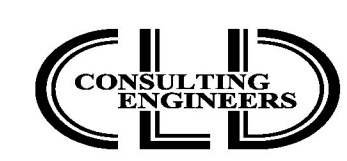

PROJECT NAME: STOWE	PLOT DATE: 5/8/2015
PROJECT NUMBER: BRF 0235(15)	DRAWN BY: S. FORTIER
FILE NAME: z88cl90bdrerofl.dgn	CHECKED BY: K. RUTTER
PROJECT LEADER: J. BYATT	SHEET 75 OF 79
DESIGNED BY: S. FORTIER	
EPSC FINAL PLAN SHEET I	

CLD 12-0120 MODEL: 01