


**LEGEND**

- SOIL TYPE BOUNDARY
- - - RIPARIAN BUFFER ZONE
- █ DISTURBED AREAS REQUIRING RE-VEGETATION
- ▨ TEMPORARY EROSION MATTING
- ⊠ STONE FILL, TYPE II


PERMANENT EROSION MATTING  
 14+75 TO 15+04 LT  
 17+00 TO 18+50 LT

VT108 STA 15+50.00 =  
 CHANNEL STA 52+00.00  
 $\Delta = 50^{\circ}00'00''$   
 (TANGENT TO CURVE)

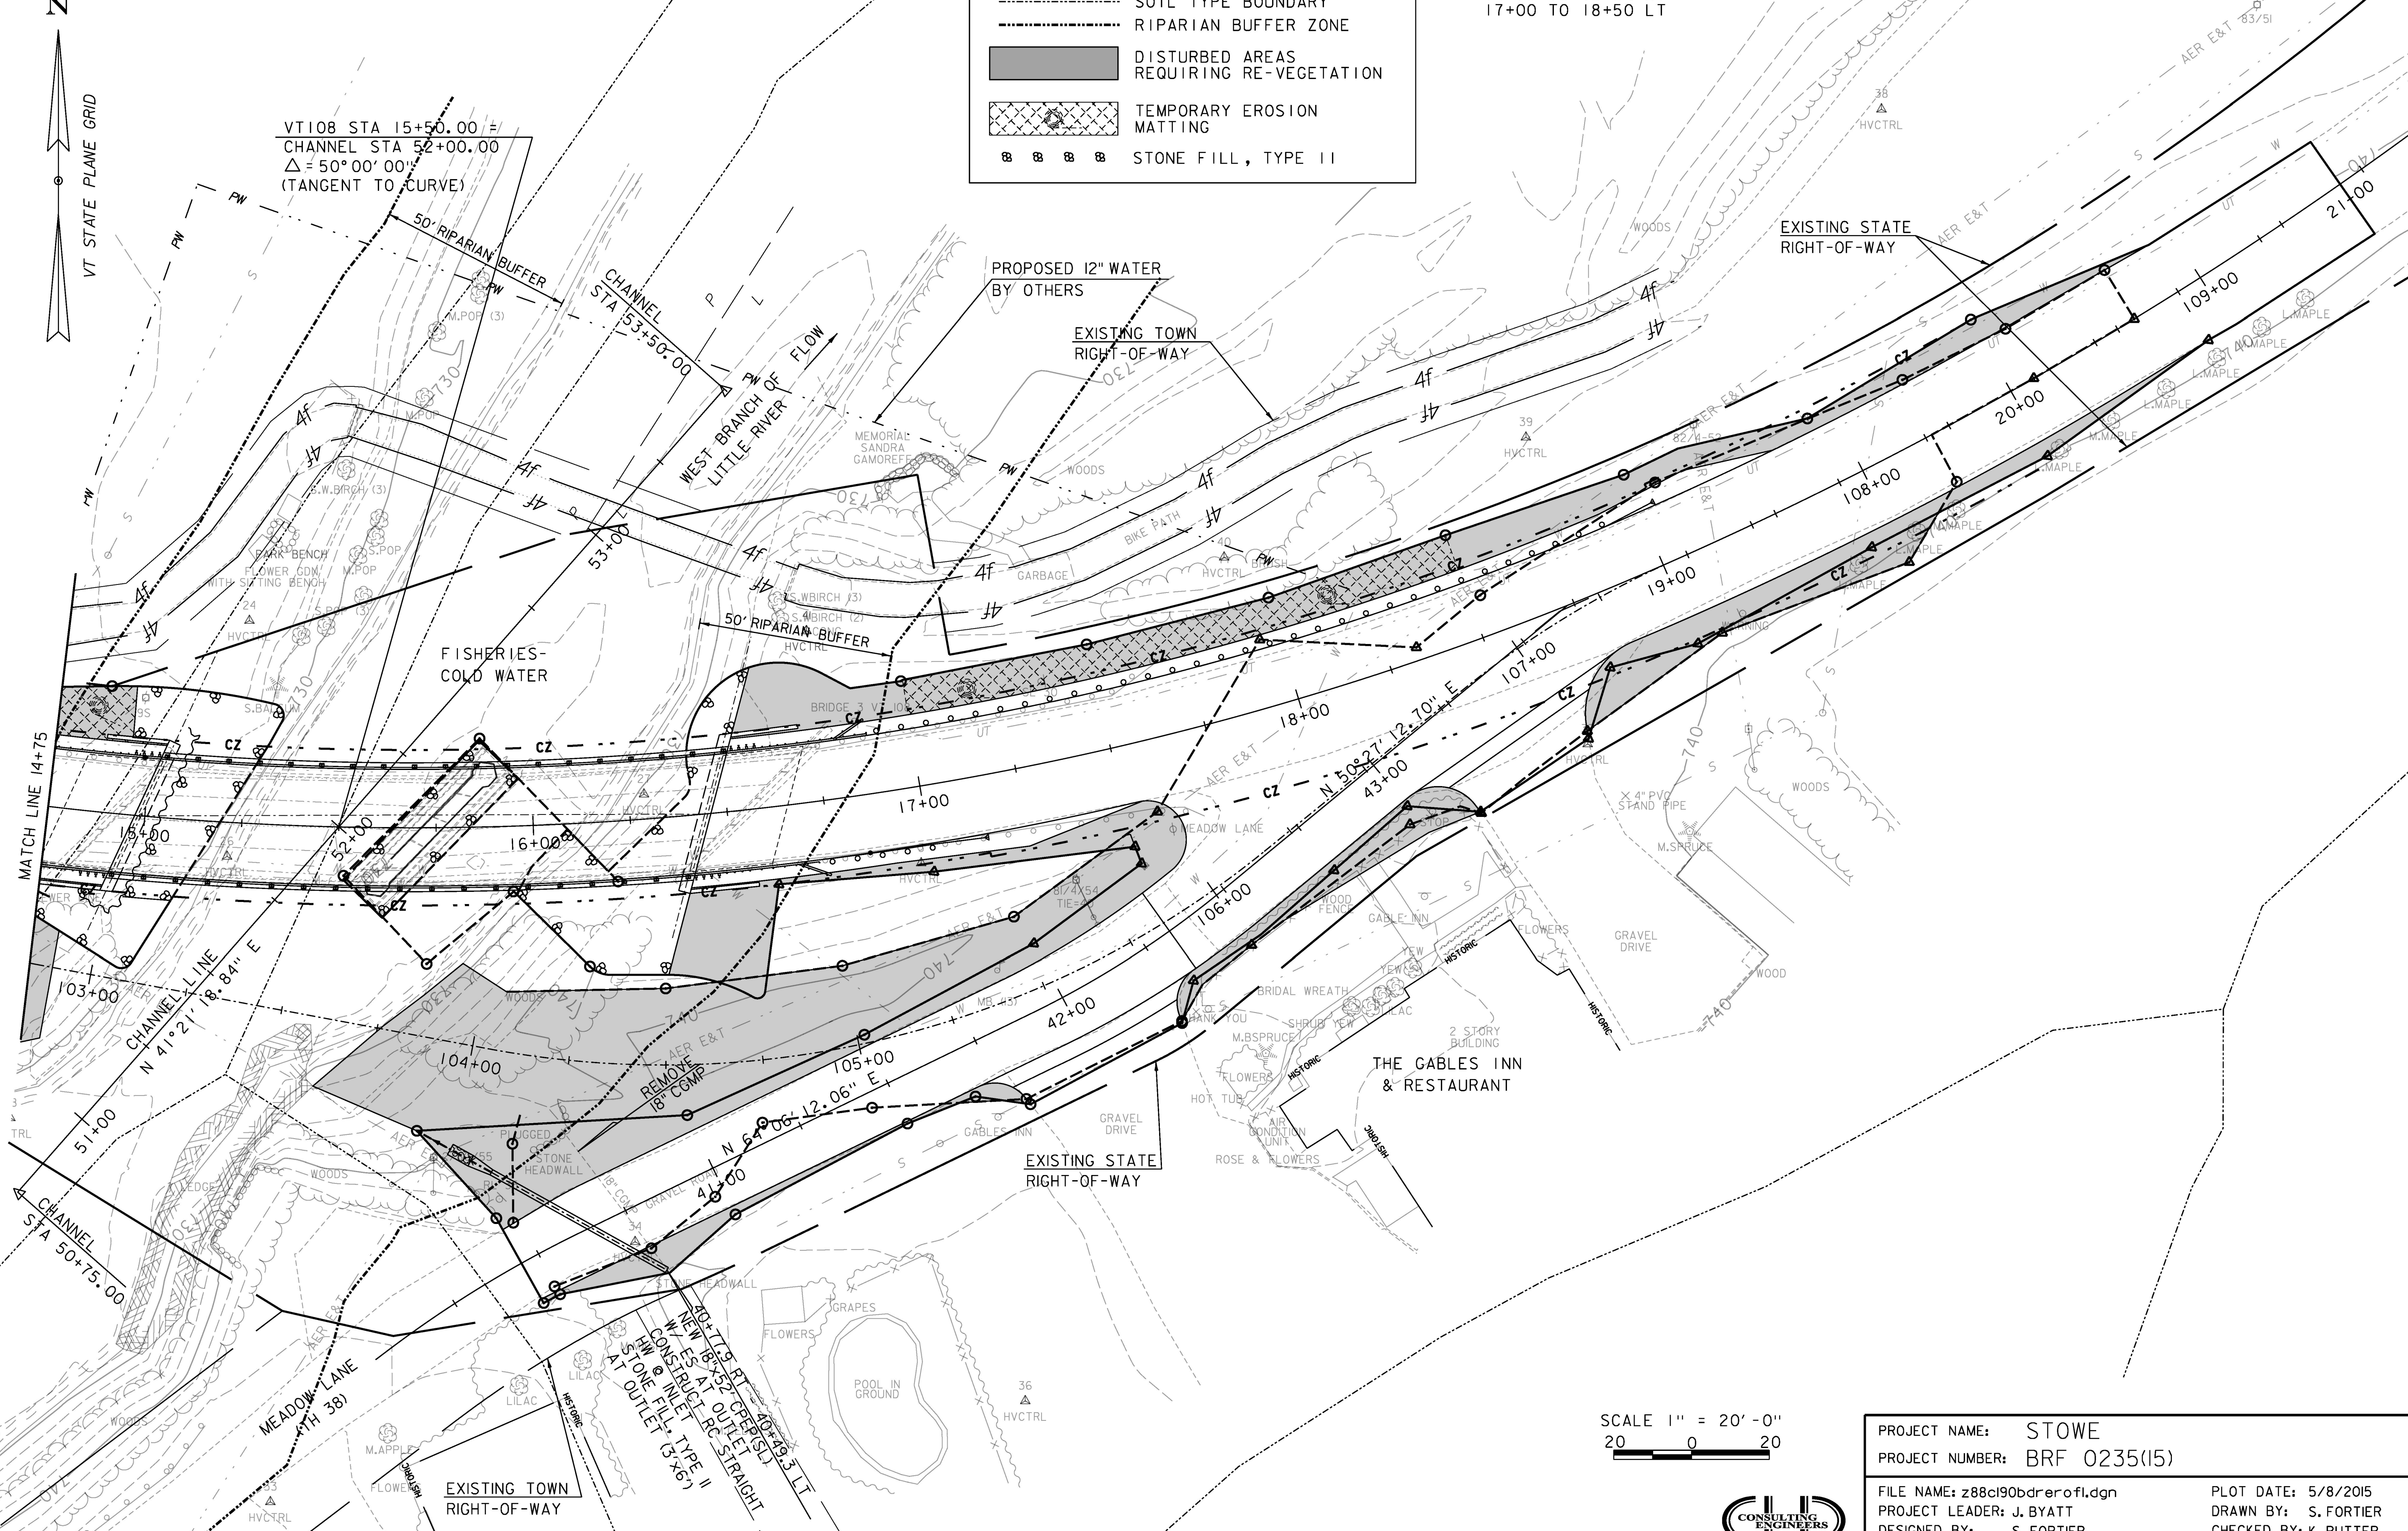

CLD 12-0120 MODEL:02

SCALE 1" = 20'-0"  
 20 0 20

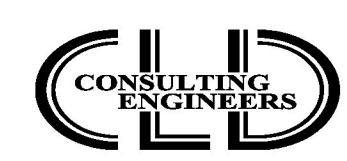

PROJECT NAME: STOWE	PLOT DATE: 5/8/2015
PROJECT NUMBER: BRF 0235(15)	DRAWN BY: S. FORTIER
FILE NAME: z88c190bdrerofl.dgn	CHECKED BY: K. RUTTER
PROJECT LEADER: J. BYATT	SHEET 76 OF 79
DESIGNED BY: S. FORTIER	
EPSC FINAL PLAN SHEET 2	