


Town of Stowe

Gables Bridge Water Main Relocation

Plan View

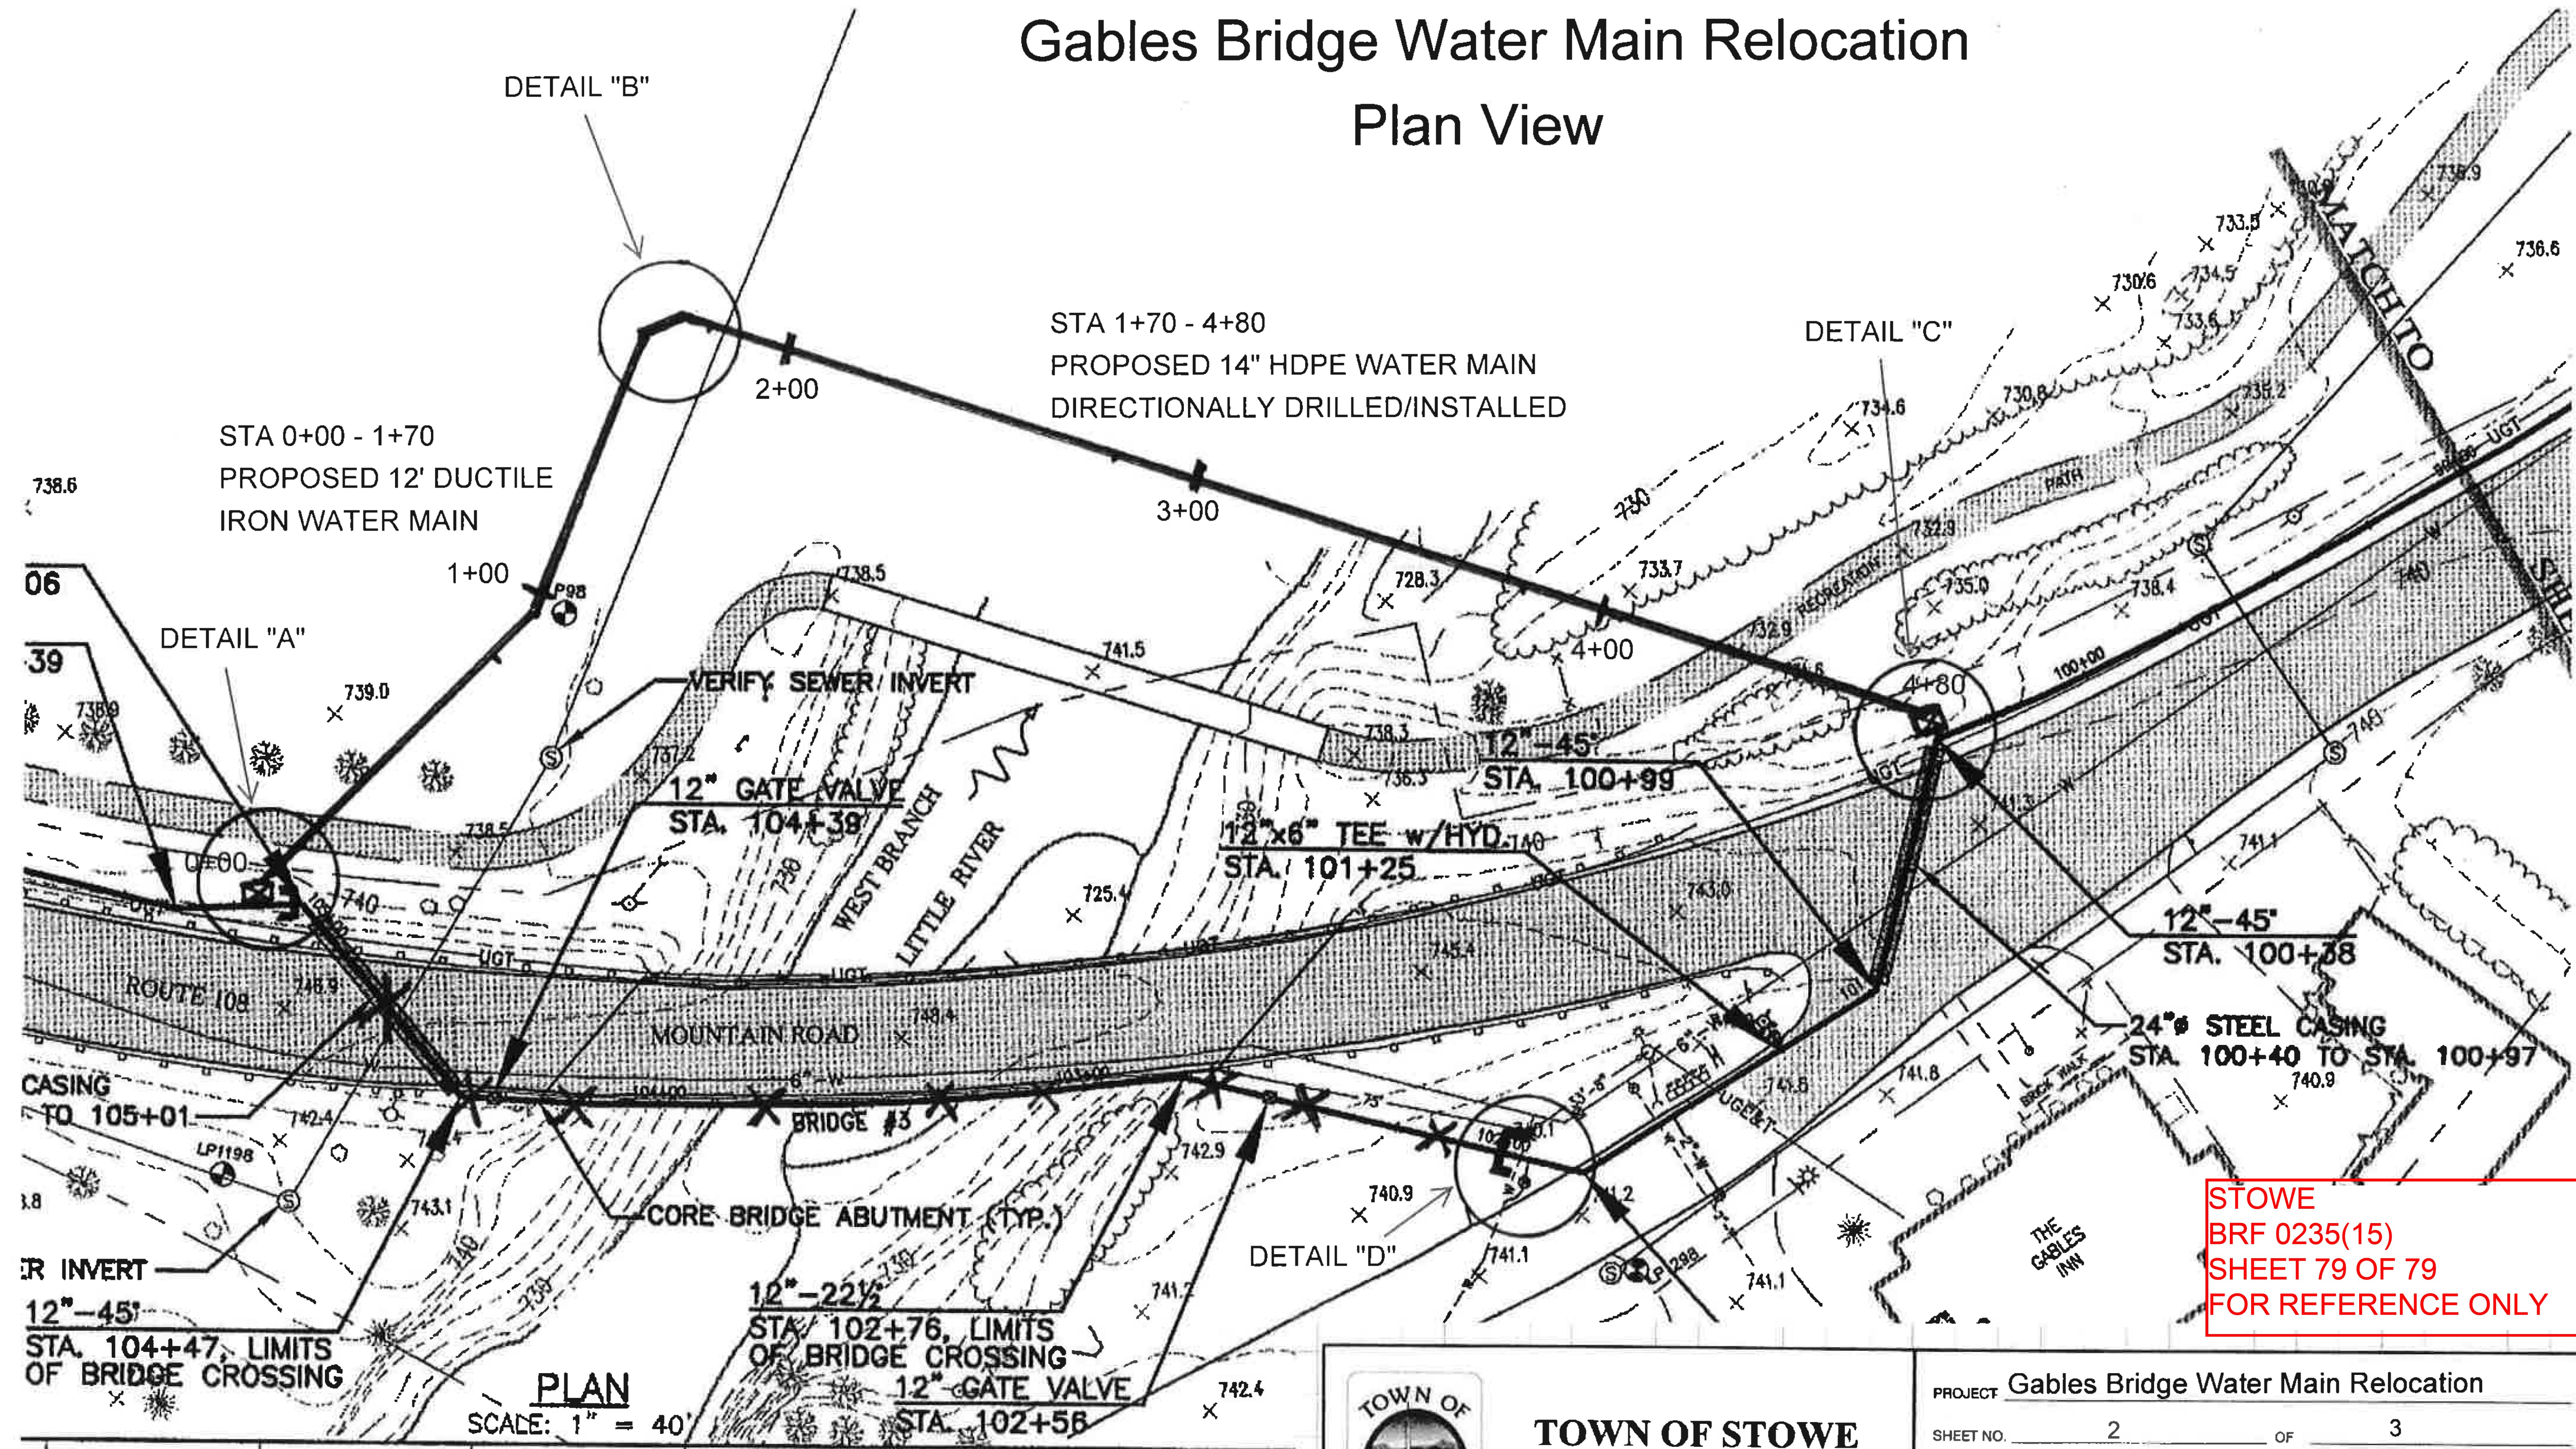

STOWE
BRF 0235(15)
SHEET 79 OF 79
FOR REFERENCE ONLY

PLAN
SCALE: 1" = 40'

TOWN OF STOWE
DEPARTMENT OF PUBLIC WORKS
PO BOX 730
67 MAIN STREET
STOWE, VT 05672

PROJECT	Gables Bridge Water Main Relocation		
SHEET NO.	2	OF	3
CALCULATED BY	RLG	DATE	12/06/2013
CHECKED BY		DATE	
SCALE	1" = 40'		PROJECT NO. 12013.01