

MATERIAL ITEM	TOTAL DEPTH	THICKNESS TOLERANCE
PAVEMENT	9 1/4"	± 1/4"
SUBBASE	21"	± 1"
SAND	6"	± 1"

TYPICAL SECTIONS

- 1 3/4" COLD PLANING (REFER TO DETAIL ON SHEET 5)
 - 1 3/4" BITUMINOUS CONCRETE PAVEMENT, TYPE III (INCLUDING COLD PLANED AREAS)
 - 2 1/2" BITUMINOUS CONCRETE PAVEMENT, TYPE II
 - 5" BITUMINOUS CONCRETE PAVEMENT, TYPE I (TO BE APPLIED IN TWO LIFTS OF 2 1/2")
 - 21" SUBBASE OF DENSE GRADED CRUSHED STONE
 - 6" SAND BORROW (STA. 0+00 - STA. 26+50)
- SHOULDERS: FULL DEPTH OF SUBBASE AND PAVEMENT

% WT.	LBS./A.	NAME	PUR %	GERM %
37.5	22.5	CREeping RED FESCUE	98	85
37.5	22.5	TALL FESCUE	95	90
5.0	3.0	RED TOP	95	90
15.0	9.0	BIRDFOOT TREFOIL	98	85
5.0	3.0	ANNUAL RYEGRASS	95	85
100.0	60.0			

GENERAL NOTES

SEED MIXTURE SHALL NOT HAVE A WEED CONTENT EXCEEDING 0.40% BY WEIGHT AND SHALL BE FREE OF ALL NOXIOUS SEED.

SEEDS TO BE APPLIED PER SEEDING FORMULAS OR AS DIRECTED BY THE ENGINEER.

FERTILIZER: FORMULA 10-20-10, TO BE USED WITH SEED, APPLIED AT THE RATE OF 500 LBS./ACRE. (HYDRO SEEDERS MAY USE 19-19-19 FORMULA).

AGRICULTURAL LIMESTONE TO BE APPLIED AT THE RATE OF 2 TONS/ACRE, OR AS DIRECTED BY THE ENGINEER.

HAY MULCH TO BE PLACED ON EARTH SLOPES AT THE RATE OF 2 TONS/ACRE, OR AS DIRECTED BY THE ENGINEER.










TOPSOIL TO BE USED WITH SEED AS INDICATED ON THE PLANS, OR AS DIRECTED BY THE ENGINEER.

MARKER POSTS TO BE PLACED AS INDICATED OR AS DIRECTED BY THE ENGINEER.

SLOPE ROUNDING: ALL CUT SLOPES TO BE ROUNDED IN ACCORDANCE WITH STANDARD SHEET B-5.

PAY LIMITS OF SAND BORROW: WHEN USED IN CONJUNCTION WITH UNDERDRAIN - SEE STANDARD SHEET D - 2.

TACK COAT: EMULSIFIED ASPHALT IS TO BE APPLIED AT THE RATE OF 0.015 GAL/SY BETWEEN SUCCESSIVE COURSES OF PAVEMENT AS DIRECTED BY THE ENGINEER.

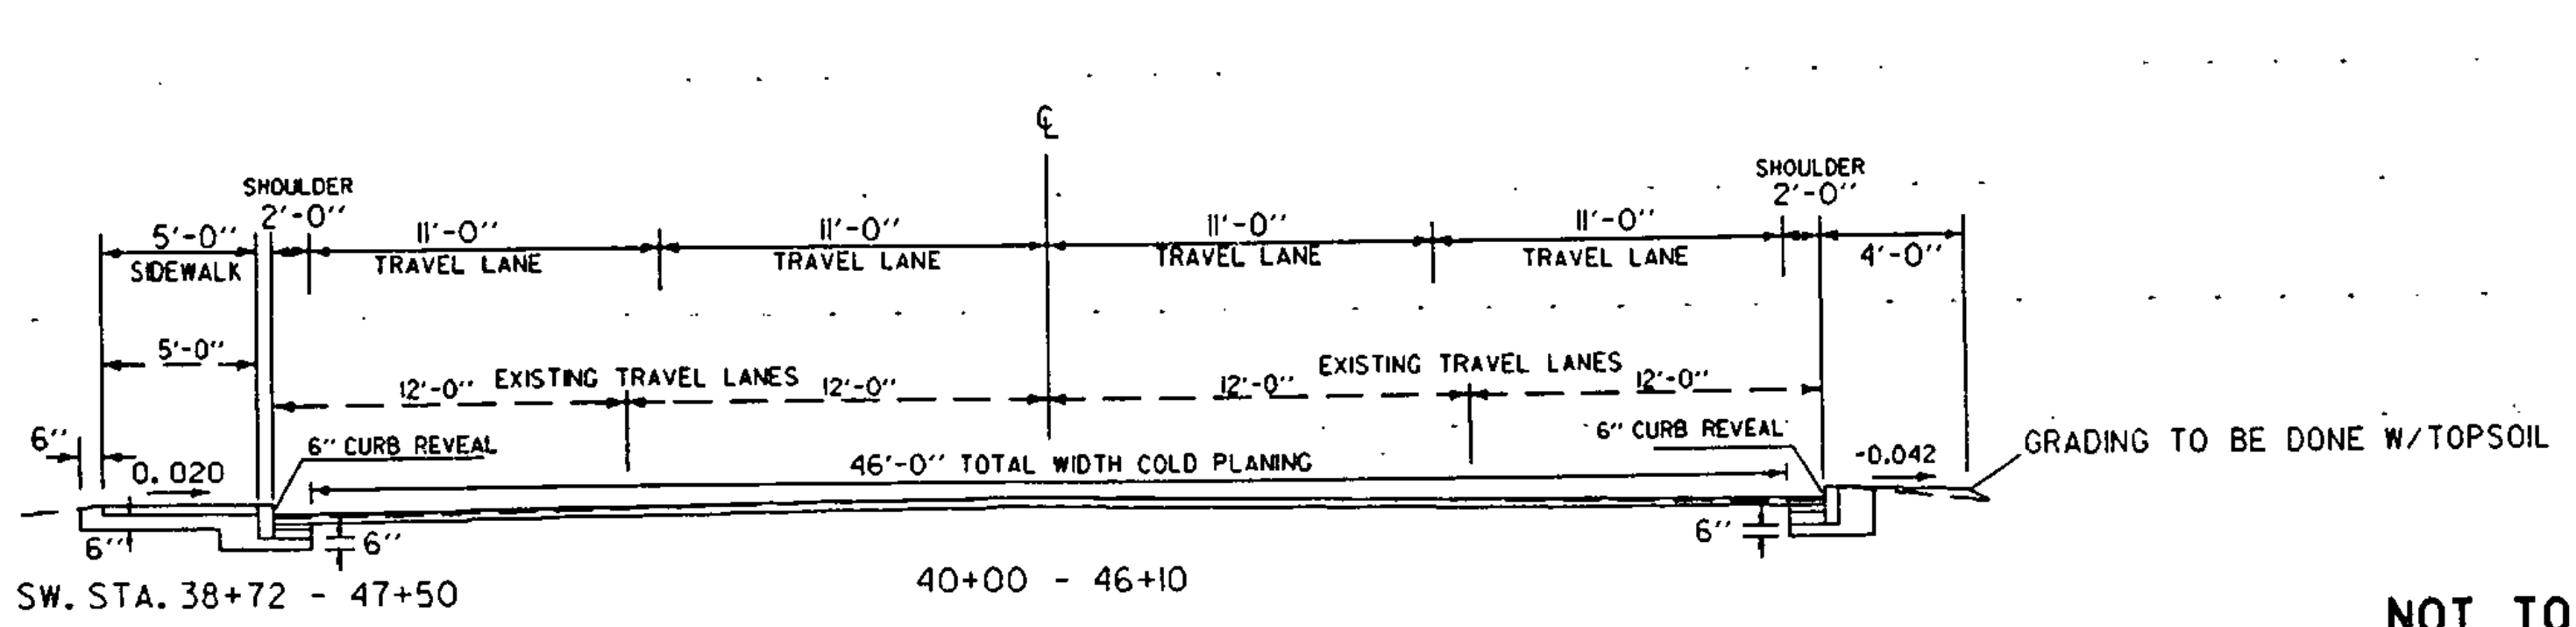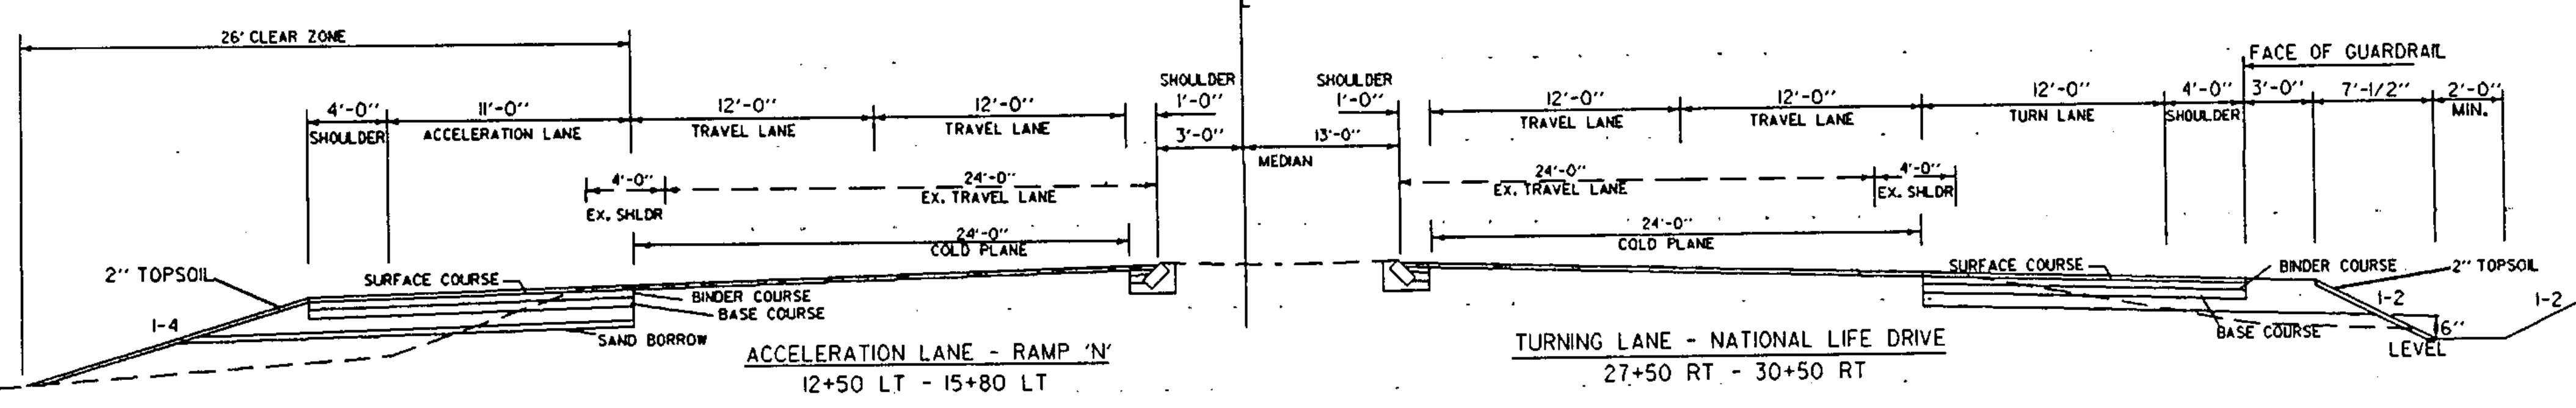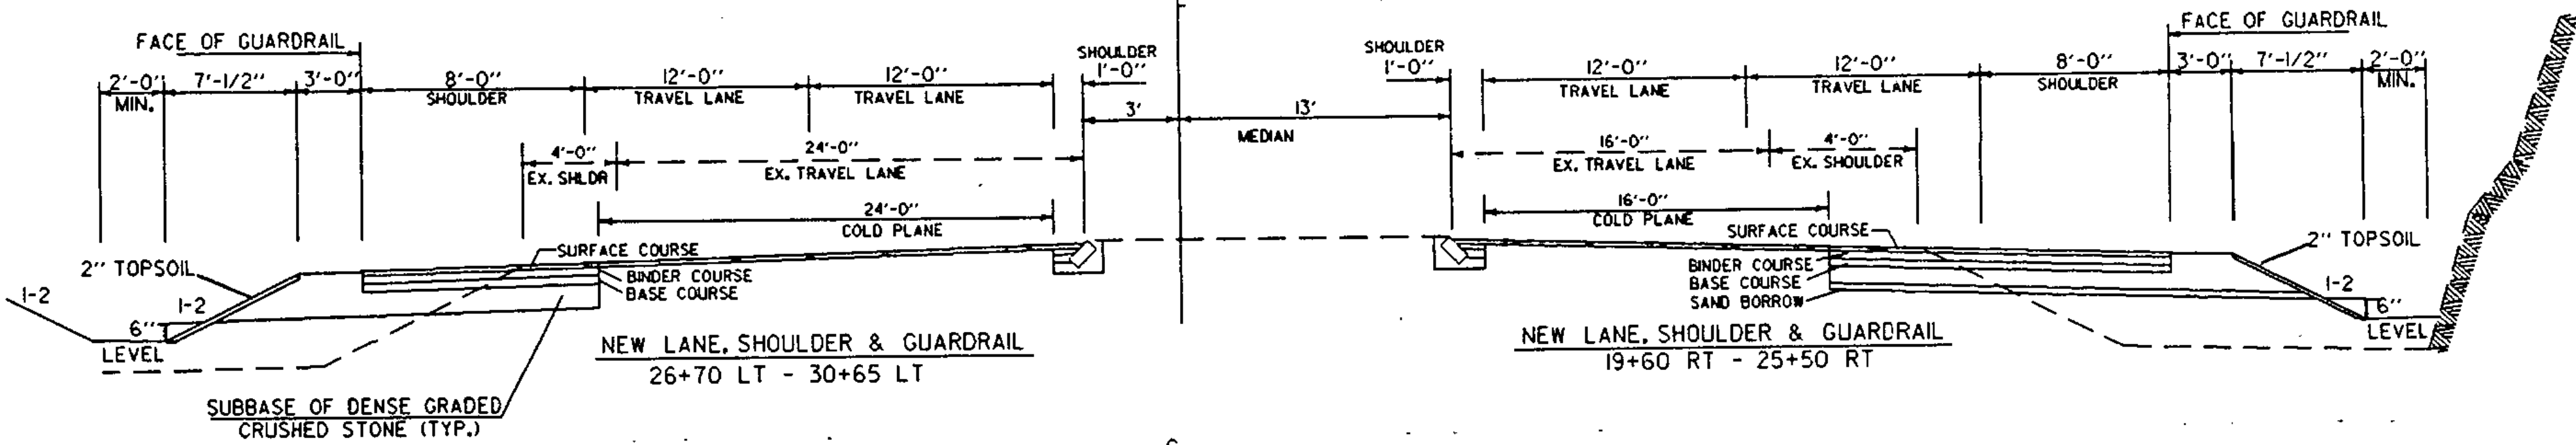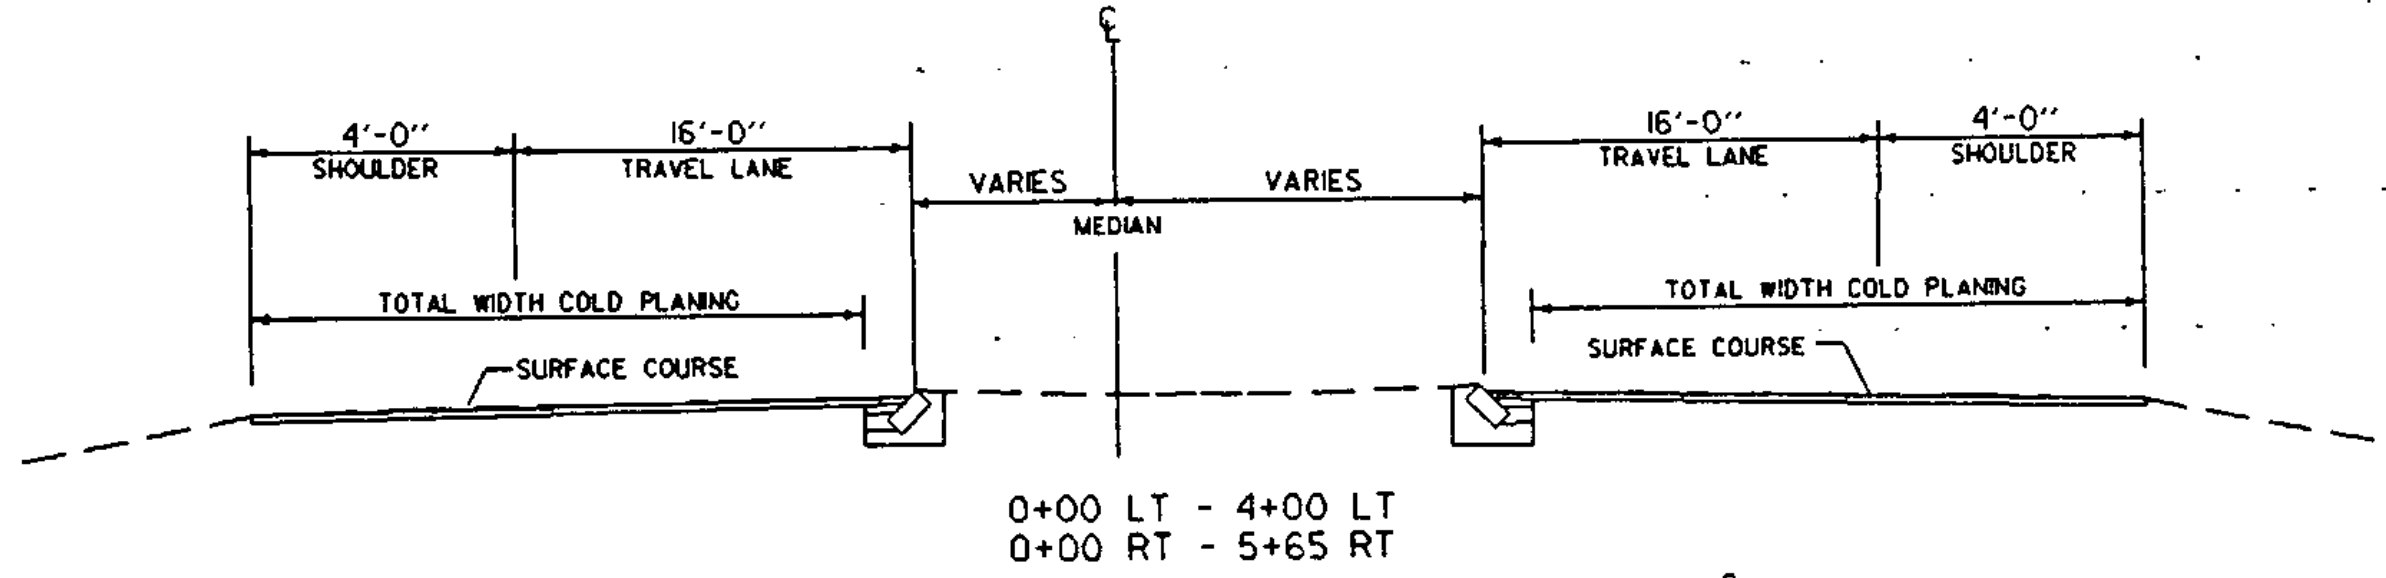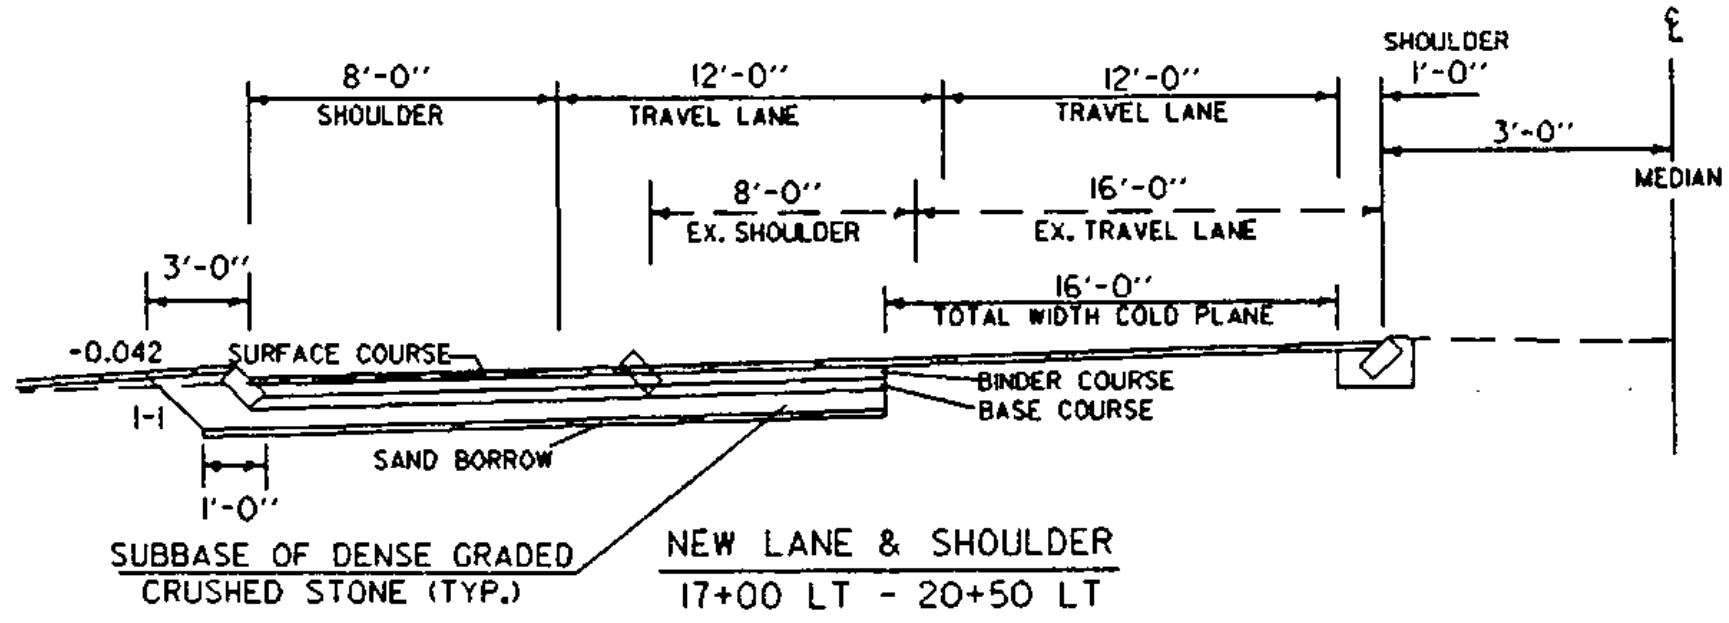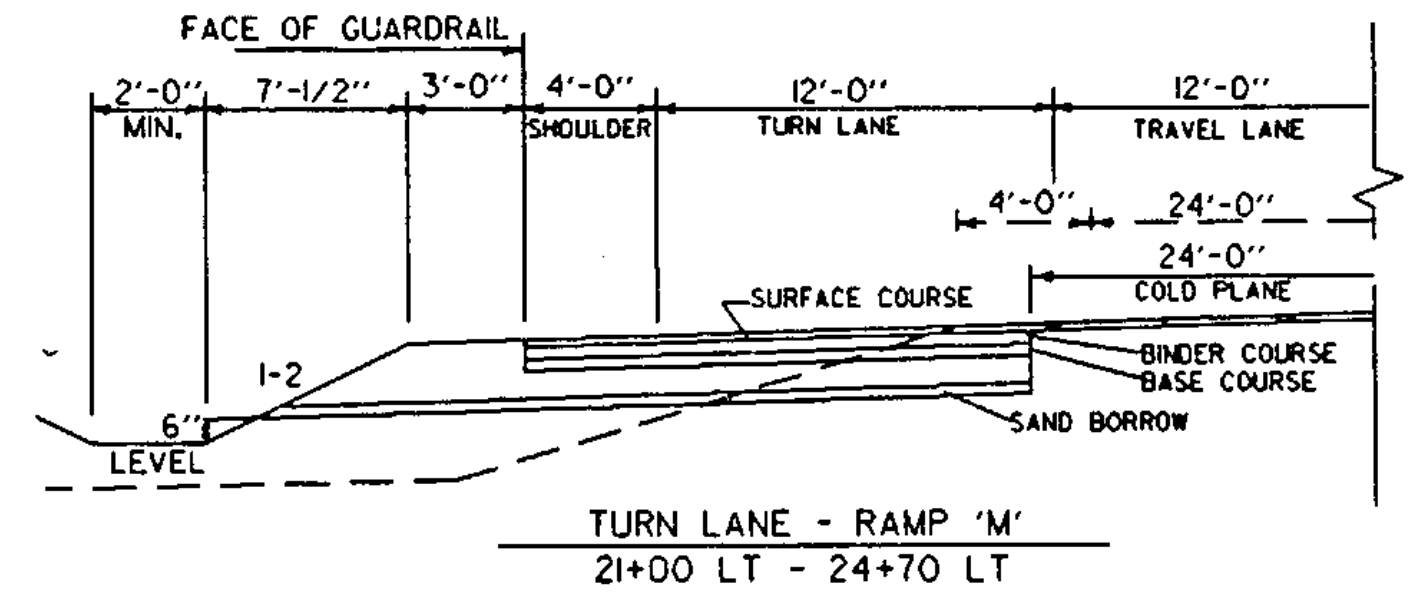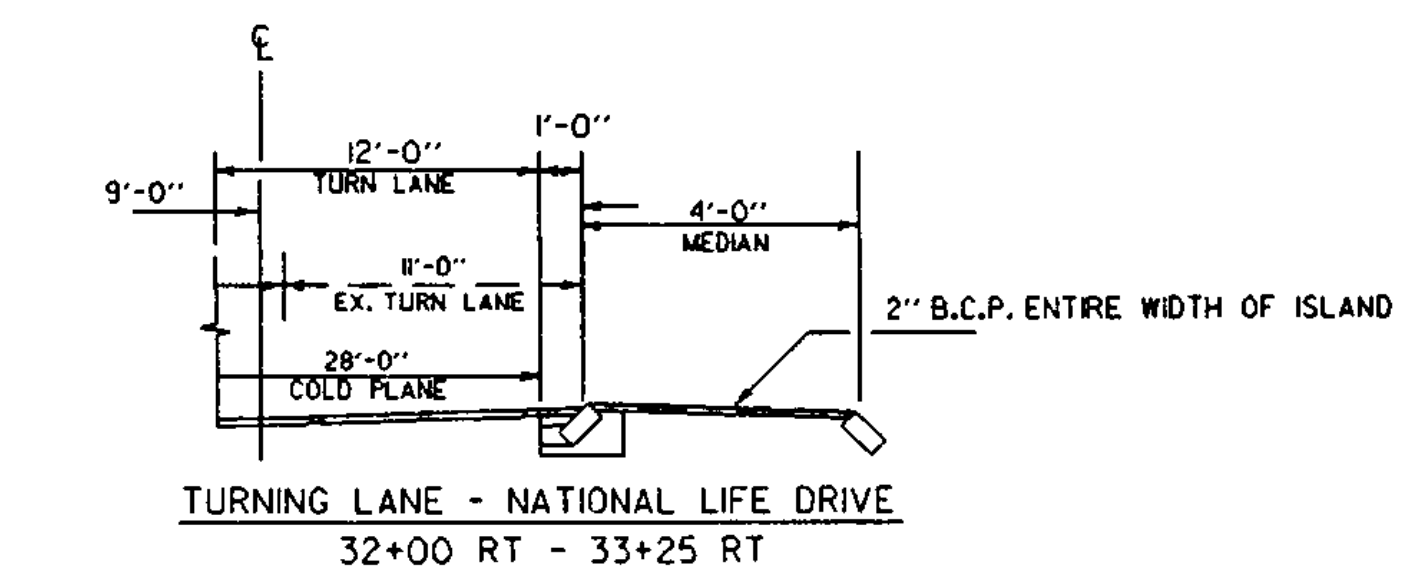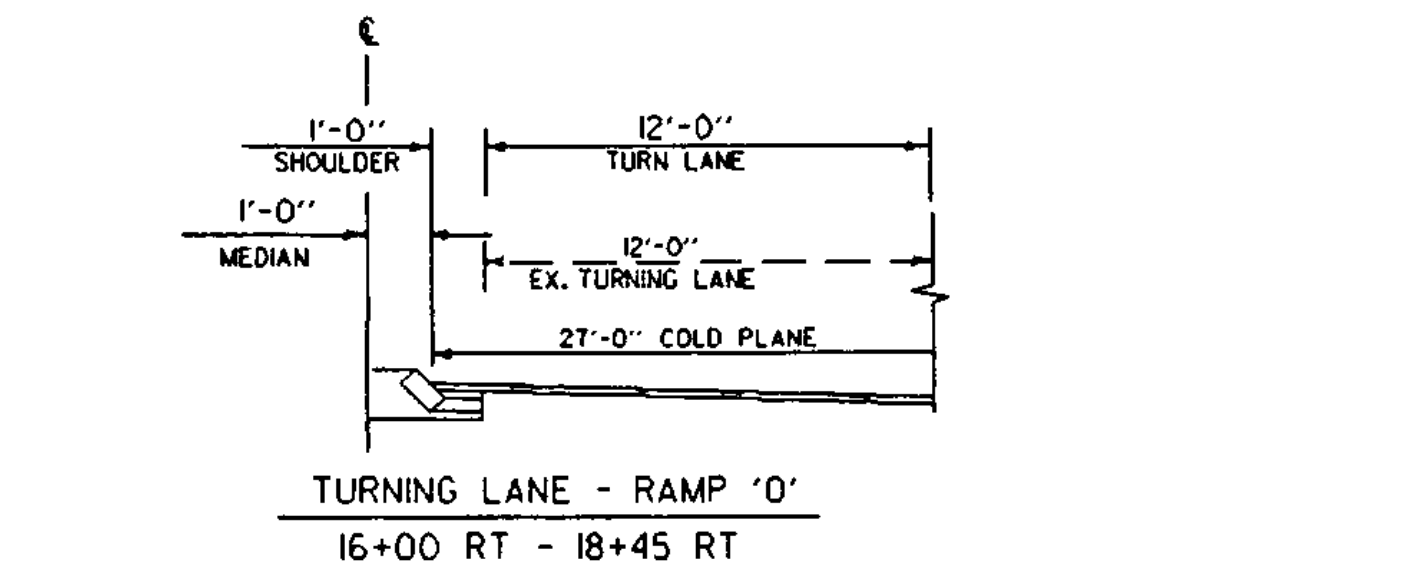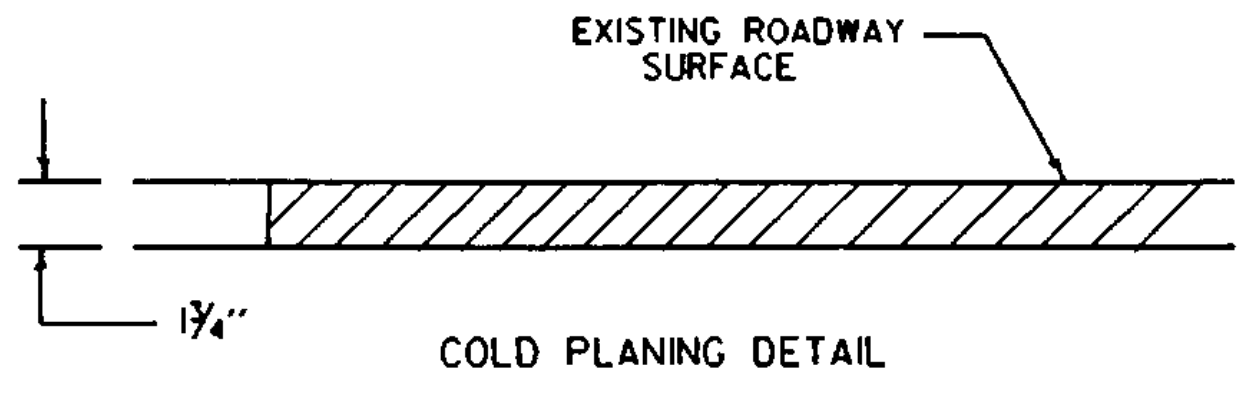

NOT TO SCALE

REVISED BY	KML	DATE	6-95
DRAWN BY	J.A.G.	DATE	12/90
SQUAD LEADER	NYQUIST		
DESIGN FILE NO.	/S001/83909/0808TYP.DGN		
PARM	db08tyl1	DATE PLOTTED	7-MAR-1996
PROJ. NAME	MONTPELIER		
PROJ. NO.	FEGC-F 028-2(8)		
SHEET	3	OF	118 SHEETS

Sheet Number: 3