


DRAINAGE NOTES

- 15 7+00 RT CAP EXIST. DI
- 16 8+00 LT REMOVE EXIST. DI, HEADWALL AND PIPE
- 17 6+75 - 9+75 LT NEW 24" X 300' CPEP W/CONC. HEADWALL AT INLET AND OUTLET
- 18 10+00 LT NEW 18" X 8' RCP CL III, W/CONC. HEADWALL AND RCDI
- 18A 9+75 - 11+00 LT CONSTRUCT SPECIAL DITCH W/STONE FILL TYPE I
- 19 8+00 - 10+00 RT NEW 18" X 200' RCP CL III, W/RCDI AT INLET
- 19A 10+00 - 12+00 RT NEW 18" X 200' RCP CL III, W/RCDI AT INLET

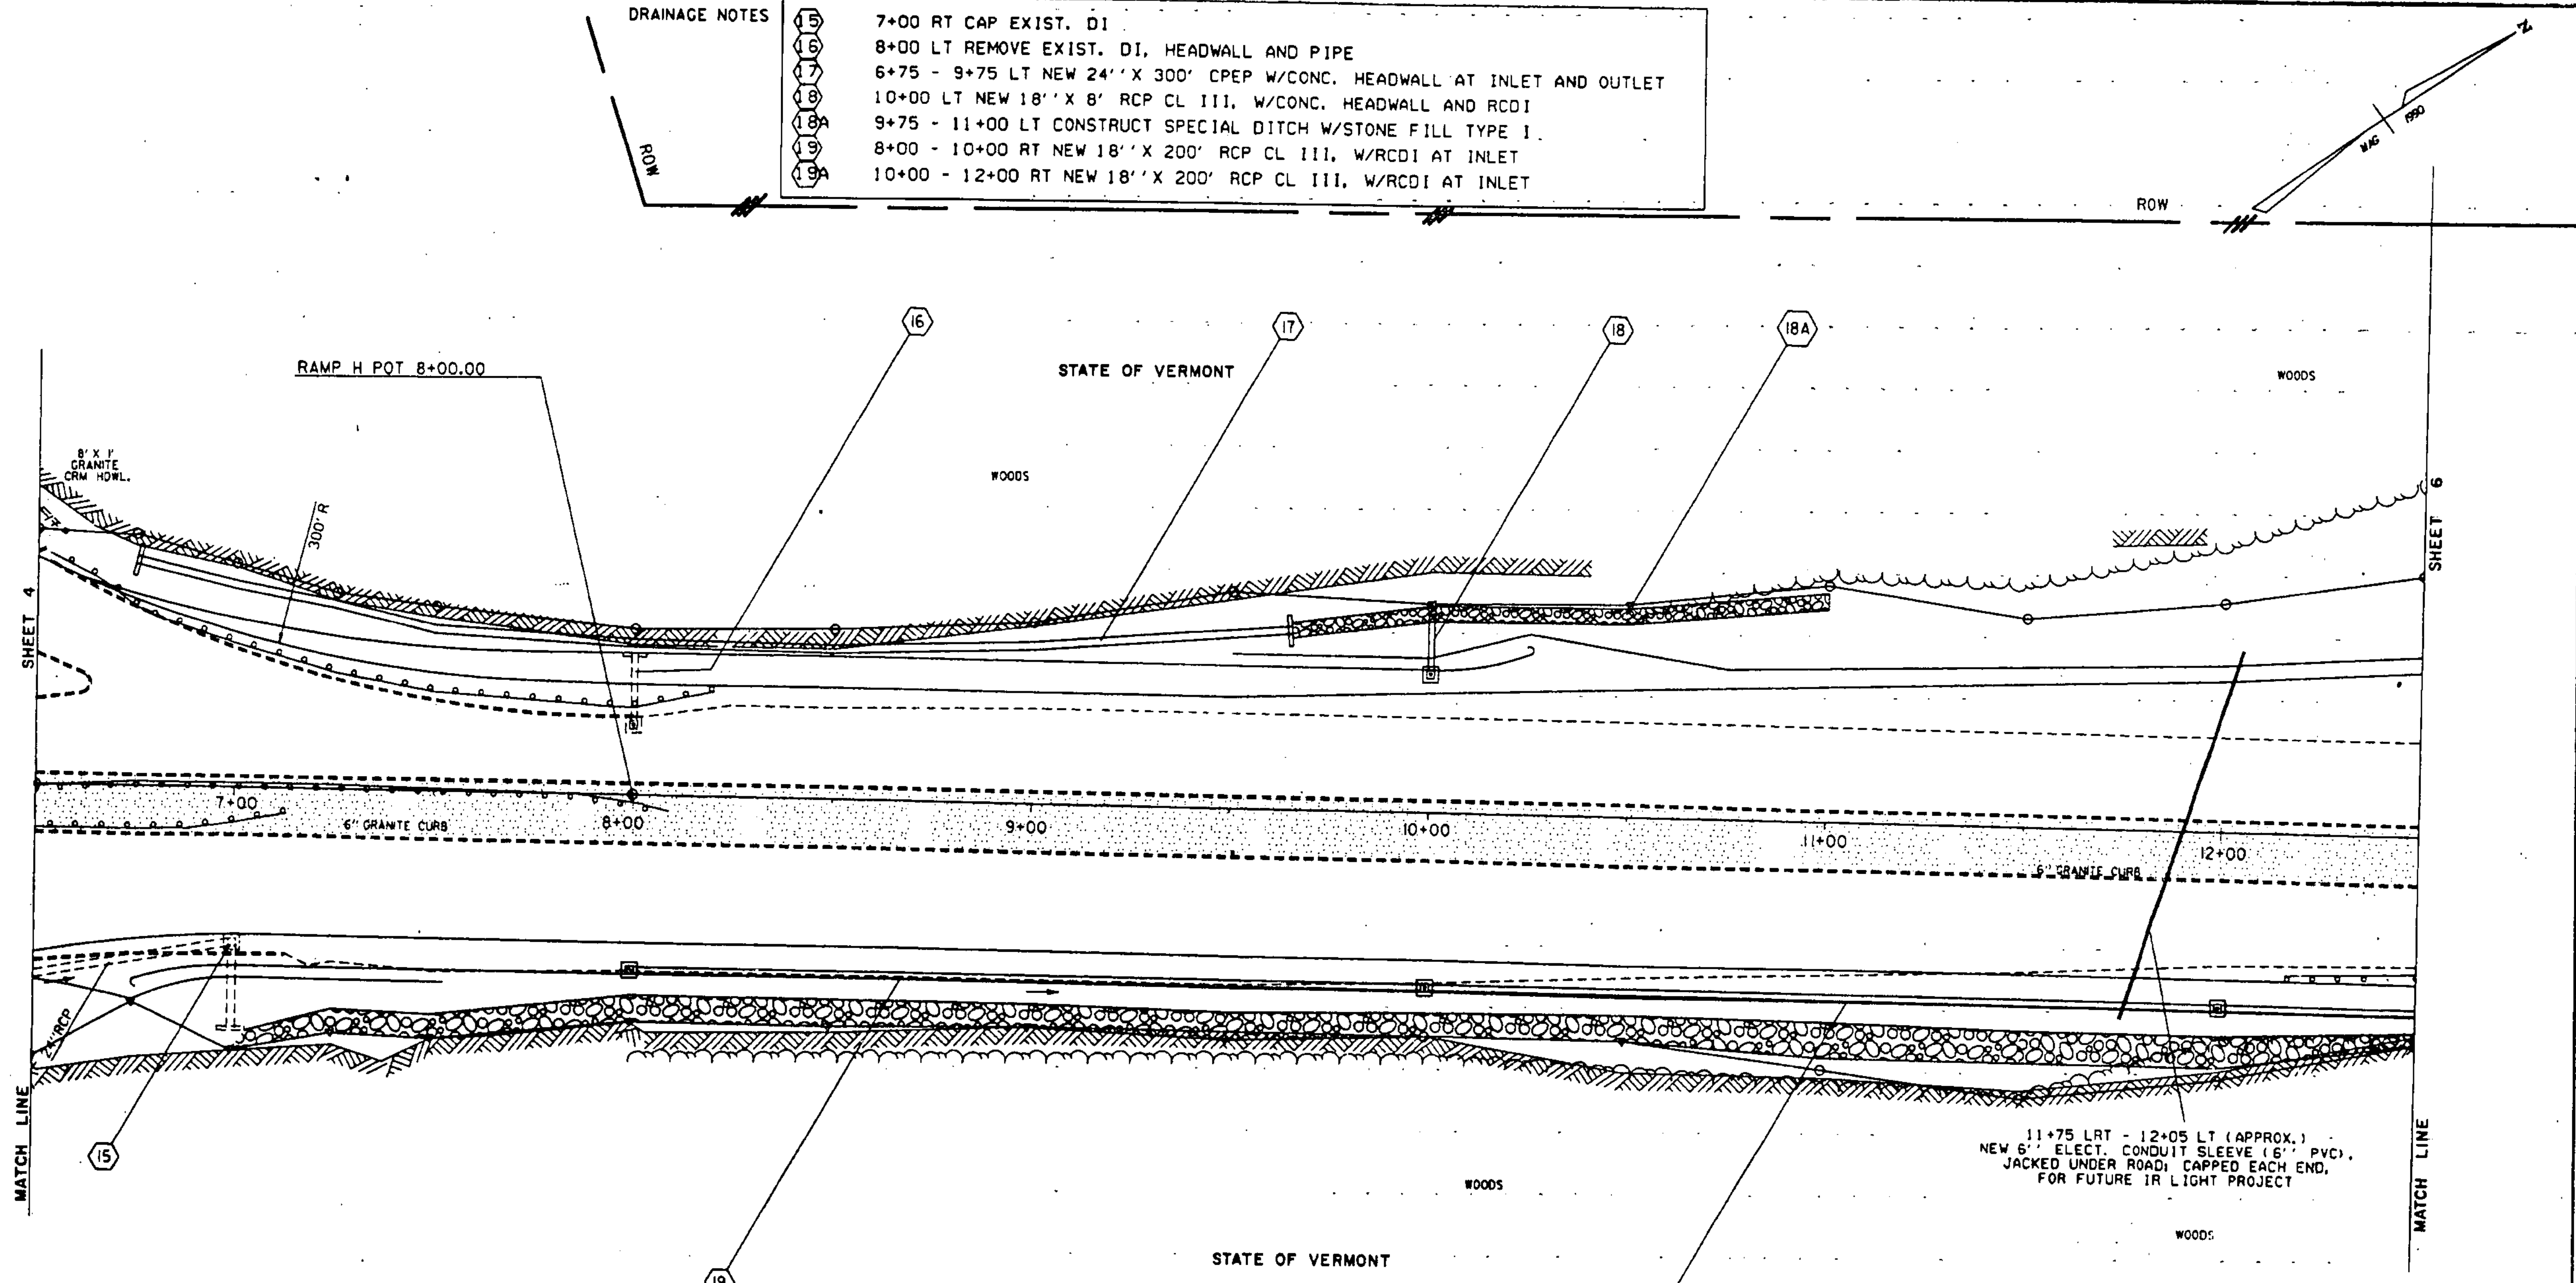

DATUM
 VERTICAL NGVD 1929
 HORIZONTAL N/A

CONSTRUCT SPECIAL DITCH W/STONE FILL TYPE I
 7+50 RT - 17+00 RT
 9+65 LT - 11+00 LT

COLD PLANING-BIT. PAVEMENT
 0+00 - 47+50

REMOVE EXISTING CURB
 6+25 RT - 7+10 RT
 6+05 RT - RAMP 'B' 6+20 RT
 RAMP 'B' 6+50 LT - ML 8+00 LT

STEEL BEAM GUARDRAIL
 6+00 LT (RAMP 'B') - 10+25 LT
 7+00 RT - 30+75 RT

BREAKAWAY CABLE TERMINAL (BCT)
 6+75 RT - 7+00 RT
 10+00 LT - 10+25 LT

REMOVE EXISTING GUARDRAIL
 6+50 LT (RAMP 'B') - 8+20 LT
 12+15 RT - 26+00 RT

TREATED TIMBER CURB
 7+00 RT - 19+50 RT

THIS SHEET
 FOR R.O.V.
 USE ONLY



SURVEYED BY Fall DATE 5-90
 DRAWN BY Squade-jfg DATE 6-90
 SQUAD LEADER D.F.Hale
 FILE /usr/zta2/055050.dir/89b018
 PARM FILE 89B018L2.1 DATE PLOTTED 30-DEC-1992
 PROJ. NAME MONTPELIER
 PRJ. NO. FECC-F 028-2(B)S
 SHEET 5 OF 15 SHEETS