


COLD PLANING-BIT. PAVEMENT
0+00 - 47+50

CAST-IN-PLACE CONCRETE CURB, TYPE B
38+57 LT - 47+50 LT

PORTLAND CEMENT CONCRETE SIDEWALK, 5 INCH
38+73 LT - 47+50 LT

SIDEWALK RAMP TYPE I
47+50 LT

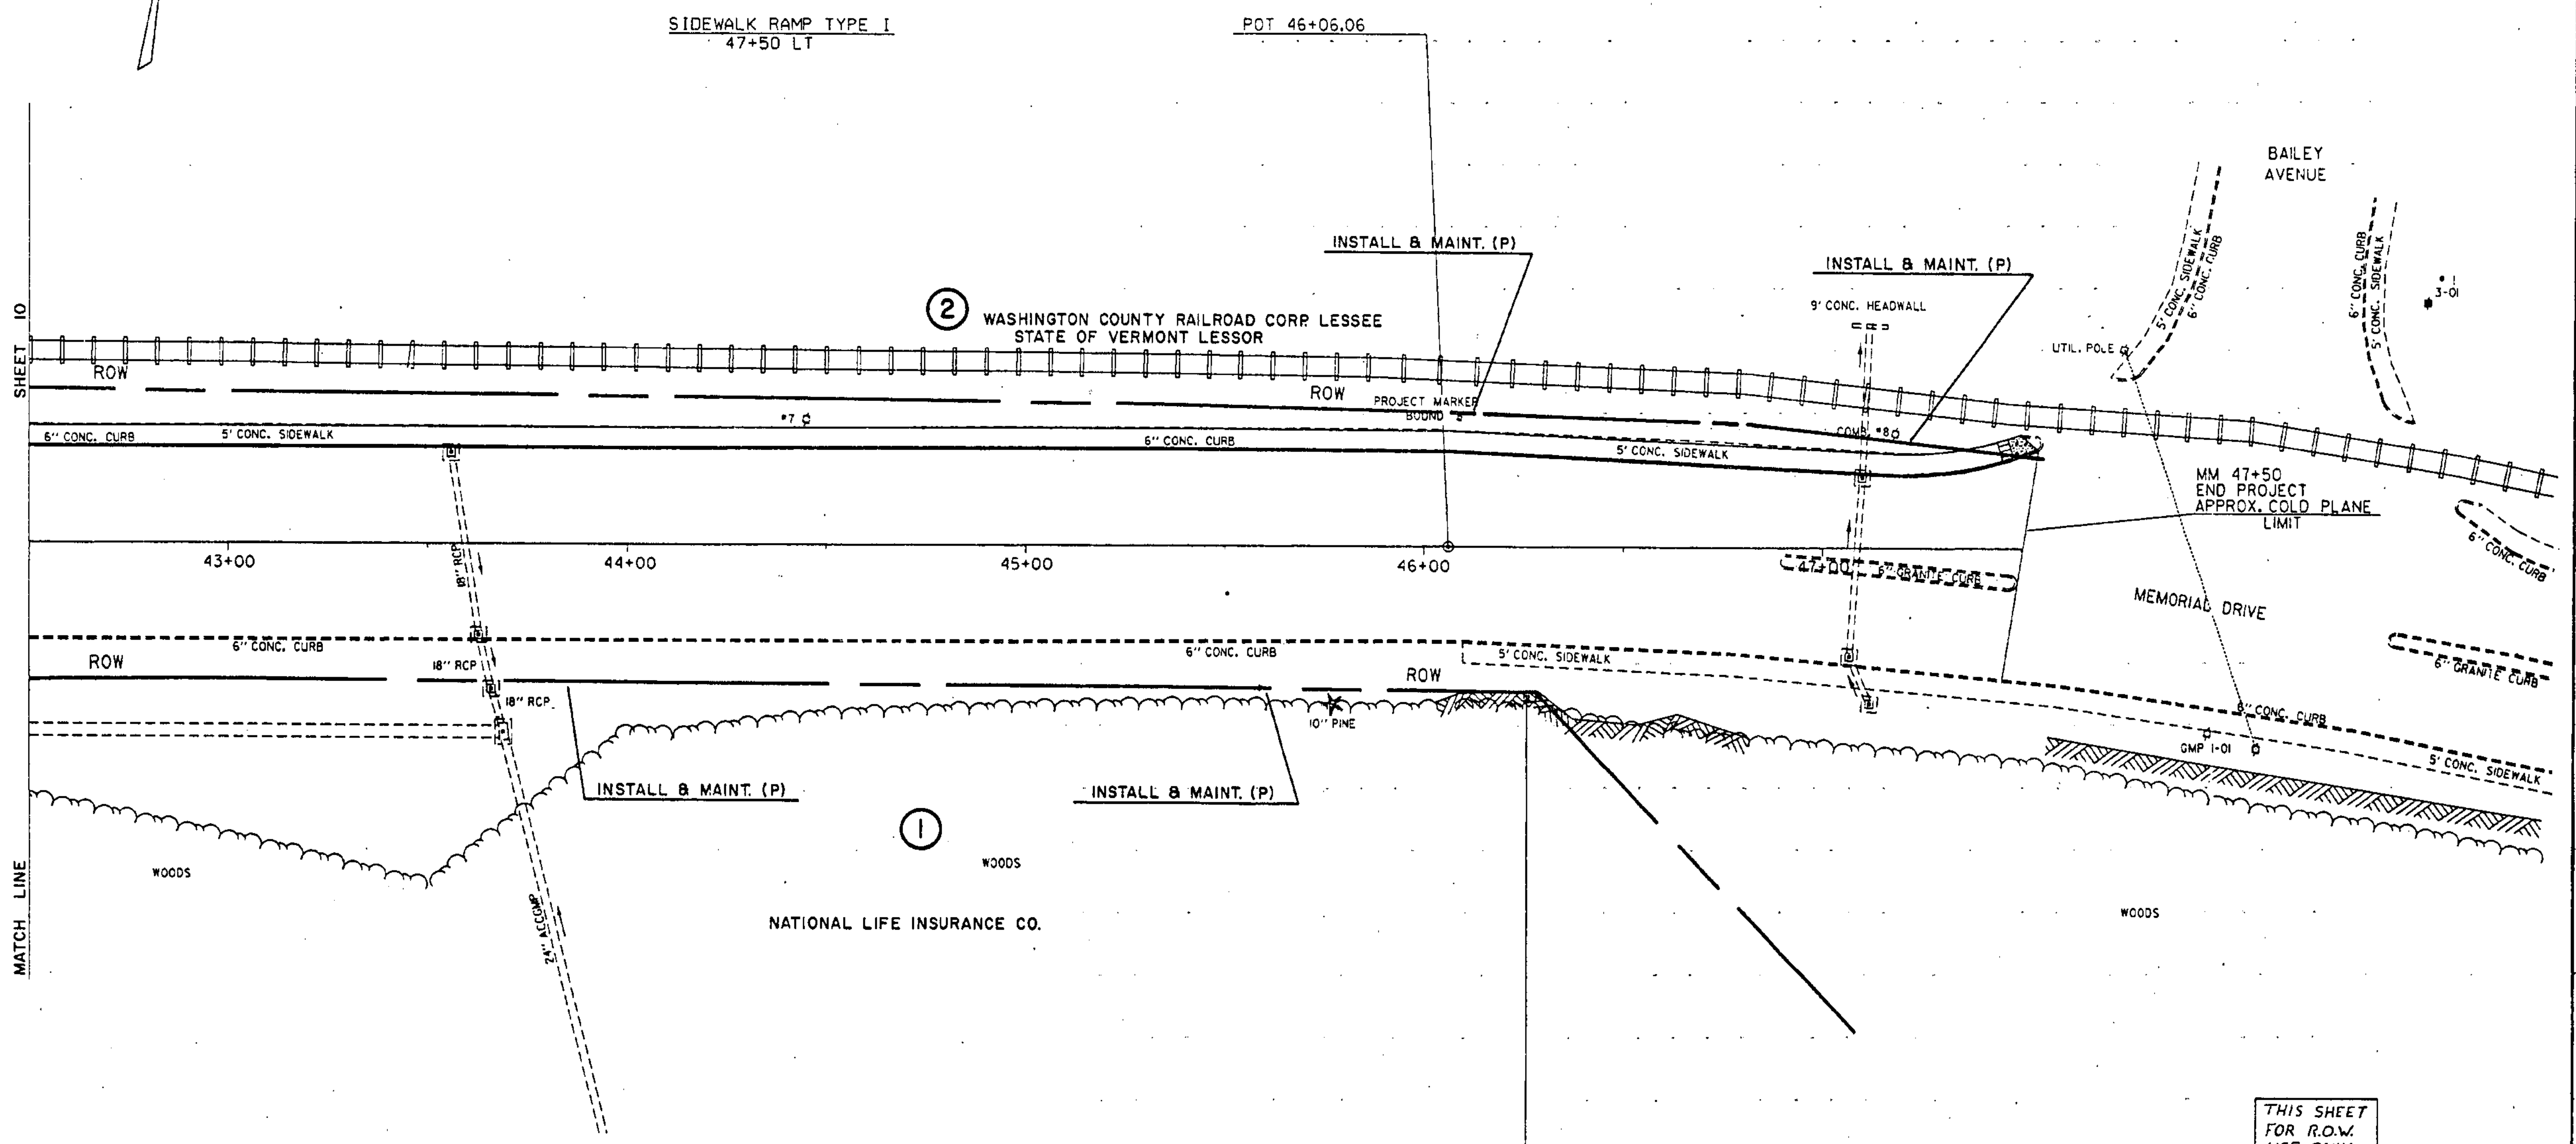

DATUM
VERTICAL NGVD 1929
HORIZONTAL N/A



BM #6
CH. SO. IN LE.
US ELEV. 530.58

THIS SHEET
FOR R.O.W.
USE ONLY

SURVEYED BY Fall DATE 5-90
DRAWN BY Squade-jfg DATE 6-90
SQUAD LEADER D.F.Hale
FILE usr/z/a2/055050.dir/89b018
IPARM 89B018L1 DATE 30-DEC-1992
FILE
PROJ. NAME MONTPELIER
PROJ. NO. FECC-F 028-2(8)S
SHEET 11 OF 15 SHEETS

PLAN SHEET 21 OF 118

MAR 13 1995