

DATUM
 VERTICAL NGVD 1929
 HORIZONTAL N/A

PORTLAND CEMENT CONCRETE SIDEWALK, 5 INCH
 42+50 LT - 47+54 LT
 47+50 RT - 47+64 RT

NOTE: REMOVAL OF EXISTING SIDEWALK AND CURB TO BE PAID AS COMMON EXCAVATION


SIDEWALK RAMP TYPE I
 47+53 RT
 47+51 LT

COLD PLANING-BIT, PAVEMENT
 42+50 - 46+10 LT & RT

VERTICAL GRANITE CURB
 42+50 - 47+50 RT
 42+50 - 47+48 LT
 47+56 - 47+64 RT

EROSION CONTROL
 HAY BALES @ DI FOR INLET PROTECTION

SURVEYED BY	Foil	DATE	5-90
DRAWN BY	KML/PJR	DATE	2-96
SQUAD LEADER	BTN		
FILE	/sdd/89b018/db08cb.dgn		
PARM	DB018L8.J	DATE	PLOTTED 5-FEB-1996
PROJ. NAME	MONTPELIER		
PROJ. NO.	FEGC-F 028-2(18)		
SHEET	33	OF	118 SHEETS

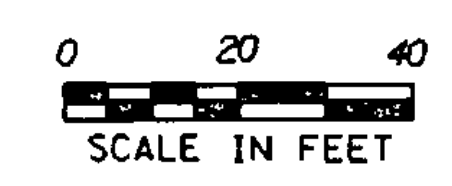

Sheet Number: 33