

# PAVEMENT MARKINGS

**TEMPORARY 4" WHITE LINE**  
 0+00 RT - 5+65 RT (EDGE)  
 5+30 RT (RAMP A) - 16+00 (ML)  
 7+25 RT - 16+00 RT (DASHED)  
 14+50 RT - 15+80 RT (DOTTED)  
 15+80 RT - 16+00 RT  
 0+00 LT - 6+35 LT (EDGE)  
 6+30 LT (RAMP B) - 16+00 LT (EDGE)  
 7+65 LT - 9+60 LT (TURN LANE)  
 9+60 LT - 16+00 LT (DASHED)  
 13+85 LT - 15+60 LT (DASHED)

**DURABLE 4" WHITE LINE**  
 0+00 RT - 5+65 RT (EDGE)  
 5+30 RT (RAMP A) - 16+00 (ML)  
 7+25 RT - 16+00 RT (DASHED)  
 14+50 RT - 15+80 RT (DOTTED)  
 15+80 RT - 16+00 RT  
 0+00 LT - 6+35 LT (EDGE)  
 6+30 LT (RAMP B) - 16+00 LT (EDGE)  
 7+65 LT - 9+60 LT (TURN LANE)  
 9+60 LT - 16+00 LT (DASHED)  
 13+85 LT - 15+60 LT (DASHED)

**PAINTED CURB**  
 14+20 RT - 16+00 RT

**TEMPORARY 4" YELLOW LINE**  
 0+00 RT - 16+00 RT  
 0+00 LT - 16+00 LT  
 5+30 RT - 5+65 RT  
 6+20 LT - 6+40 LT




**DURABLE 4" YELLOW LINE**  
 0+00 RT - 16+00 RT  
 0+00 LT - 16+00 LT  
 5+30 RT - 5+65 RT  
 6+20 LT - 6+40 LT

**TEMPORARY LETTER OR SYMBOL**  
 9+50 LT (RT ARROW, O,N,L,Y)  
 15+80 RT (LT ARROW, O,N,L,Y)

**DURABLE LETTER OR SYMBOL**  
 9+50 LT (RT ARROW, O,N,L,Y)  
 15+80 RT (O N L Y, LT ARROW)

**TEMPORARY 8" WHITE LINE**  
 5+65 RT - 6+75 RT (RAMP A GORE)  
 5+65 RT - 7+25 RT (RAMP A)  
 6+35 LT - 7+05 LT (RAMP B GORE)  
 6+40 LT - 7+65 LT (RAMP B)  
 6+40 LT - 7+05 LT (DIAG.) (RAMP B)  
 15+60 LT - 16+00 LT (RAMP N GORE)

**DURABLE 8" WHITE LINE**  
 5+65 RT - 6+75 RT (RAMP A GORE)  
 5+65 RT - 7+25 RT (RAMP A)  
 6+35 LT - 7+05 LT (RAMP B GORE)  
 6+40 LT - 7+65 LT (RAMP B)  
 6+40 LT - 7+05 LT (DIAG.) (RAMP B)  
 15+60 LT - 16+00 LT (RAMP N GORE)

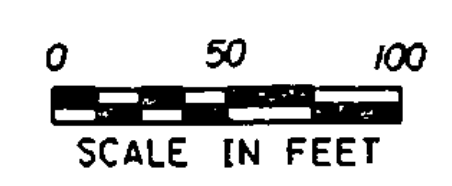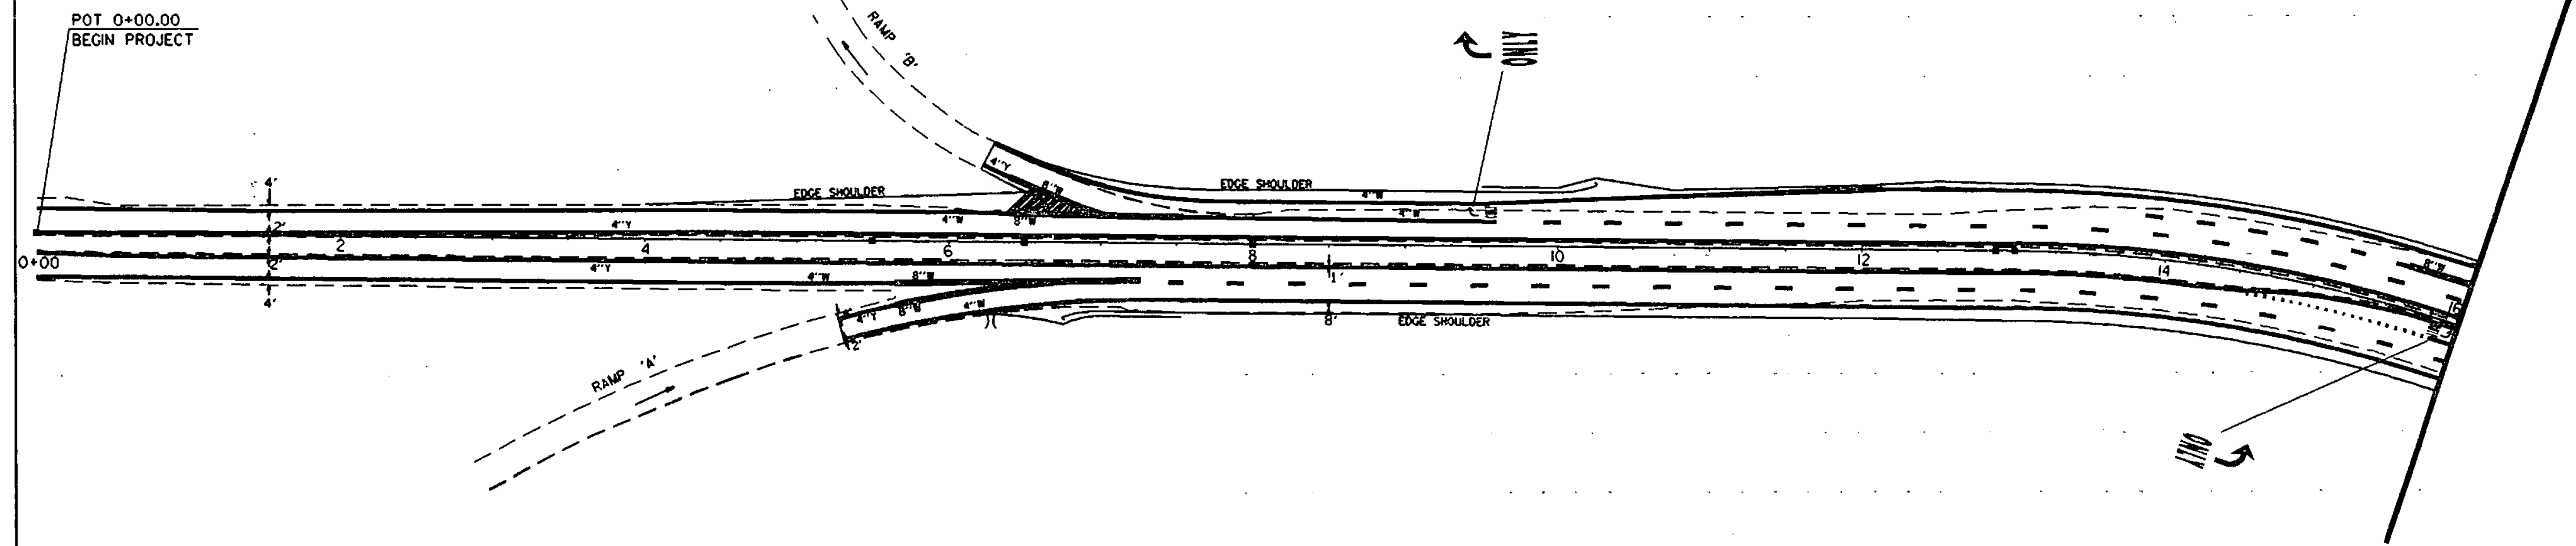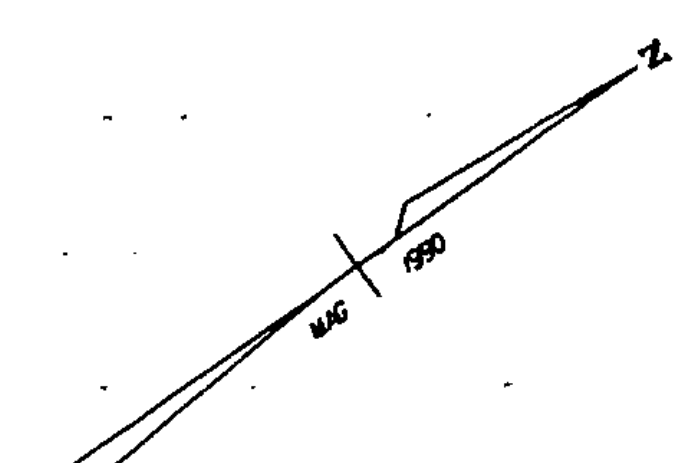

SURVEYED BY	MOREAU	DATE	9-92
DRAWN BY	SQUAD A	DATE	2-93
SQUAD LEADER	BTN		
DESIGN FILE NO.	/eqda/db08ctr.dgn		
PARM FILE	/eqda/db081mlj	DATE	15-FEB-1996
PROJ. NAME	MONTPELIER		
PROJ. NO.	F EGC-F 028-2(8)		
SHEET	44	OF	118 SHEETS