


NOTE:  
 STA. 0+50 BEGIN  
 CURB TAPER

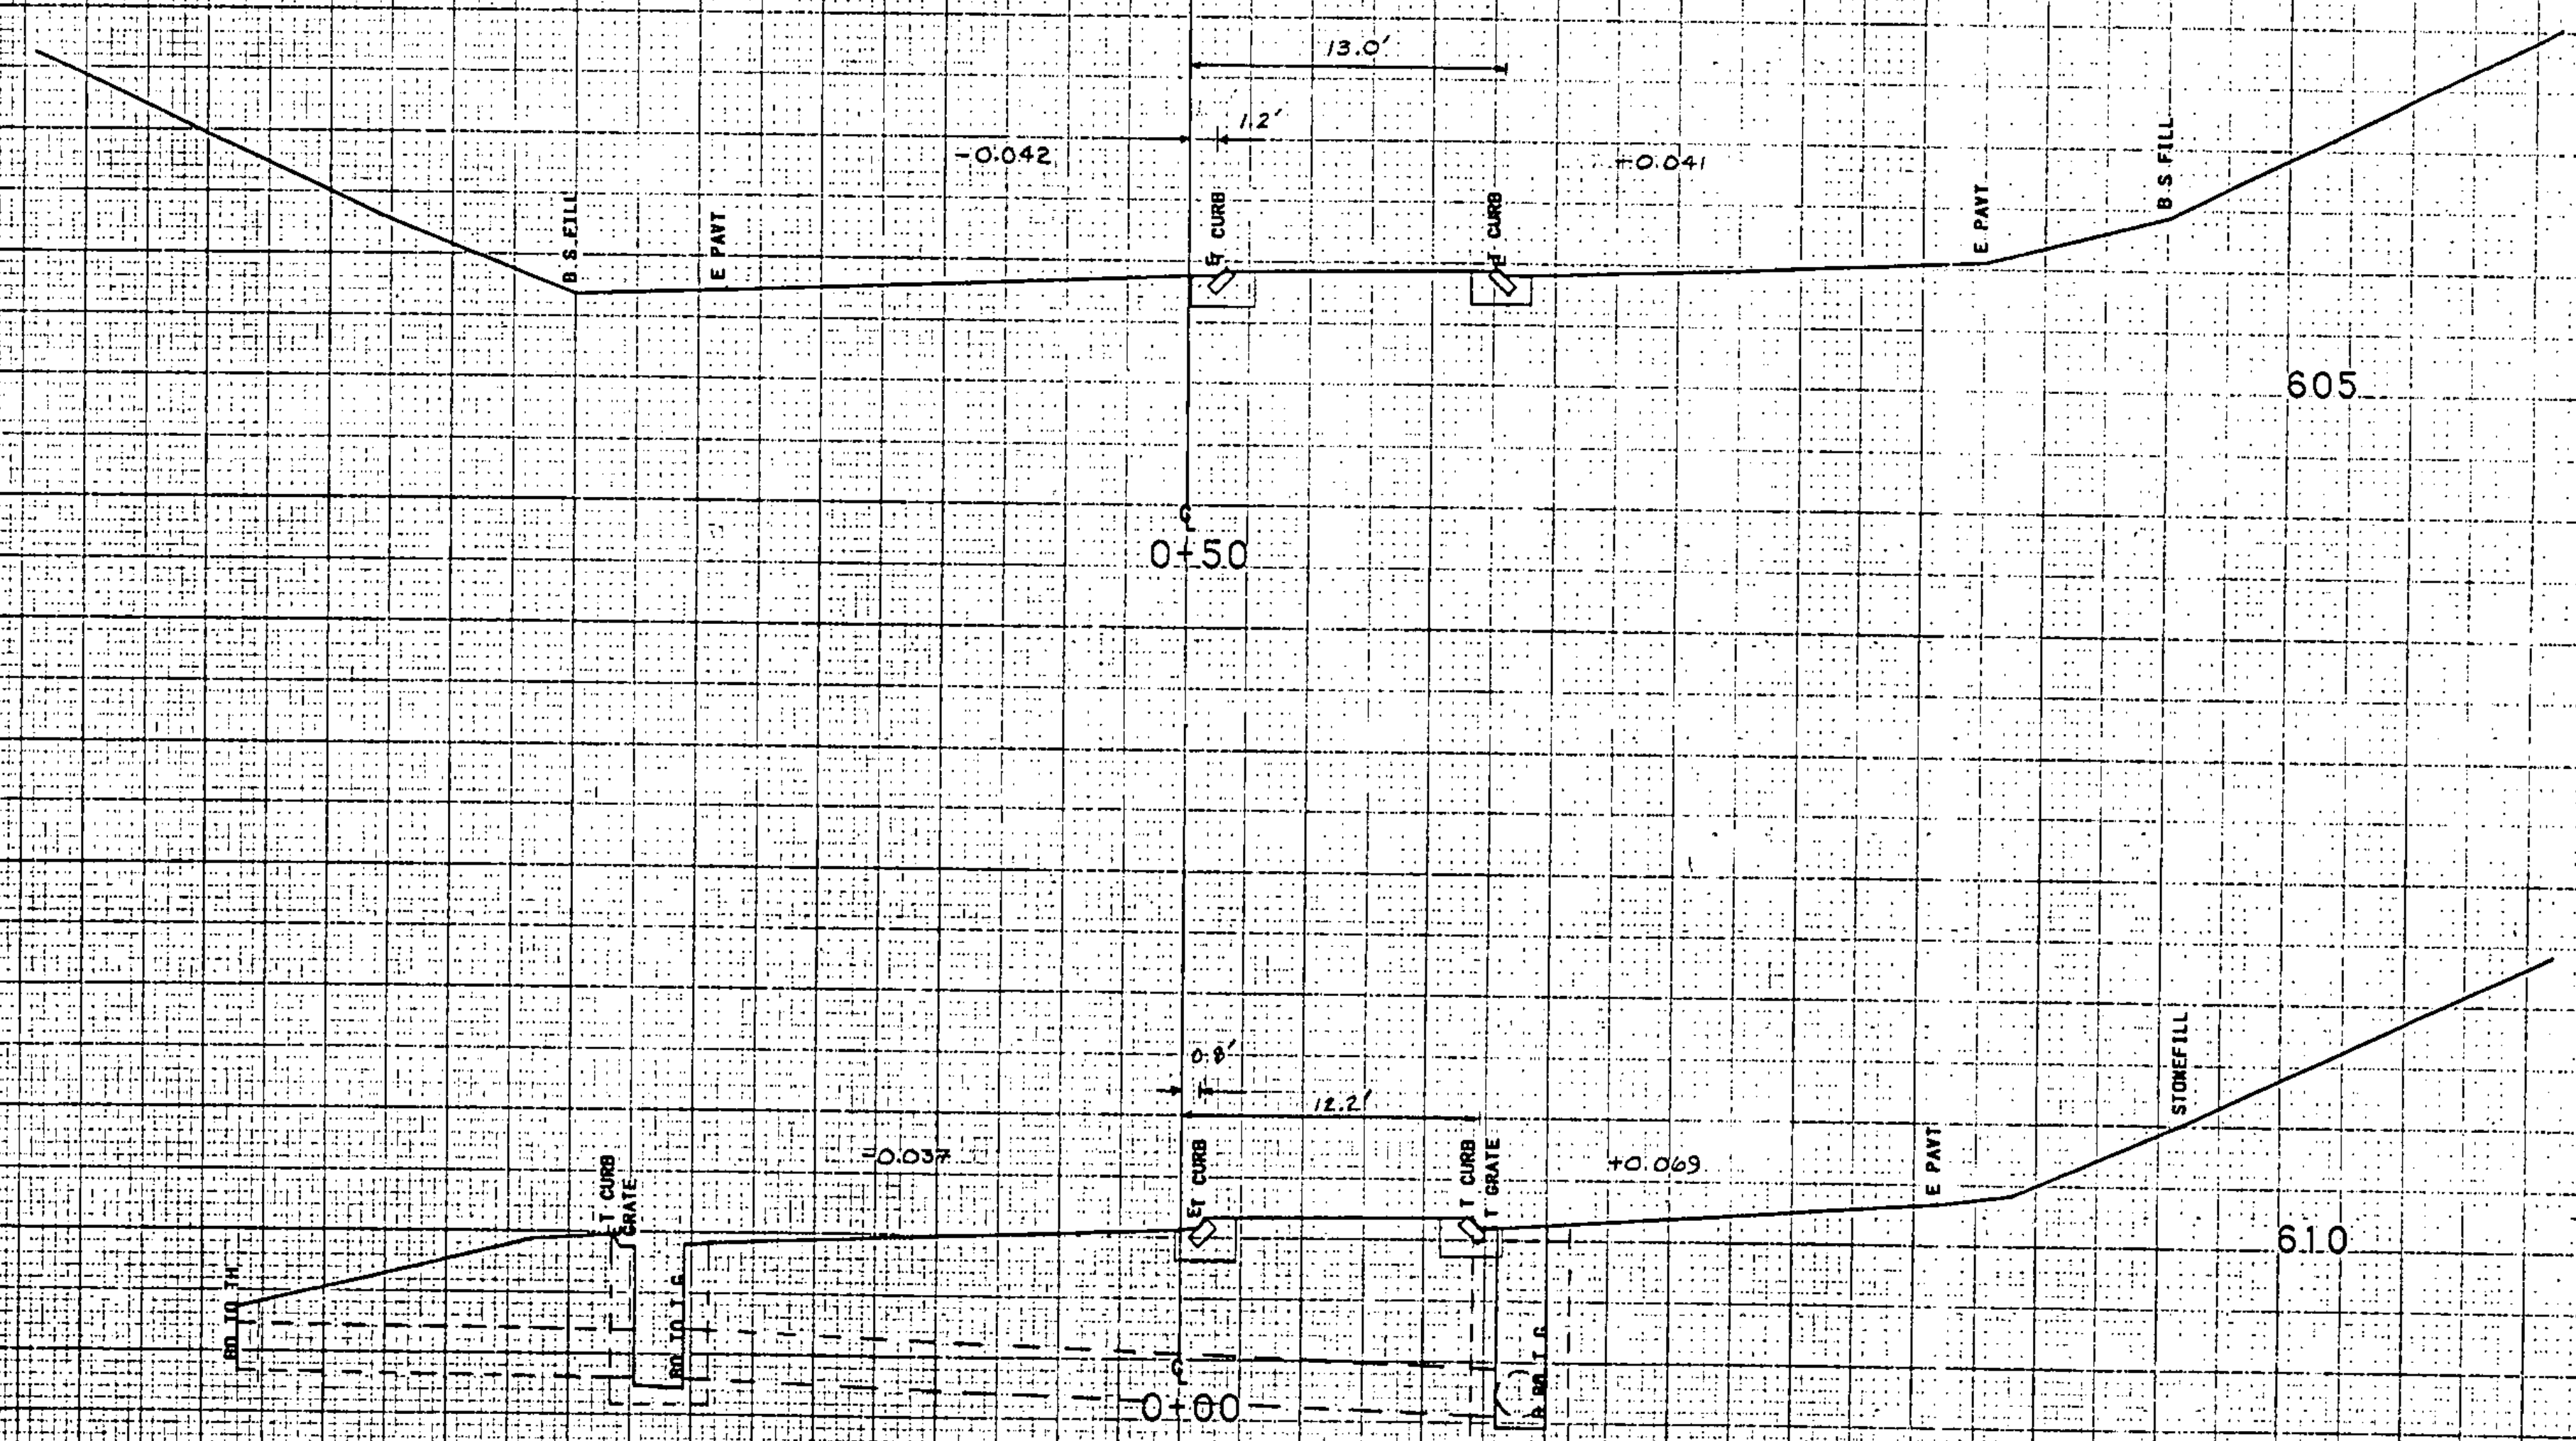

FROM STA.	0+00	TO STA.	0+50
PROJECT NAME	MONTPELIER MI		
NO.	F028-2 (B) S		
SURVEYED BY	FALL	PLOTTED	07/12/90
SHEET	71	OF	118 SHEETS

SCALE 5 FEET