
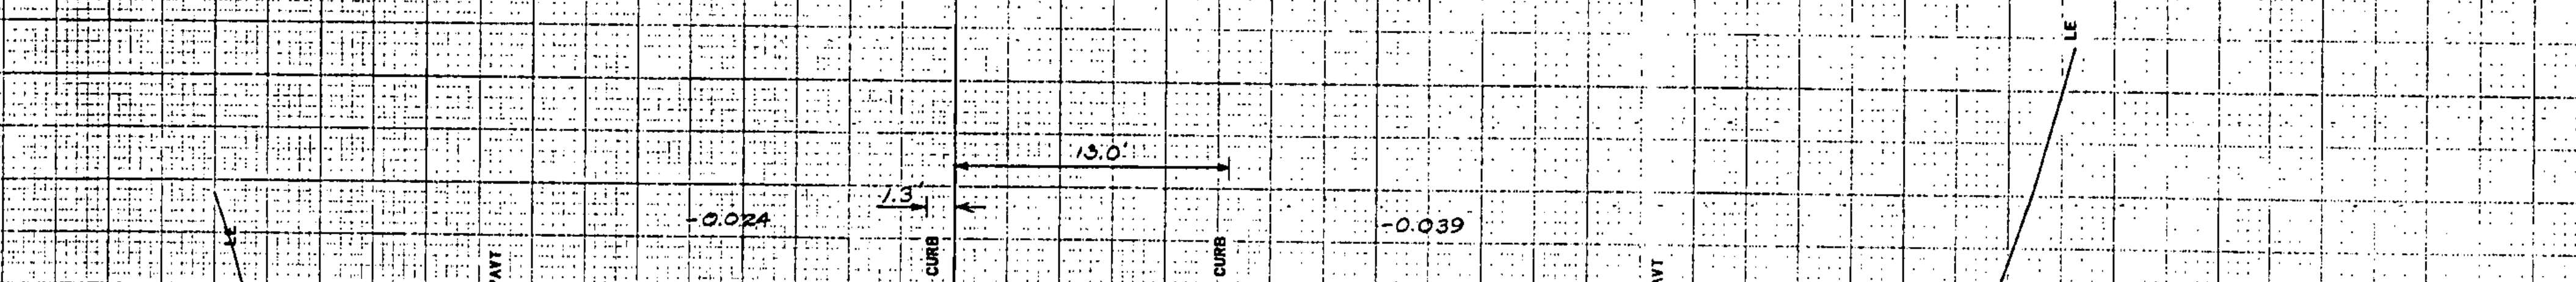
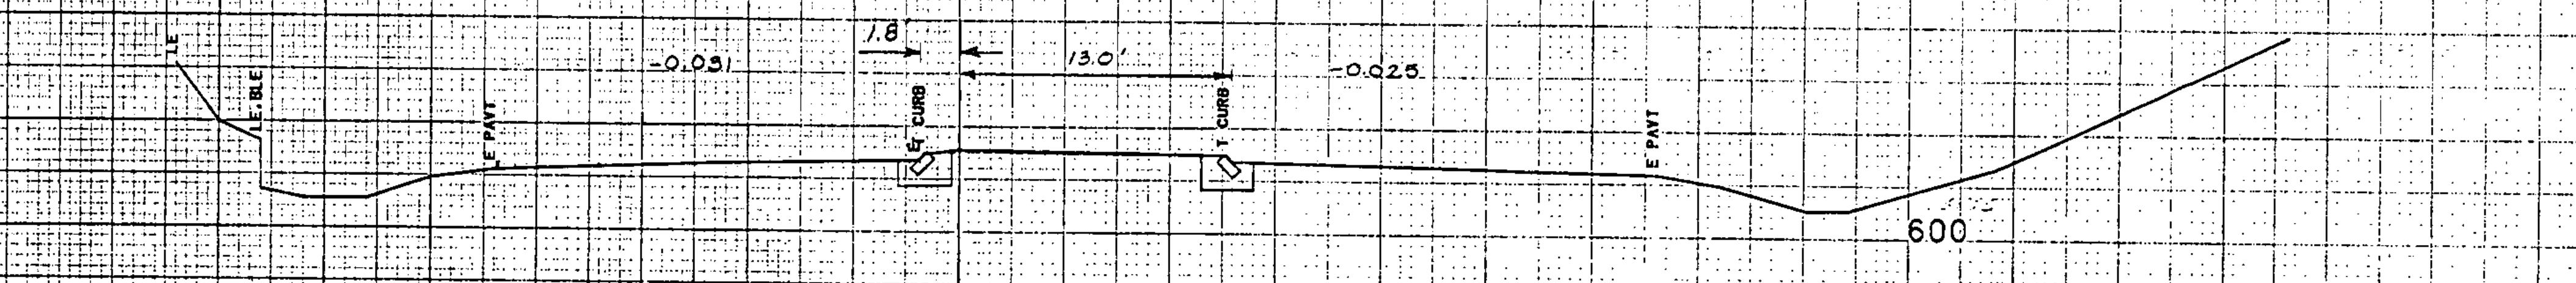


NOTE: STA 3+93.5 BEGIN SHOULDER TAPER

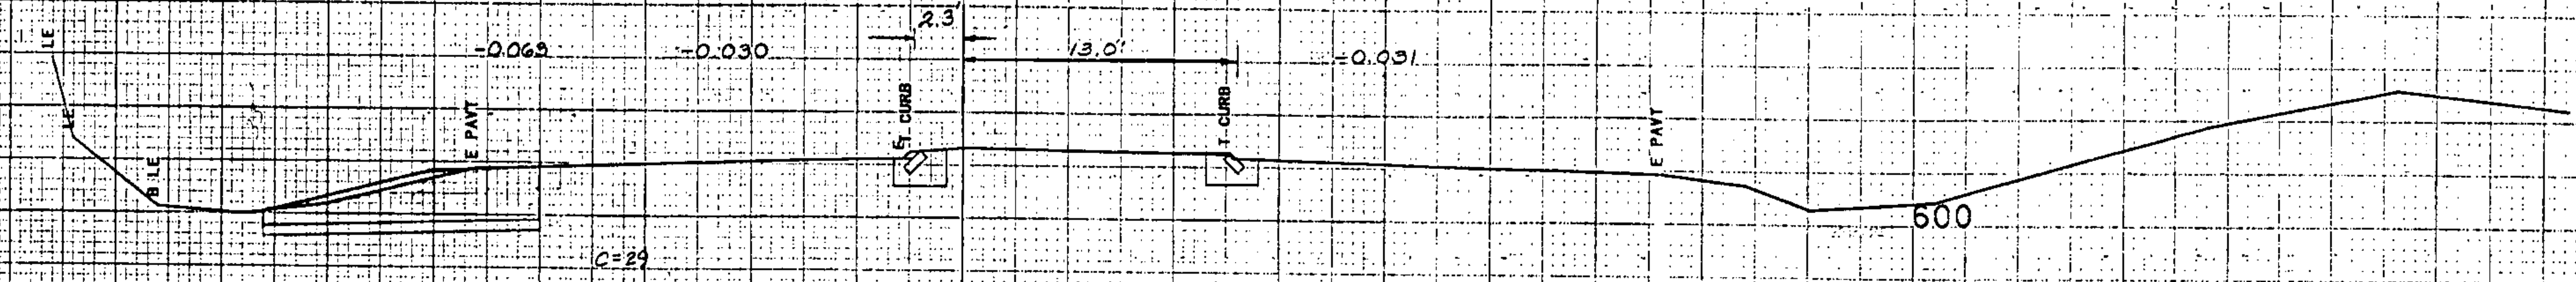

FROM STA.	3+00	TO STA.	4+00
PROJECT NAME	MONTPELIER M1		
PROJECT NO.	F028-2 (B) S		
SURVEYED BY	FALL	PLOTTED	07/12/90
SHEET	77 OF 118	SHEETS	05/90 0299

SCALE 1" = 5 FEET