


Ramp M' Transition Detail

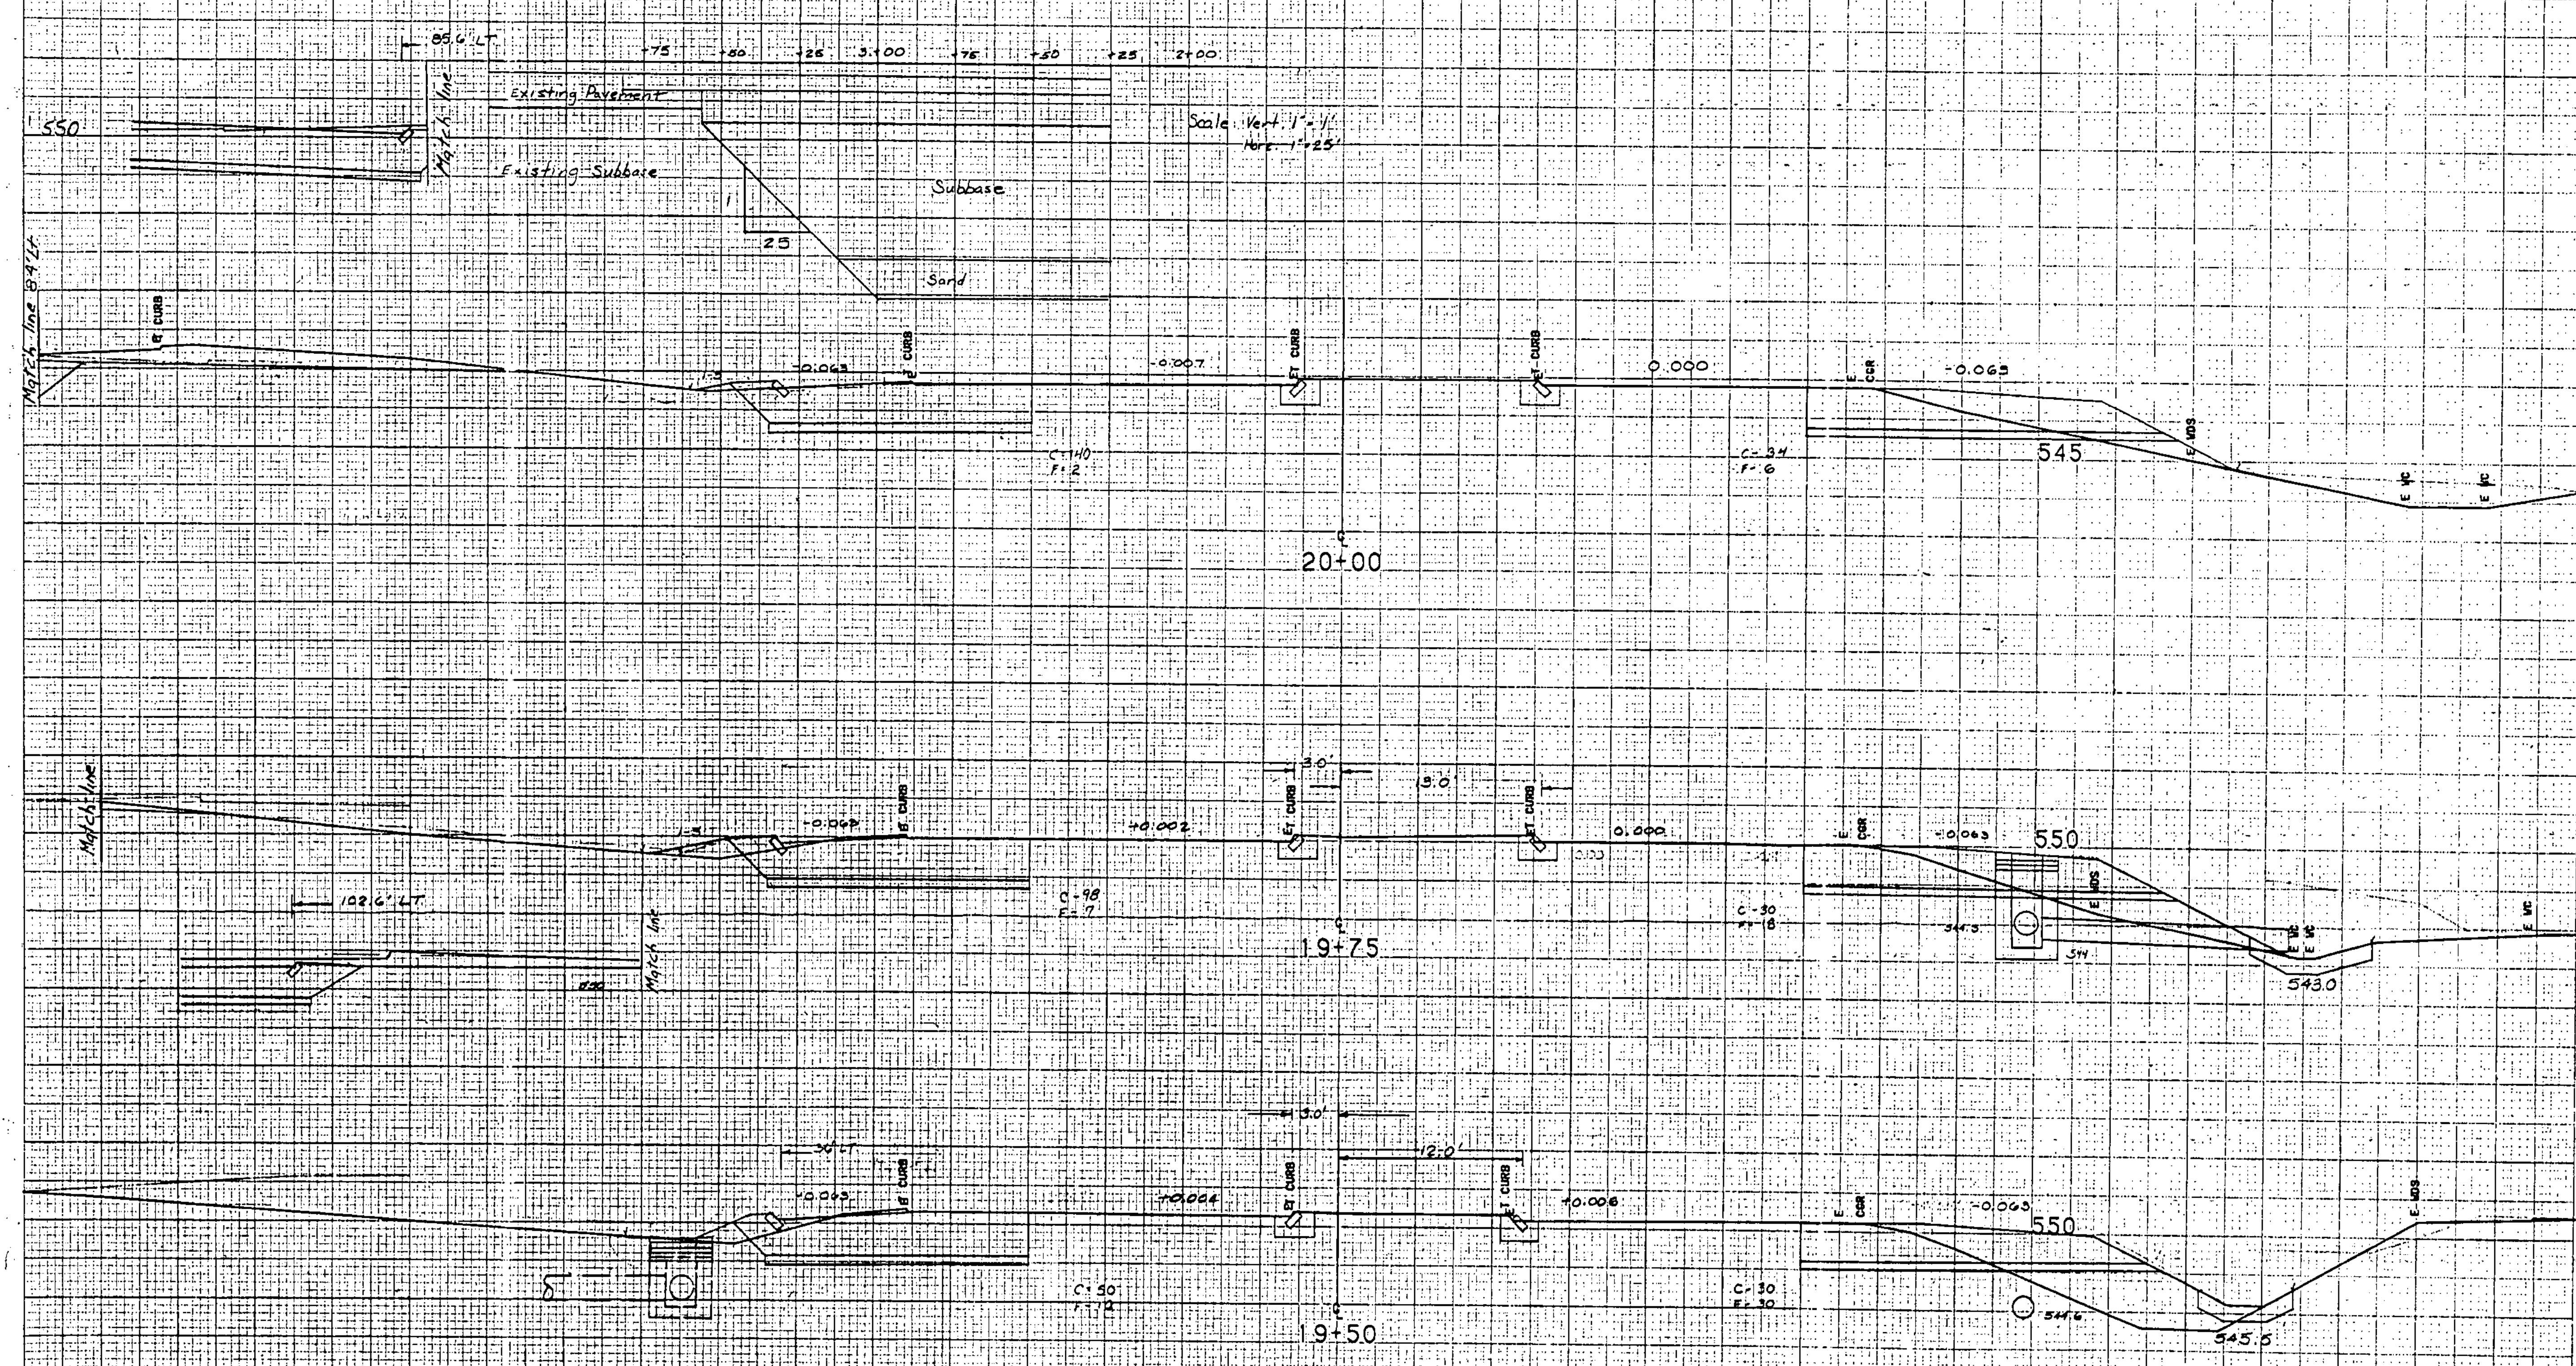

FROM STA.	19+50	TO STA.	20+00
PROJECT NAME	MONTPELIER M2		
NO.	F028-2(8)S		
SURVEYED BY	FALL	PLOTTED	07/12/90
SHEET 7/	OF 11/8	SHEETS	05/90 0299

SCALE: 1"=25'