


32+50~33+00 LT  
Box Cut Taper 1:25

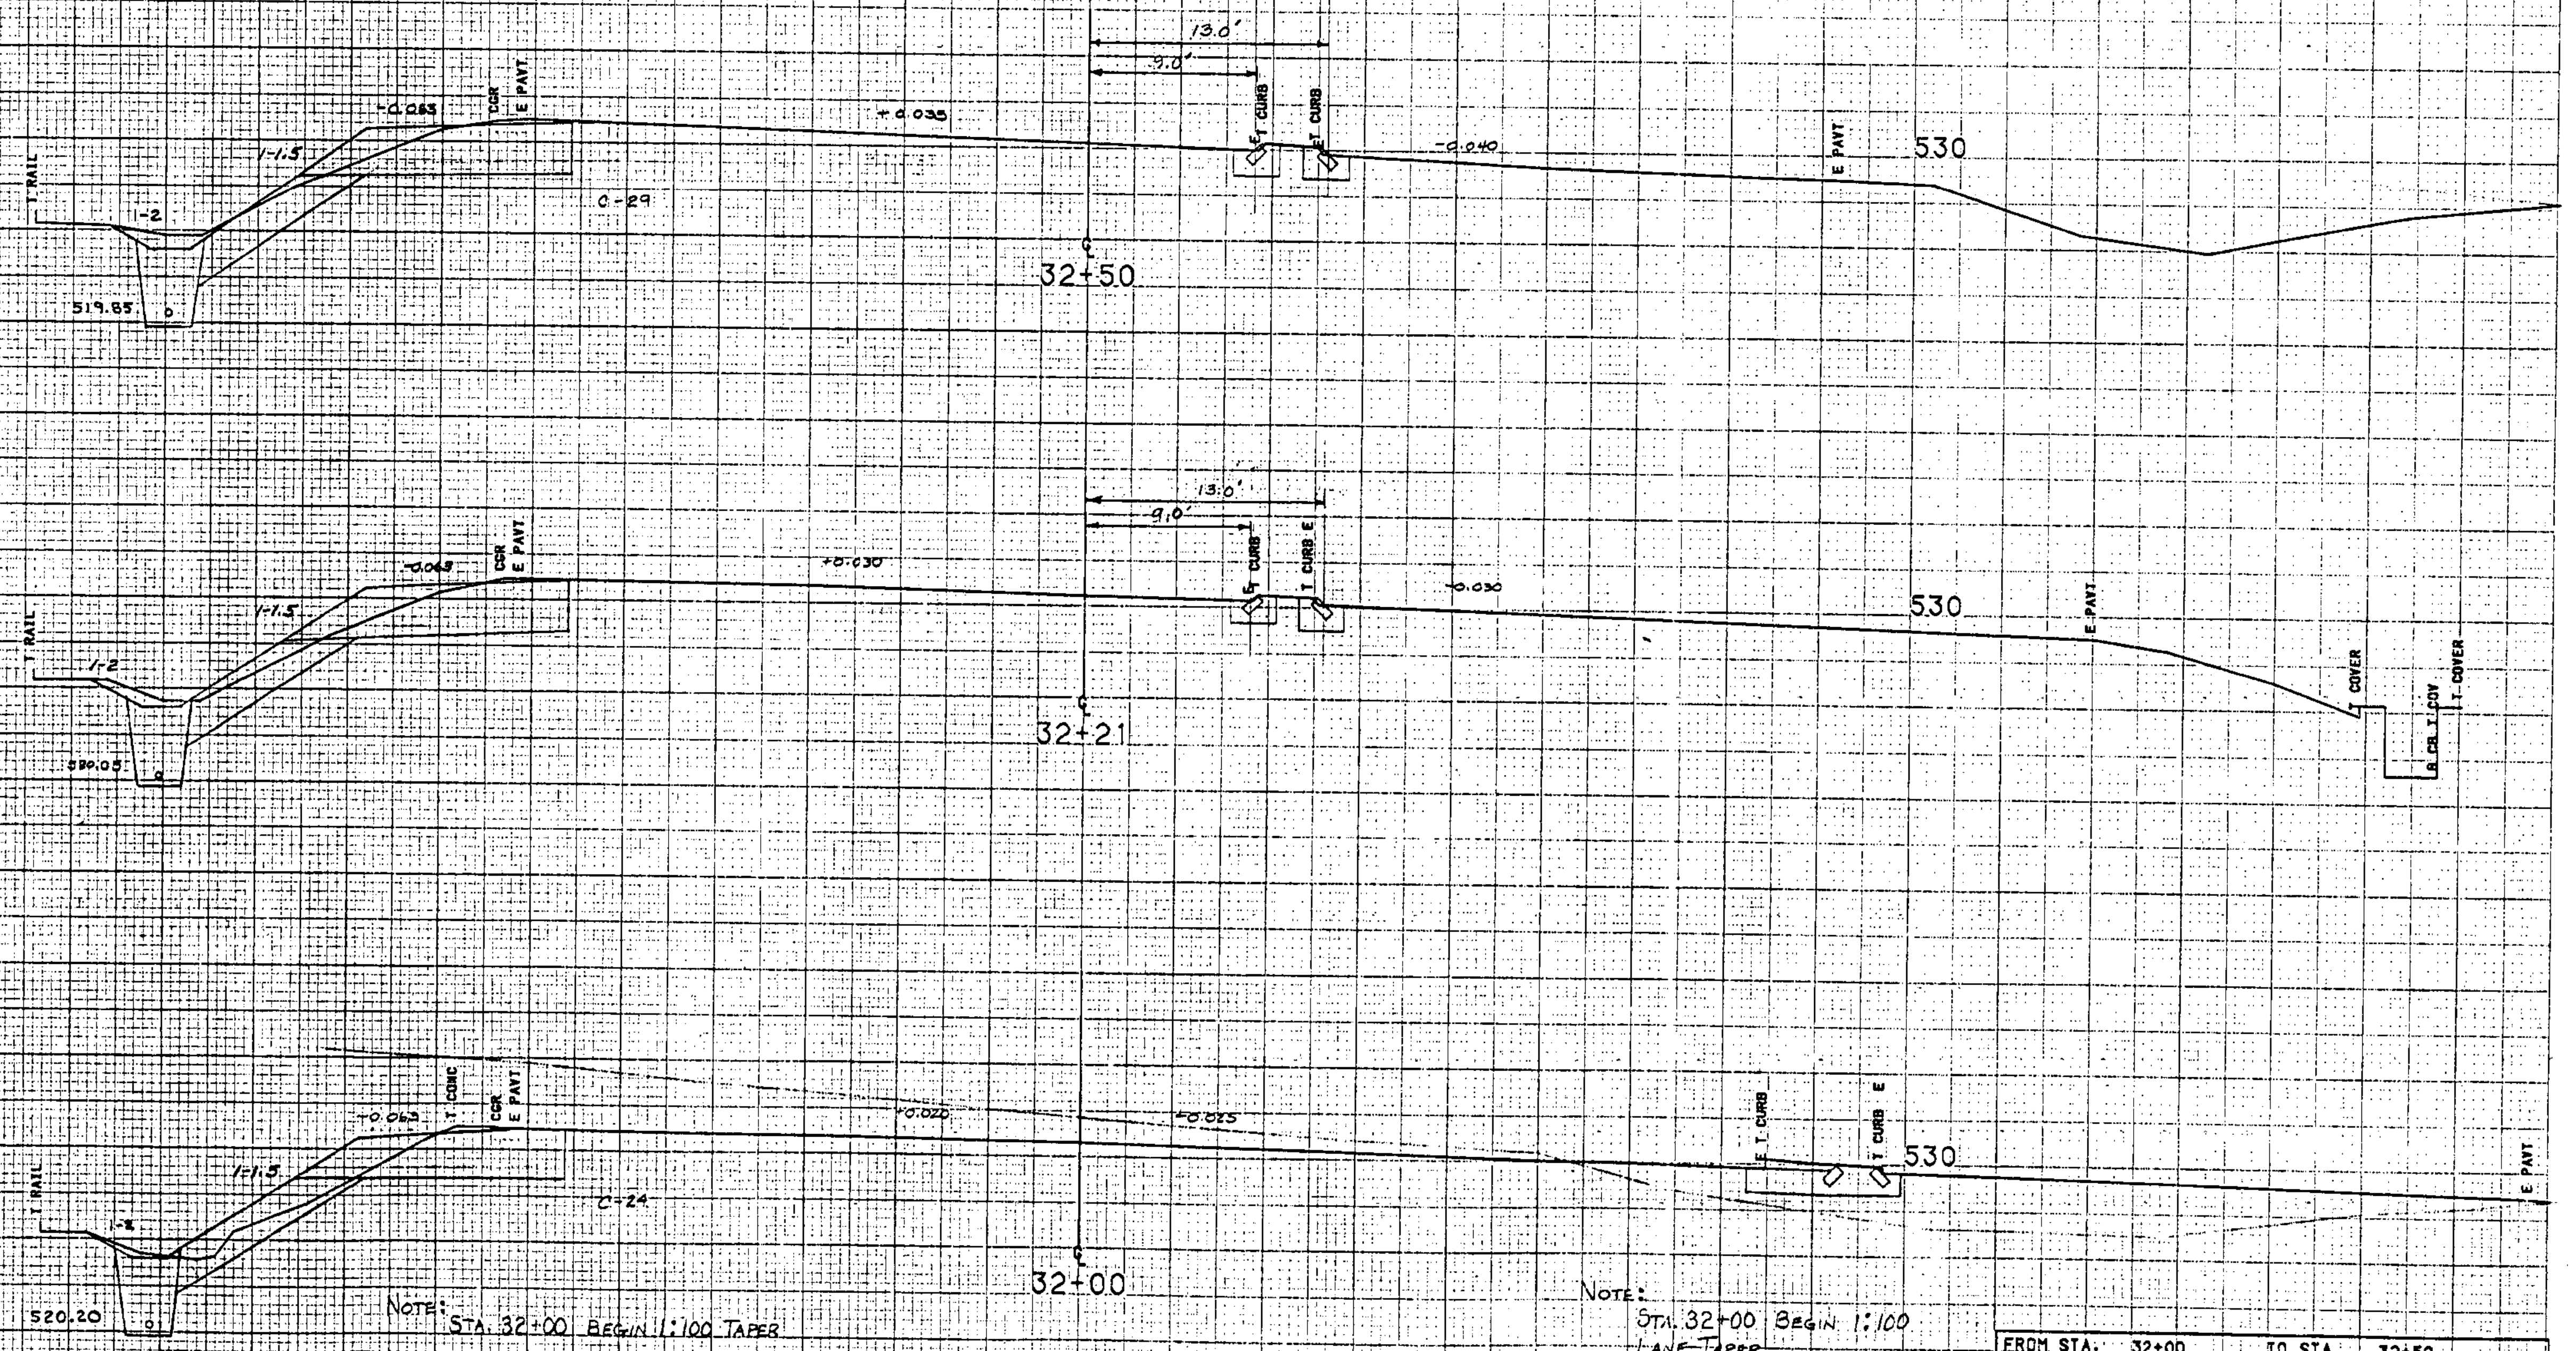

NOTE: STA. 32+00 BEGIN 1:100 TAPER

NOTE: STA. 32+00 BEGIN 1:100 LANE TAPER

SCALE 1" = 5 FEET

FROM STA.	32+00	TO STA.	32+50
PROJECT NAME	MONTPELIER M3		
NO.	F028-2 (8) S		
SURVEYED BY	FALL	PLOTTED	07/12/90
SHEET 102	DE 118	SHEETS	05/90 0299