



MATERIAL TRANSITION DIAGRAM

SCALE: HORIZ. 1"=25'
VERT. 1"=25'

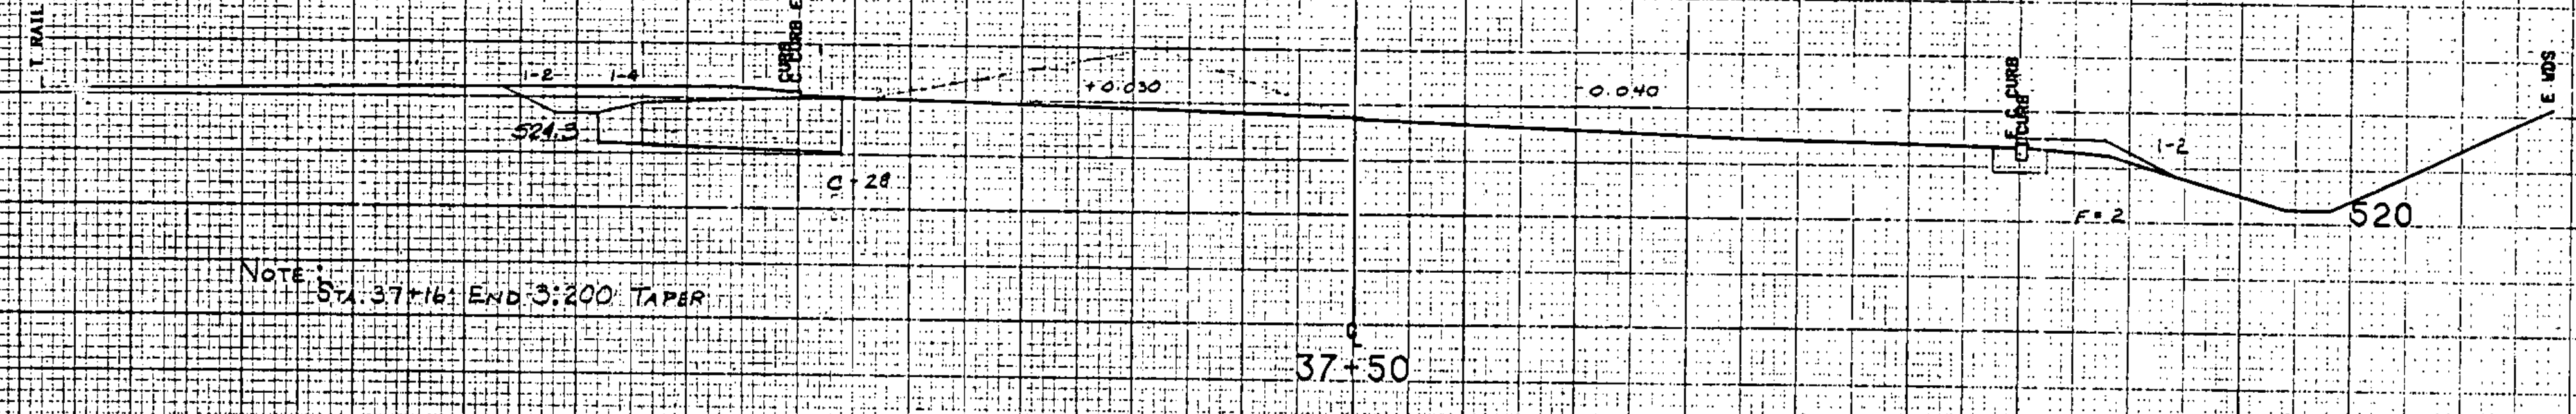

NOTE: STA. 37+16: END 3:200 TAPER

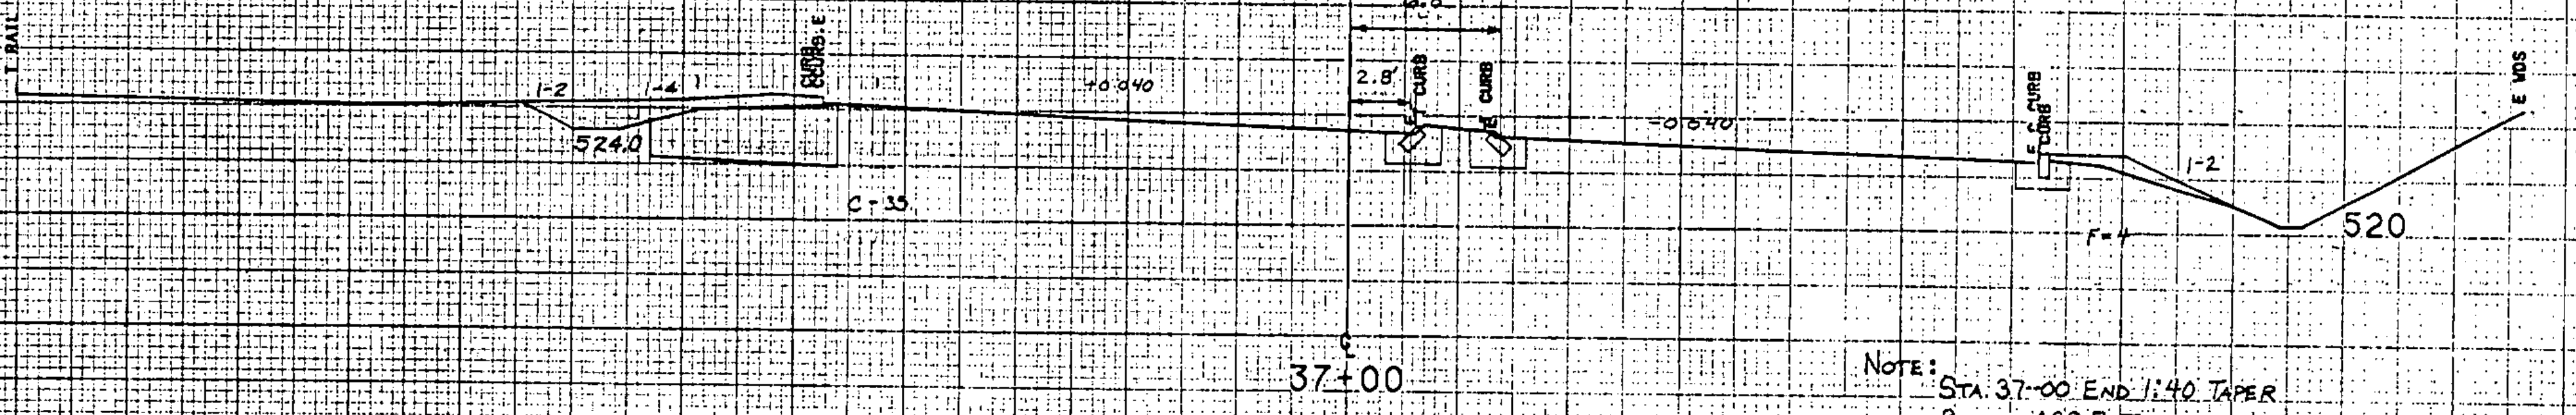

NOTE: STA. 37+00: END 1:40 TAPER
BEGIN 1:38.7 TAPER

FROM STA.	37+00	TO STA.	38+00
PROJECT NAME	MONTPELIER M4		
NO.	F028-2 (B) S		
SURVEYED BY	FALL	PLOTTED	07/12/90
SHEET	07 OF 110	SHEETS	05/90 0299

SCALE 1"=25'