



EXISTING BRIDGE


REMOVE FIRST PORTION OF EXISTING BRIDGE IN PHASE ONE

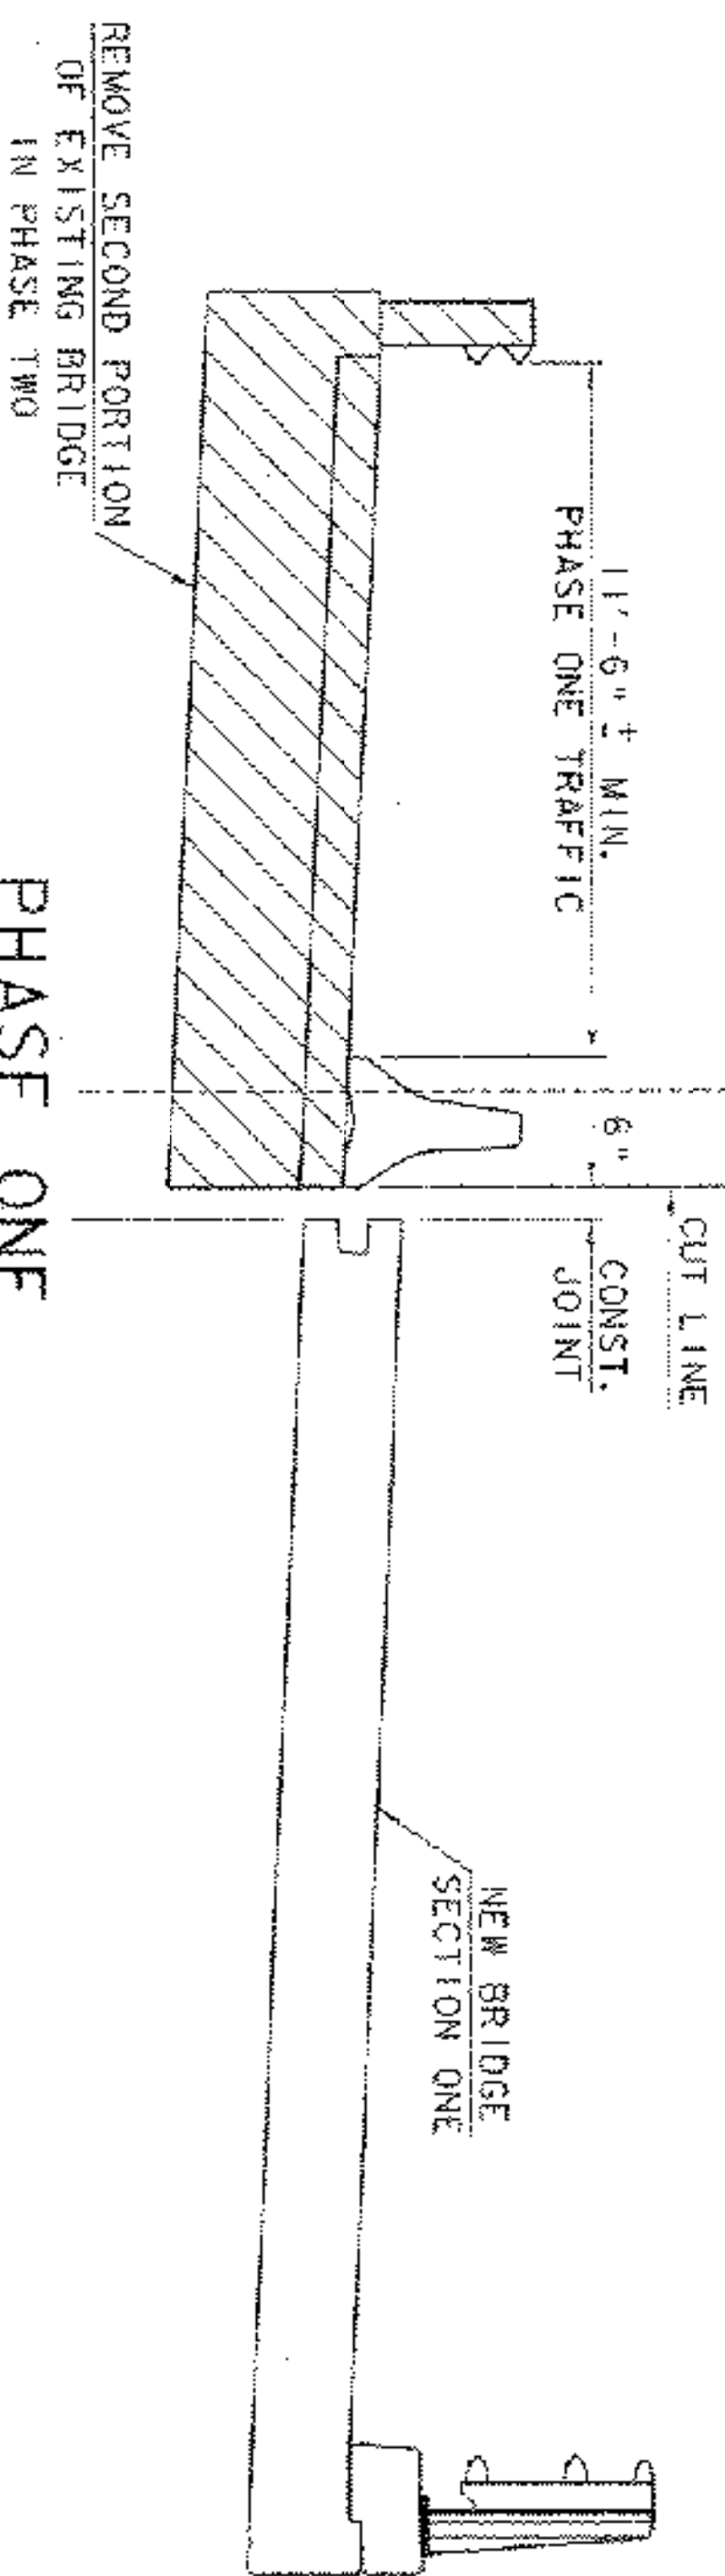

PHASE ONE

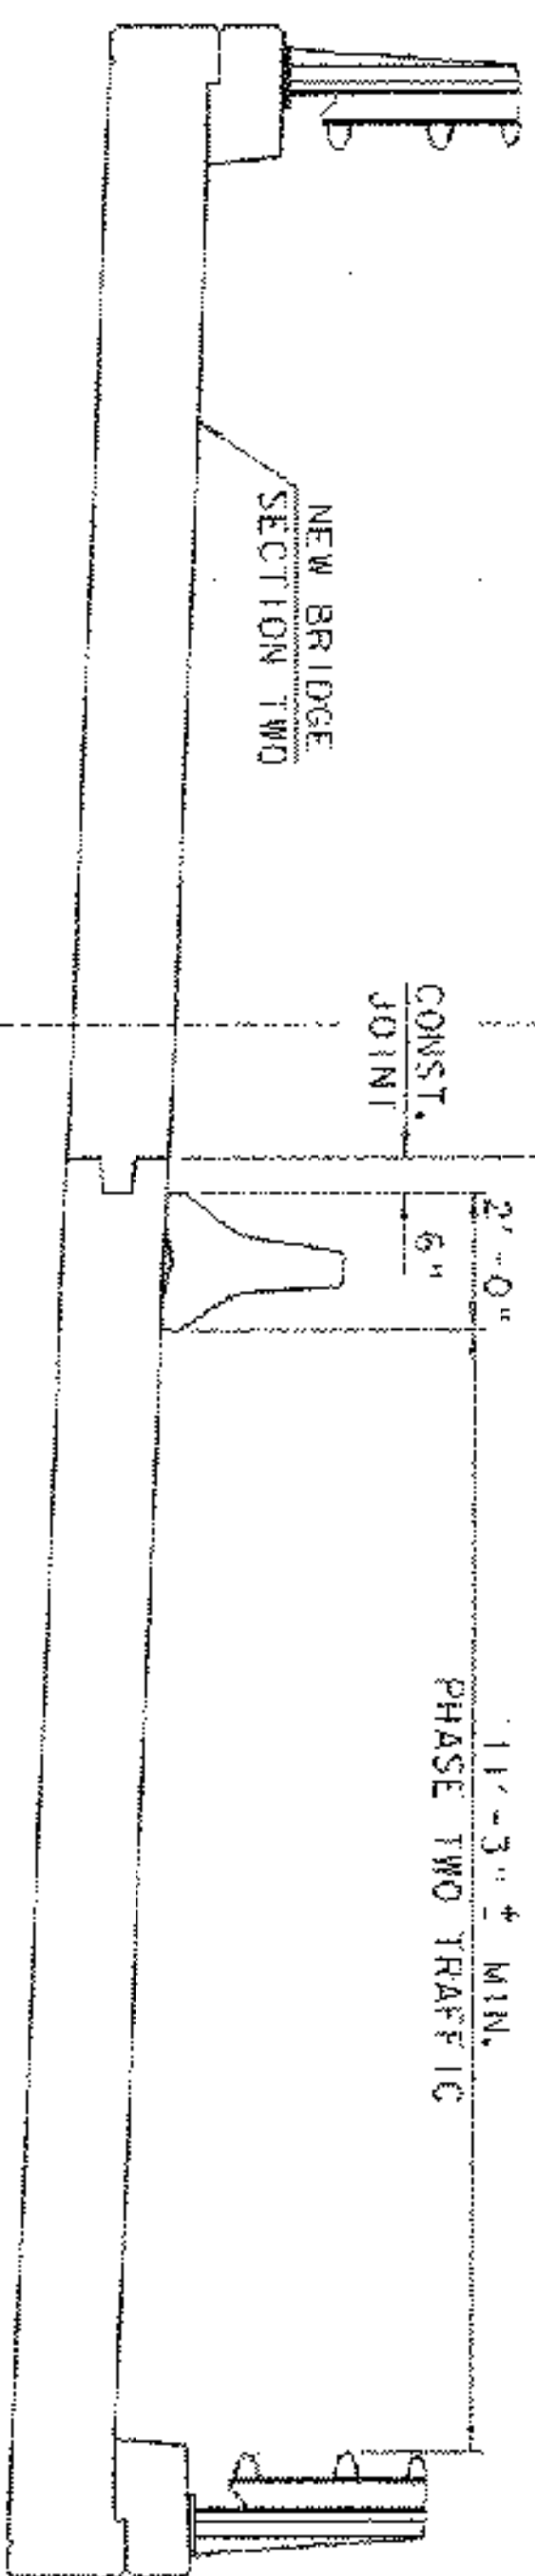

PHASE TWO

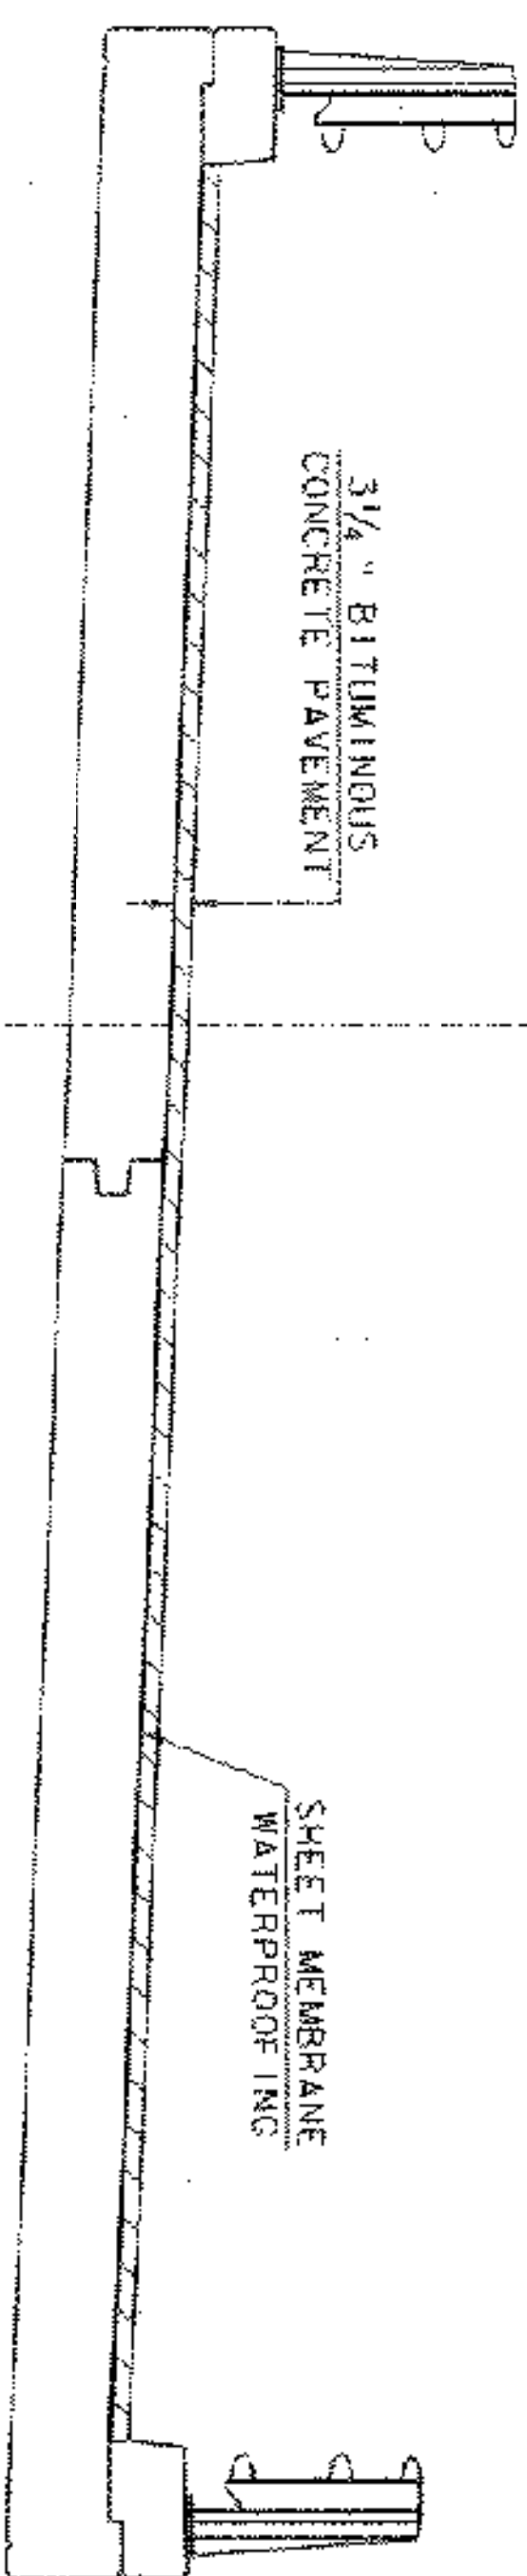


PHASE THREE

PHASE CONSTRUCTION NOTES

- PHASE ONE:** PLACE TEMPORARY BARRIER AT THE LOCATION SHOWN TO MAINTAIN ONE-WAY TRAFFIC. DIRECT ALL TRAFFIC TO UPSTREAM SIDE OF BRIDGE AS SHOWN. CUT EXISTING BRIDGE AT THE LOCATION SHOWN AND REMOVE PORTION OF EXISTING BRIDGE INDICATED BY THE HATCH LINES. WITH TRAFFIC IN PHASE ONE CONDITION, CONSTRUCT NEW BRIDGE SECTION ONE TO CONSTRUCTION JOINT AS SHOWN.
- PHASE TWO:** RESET TEMPORARY BARRIER AS SHOWN AND MOVE ONE-WAY TRAFFIC TO ONE-WAY TRAFFIC ON THE DOWNSTREAM SIDE OF BRIDGE AS SHOWN. REMOVE REMAINING PORTION OF EXISTING BRIDGE INDICATED BY THE HATCH LINES. WITH TRAFFIC IN PHASE TWO CONDITION, CONSTRUCT NEW BRIDGE SECTION TWO AS SHOWN.
- PHASE THREE:** REMOVE TEMPORARY BARRIER. WHILE MAINTAINING ONE-WAY TRAFFIC, PLACE SHEET MEMBRANE AND PERMANENT PAVEMENT. REDIRECT TO TWO-WAY TRAFFIC.

CONSPAN PRECAST
 CONCRETE ARCH USED
 VALUE ENGINEERING
 SEE PAGES 040 TO 088.
 STILL UTILIZED PHASE
 CONSTRUCTION

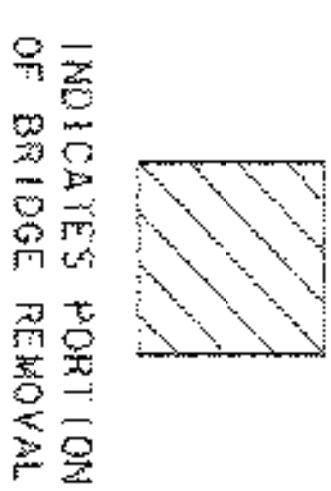

PHASE CONSTRUCTION DETAILS

PROJECT NAME:	ROCKINGHAM
PROJECT NUMBER:	TH2 - 9103
FILE NAME:	902053\sr-uctur-99\sc033dcd\
PROJECT MANAGER:	R. R. WHITCOMBS
DESIGNED BY:	G. ROY
DRAWN BY:	G. ROY
CHECKED BY:	R. WHITCOMB
SHEET	9 OF 38