


ELEVATION ALONG DOWNSTREAM FASCIA

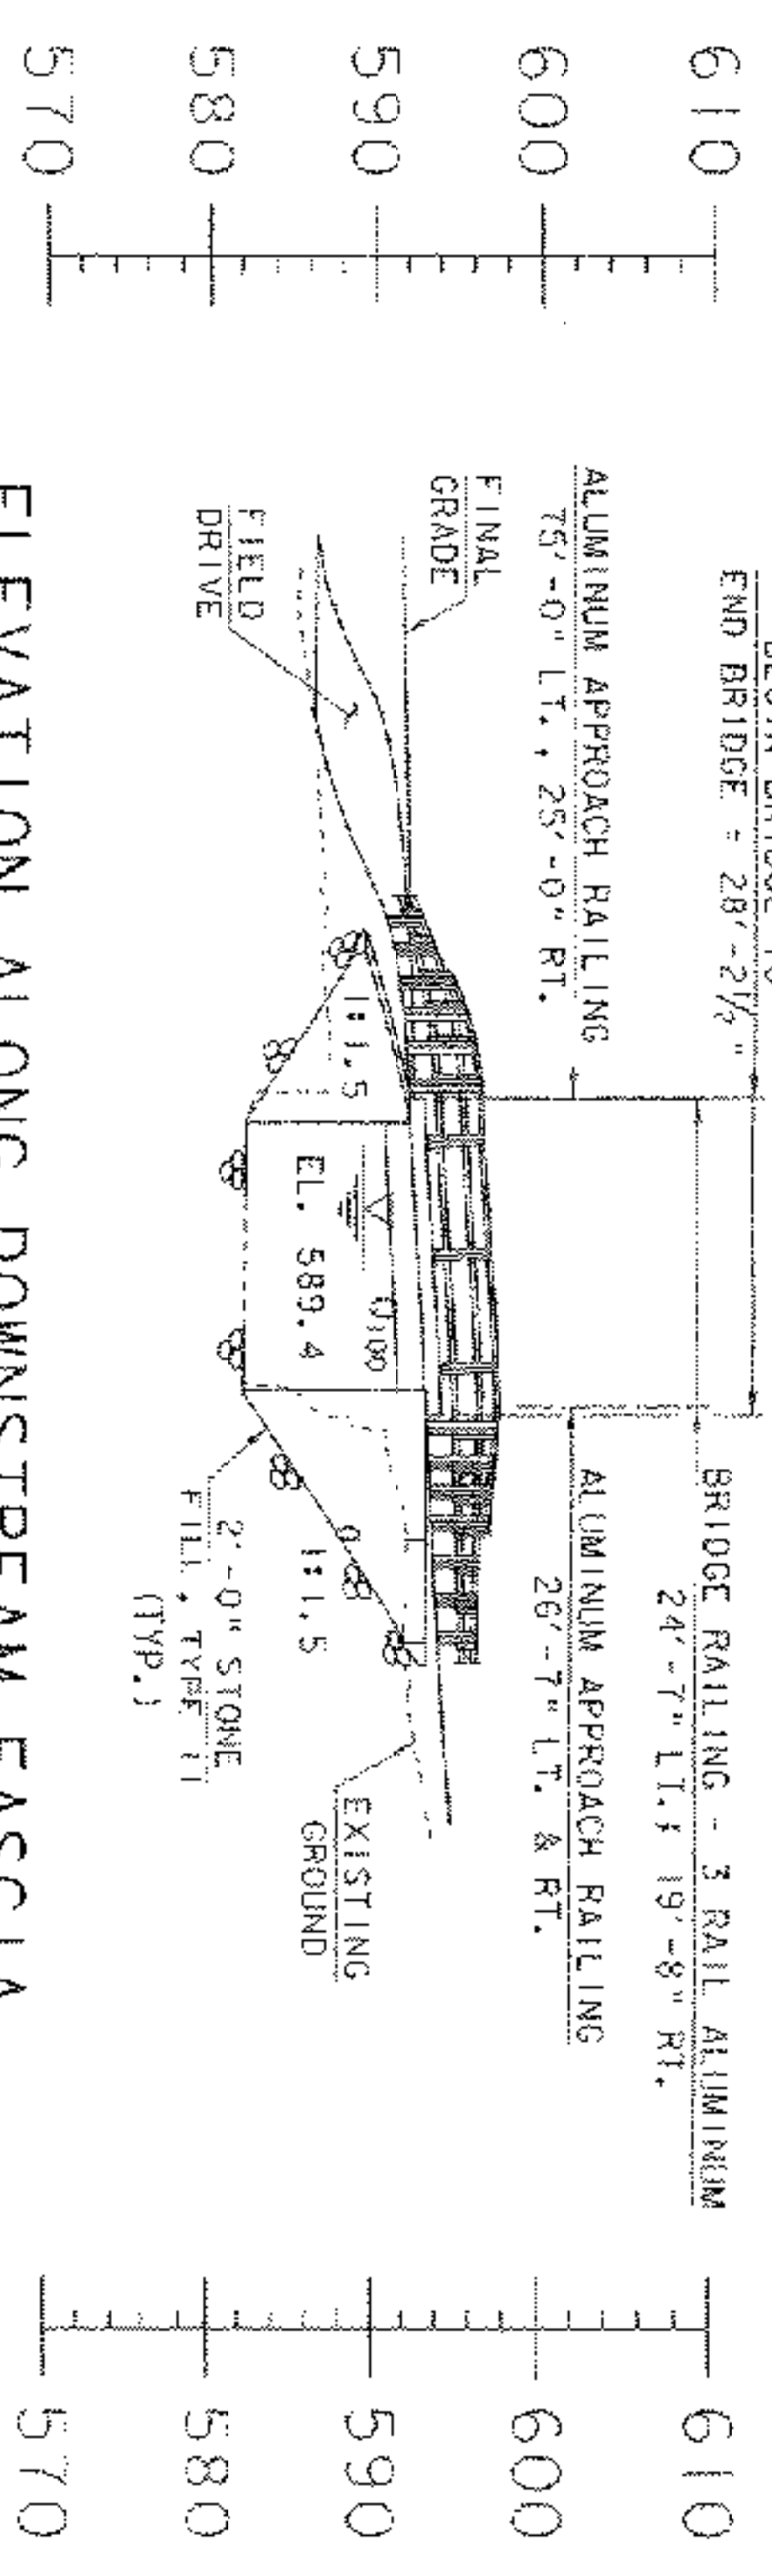

PLAN AND ELEVATION

CONSPAN PRECAST
 CONCRETE ARCH USED
 VALUE ENGINEERING
 SEE PAGES 040 TO 088.

PROJECT NAME:	ROCKINGHAM
PROJECT NUMBER:	TH2 - 9103
FILE NAME:	302053.structure-66x5050.pn1
PROJECT MANAGER:	R. R. WHITCOMB
DESIGNED BY:	G. ROY
PLOT DATE:	19-AUG-2003
DRAWN BY:	G. ROY
CHECKED BY:	R. WHITCOMB
SHEET	13 OF 38