



APPROACH SLAB PLAN

SCALE: 1/4" = 1'-0"

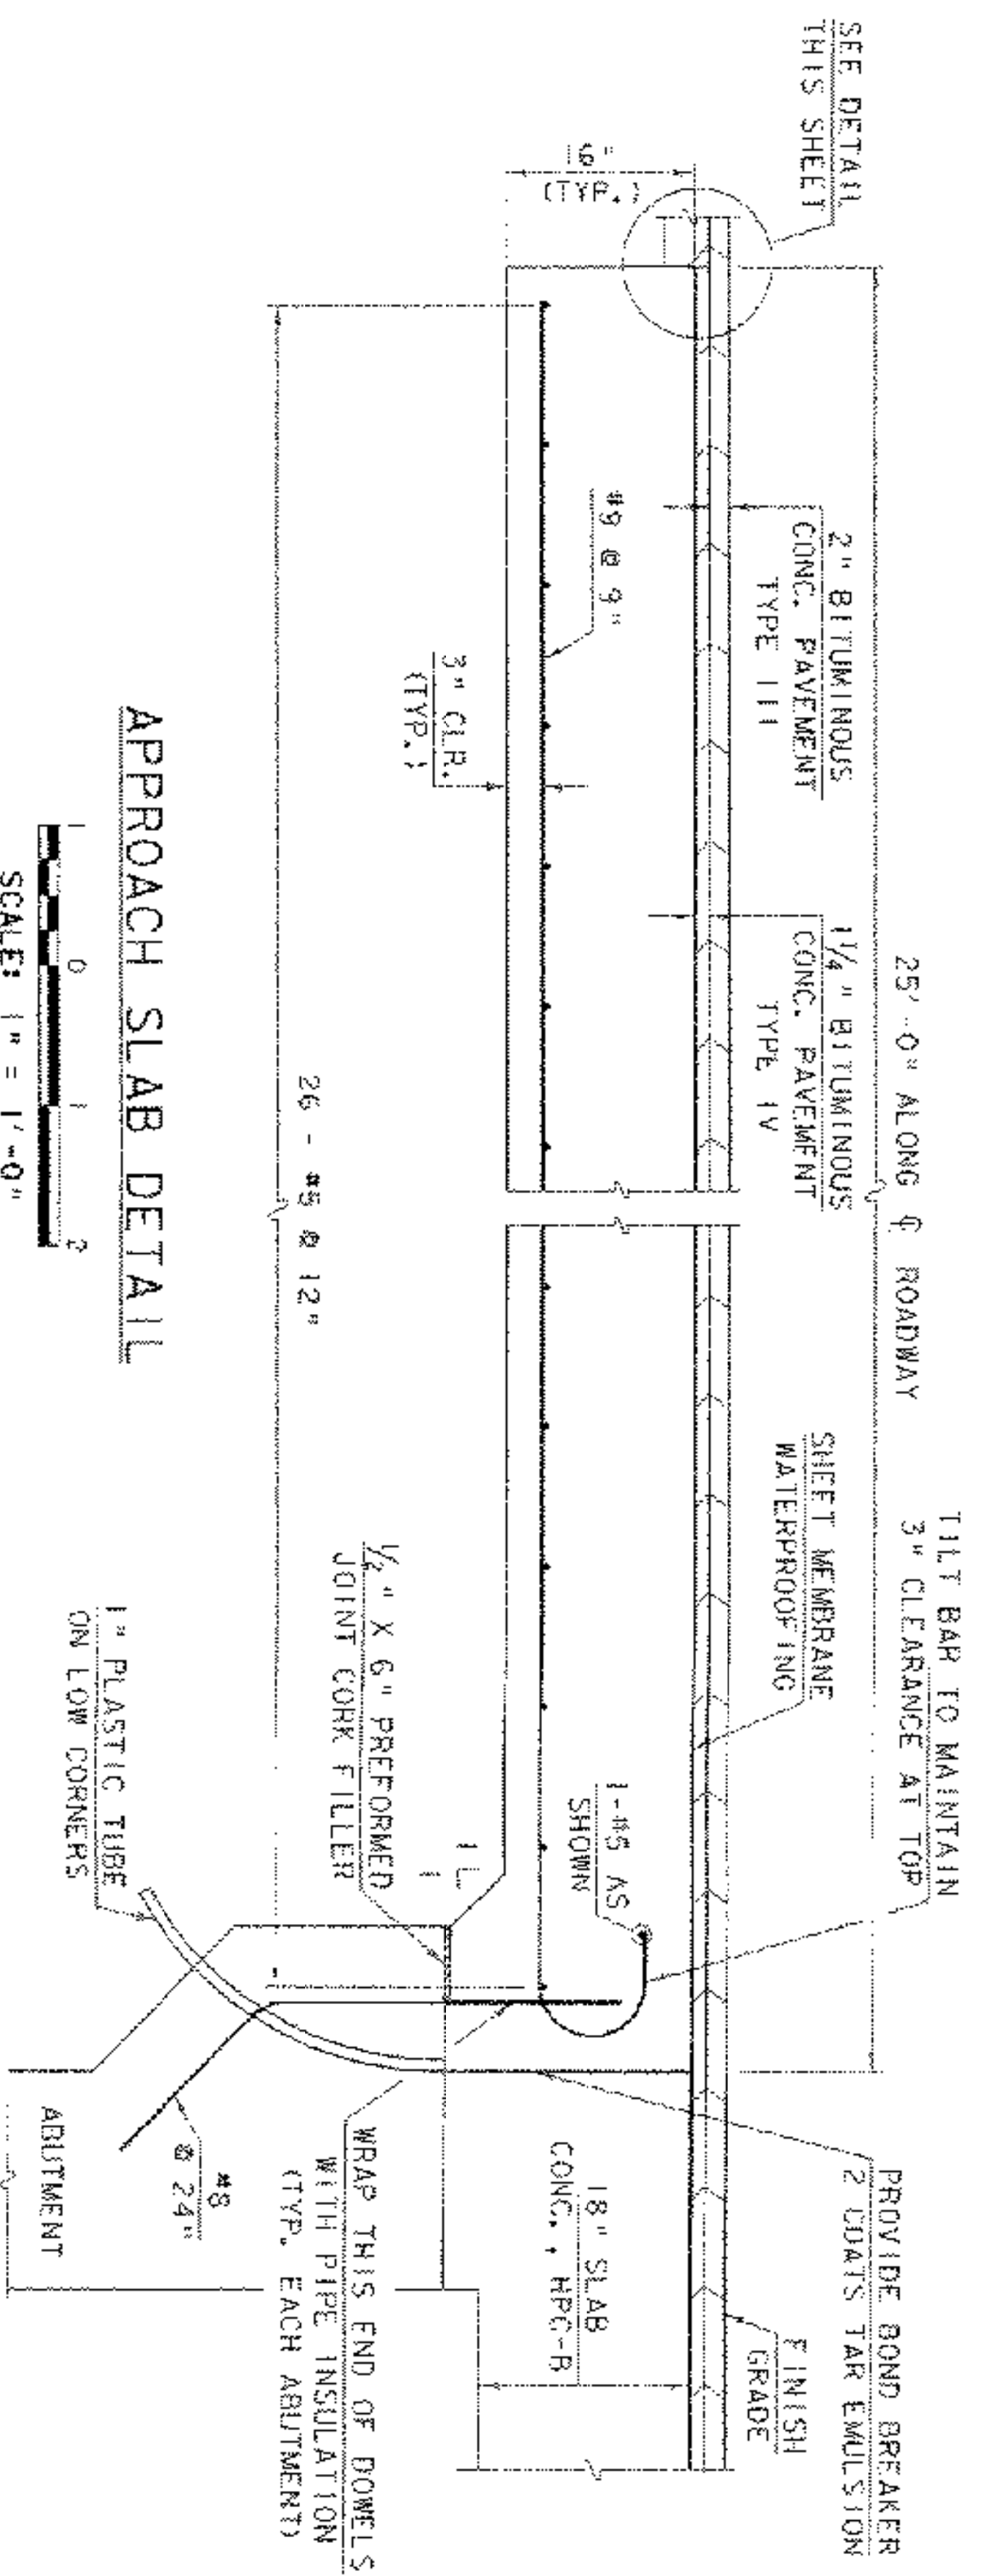

APPROACH SLAB DETAIL

SCALE: 1" = 1'-0"

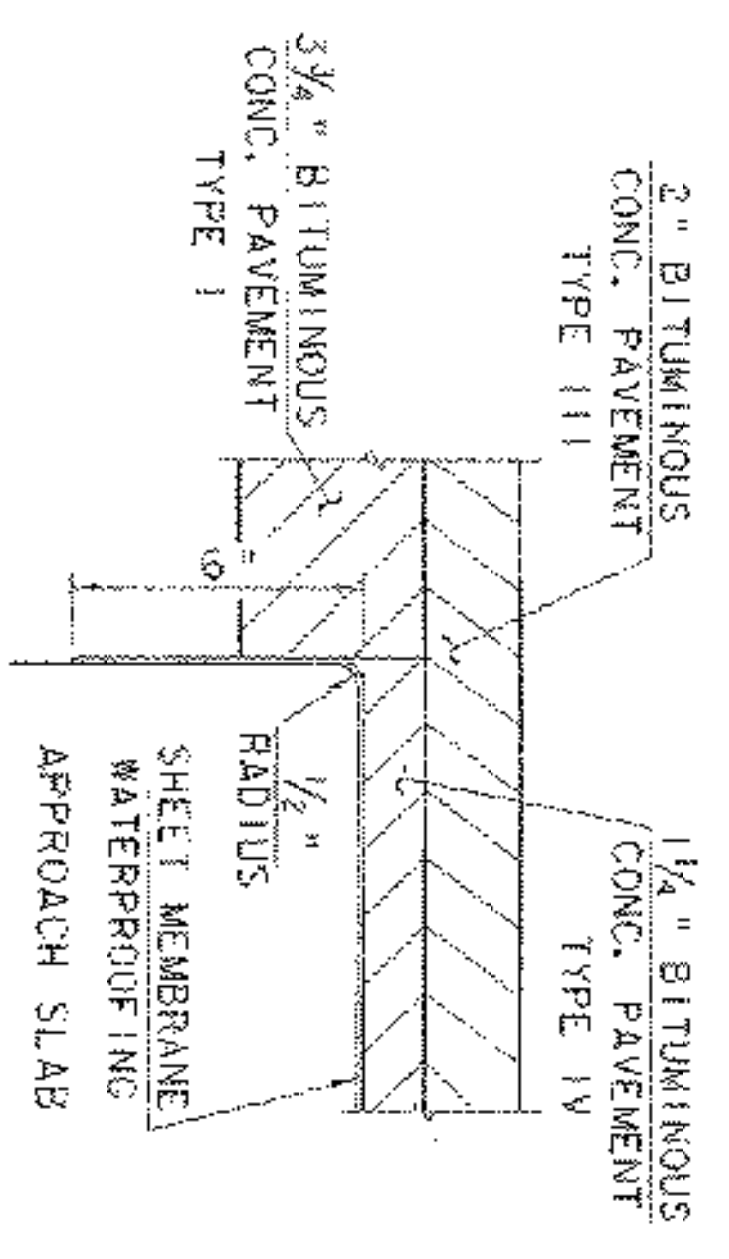

DETAIL FOR SHEET MEMBRANE AT APPROACH SLAB END

SCALE: 3" = 1'-0"

APPROACH SLAB DETAILS

CONSPAN PRECAST
CONCRETE ARCH USED
VALUE ENGINEERING
SEE PAGES 040 TO 088.

PROJECT NAME:	ROCKINGHAM
PROJECT NUMBER:	TH2 - 9103
FILE NAME:	9905318TRUCTUR6E66053053
PROJECT MANAGER:	R. R. WHITCOMB
DESIGNED BY:	C. ROY
PLOT DATE:	19-AUG-2005
DRAWN BY:	G. ROY
CHECKED BY:	R. WHITCOMB
SHEET	19 OF 38