


ABUTMENT NO. 1 FOOTING REINFORCING PLAN

CONSPAN PRECAST  
 CONCRETE ARCH USED  
 VALUE ENGINEERING  
 SEE PAGES 040 TO 088.

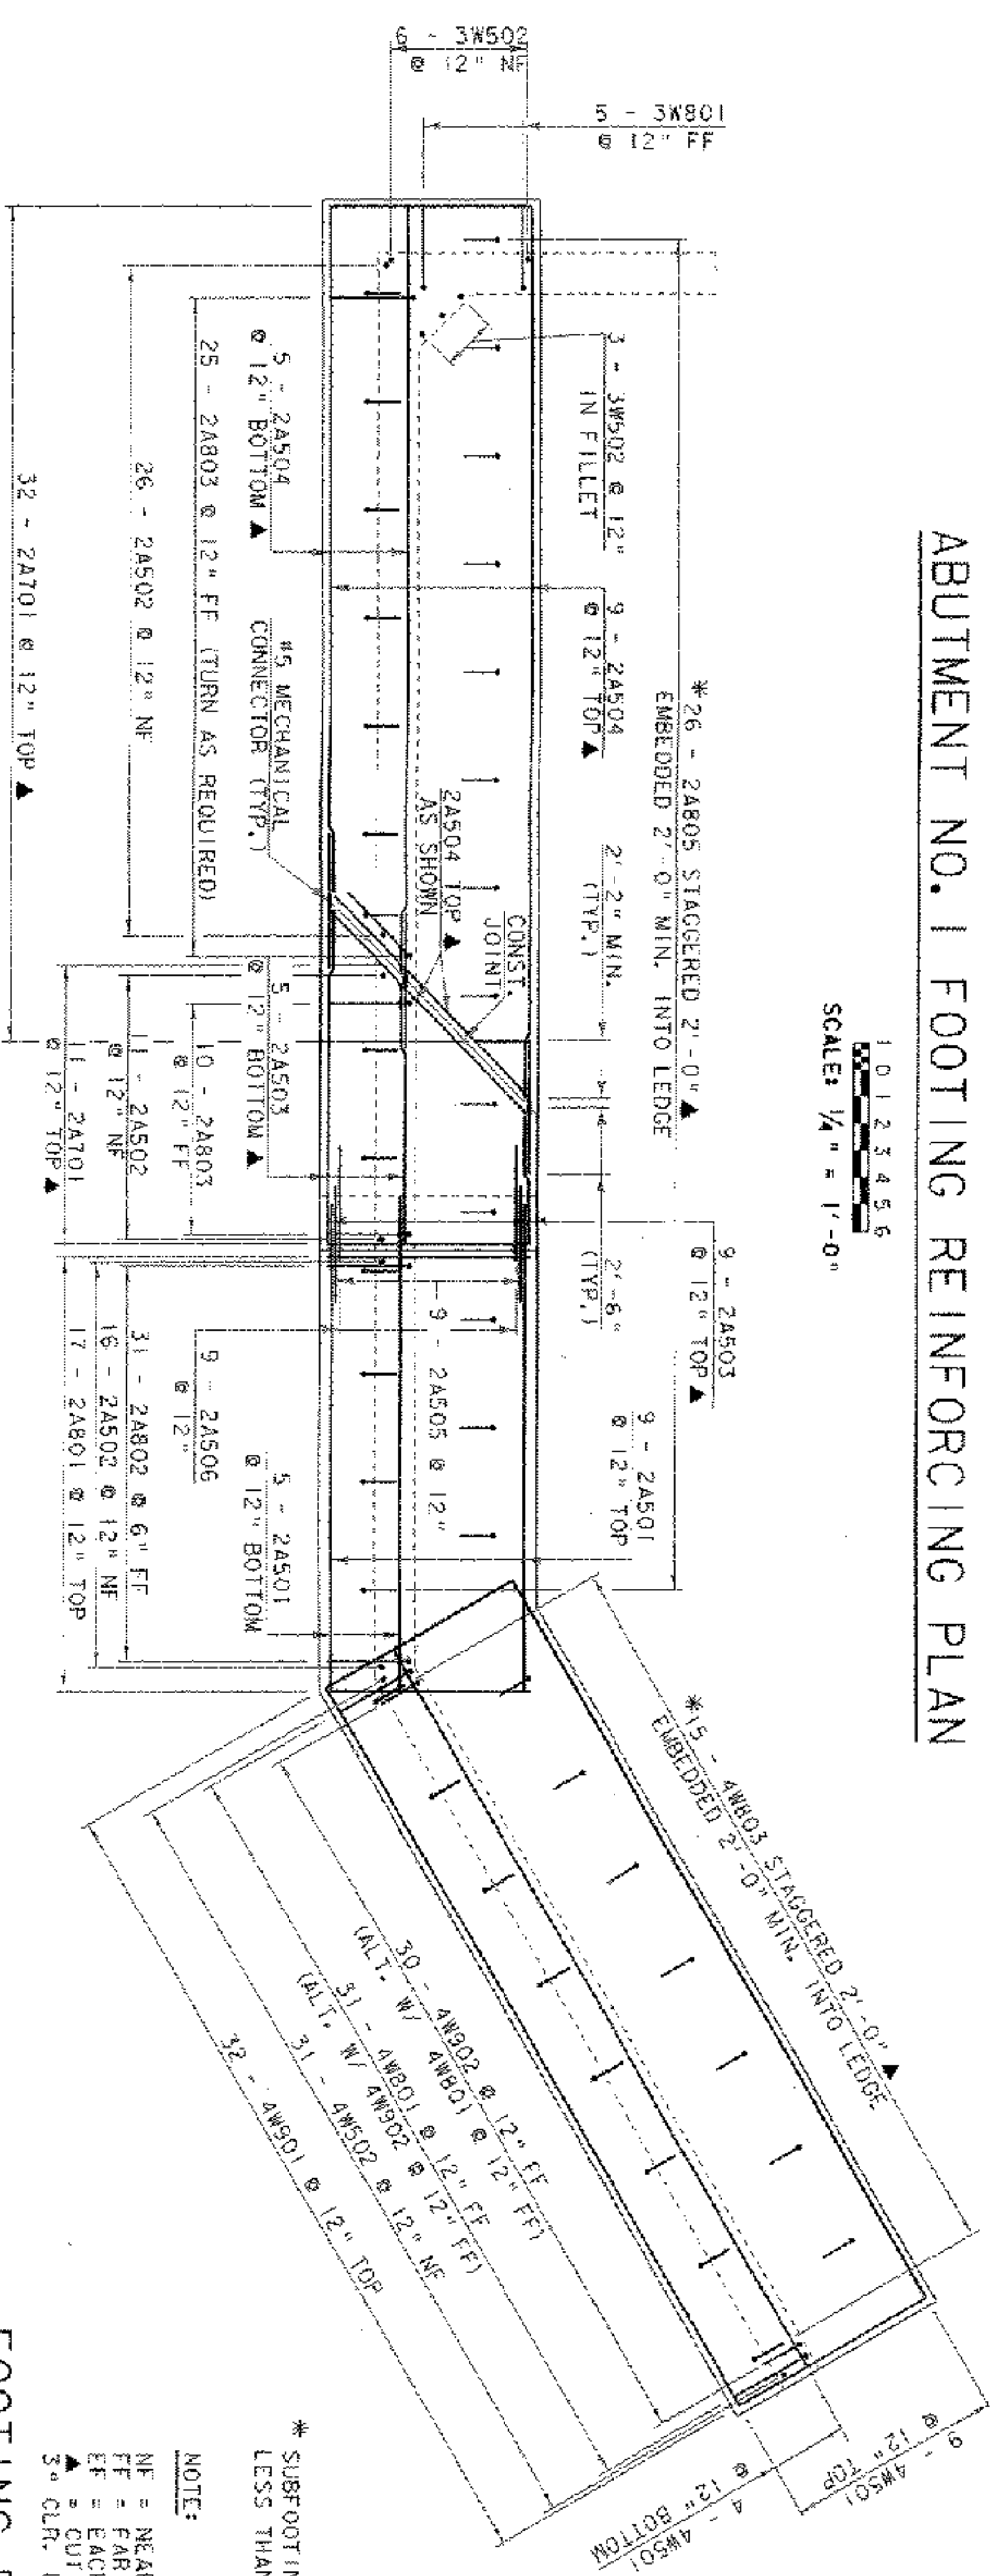

ABUTMENT NO. 2 FOOTING REINFORCING PLAN

FOOTING REINFORCING PLAN

\* SUBFOOTING STEEL: OMIT IF LEDGE IS  
 LESS THAN 3" BELOW BOTTOM OF FOOTING.

NOTE:  
 NF = NEAR FACE  
 FF = FAR FACE  
 EF = EACH FACE  
 ▲ = CUT TO FIT IN FIELD  
 3" CLR. UNLESS OTHERWISE NOTED

PROJECT NAME:	ROCKINGHAM
PROJECT NUMBER:	TH2 - 9103
FILE NAME:	906053\structure\sc053ft91
PROJECT MANAGER:	R. R. WHITCOMB
DESIGNED BY:	G. ROY
PLOT DATE:	20-MAR-2003
DRAWN BY:	L. BULLOCK
CHECKED BY:	G. ROY
SHEET	27 OF 38