


* EXACT LOCATION OF 18" DIA. RCP TO BE DETERMINED IN THE FIELD BY THE RESIDENT ENGINEER AND THE CONTRACTOR. (SEE DRAINAGE DETAIL FOR PIPE NO. 6 ON GRANITON-ROCK INGHAM STP 0126(4)S PROJECT.)

ABUTMENT NO. 1 PLAN

SCALE: 1/4" = 1'-0"

CONSPAN PRECAST
CONCRETE ARCH USED
VALUE ENGINEERING
SEE PAGES 040 TO 088.

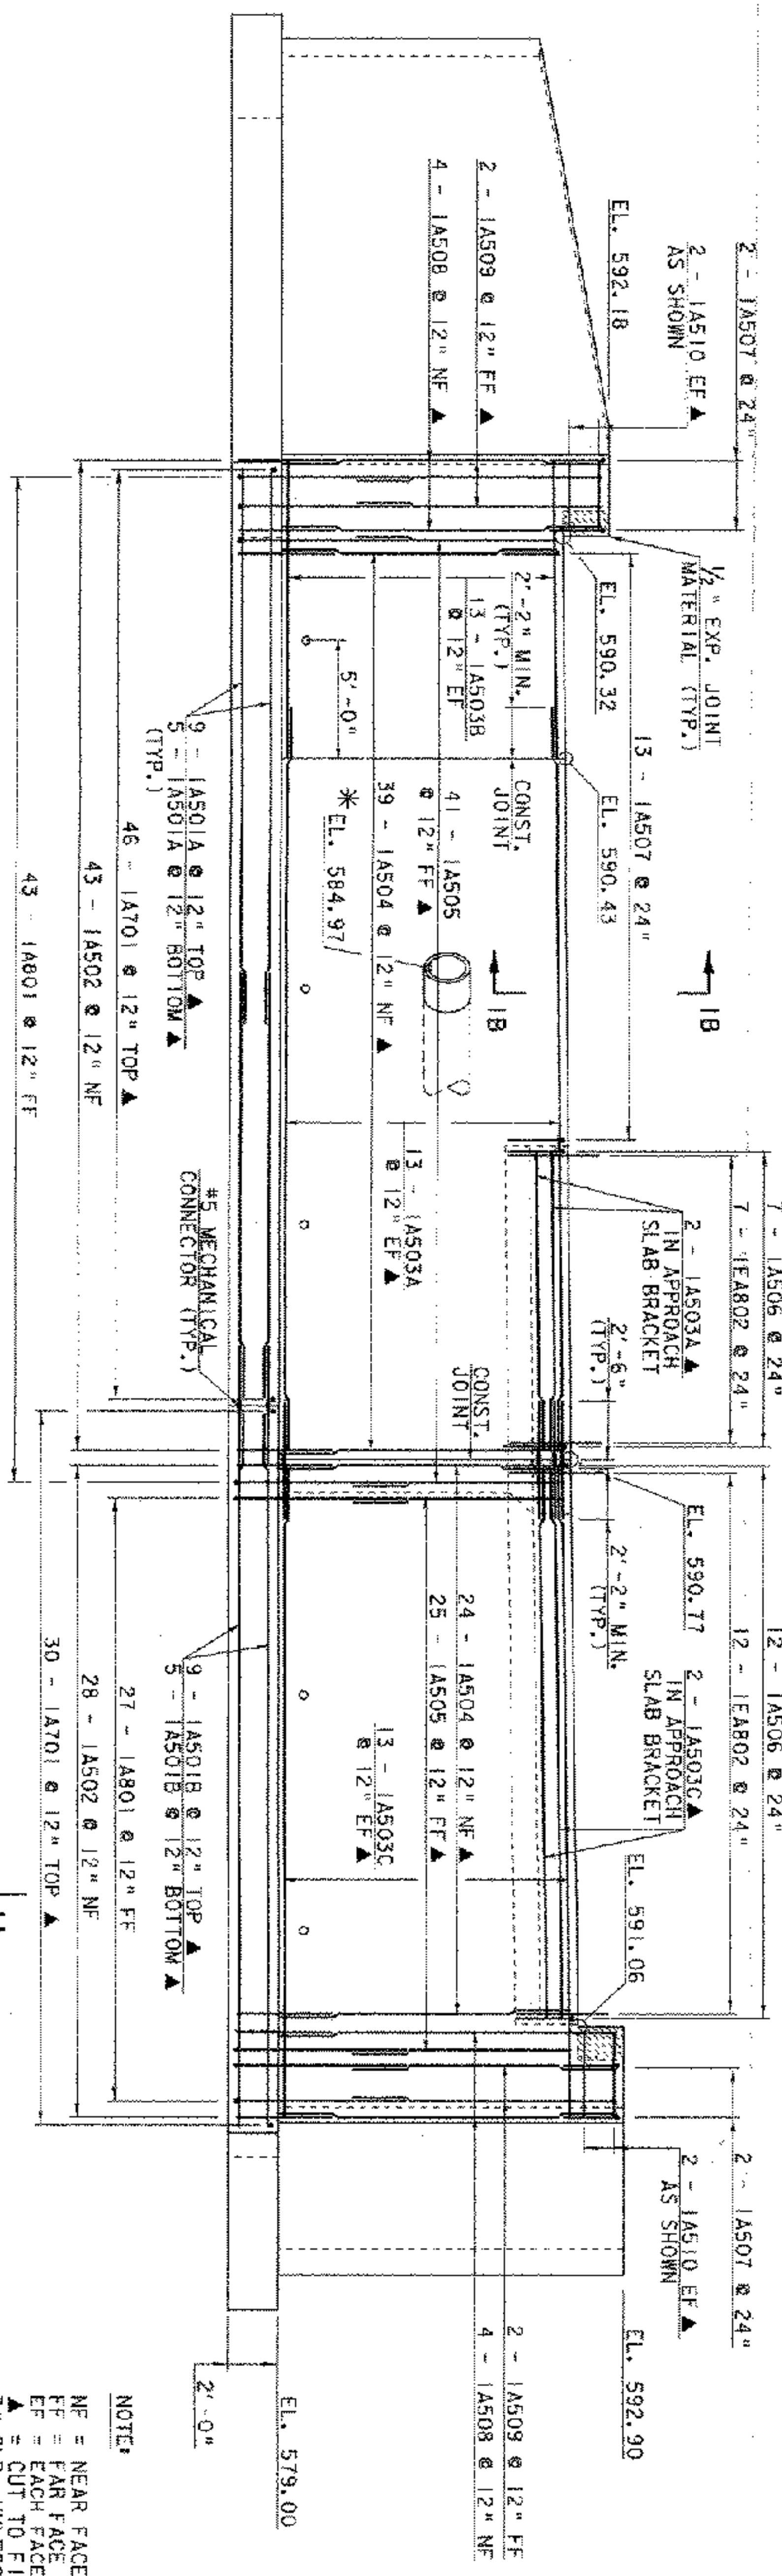

ABUTMENT NO. 1 ELEVATION

SCALE: 1/4" = 1'-0"

ABUTMENT NO. 1 DETAILS

NOTE:
NF = NEAR FACE
FF = FAR FACE
EF = EACH FACE
▲ = CUT TO FIT IN FIELD
3" CLR. UNLESS OTHERWISE NOTED

PROJECT NAME:	ROCKINGHAM	PROJECT NUMBER:	TH2 - 9103
FILE NAME:	90c053\struc\th2\as053\dht	PLOT DATE:	21-OCT-2003
PROJECT MANAGER:	R.R. WHITCOMB	DRAWN BY:	L. BULLOCK
DESIGNED BY:	G. ROY	CHECKED BY:	G. ROY
		SHEET	28 OF 38