


ABUTMENT NO. 2 PLAN

SCALE: 1/4" = 1'-0"

CONSPAN PRECAST
 CONCRETE ARCH USED
 VALUE ENGINEERING
 SEE PAGES 040 TO 088.

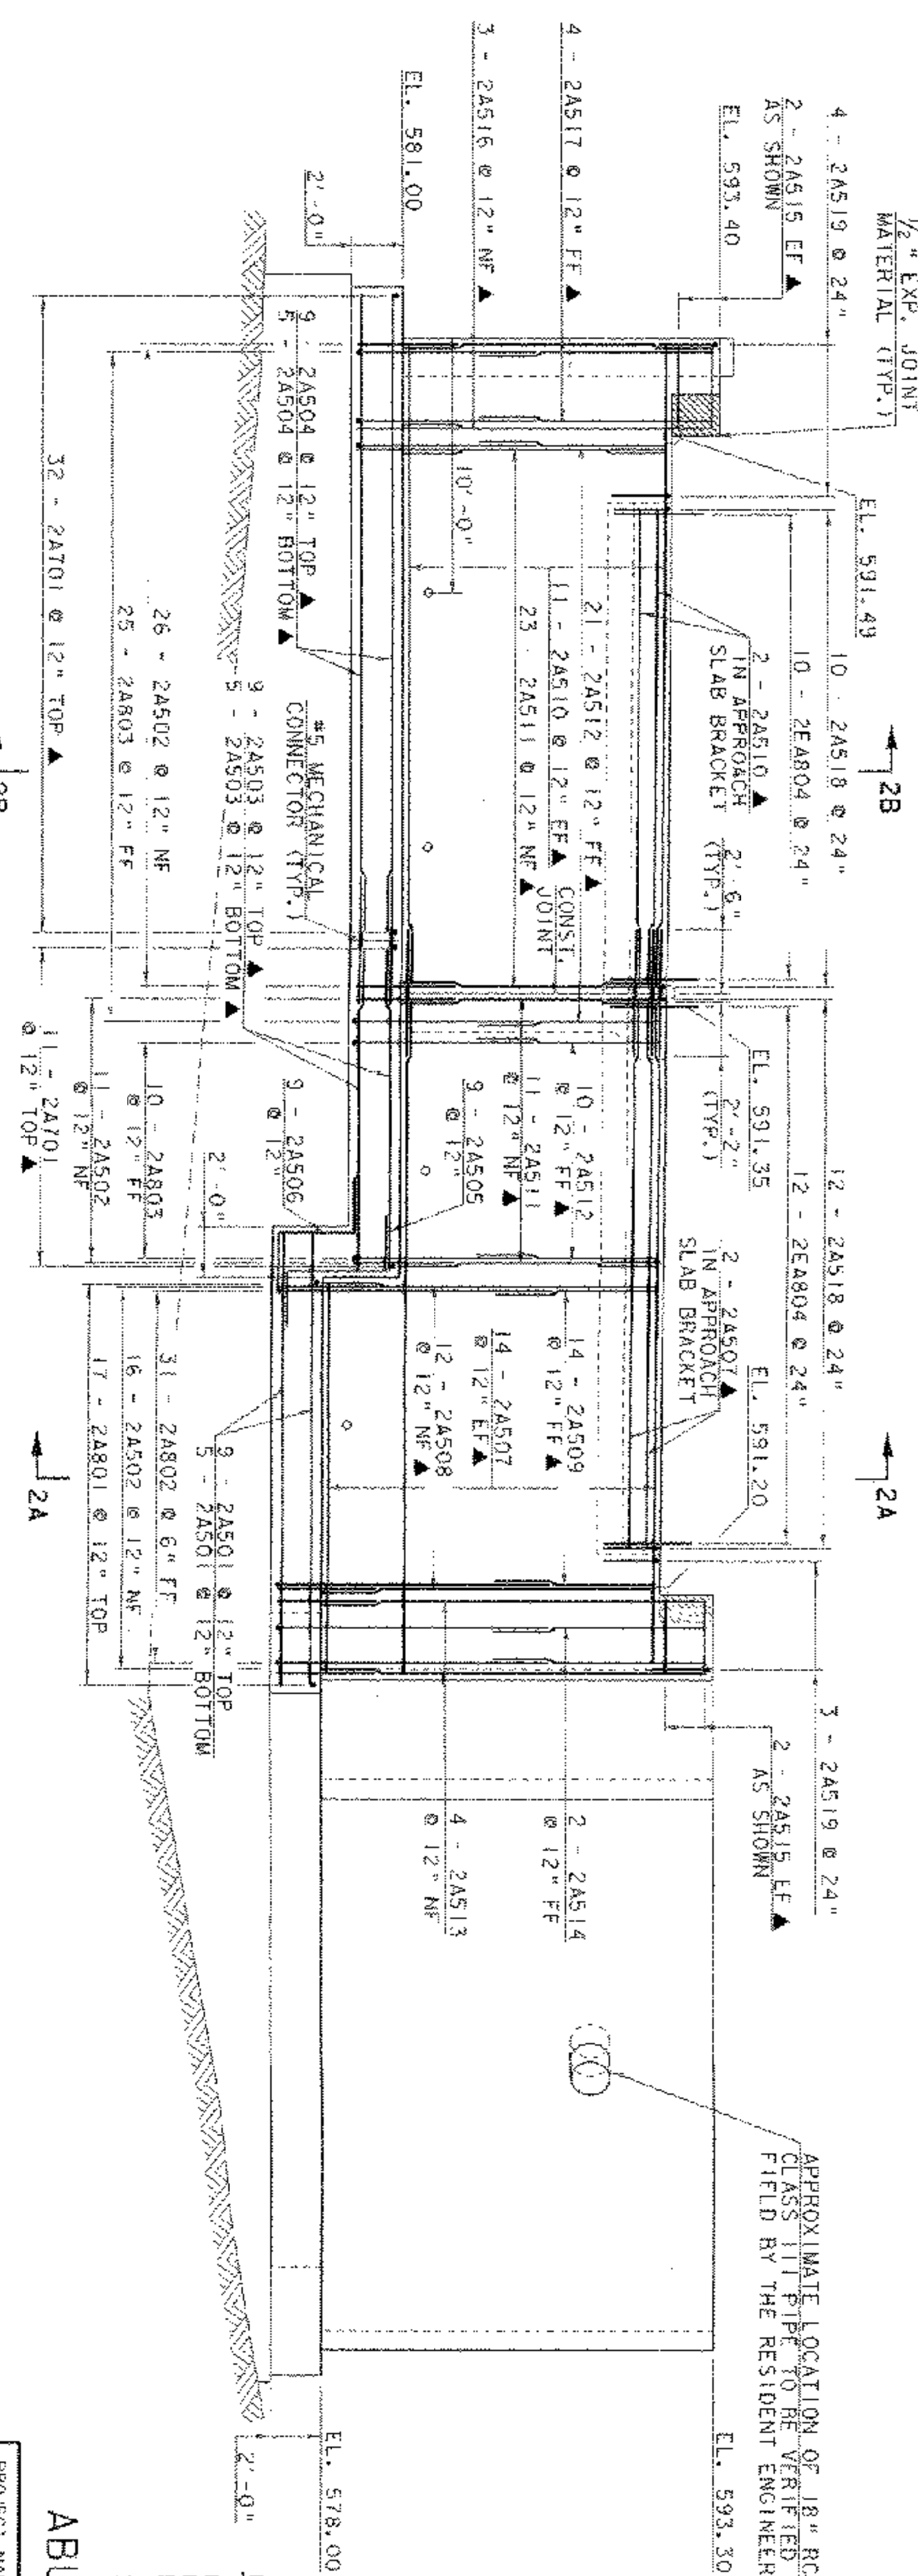

ABUTMENT NO. 2 ELEVATION

SCALE: 1/4" = 1'-0"

ABUTMENT NO. 2 DETAILS

NOTE:
 NF = NEAR FACE
 FF = FAR FACE
 EF = EACH FACE
 ▲ = CUT TO FIT IN FIELD
 3" CLR. UNLESS OTHERWISE NOTED

PROJECT NAME: ROCKINGHAM
 PROJECT NUMBER: TH2 - 9103
 FILE NAME: S05053\structure\est\sc053d21
 PROJECT MANAGER: R.F. WHITCOMB
 DESIGNED BY: G. ROY
 PLOT DATE: 19-AUG-2003
 DRAWN BY: L. BILLOCK
 CHECKED BY: G. ROY
 SHEET 29 OF 38