



345+00
 AREA: 675
 68%
 68%
 2012/3 = 69.015F

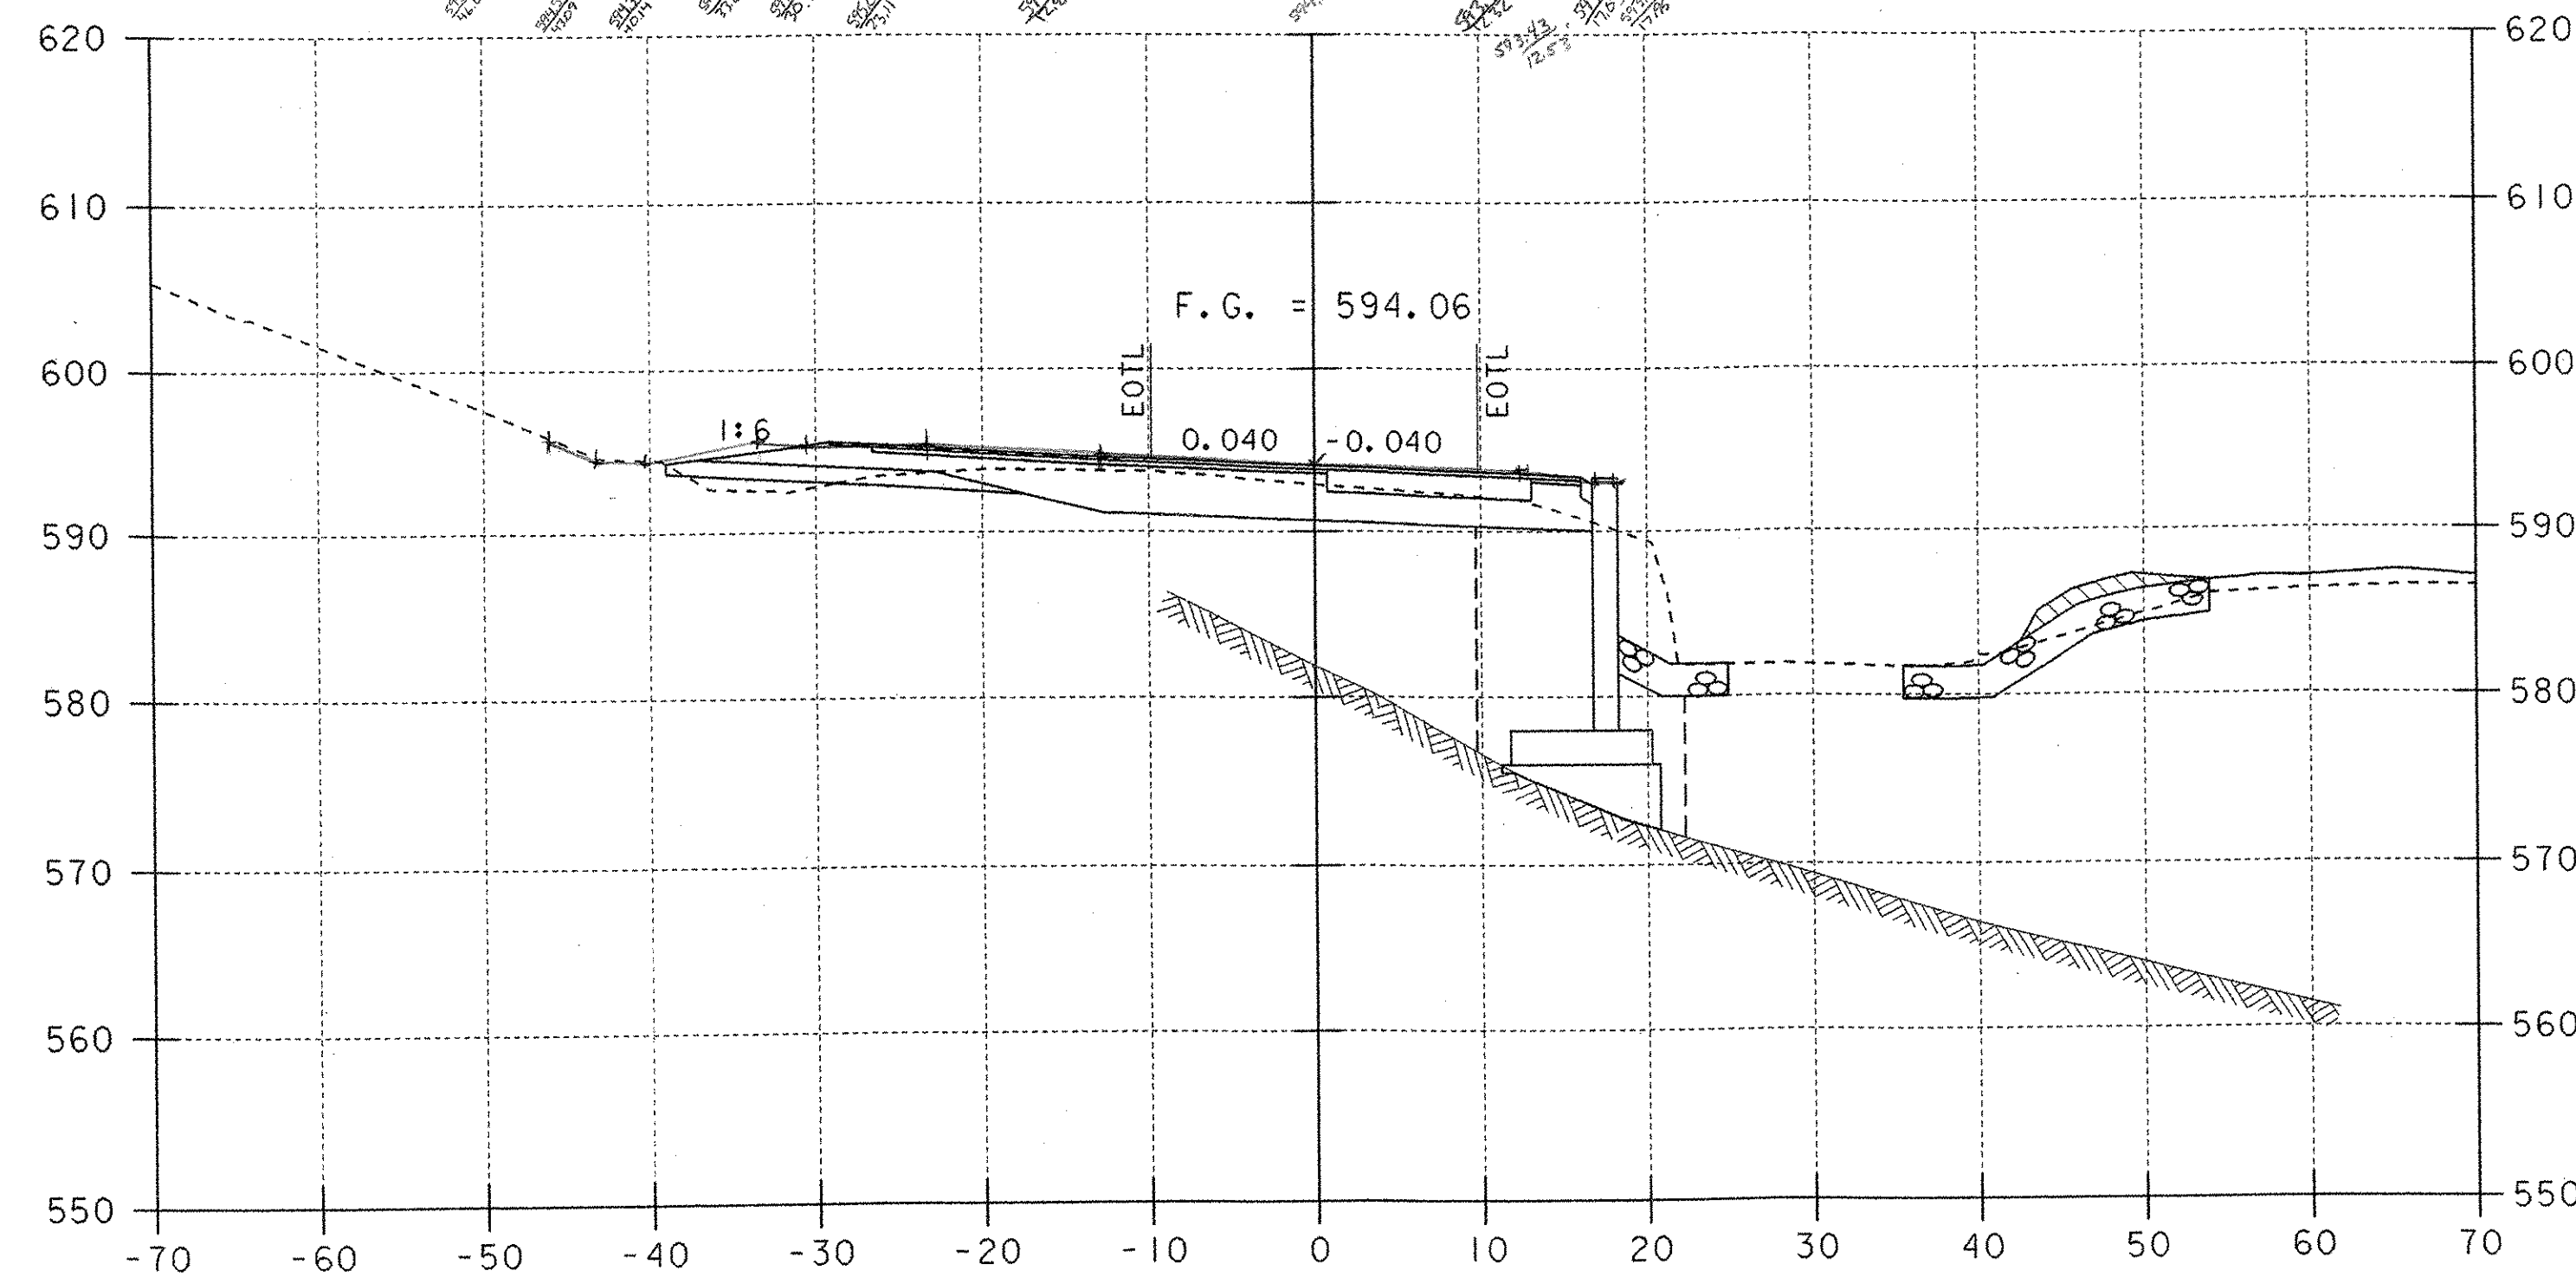

344+75
 AREA: 7754
 76.82
 76.82
 232.41/3 = 77.47

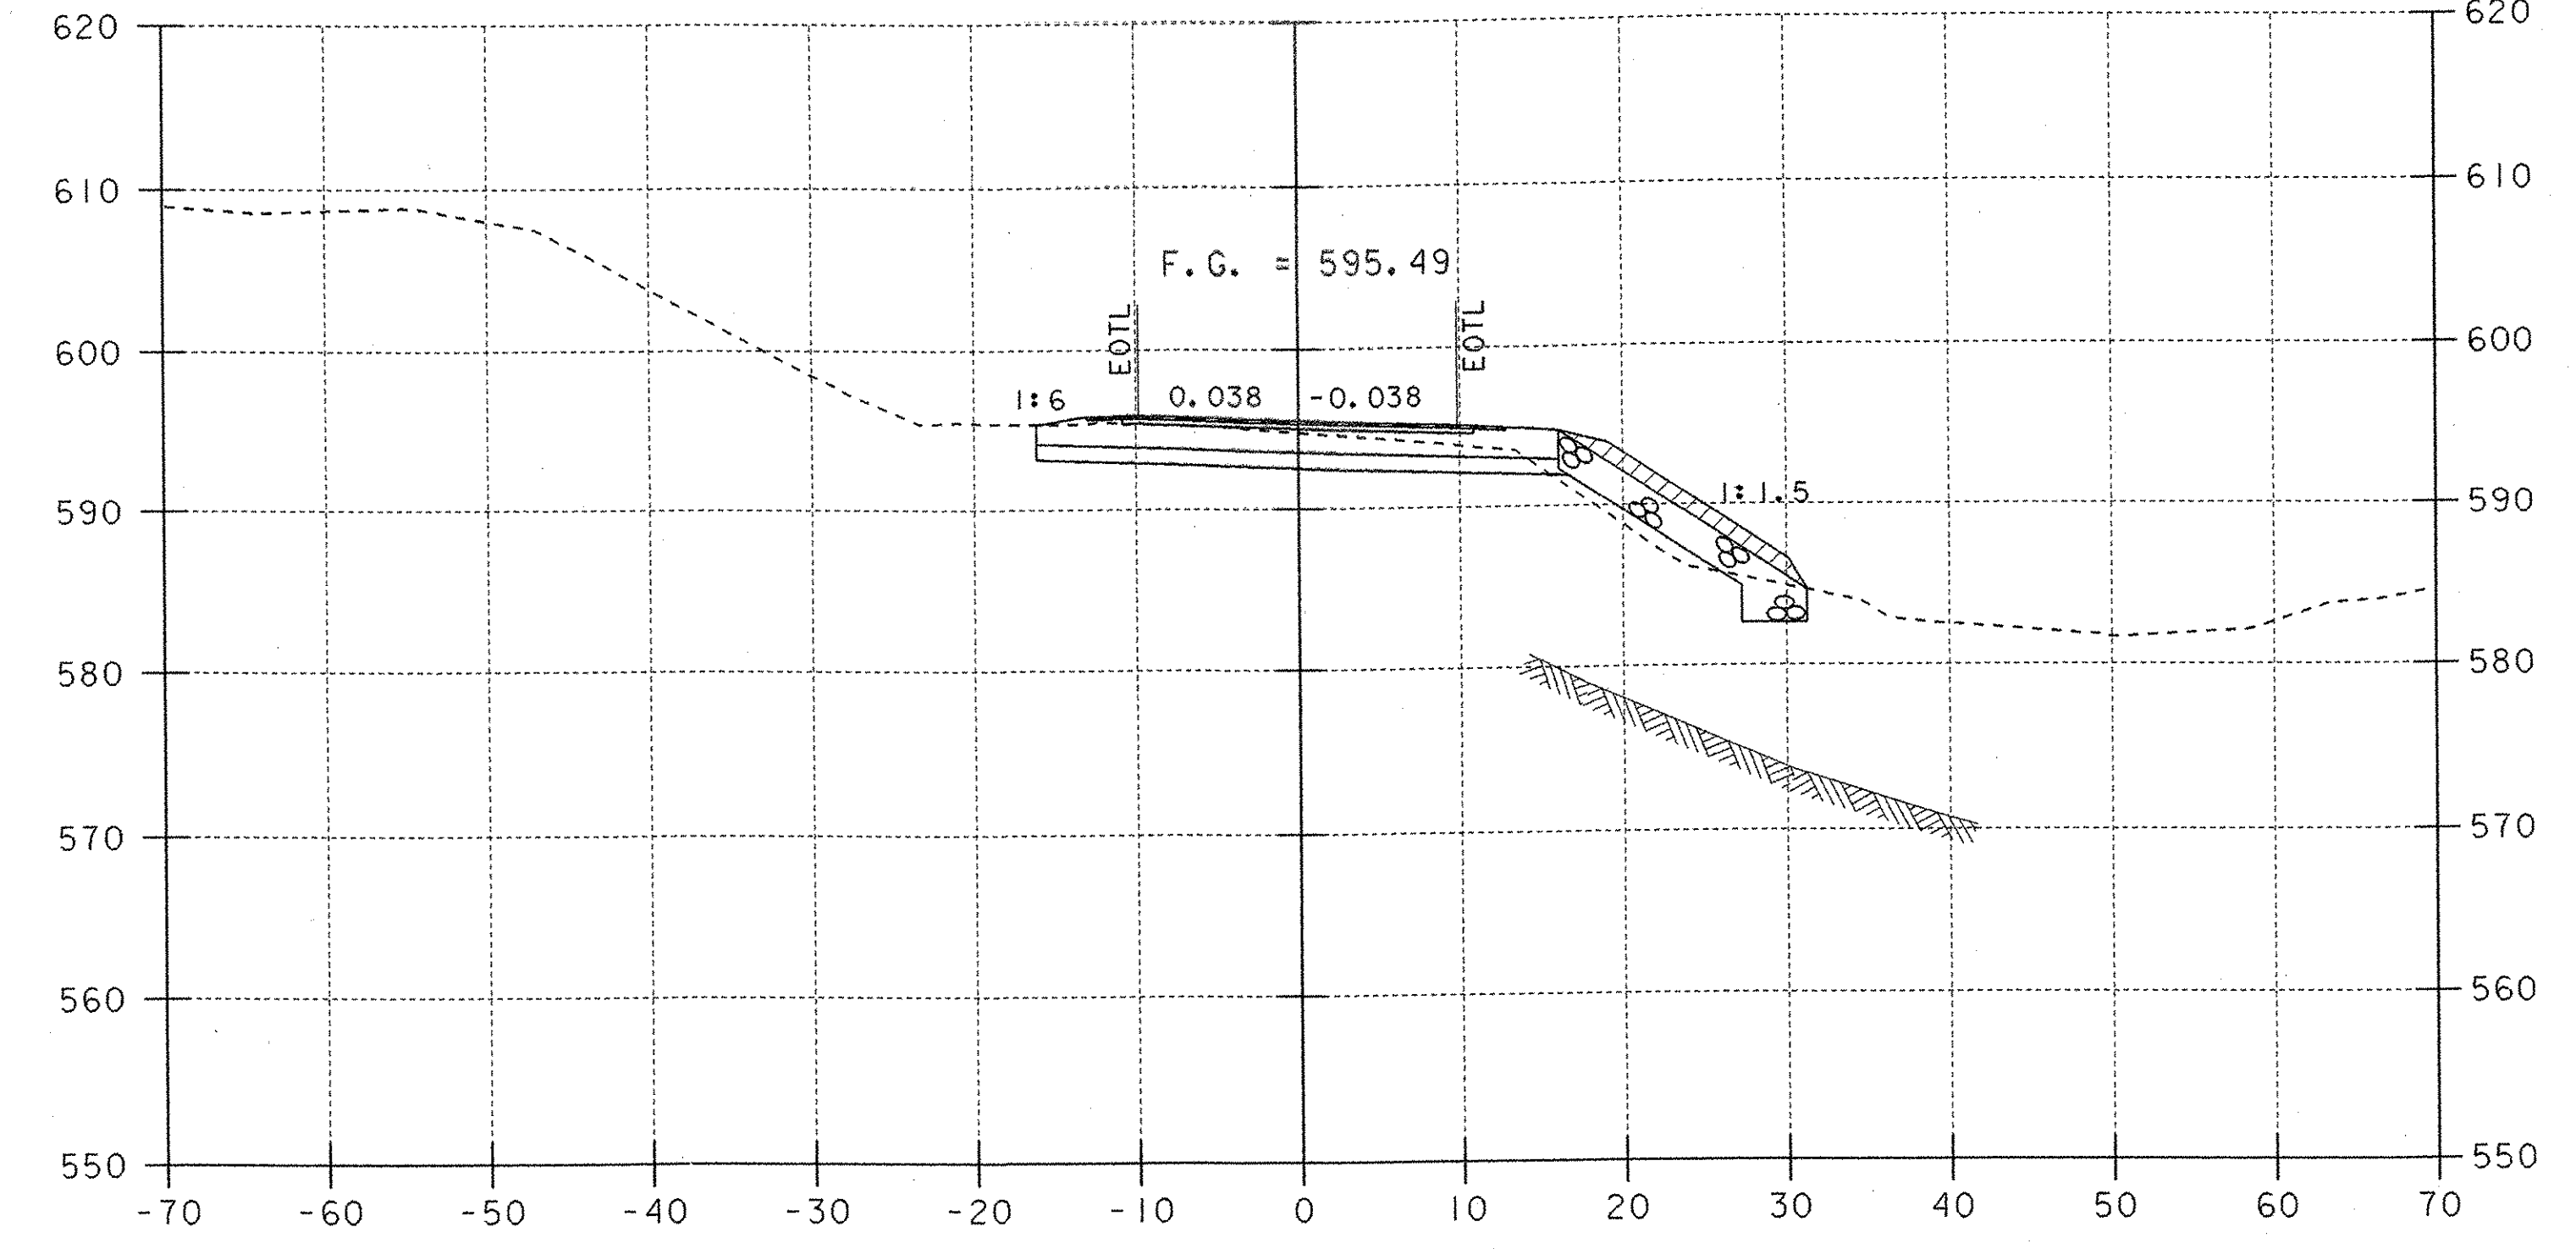

END PROJECT TH2-9103
 RESUME PROJECT STP 0126 (4) S
 ENGLISH STA. 345+14.44 =
 METRIC STA. 10+520.000

345+14.44

10 0 10
 SCALE: 1" = 10'-0"

ROADWAY CROSS SECTION (2)

PROJECT NAME: ROCKINGHAM	FILE NAME: 90c053\structures\sc053m02.i	PLOT DATE: 20-MAR-2003
PROJECT NUMBER: TH2 - 9103	PROJECT MANAGER: R. R. WHITCOMB	DRAWN BY: G. ROY
	DESIGNED BY: G. ROY	CHECKED BY: R. WHITCOMB
		SHEET 34 OF 38

Handwritten signature/initials