



51+20

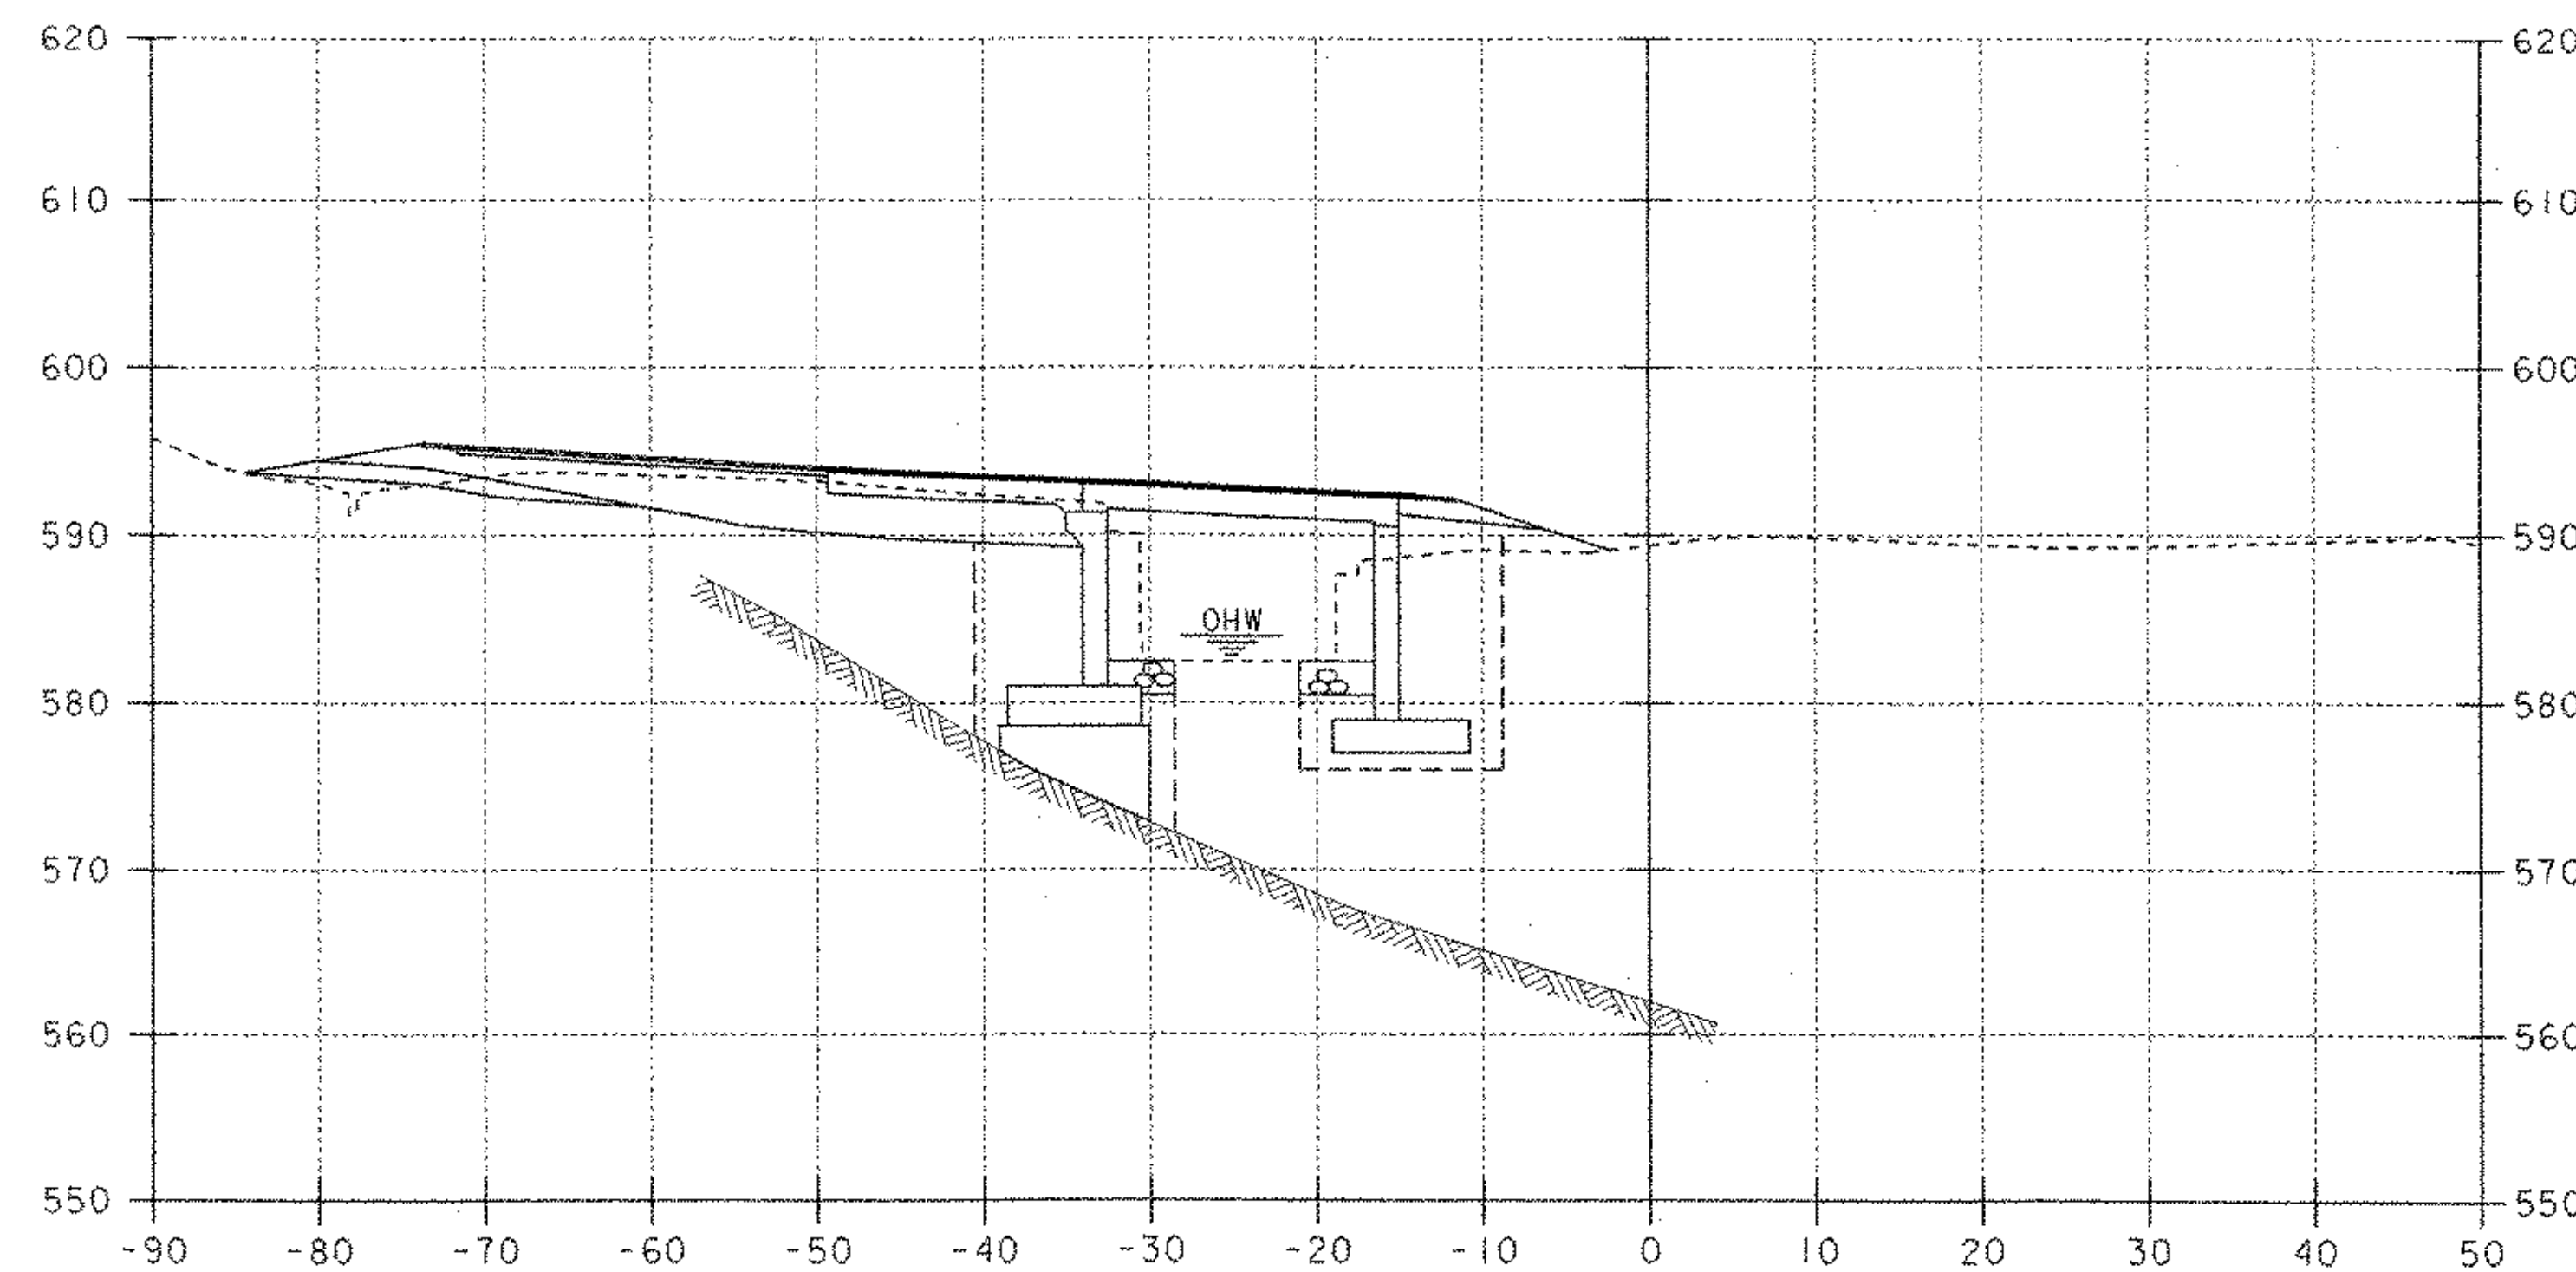


51+40

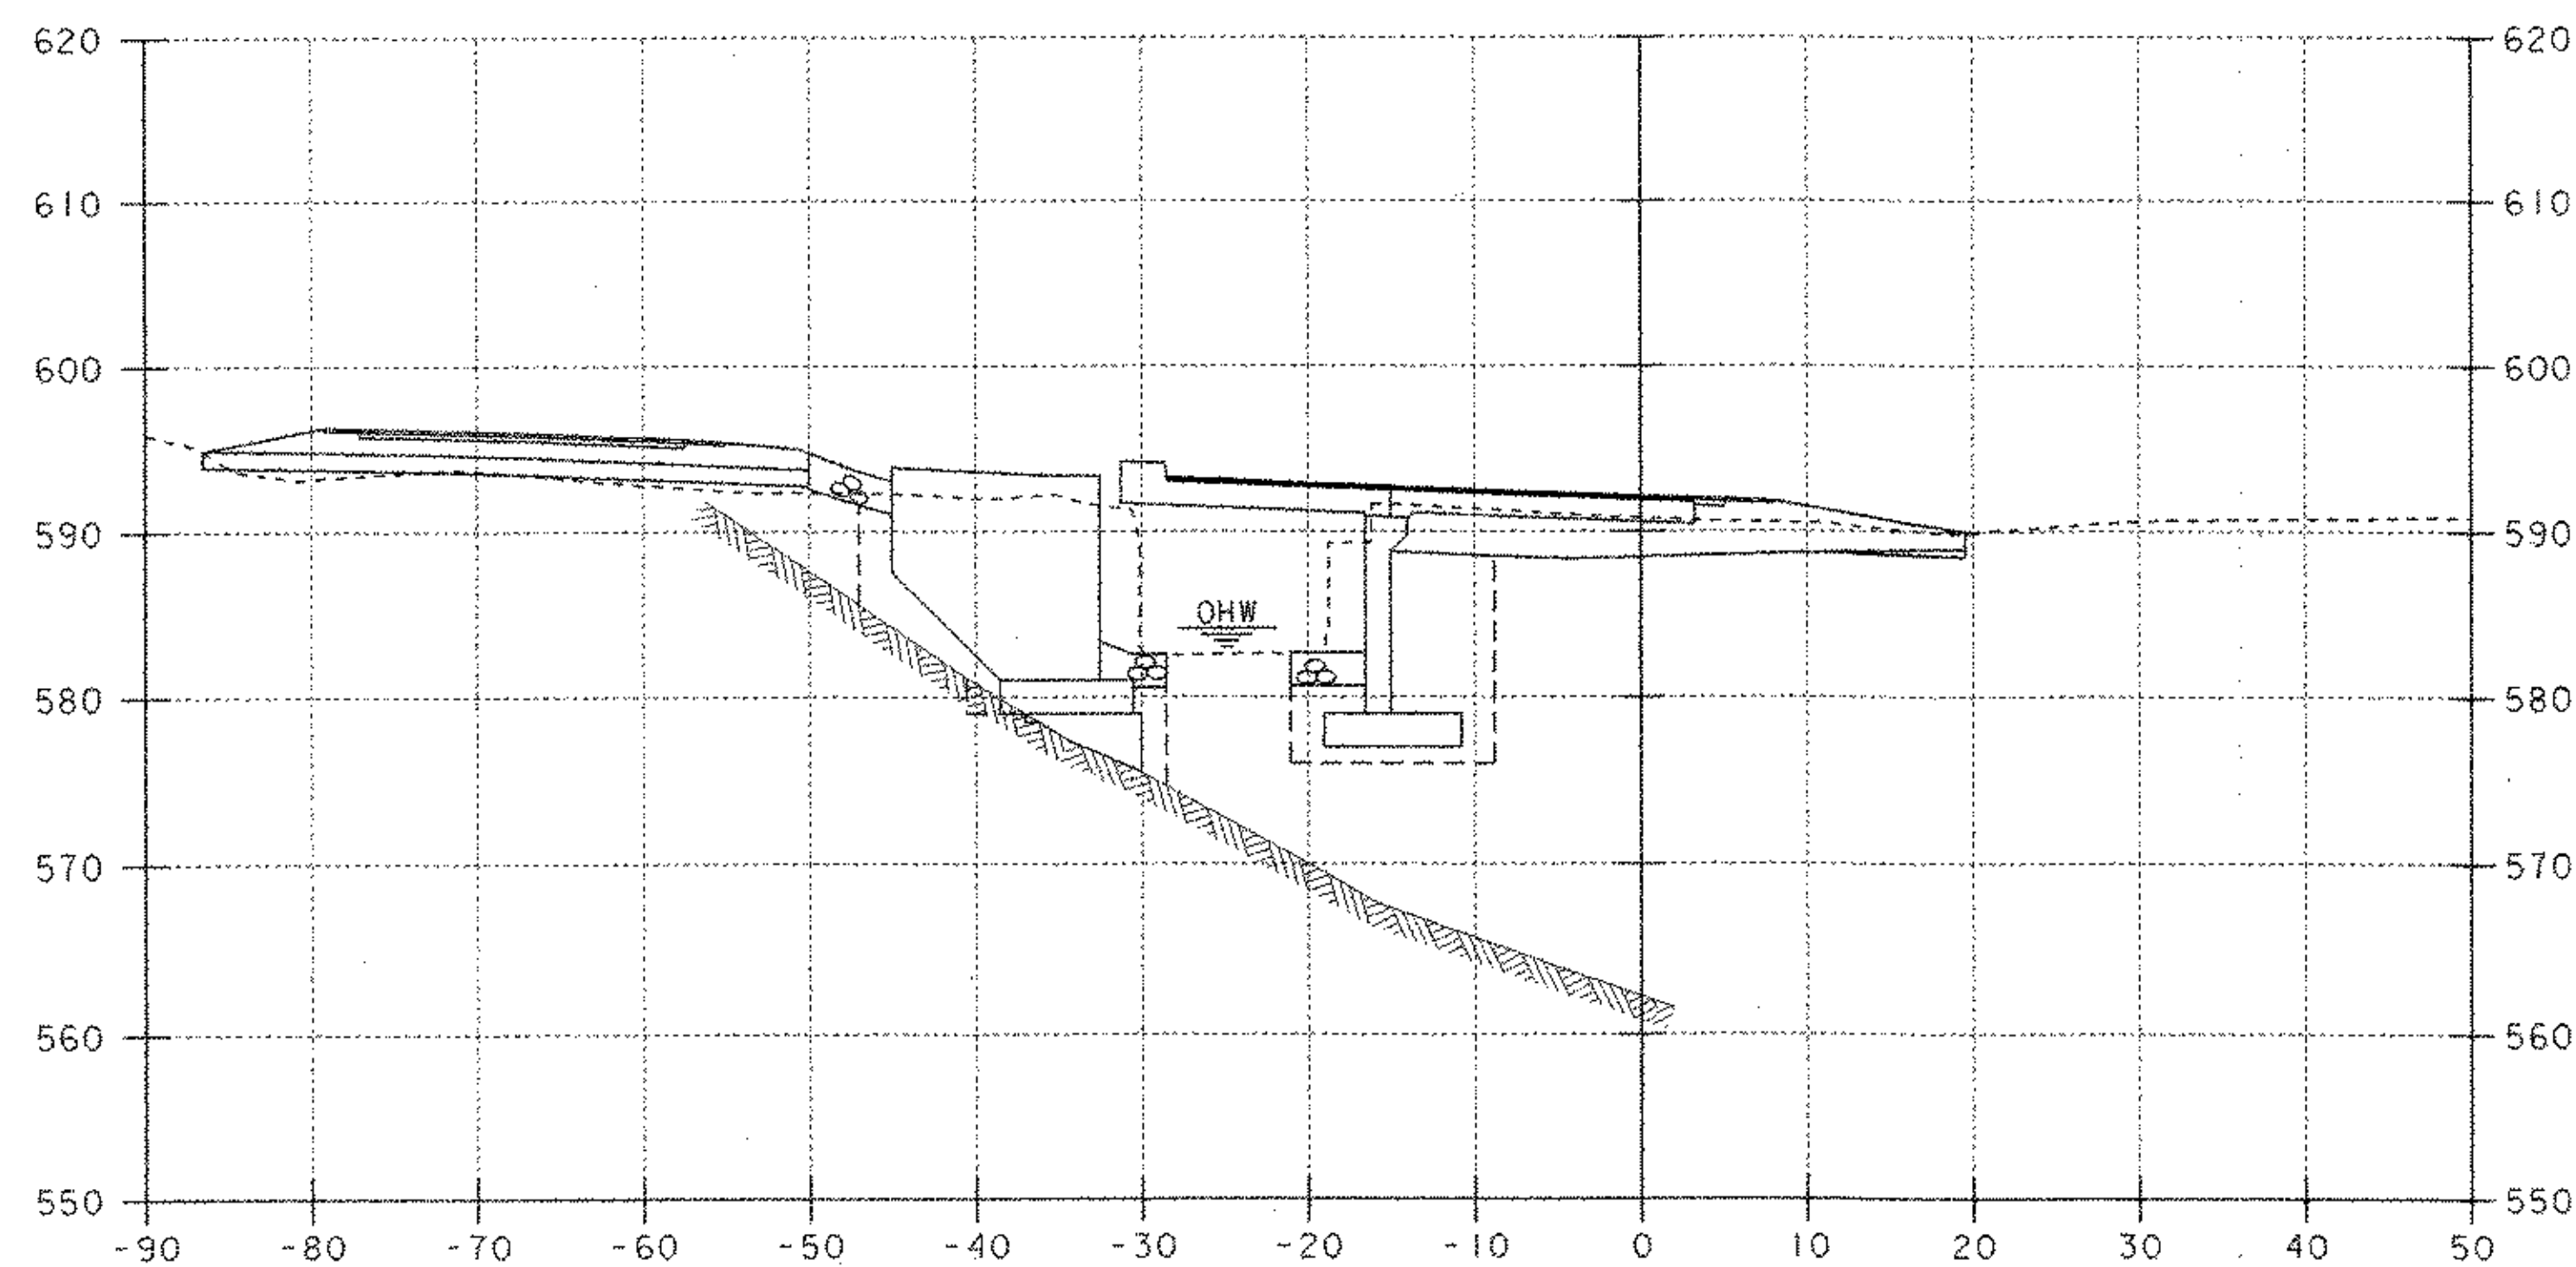

51+10

STA. 51+05.1 LT.
BEGIN GRAN. BACKFILL FOR STRUCTURES

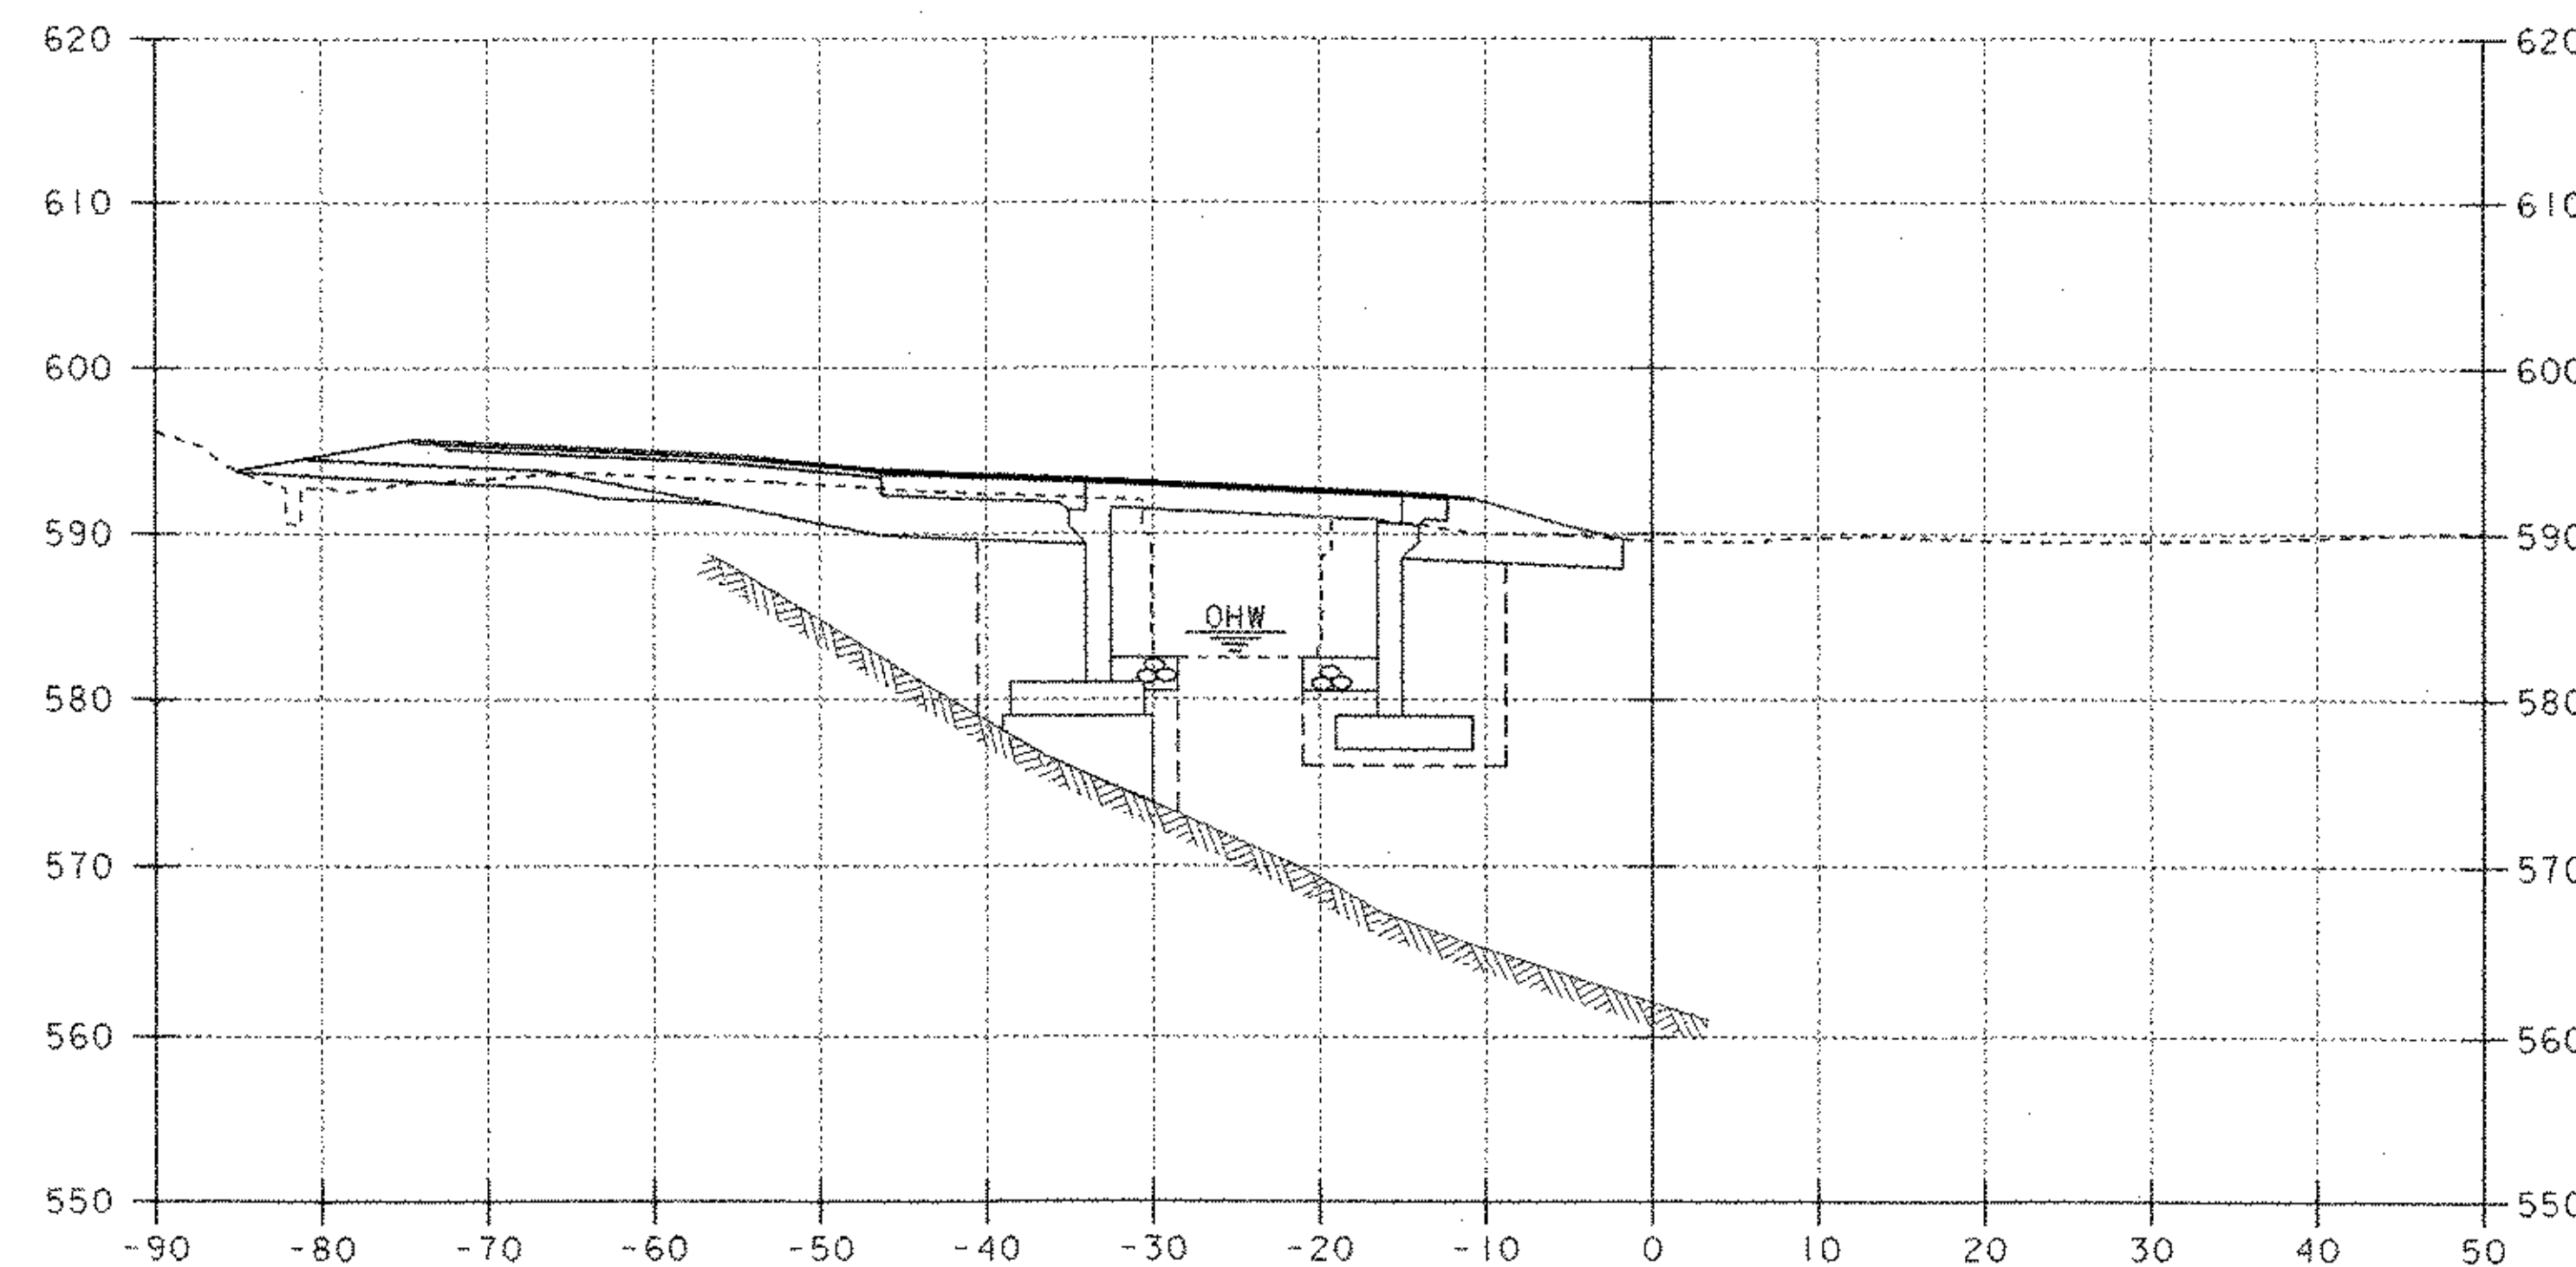

51+30

CHANNEL CROSS SECTIONS (2)

10 0 10
SCALE: 1" = 10'-0"

PROJECT NAME: ROCKINGHAM	PLOT DATE: 20-MAR-2003
PROJECT NUMBER: TH2 - 9103	DRAWN BY: G. ROY
FILE NAME: 90c053\structures\sc053c02.1	CHECKED BY: R. WHITCOMB
DESIGNED BY: G. ROY	SHEET 36 OF 38