


STA. 51+91.9 LT.  
END GRAN. BACKFILL FOR STRUCTURES

52+00

STA. 51+90.9 LT.  
END UNCLASS. CHANNEL EXCAVATION  
GEOTEXTILE UNDER STONE FILL  
STONE FILL, TYPE II  
GRUBBING MATERIAL

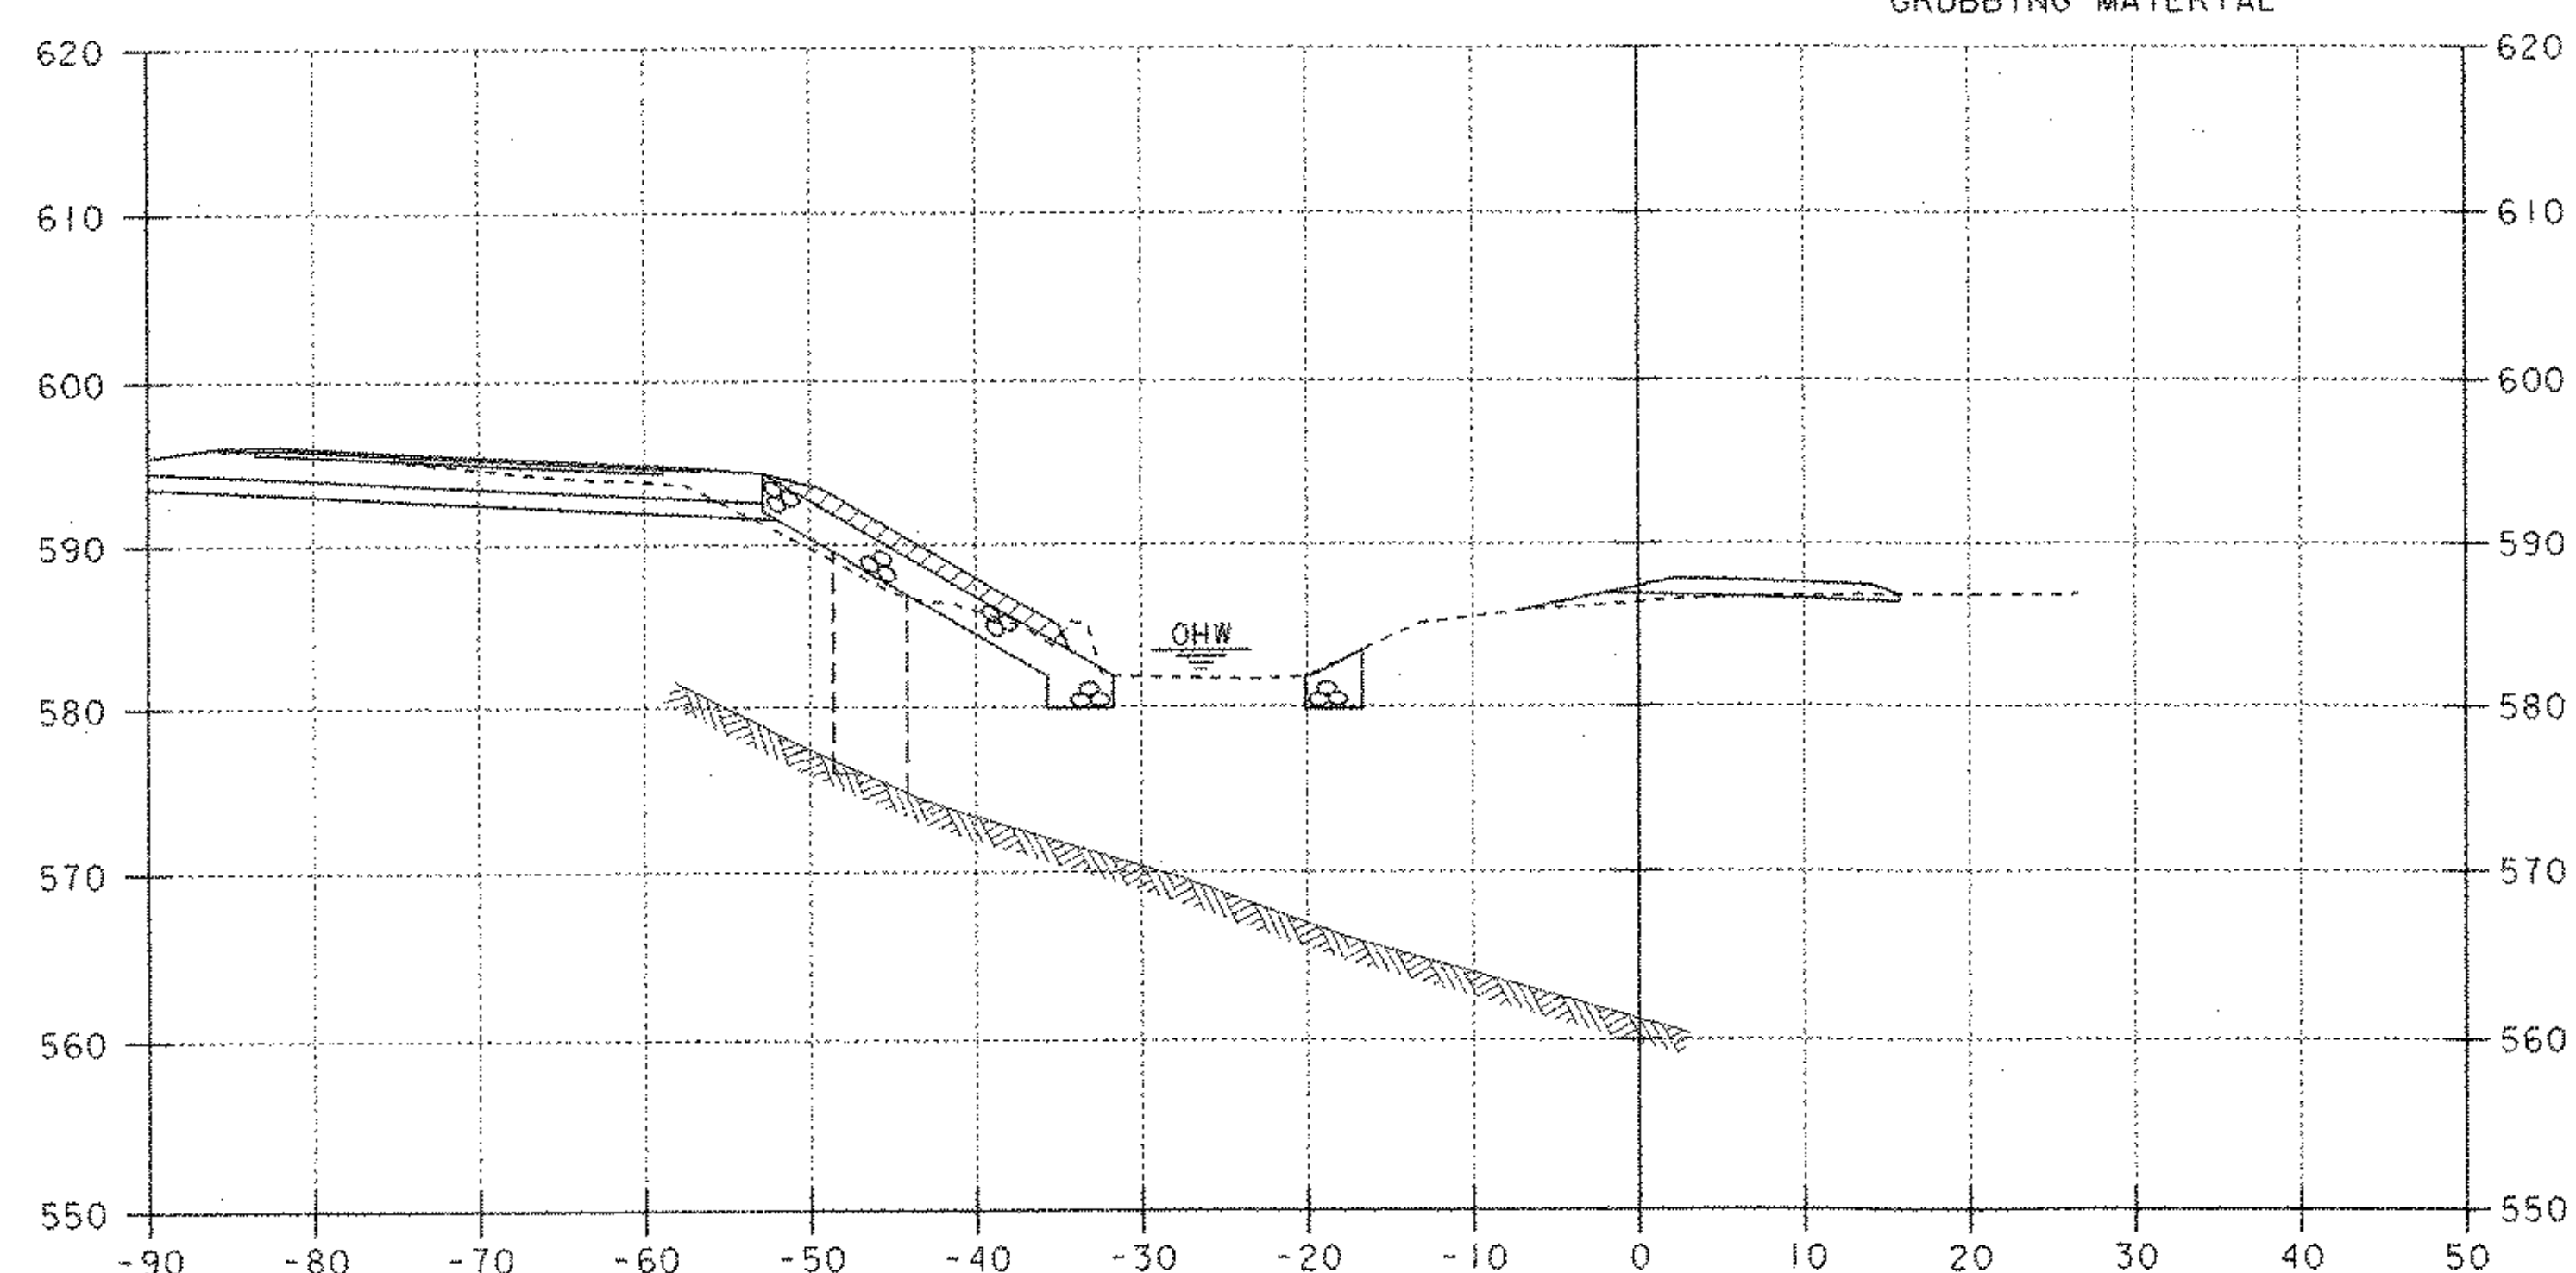

STA. 51+83.5 LT.  
END GRAN. BACKFILL FOR STRUCTURES

51+90

STA. 51+83.5 LT.  
END GRAN. BACKFILL FOR STRUCTURES

10 0 10  
SCALE: 1" = 10'-0"

CHANNEL CROSS SECTIONS (4)

|   |                         |
|---|-------------------------|
| PROJECT NAME: ROCKINGHAM                | PLOT DATE: 20-MAR-2003  |
| PROJECT NUMBER: TH2 - 9103              | DRAWN BY: G. ROY        |
| FILE NAME: 90c053\structures\sc053c04.i | CHECKED BY: R. WHITCOMB |
| DESIGNED BY: G. ROY                     | SHEET 38 OF 38          |