


RECEIVED
 CK'D BY GR CK'D BY B
 8-2004
 AUG 25 2004
 RESUBMIT _____ APPROVED _____
 BY _____ DATE _____

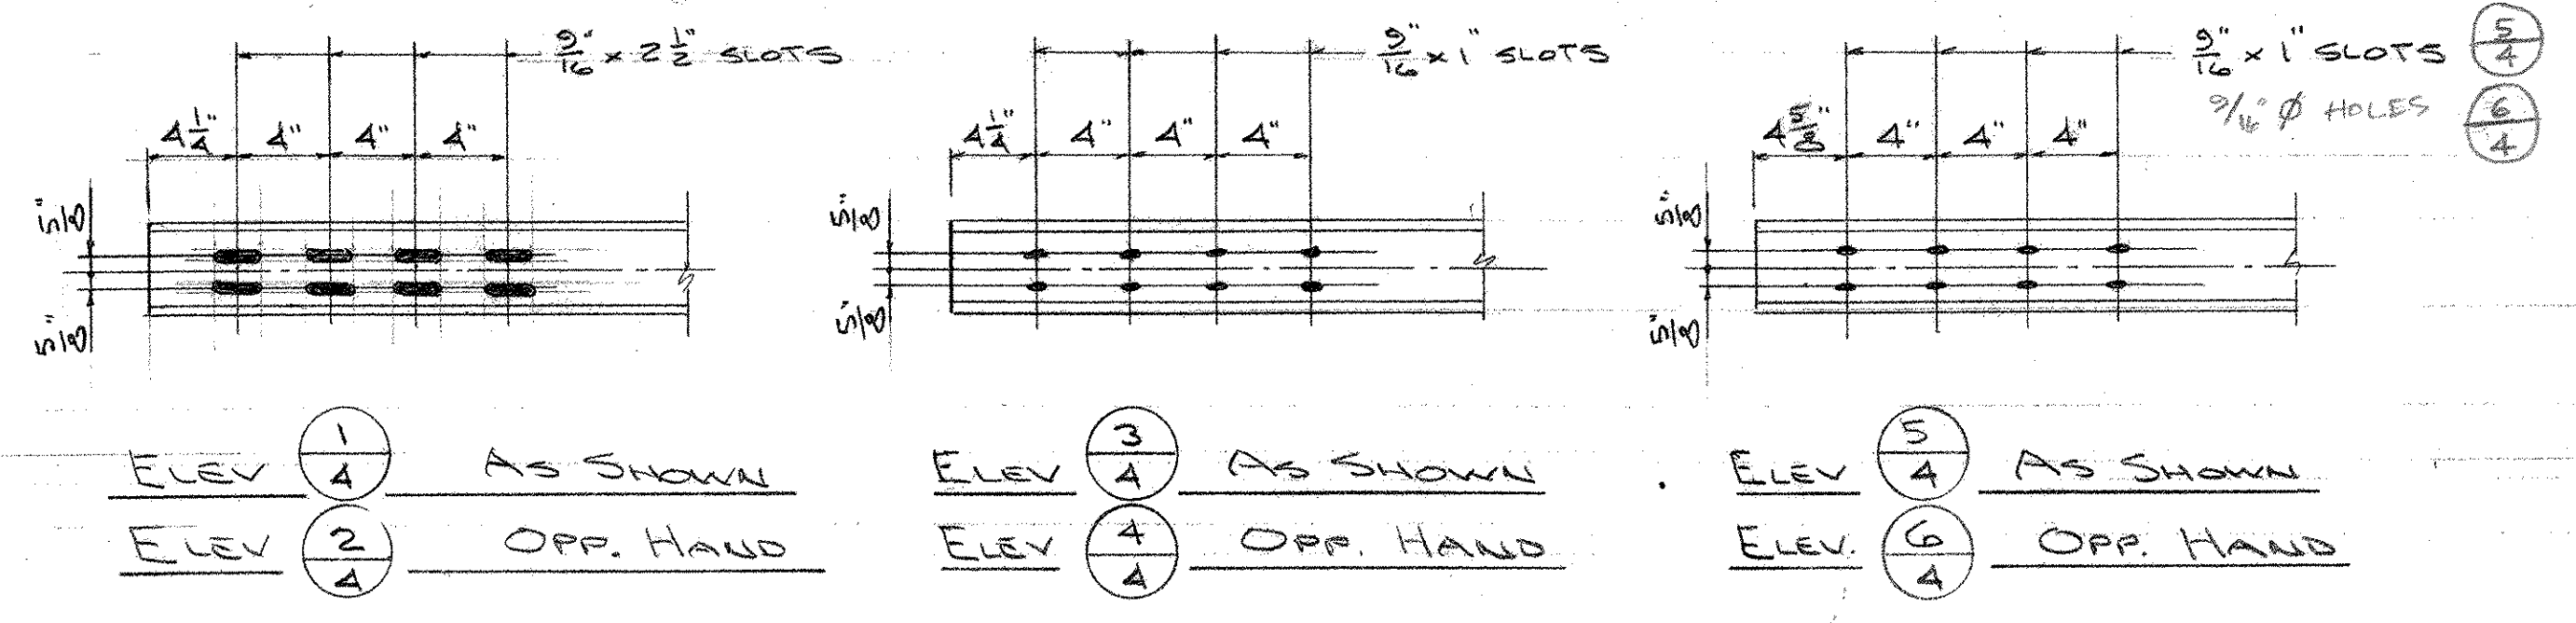

ELEV $\frac{1}{4}$ AS SHOWN
 ELEV $\frac{2}{4}$ OPP. HAND

ELEV $\frac{3}{4}$ AS SHOWN
 ELEV $\frac{4}{4}$ OPP. HAND

ELEV $\frac{5}{4}$ AS SHOWN
 ELEV $\frac{6}{4}$ OPP. HAND

1		8-19-04	FOR APPROVAL	BY <u>AB</u>
ISSUE	DATE	DESCRIPTION	BY	DATE

AUCIELLO IRON WORKS INC
 560 MAIN ST. HUDSON, MA (978) 568-8382

VT. AGENCY OF TRANSPORTATION
 ROCKINGHAM #TH2-9103
 I.H. 2 OVER BEAVER BROOK

ALUM. BRIDGE & APPROACH RAILING

SURFACE PREP: NONE FINISH: MILL FINISH

FOR F.R. LAFAYETTE, INC.
 DR: WM 8-11-04 DWG NO.
 CHK: S 8-18-04 BR-2836

JOB NO. 1340019-1001 SHEET 4 OF 7