


**Notes:**  
 - All edges of Precast to have a 19 [3/4"] chamfer.

**CONSPAN®**  
 BRIDGE SYSTEMS  
 3100 Research Blvd. © 1991  
 P.O. Box 20286  
 Dayton, Ohio 45420-0286  
 (800) 626-3999

**Offices**  
 Dayton, OH (937) 254-2233  
 fax (937) 254-8365  
 Charlotte NC (704) 548-8420  
 Sacramento, CA (916) 787-8701  
 Albany, NY (518) 371-2871

CONSPAN® is a patented system and the furnishing of this drawing does not constitute an express or implied license.

5 - 4877 [16'-0"] Span x 3353 [11'-0"] Rise x 2438 [8'-0"] Long  
 3 - 4877 [16'-0"] Span x 3353 [11'-0"] Rise x 2017 [6'-7 3/8"] Long  
 1 - 4877 [16'-0"] Span x 3353 [11'-0"] Rise Skewed  
 ( 610 [2'-0"] Short Leg x 2362 [7'-9"] Long Leg)  
 Precast Concrete Bridge Units  
 Plus 8 Joints @ 6 [1/4"] ± per Joint

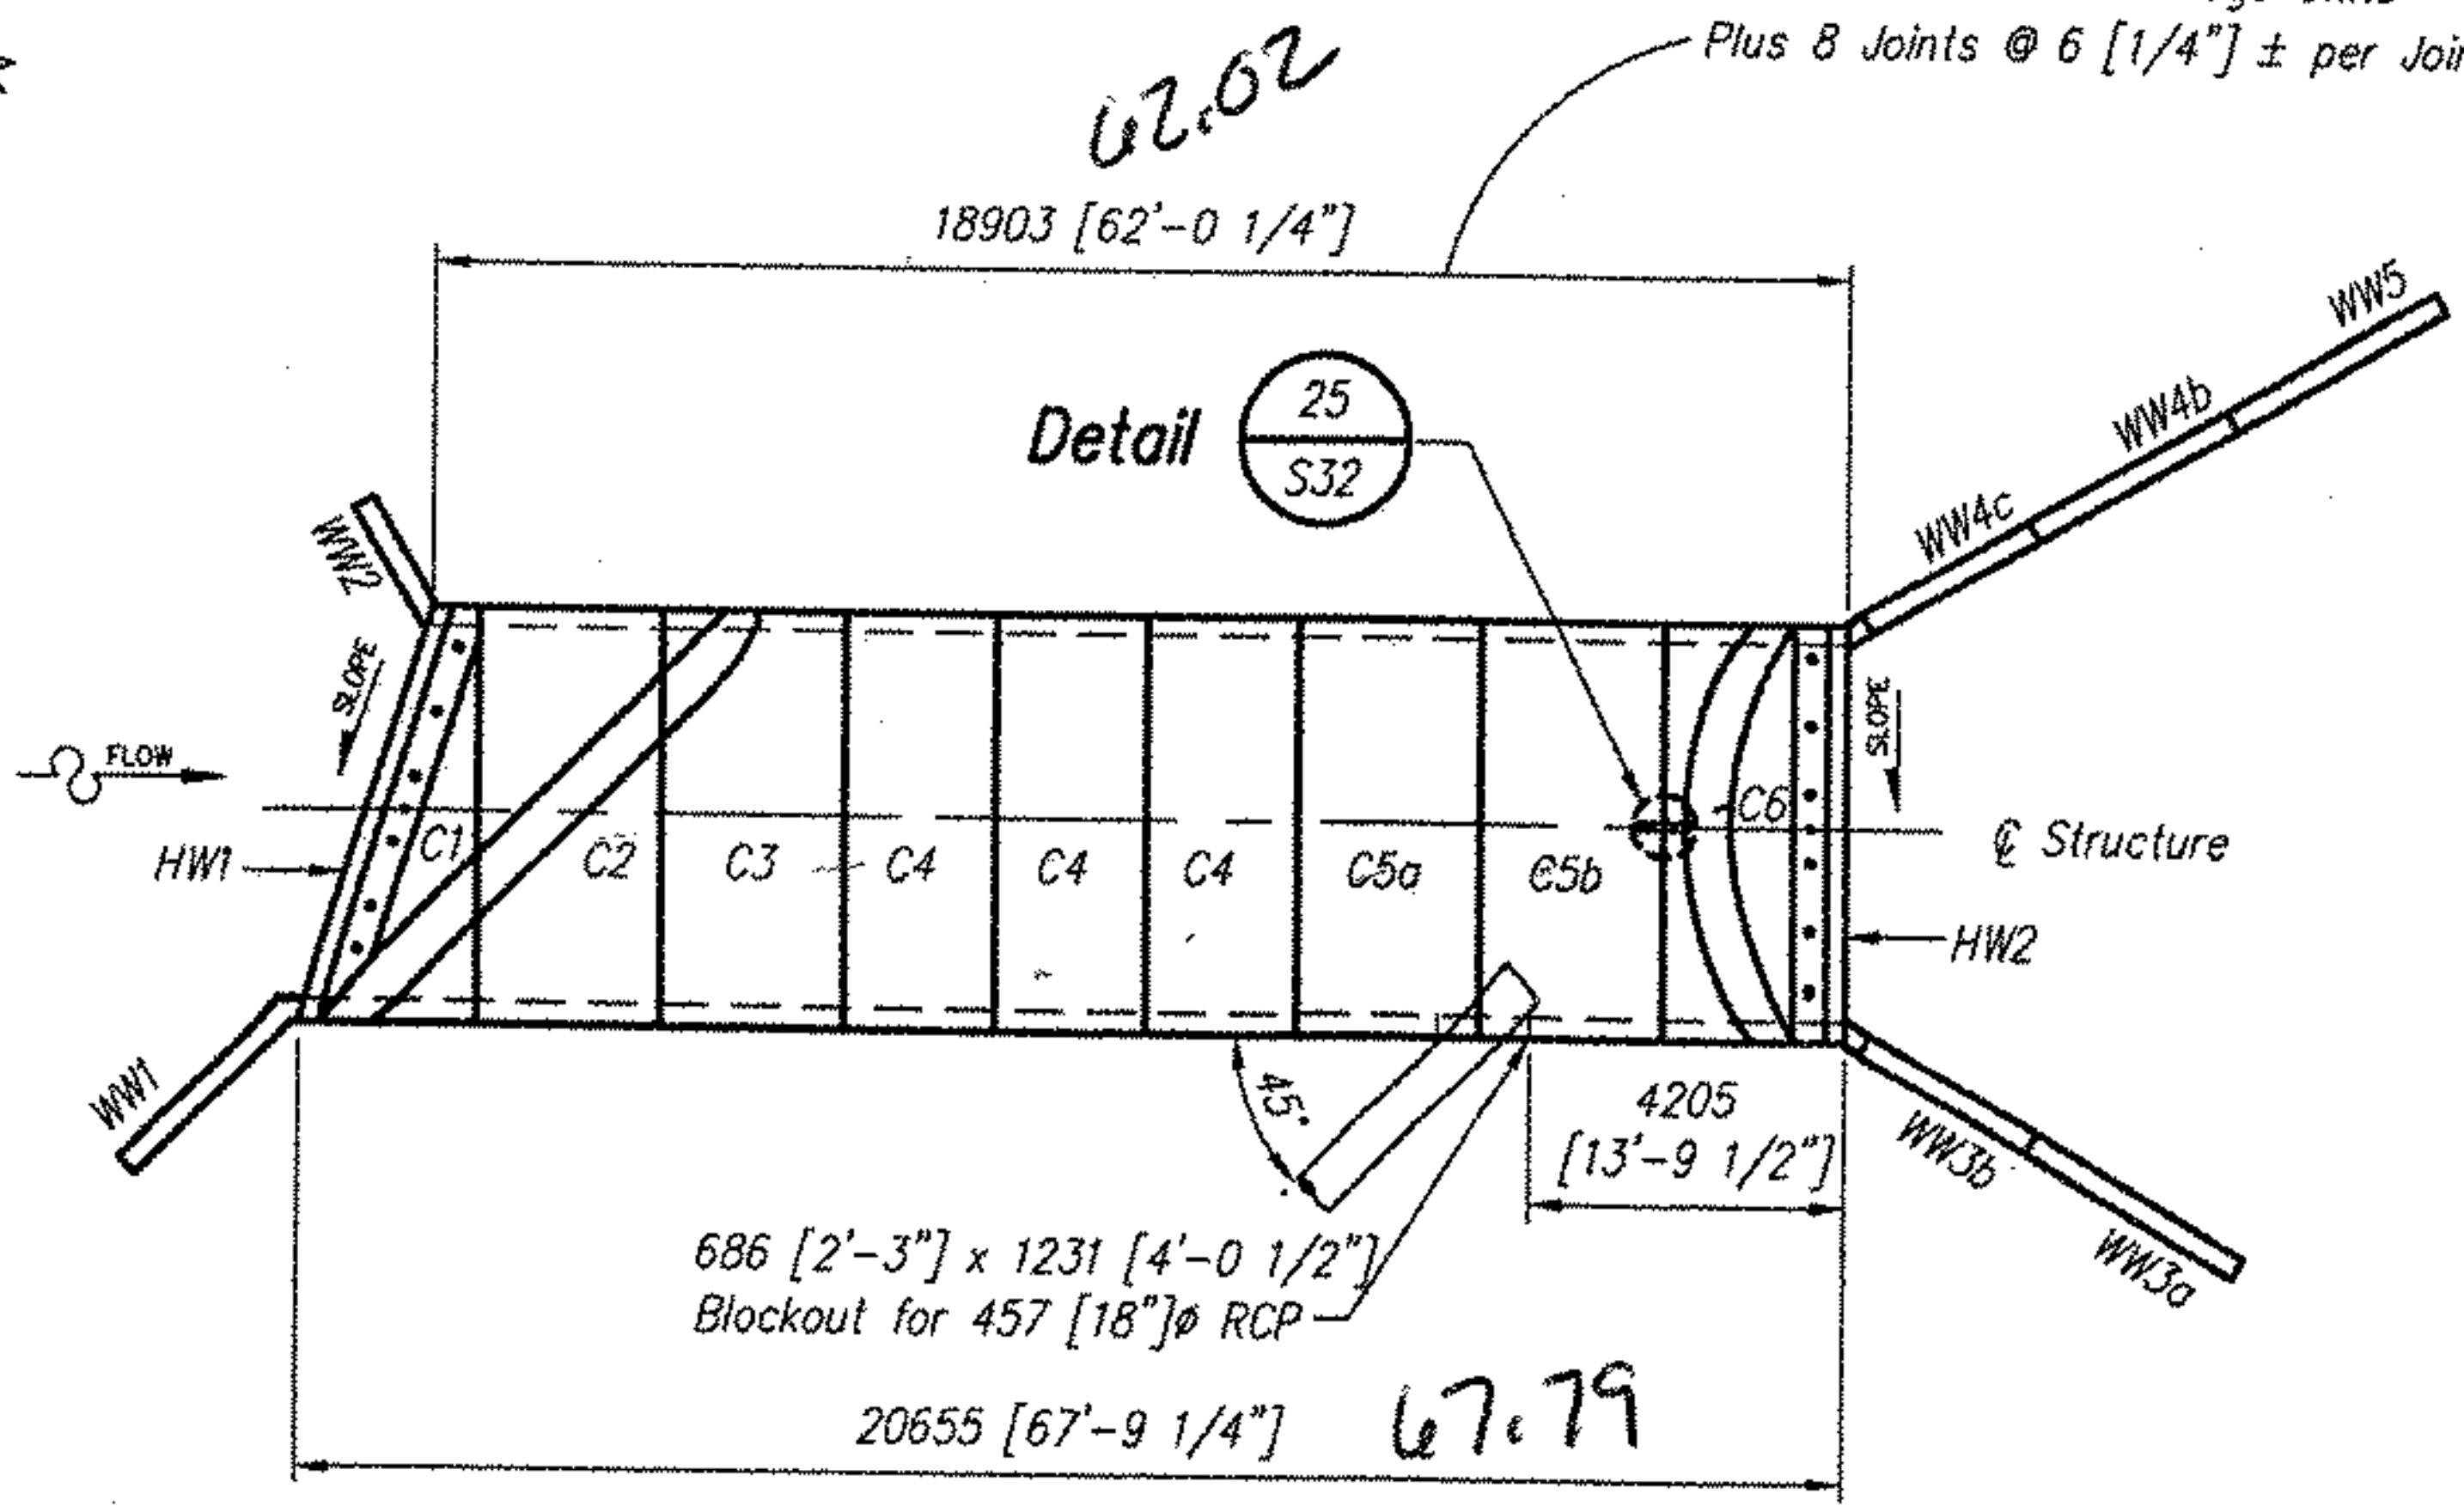

**KEY PLAN**

Revisions:		Date
No.	1	07/28/04
	2	
	3	
	4	


Sheet Title:  
 KEY PLAN  
 SHOP DRAWING

Producer:  
 CONCRETE SYSTEMS, INC.  
 NEW ENGLAND  
 800-342-3374

VERMONT  
 VT. RTE. 121  
 BRIDGE NO. 7

Date	Description	Sheets Revised	By
07/28/04	Blockout for 18" RCP in Units	S1, S14, S14a Added	KJG

**REVISIONS**

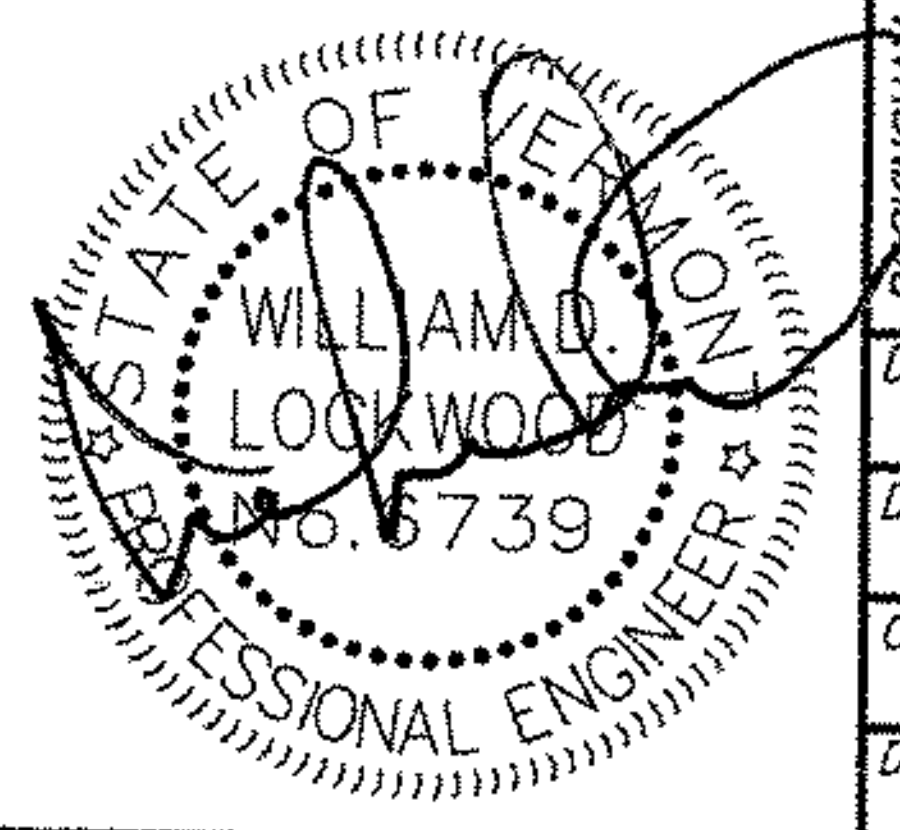

Des. By: KJG Job No. 11415  
 Drawn By: JLL Sheet No.  
 Chk'd By: JVP **S1**  
 Date: 6/22/04 **056**