


TYPICAL SECTIONS U.S. ROUTE 2


MATERIAL ITEM	THICKNESS TOLERANCE
PAVEMENT COURSES (TOTAL DEPTH)	± 1/4"
SUBBASE	± 1"
SAND BORROW	± 1"

3" WEARING COURSE, SUPERPAVE BITUMINOUS CONCRETE PAVEMENT (PG 58-²⁸~~34~~), 1/2" TYPE IIIS, 1/2" TYPE IIIS
 6" BASE COURSE, SUPERPAVE BITUMINOUS CONCRETE PAVEMENT (PG 58-²⁸~~34~~), 3" TYPE IS, 3" TYPE IS
 24" SUBBASE OF DENSE GRADED CRUSHED STONE
 12" SAND BORROW OR SUBBASE OF DENSE GRADED CRUSHED STONE

EMULSIFIED ASPHALT SHALL BE APPLIED ON ALL EXISTING PAVEMENT SURFACES, BETWEEN ALL COURSES OF PAVEMENT AND ON COLD PLANED SURFACES AT THE RATE OF 0.025 GAL/SY OR AS DIRECTED BY THE RESIDENT ENGINEER.

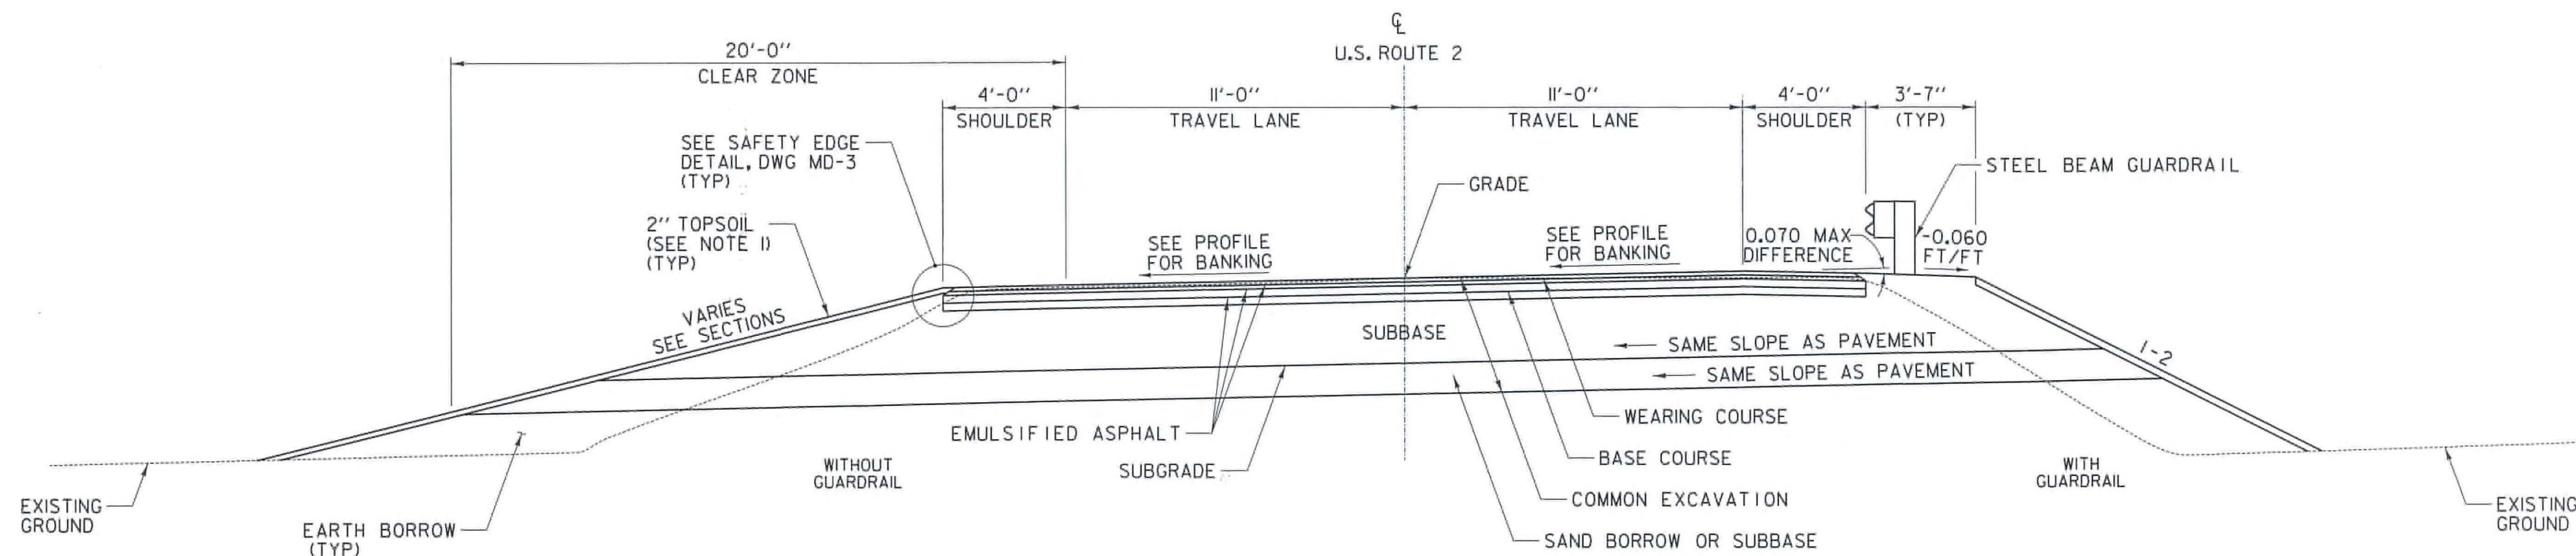

U.S. ROUTE 2 BANKED SECTION
STA 29+50.00 TO STA 35+40.01

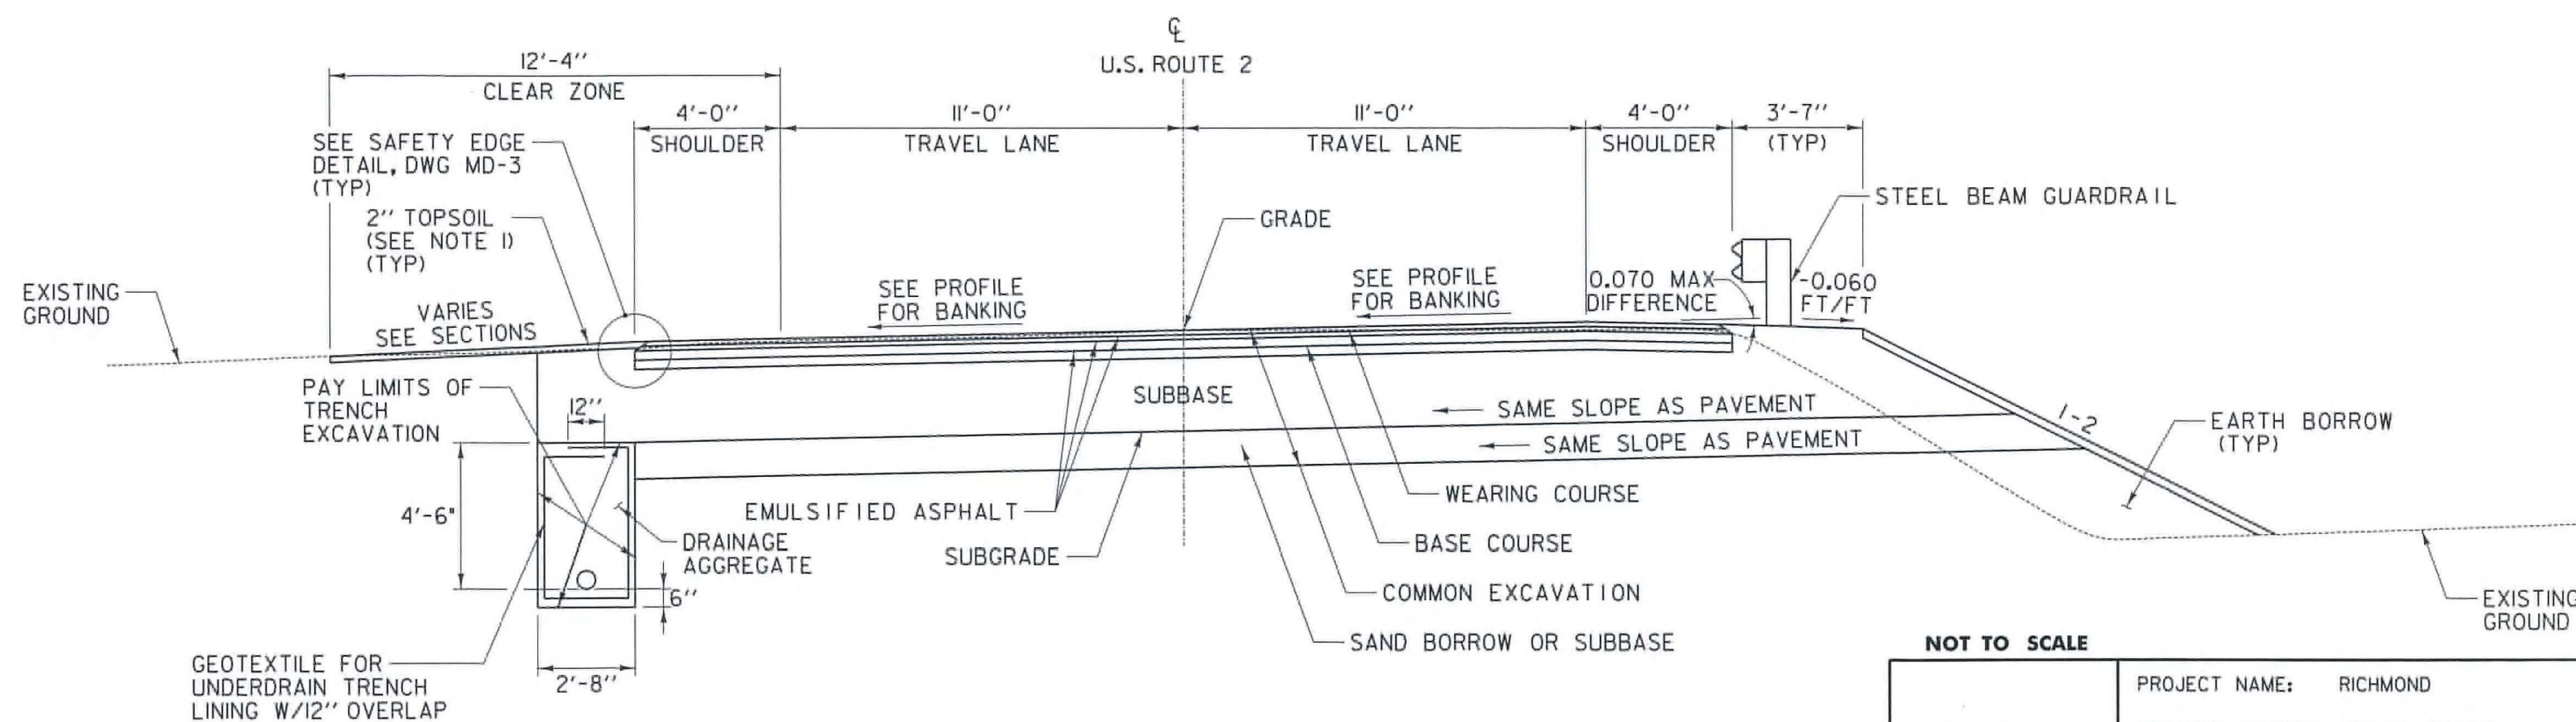

U.S. ROUTE 2 BANKED SECTION
STA 39+35.76 TO STA 45+00.00

<input checked="" type="checkbox"/> Reviewed	<input type="checkbox"/> Furnish As Corrected
<input type="checkbox"/> Rejected	<input type="checkbox"/> Revise and Resubmit

This review is only for general conformity with the design concept and the information given in the Construction Documents. Corrections or comments made on the drawings during the review do not release the Contractor from compliance with the requirements of the Plans and Specifications. Review of a specific area shall not exclude review of an assembly of which it is a component. The Contractor is responsible for dimensions, to be confirmed and corrected at the job site, information that pertains solely to the fabrication process or to the means, methods, techniques, sequences and procedures of construction, coordination of the work with that of other trades and performance of work in a safe and satisfactory manner.

August 31, 2011
 J. Santacruz

NOTE:
 1. IN AREAS WITH GRASS-LINED DITCHES, TOPSOIL SHALL BE SIX INCHES DEEP.

NOT TO SCALE

TYPICAL SECTION SHEET #1

PROJECT NAME: RICHMOND	PLOT DATE: 8/25/2011
PROJECT NUMBER: STP-RS 0284(III)	DRAWN BY: C.A.K.
FILE NAME: z90c092_TYP_I4.dgn	CHECKED BY: D.E.G.
PROJECT LEADER: D.E.G.	SHEET 2 OF 46
DESIGNED BY: B.T.H.	
DWG. NO.: TS-1	

FILE NAME: V:\P\0\sect1\ANY\2\22076\CAOD\AST\N\WB (1-14) ROADWAY DESIGN\96c092_typ_14.dgn
 DATE/TIME: 8/25/2011 10:00:00
 USER: 3886