


TYPICAL SECTIONS KENYON ROAD - JOHNNIE BROOK ROAD


MATERIAL ITEM	THICKNESS TOLERANCE
PAVEMENT COURSES (TOTAL DEPTH)	± 1/4"
SUBBASE	± 1"
SAND BORROW	± 1"

3" WEARING COURSE, SUPERPAVE BITUMINOUS CONCRETE PAVEMENT (PG 58-²⁸34), 1/2" TYPE III, 1/2" TYPE III S
 3" BASE COURSE, SUPERPAVE BITUMINOUS CONCRETE PAVEMENT (PG 58-²⁸34), TYPE ~~IS~~ ^{IS}
 24" SUBBASE OF DENSE GRADED CRUSHED STONE
 12" SAND BORROW OR SUBBASE OF DENSE GRADED CRUSHED STONE

EMULSIFIED ASPHALT SHALL BE APPLIED ON ALL EXISTING PAVEMENT SURFACES, BETWEEN ALL COURSES OF PAVEMENT AND ON COLD PLANED SURFACES AT THE RATE OF 0.025 GAL/SY OR AS DIRECTED BY THE RESIDENT ENGINEER.

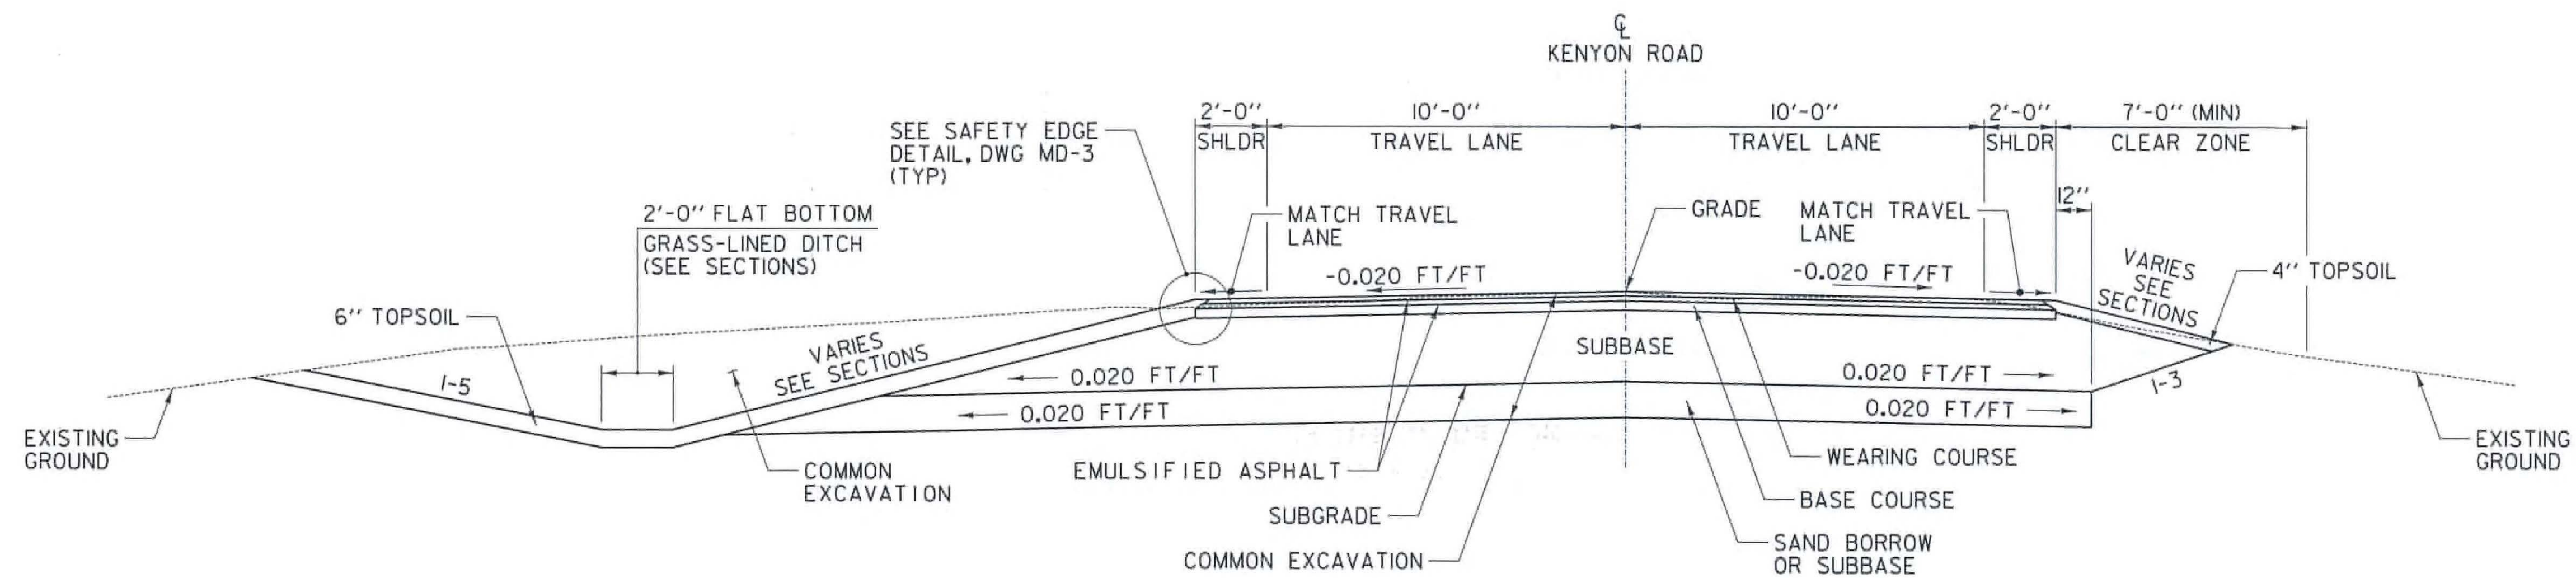

KENYON ROAD TYPICAL SECTION
STA K I+15.00 TO STA K 4+60.00

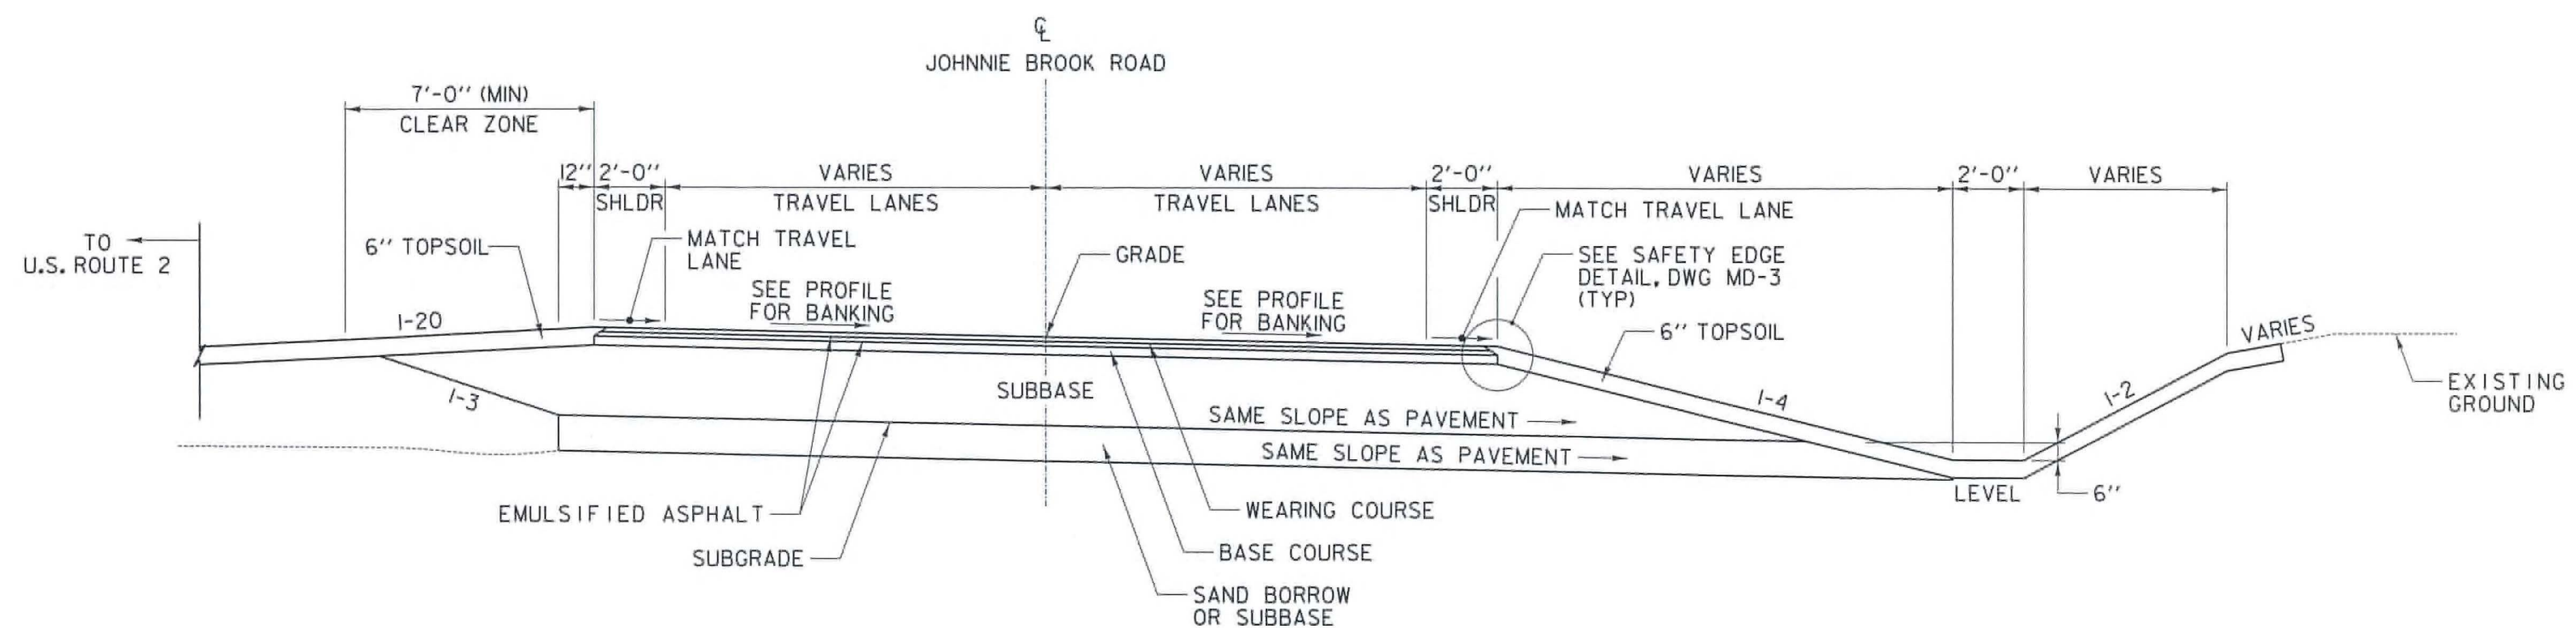

JOHNNIE BROOK ROAD TYPICAL SECTION
STA JB 120+10.00 TO STA JB 120+75.00

<input checked="" type="checkbox"/> Reviewed	<input type="checkbox"/> Forth As Corrected
<input type="checkbox"/> Rejected	<input type="checkbox"/> Revise and Resubmit

This review is for general conformance with the design concept and the information given in the Construction Documents. Corrections of mistakes made on the drawings during the review do not release the Contractor from compliance with the requirements of the Plans and Specifications. Review of a specific area shall not include review of an assembly of which it is a component. The Contractor is responsible for dimensions to be confirmed and corrected at the job site, information that pertains solely to the fabrication process or to the means, methods, techniques, sequences and procedures of construction, conditions of the Work, with that of other trades and performing all Work in a safe and satisfactory manner.

Date: August 21, 2011
 J. Santacruce

NOT TO SCALE

TYPICAL SECTION SHEET #2

PROJECT NAME: RICHMOND	PLOT DATE: 8/25/2011
PROJECT NUMBER: STP-RS 0284(II)	DRAWN BY: C.A.K.
FILE NAME: z90c092_TYP_I4.dgn	CHECKED BY: D.E.G.
PROJECT LEADER: D.E.G.	SHEET 3 OF 46
DESIGNED BY: B.T.H.	
DWG. NO.: TS-2	